

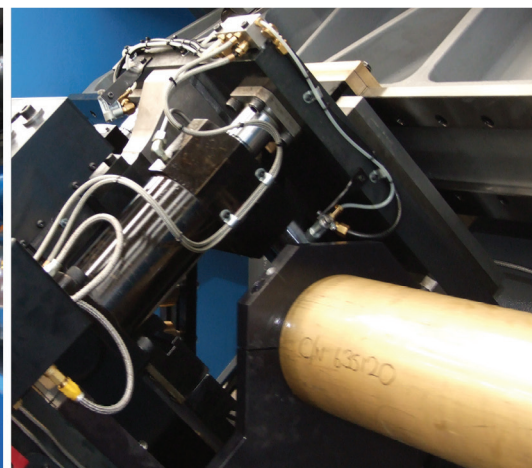


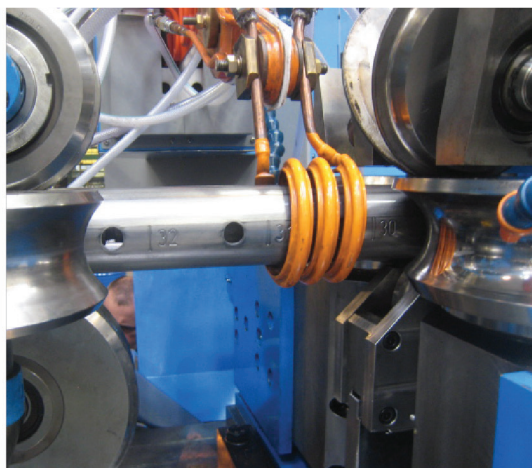

THERMATOOL

An Inductotherm Group Company

CUSTOMER DOCUMENTATION

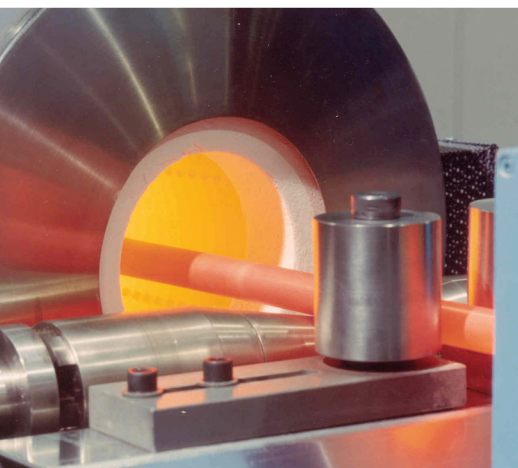

Inductotherm Heating & Welding Ltd

Thermatool House

Crockford Lane

Basingstoke

Hampshire

RG24 8NA UNITED KINGDOM

Tel: +44 (0) 1256 33 55 33

Fax: +44 (0) 1256 46 72 24

Email: info@inductothermhw.co.uk

www.inductotherm-hw.com



**INDUCTOTHERM
GROUP**

Leading Manufacturers of Melting, Thermal Processing and
Production Systems for the Metals and Materials Industry Worldwide.

OTO MILLS S.p.A, Italy

	<u>Drawing Title</u>	<u>Drq No.</u>		<u>Rev</u>
1	Schematic Electrical	WW5107	Sht 1-44	F
2	Interconnection Cable List	WW0094	Sht 1-24	L
3	Thermatool Wiring Colours	XS0051	Sht 1-2	A
4	Interconnect Wiring - AGP3600 - S7-300 PLC,TV2	WW5400	Sht 1/1	1
5	External Water Circuit (HF12 50-350KW)	WW0090	Sht 1/1	H
6	DC PSU Cabinet - Water Schematic (200-350kW)	WW0091	Sht 2/2	J
7	HF12 Inverter Water Schematic - Bus 5	WW5069	Sht 1-3	A
8	Work Coils (DRAWING NOT SUPPLIED)	Refer to Mill Layout		
9	Work Coils (DRAWING NOT SUPPLIED)	Refer to Mill Layout		
10	Tacho-Generator Type: Reo N	WD0083	Sht 1/1	0
11	Basic Dimensions - Thermaview Mk 2 Console	VC0061	Sht 1/1	0
12	Basic Dimensions - HF12 Inverter Cabinet	WD0076	Sht 1/1	A
13	Basic Dimensions - Power Unit Cabinet (200-350kW)	WD0077	Sht 2/2	B
14	Basic Dimensions - Heat Exchanger 50-350kW CFI	WD0171	Sht 1/1	B
15	Through Flow Impedor details	WD5066	Sht 1/2	C
16	Return Flow Impedor details	WD5067	Sht 1/2	A
17	Auto-Match Assembly - HF12	-001 WU5262	Sht 1/4	B
18	Auto-Match Assembly - HF12 BOM	-001 WU5262	Sht 1-2	E
19	Auto-Match Assembly -Common Build - HF12	WU5261	Sht 1-2	B
20	Auto-Match Assembly -Common Build - HF12 BOM	WU5261	Sht 1-2	B
21	Output Bus Assembly	WU5032	Sht 1/1	0
22	Output Bus Assembly - BOM	WU5032	Sht 1/1	0
23	30° Output Assembly	WU5311	Sht 1/1	0
24	30° Output Assembly - BOM	WU5311	Sht 1/1	0
25	Axis Table Assembly	WU5436	Sht 1/1	0
26	Customer Plinth Requirements - HF12	WG2210-T2400	Sht 1/1	0

A A B O C O												A A A E O O												A O O 1 O A O A O O B												O O B O B O O O O O												A D B O O O O A A A												REV SH												REV STATUS											
38A 37A 22A 12A 11A 3A												38 37 36 1																																																											

DRAWING LIST:

CFI SOLID STATE WELDER

400 (460) VAC, 50/60Hz, 3 PH.

SYSTEM INTERCONNECT.	SHEET 2
SYSTEM GROUNDING.	SHEET 3
DC CONTROL PANEL 0 VOLT WIRING + EARTH	SHEET 3A
AC POWER DISTRIBUTION (50-350 KW)	SHEET 4
AC POWER DISTRIBUTION (400-1200 KW)	SHEET 5
AC POWER DISTRIBUTION (CURRENT FEEDBACK).	SHEET 6
AC POWER DISTRIBUTION (DC RECTIFIERS).	SHEET 7
AC POWER DISTRIBUTION (AUXILIARY CONTROL)	SHEET 8
THREE PHASE AC MOTORS	SHEET 9
AC CONTROL.	SHEET 10
SINGLE PHASE AC MOTORS.	SHEET 11
SINGLE PHASE AC MOTORS.	SHEET 11A
24VDC CONTROL (E-STOP CIRCUIT)	SHEET 12
24VDC CONTROL.	SHEET 12A
24VDC CONTROL.	SHEET 13
BLANK PAGE.	SHEET 14
BLANK PAGE	SHEET 15
PLC ANALOG INPUTS 0-10V (SLOT 0,2).	SHEET 16
PLC DIGITAL INPUTS 24VDC (SLOTS 0,2).	SHEET 17
PLC DIGITAL INPUTS 24VDC (SLOTS0,4).	SHEET 18
PLC DIGITAL INPUTS 24VDC (SLOTS 0,5).	SHEET 19
PLC DIGITAL OUTPUTS 24VDC (SLOTS 0,2)	SHEET 20
PLC DIGITAL OUTPUTS 24VDC (SLOTS 0,6)	SHEET 21
["OPTIONAL" CUSTOMER FAULTS]	
PLC DIGITAL INPUTS 24VDC (SLOTS 0,7).	SHEET 22
PLC DIGITAL INPUTS 24VDC (SLOTS 0,8).	SHEET 22A
MILL INTERLOCKS	SHEET 23
1-XLOC TERM. BLOCK.	SHEET 24
1-XHF TERM. BLOCK	SHEET 25
1-DC1 & 1-DC2 CONTROL BOARDS	SHEET 26
2-HF1 CONTROL BOARD	SHEET 27
1-SPC1 SPEED POWER CONTROL BOARD	SHEET 28
HF MODULE POWER SUPPLIES (50- 350 kW).	SHEET 29
HF MODULES POWER SUPPLIES (400-800 KW)	SHEET 30
HF MODULES POWER SUPPLIES (1000-1200 KW)	SHEET 31
DC HARMONIC FILTER.	SHEET 32
RF OUTPUT CIRCUIT.	SHEET 33
2-HF1 TO HF MODULE CONNECTIONS	SHEET 34
HF-GENERATOR PLUG INTERCONNECT DETAILS (PLUG1,)	SHEET 35
HF-GENERATOR PLUG INTERCONNECT DETAILS (PLUG 2,3,4)	SHEET 36
"TYPICAL" TERMINAL LAYOUT 50 THRU 350KW	SHEET 37
"TYPICAL" TERMINAL LAYOUT 400 THRU 600KW	SHEET 37A
"TYPICAL" PANEL LAYOUT 50 THRU 350KW	SHEET 38
"TYPICAL" PANEL LAYOUT 400 THRU 600KW	SHEET 38A

WIRE IDENTIFICATION:

	FIRST NUMBER USED	LAST NUMBER USED
3 PHASE AC 400 (460)/200	L1 L2 L3	16L1 16L2 16L3
ISOLATED CONTROL VOLTAGE AC 115 OR (230)	101 100	140 109
HIGH FREQUENCY GENERATOR	601	621
ISOLATED CONTROL VOLTAGE AC 115 OR (230)	600	-
AUXILIARY VOLTAGE AC 115 OR (230)	801 800	- -
HIGH VOLTAGE DC	900	906
CONTROL VOLTAGE (24VDC)	2401 2402 2400	2457 - -
LOW VOLTAGE DC (6-23VDC)	1001 1002 1000	1094 - -

NOTES:
 NUMBERS SHOWN ARE RESERVED FOR SUPPLY WIRES.
 SEQUENCE CONTINUES FOR SIGNAL WIRES.
 EX. 24VDC SIGNAL = 2403

WIRING COLOURS IN ACCORDANCE WITH THERMATOOL STANDARD DRG No: XS0051 (GENERALLY AS RECOMMENDED BY: EN 60204)

PLC ADDRESS IS USED FOR WIRE NUMBER WHEN EVER POSSIBLE.
 EX. SLOT 1, GROUP 0, BIT 15 = 01015

CABLE SIZE:- "GENERAL" CONTROL WIRING MINIMUM 1.5MM UNLESS STATED
 CONTROL WIRING TO PLC INPUTS/OUTPUTS MAY BE 0.5MM
 EARTH/GROUNDING CABLES (UNLESS IN CONDUIT/MULTICORE) TO BE MINIMUM 4MM (UNLESS STATED)

CABLE INTERCONNECTION LIST DRAWING NO: WW0094

REV	ECR	DESCRIPTION	ZONE	DWN	CHK	APPD	MM/DD/YY
0	03248	FIRST ISSUE		TAT			10/10/03
A	04102	REV.SH.1,2,3,8,10,18,25,27,32,35,36,37,37A,38,38A		TAT			07/16/04
B	04256	REV. SH.1,8,16,18,22,22A		TAT			11/17/04
C	05222	ADD SH 11A (NEW VARIANT 3 AXIS TABLE)		TAT			11/16/05
D	06151	REV. SH.1,9		TAT			06/23/06
E	09047	REV. SH.1,35		TAT			04/08/09
F		REV SH.1,29 CORRECT WIRE NUMBERS		AM			10/01/12

NEXT ASSY: _____ JOB NO: _____ FIRST APPLICATION: _____ UNIT: CFI 50-1200 kW		UNLESS OTHERWISE SPECIFIED DIMENSIONS ARE IN MILLIMETERS TOLERANCES ON: 0 PLACE (X) ± 0.5 ANGLE ± 0°30' 1 PLACE (X.X) ± 0.3 SURFACE N8 2 PLACE (X.XX) ± 0.15 FINISH		APPROVALS: _____ DD/MM/YY: 10/10/03 DWN TT (CC: WW0200) CHK _____ ENG/APPD _____ MATL _____			
BUYER OR SELLER HEREBY ACKNOWLEDGES THAT THERE MAY BE ERRORS OR OMISSIONS IN THIS DOCUMENT AND THAT THERMATOOL EUROPE LTD SHALL NOT BE LIABLE IN ANY MANNER FOR SUCH ERRORS OR OMISSIONS. ©Copyright THERMATOOL EUROPE LTD THIS DOCUMENT IS THE PROPERTY OF THERMATOOL EUROPE LTD AND IT IS SUBMITTED FOR USE ONLY WITH WORK PROPOSED OR AUTHORIZED BY THIS COMPANY. IT SHOULD NOT BE USED OR DUPLICATED FOR ANY OTHER PURPOSE AND IS TO BE RETURNED TO THERMATOOL EUROPE LTD ON REQUEST WHEN NO LONGER REQUIRED FOR SUCH PURPOSES.		BREAK AND DEBURR ALL SHARP EDGES		SI-METRIC THIRD ANGLE PROJECTION		TITLE: SCHEMATIC - ELECTRICAL CFI SOLID STATE WELDER TVIEW ("OPTIONAL" CUS. INPUTS ,S7-313C PLC, PILZ E-STOPS)	
FINISH/HEAT TREAT: _____				SIZE: A1 DIV NO: 3 DWG NO: WW5107 REV: F		SCALE: N/A DO NOT SCALE DRAWING COPY SHEET 1 OF 44	


REVISIONS							
REV	ECR	DESCRIPTION	ZONE	DWN	CHK	APPD	MM/DD/YY
0	03248	FIRST ISSUE		TAT			10/10/03
A	04102	IMPROVE CLARITY OF XFMR CAB		TAT			07/15/04

SYSTEM INTERCONNECT

NOTES:

- THIS DRAWING SHOWS HOW THE THERMATOOL EQUIPMENT IS ELECTRICALLY INTERCONNECTED. THE LOCATION OF CONDUITS SHOWN ARE INTENDED TO BE USED AS A GUIDE. CONDUITS ARE SHOWN THIS WAY TO CLEARLY DEMONSTRATE HOW THEY INTERCONNECT. THE ACTUAL INSTALLATION AND RUNNING OF CONDUIT IS THE OPTION OF THE CUSTOMER.
- RUN SEPARATE CONDUIT FOR EACH WIRING LEVEL.
- WIRING VOLTAGE LEVEL, LEVEL NUMBERS
 - LOW LEVEL (ANALOG)
 - MEDIUM LEVEL (24VDC)
 - HIGH LEVEL (115 {230} VAC)
 - POWER LEVEL (400 {460} VAC)
 - SPECIAL HIGH POWER CABLES
 - PLANT DISTRIBUTION
- | | | | | | | |
|-----------------------|----------------|----|---|----|---|----|
| XX-XX-XX | CONDUIT NUMBER | XX | - | XX | - | XX |
| FROM EQUIPMENT PREFIX | | | | | | |
| TO EQUIPMENT PREFIX | | | | | | |
| WIRING VOLTAGE LEVEL | | | | | | |
| JUNCTION BOX NUMBER | | | | | | |
- ALL CONDUIT AND WIRING TO BE PROVIDED AND INSTALLED BY CUSTOMER, UNLESS OTHERWISE NOTED.
- ALL WIRING TO BE IN ACCORDANCE WITH THE NATIONAL ELECTRICAL CODE AND/OR ALL APPLICABLE CODES.
- FOR WIRE DETAILS REFER TO INTERCONNECT CABLE LIST.
- FOR THERMAVIEW UNITS WELDER CONTROL CONSOLE REQUIRES 230VAC 60/50HZ UNINTERRUPTABLE SUPPLY.

(400-1200 KW WELDERS ONLY)

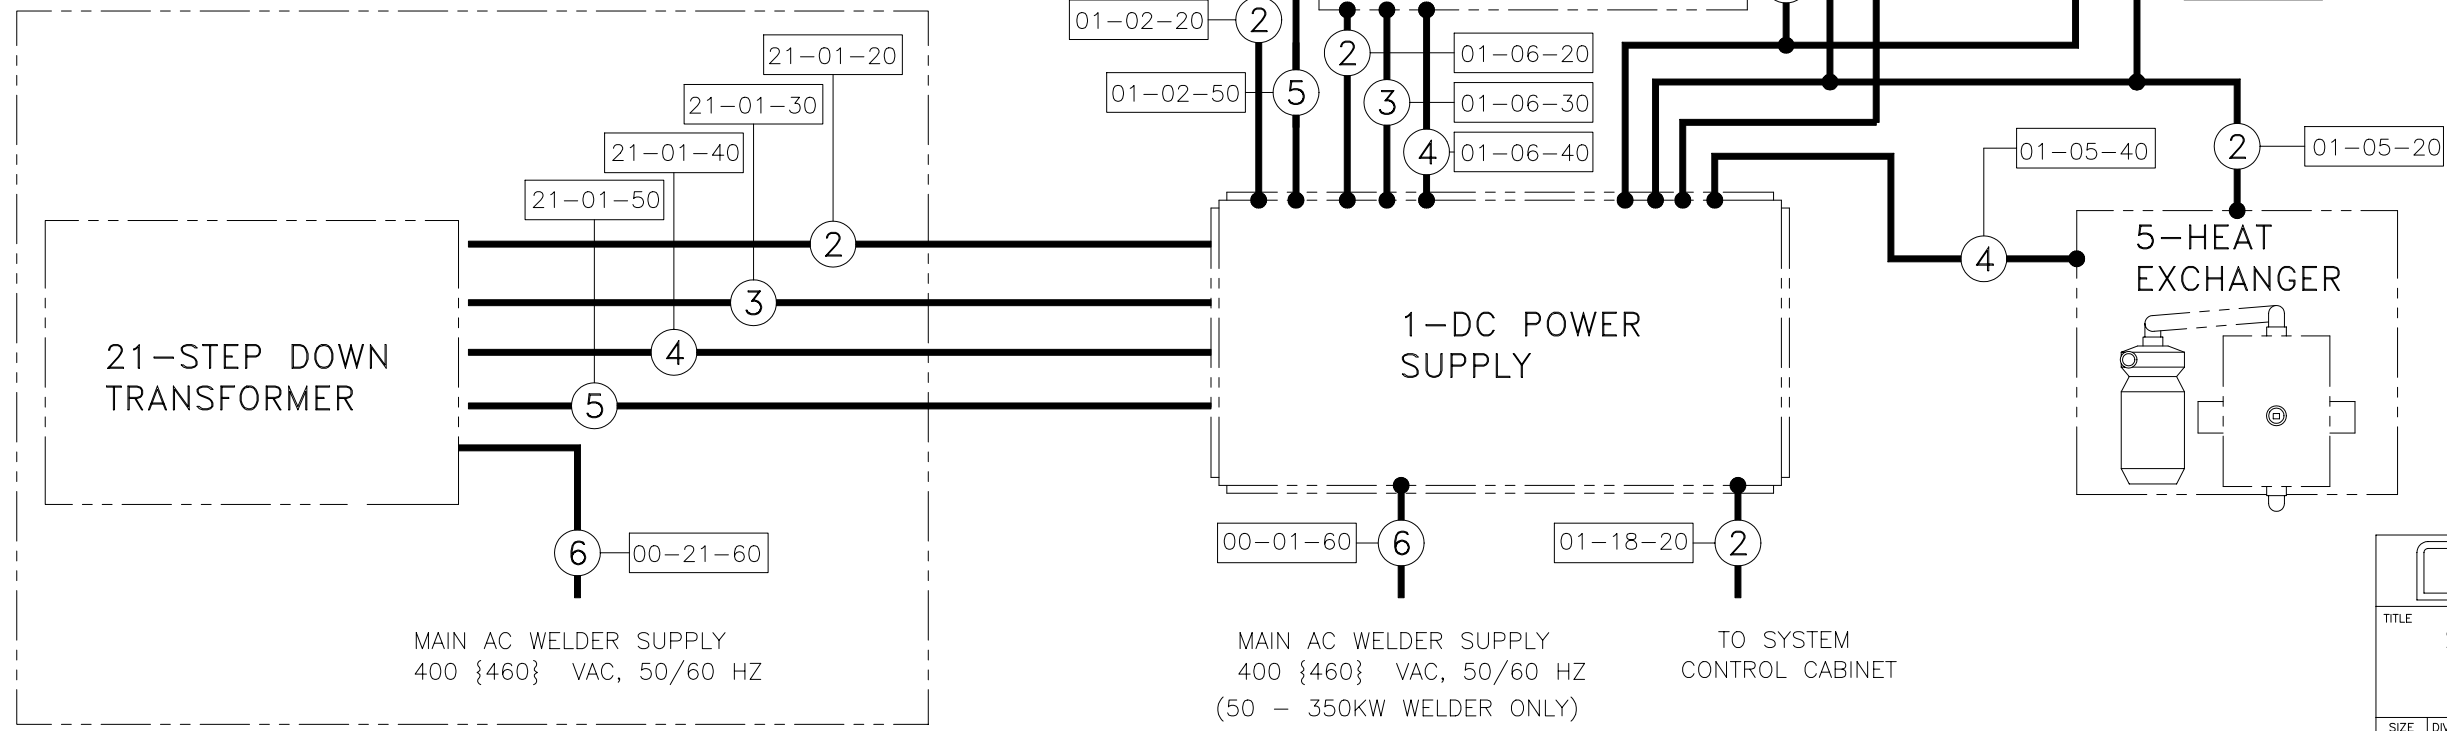


 ©Copyright THERMATOOL EUROPE LTD			
TITLE			
SCHEMATIC – ELECTRICAL CFI SOLID STATE WELDER			
SIZE	DIV NO	DWG NO	REV
A1	3	WW5107	A
SCALE	N/A	DO NOT SCALE DRAWING COPY	SHEET
		2	2

REVISIONS							
REV	ECR	DESCRIPTION	ZONE	DWN	CHK	APPD	MM/DD/YY
0	03248	FIRST ISSUE		TAT			10/10/03
A	04102	DEL EARTH CABLE SIZES "SEE INTRCNCT"		TAT			07/15/04

SYSTEM GROUNDING

NOTES:

1. ALL GROUND CABLES ARE 10 AWG [6MM²] GRN/YEL UNLESS OTHERWISE SPECIFIED.
2. RUN GROUNDING CABLES FROM A SINGLE GROUND POINT ON THE RF CAPACITOR BUS TO (4) INDIVIDUAL LOCATIONS ON THE MILL BASE. KEEP WIRES AS SHORT AS POSSIBLE AND EQUAL IN SPACING AND DISTANCE. MINIMUM SPACING ON MILL FIXTURE IS 12 INCHS [305MM].

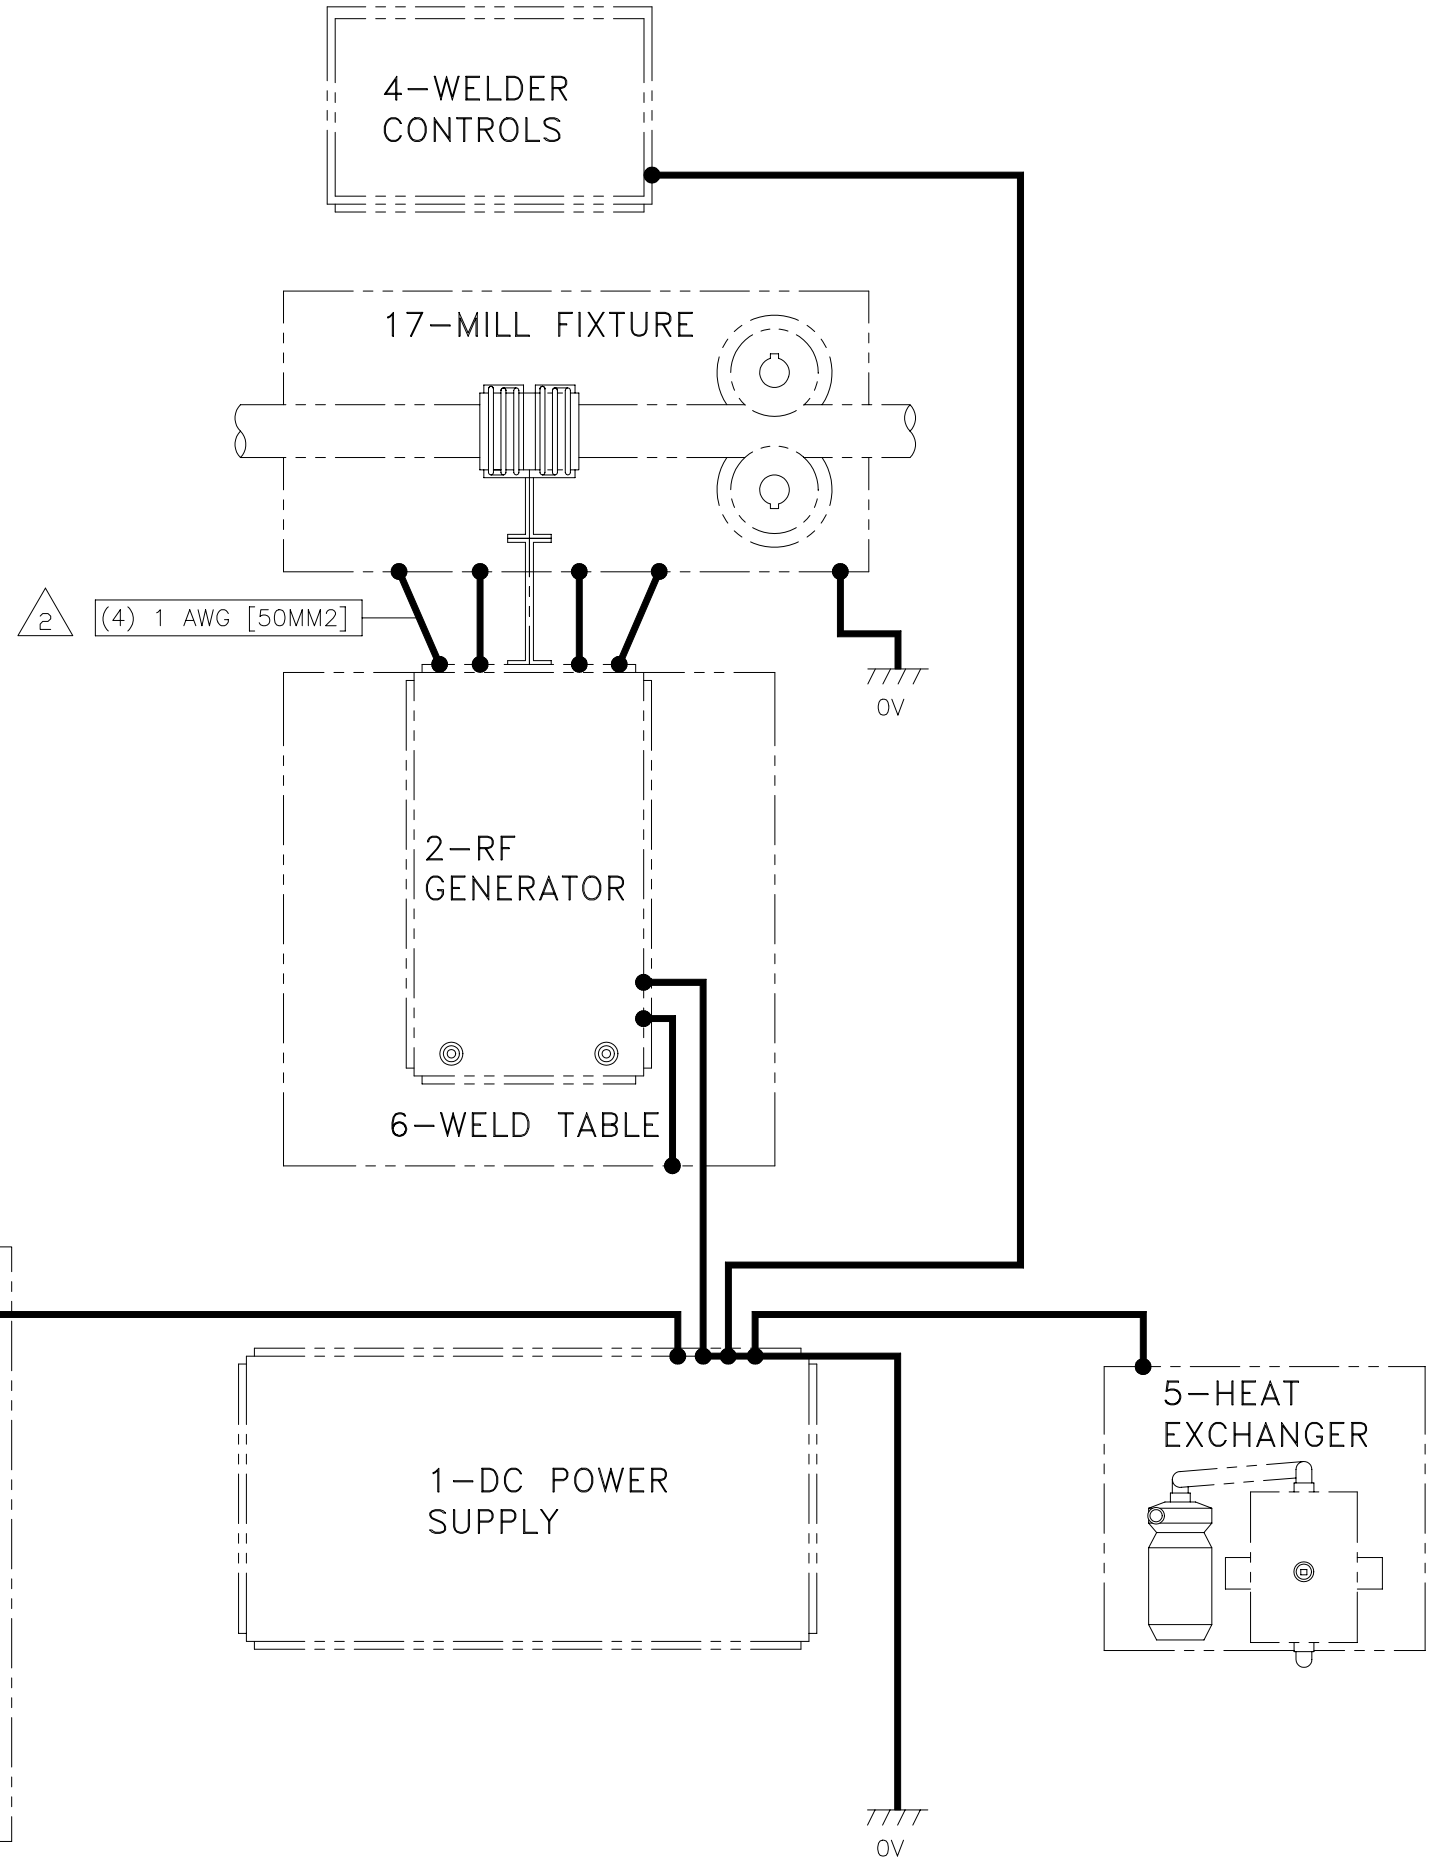

THERMATOOL
©Copyright THERMATOOL EUROPE LTD

TITLE
**SCHEMATIC – ELECTRICAL
CFI SOLID STATE WELDER**

SIZE A1	DIV NO 3	DWG NO WW5107	REV A
SCALE N/A	DO NOT SCALE DRAWING COPY		SHEET 3


ENG-REF: 2

TYPICAL DC PANEL 0 VOLT (COM) WIRING

REVISIONS						
REV	ECR	DESCRIPTION	ZONE	DWN	CHK	APPD
0		FIRST ISSUE		TAT		

NOTES:-

- PANEL COMPONENT PREFIX IS "1" (IE, 1-CB1,1-CB2,1-CR1, etc)
- MINIMUM SIZE CABLE 1.5MM SQ.

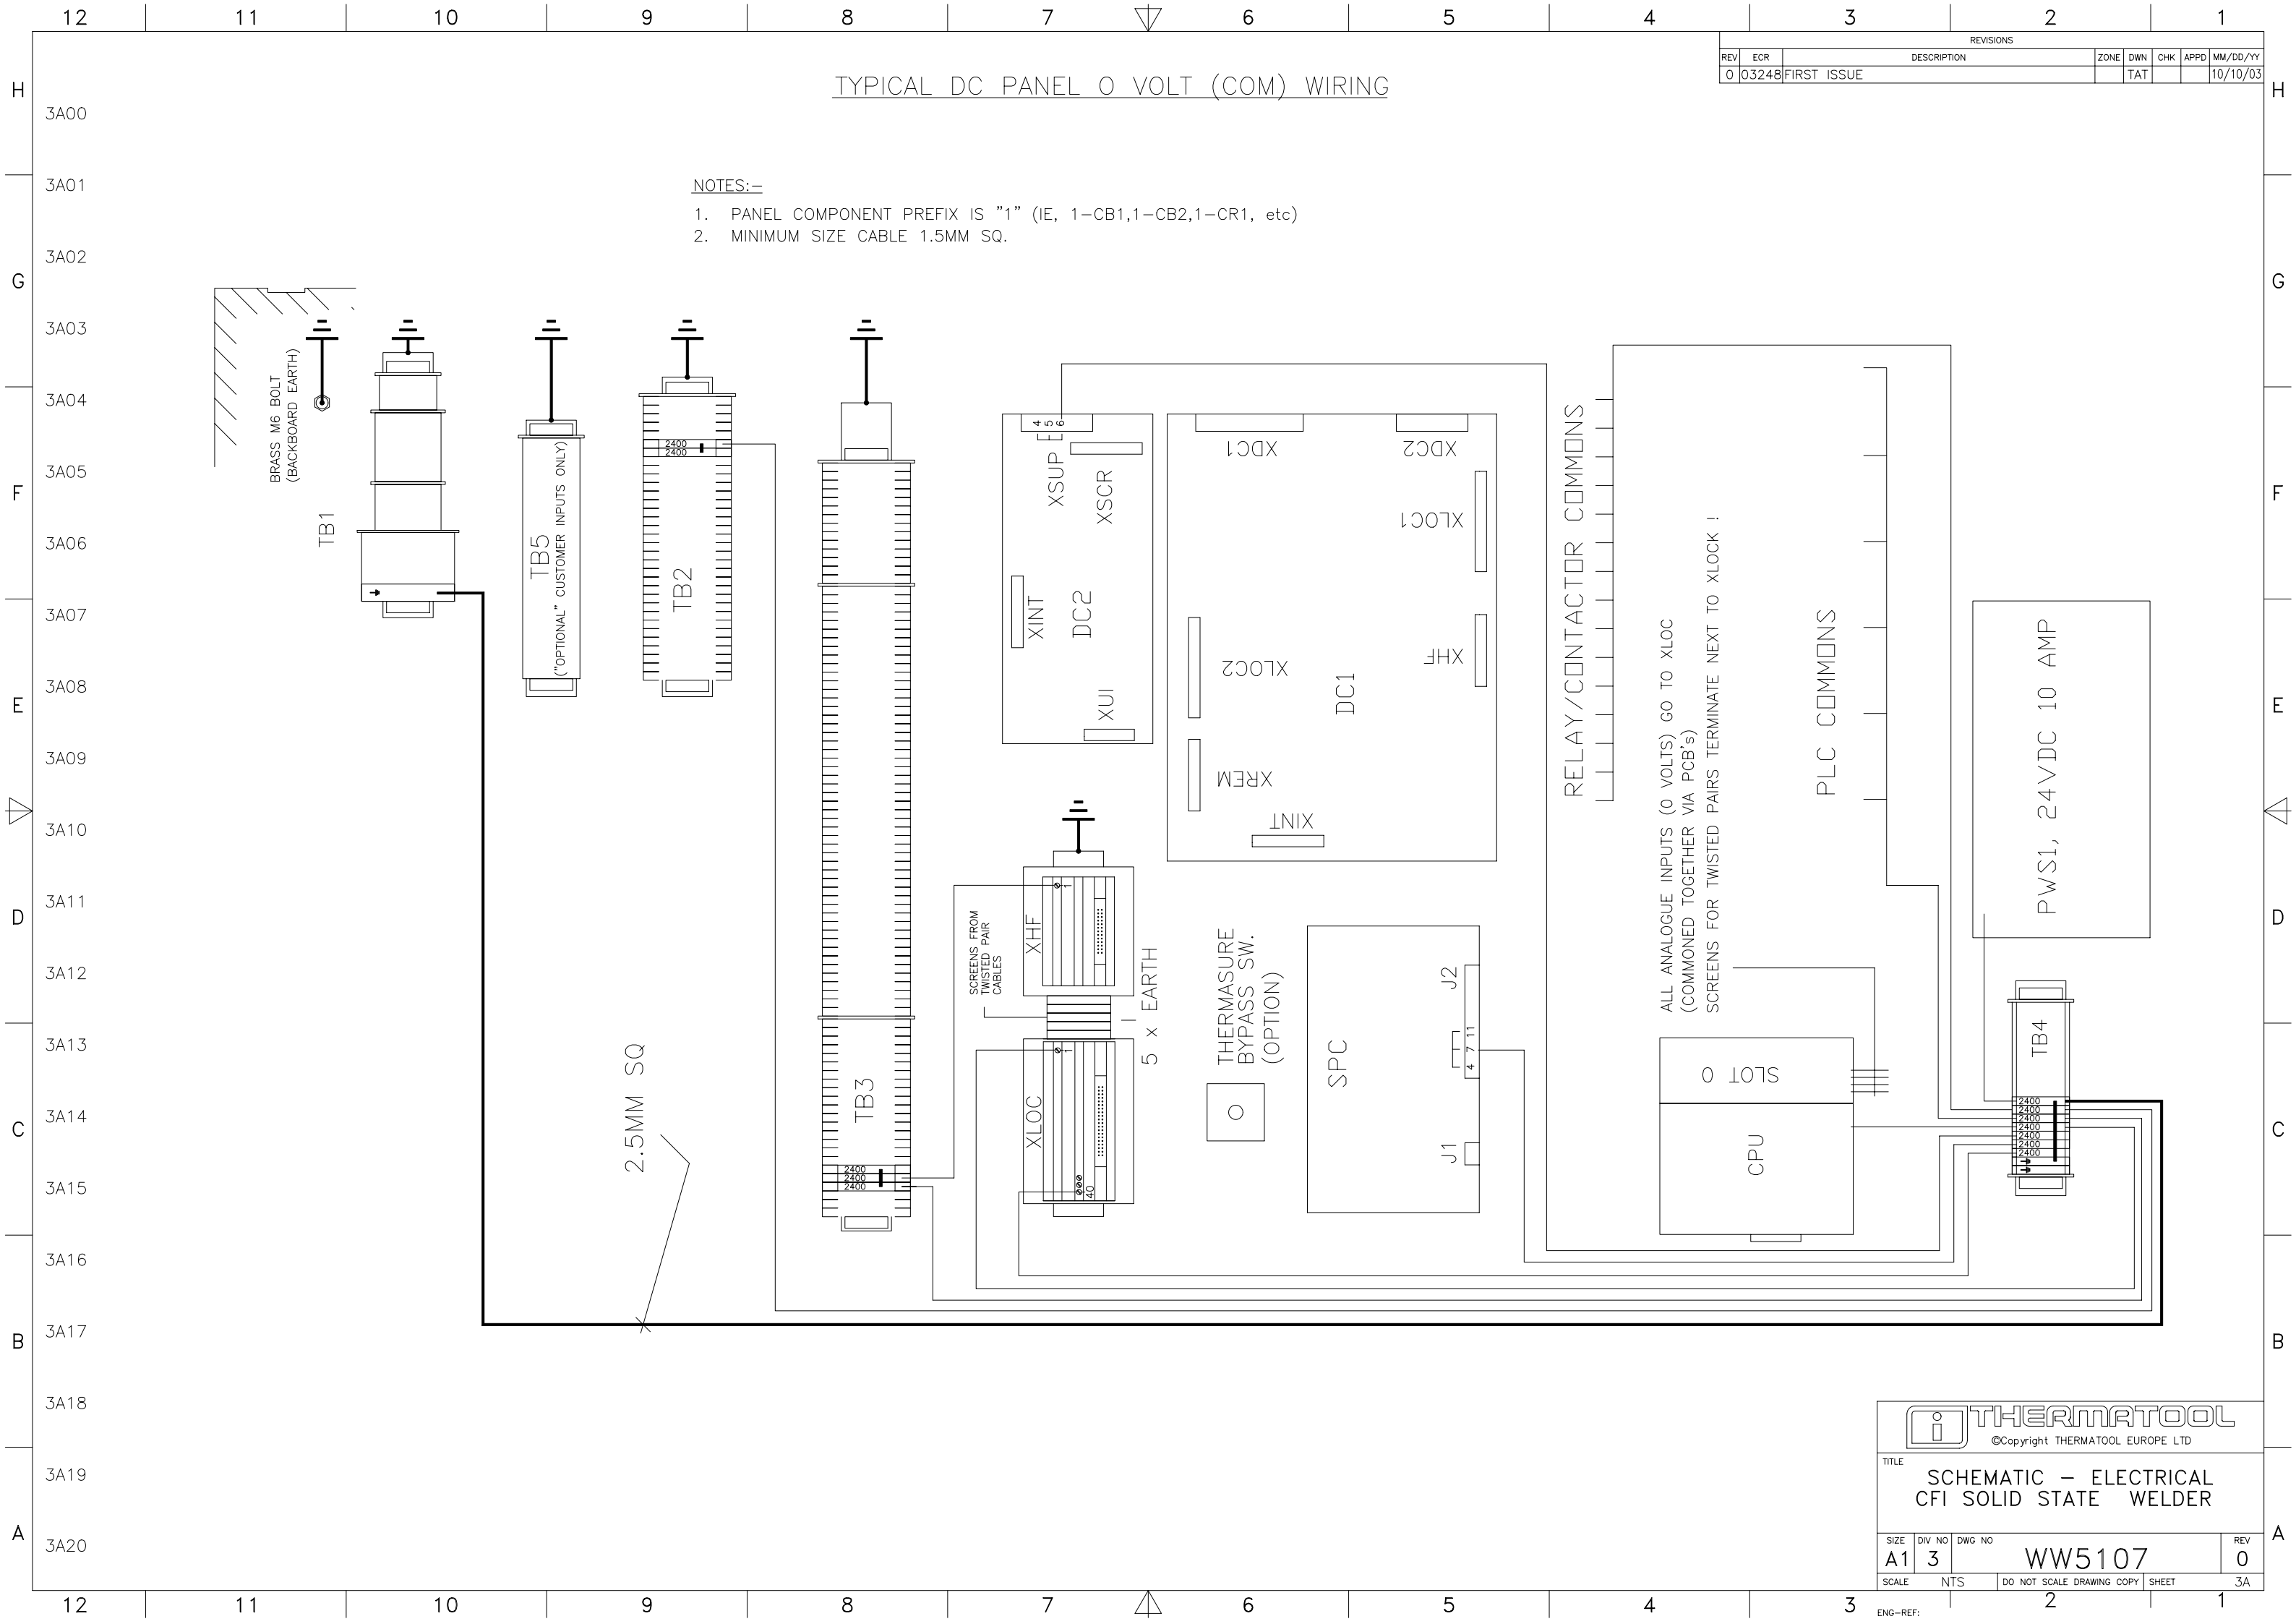


THERMATOOL
©Copyright THERMATOOL EUROPE LTD

TITLE: SCHEMATIC – ELECTRICAL CFI SOLID STATE WELDER

SIZE	DIV NO	DWG NO	REV
A1	3	WW5107	0

SCALE: NTS DO NOT SCALE DRAWING COPY SHEET: 3A

ENG-REF: 2

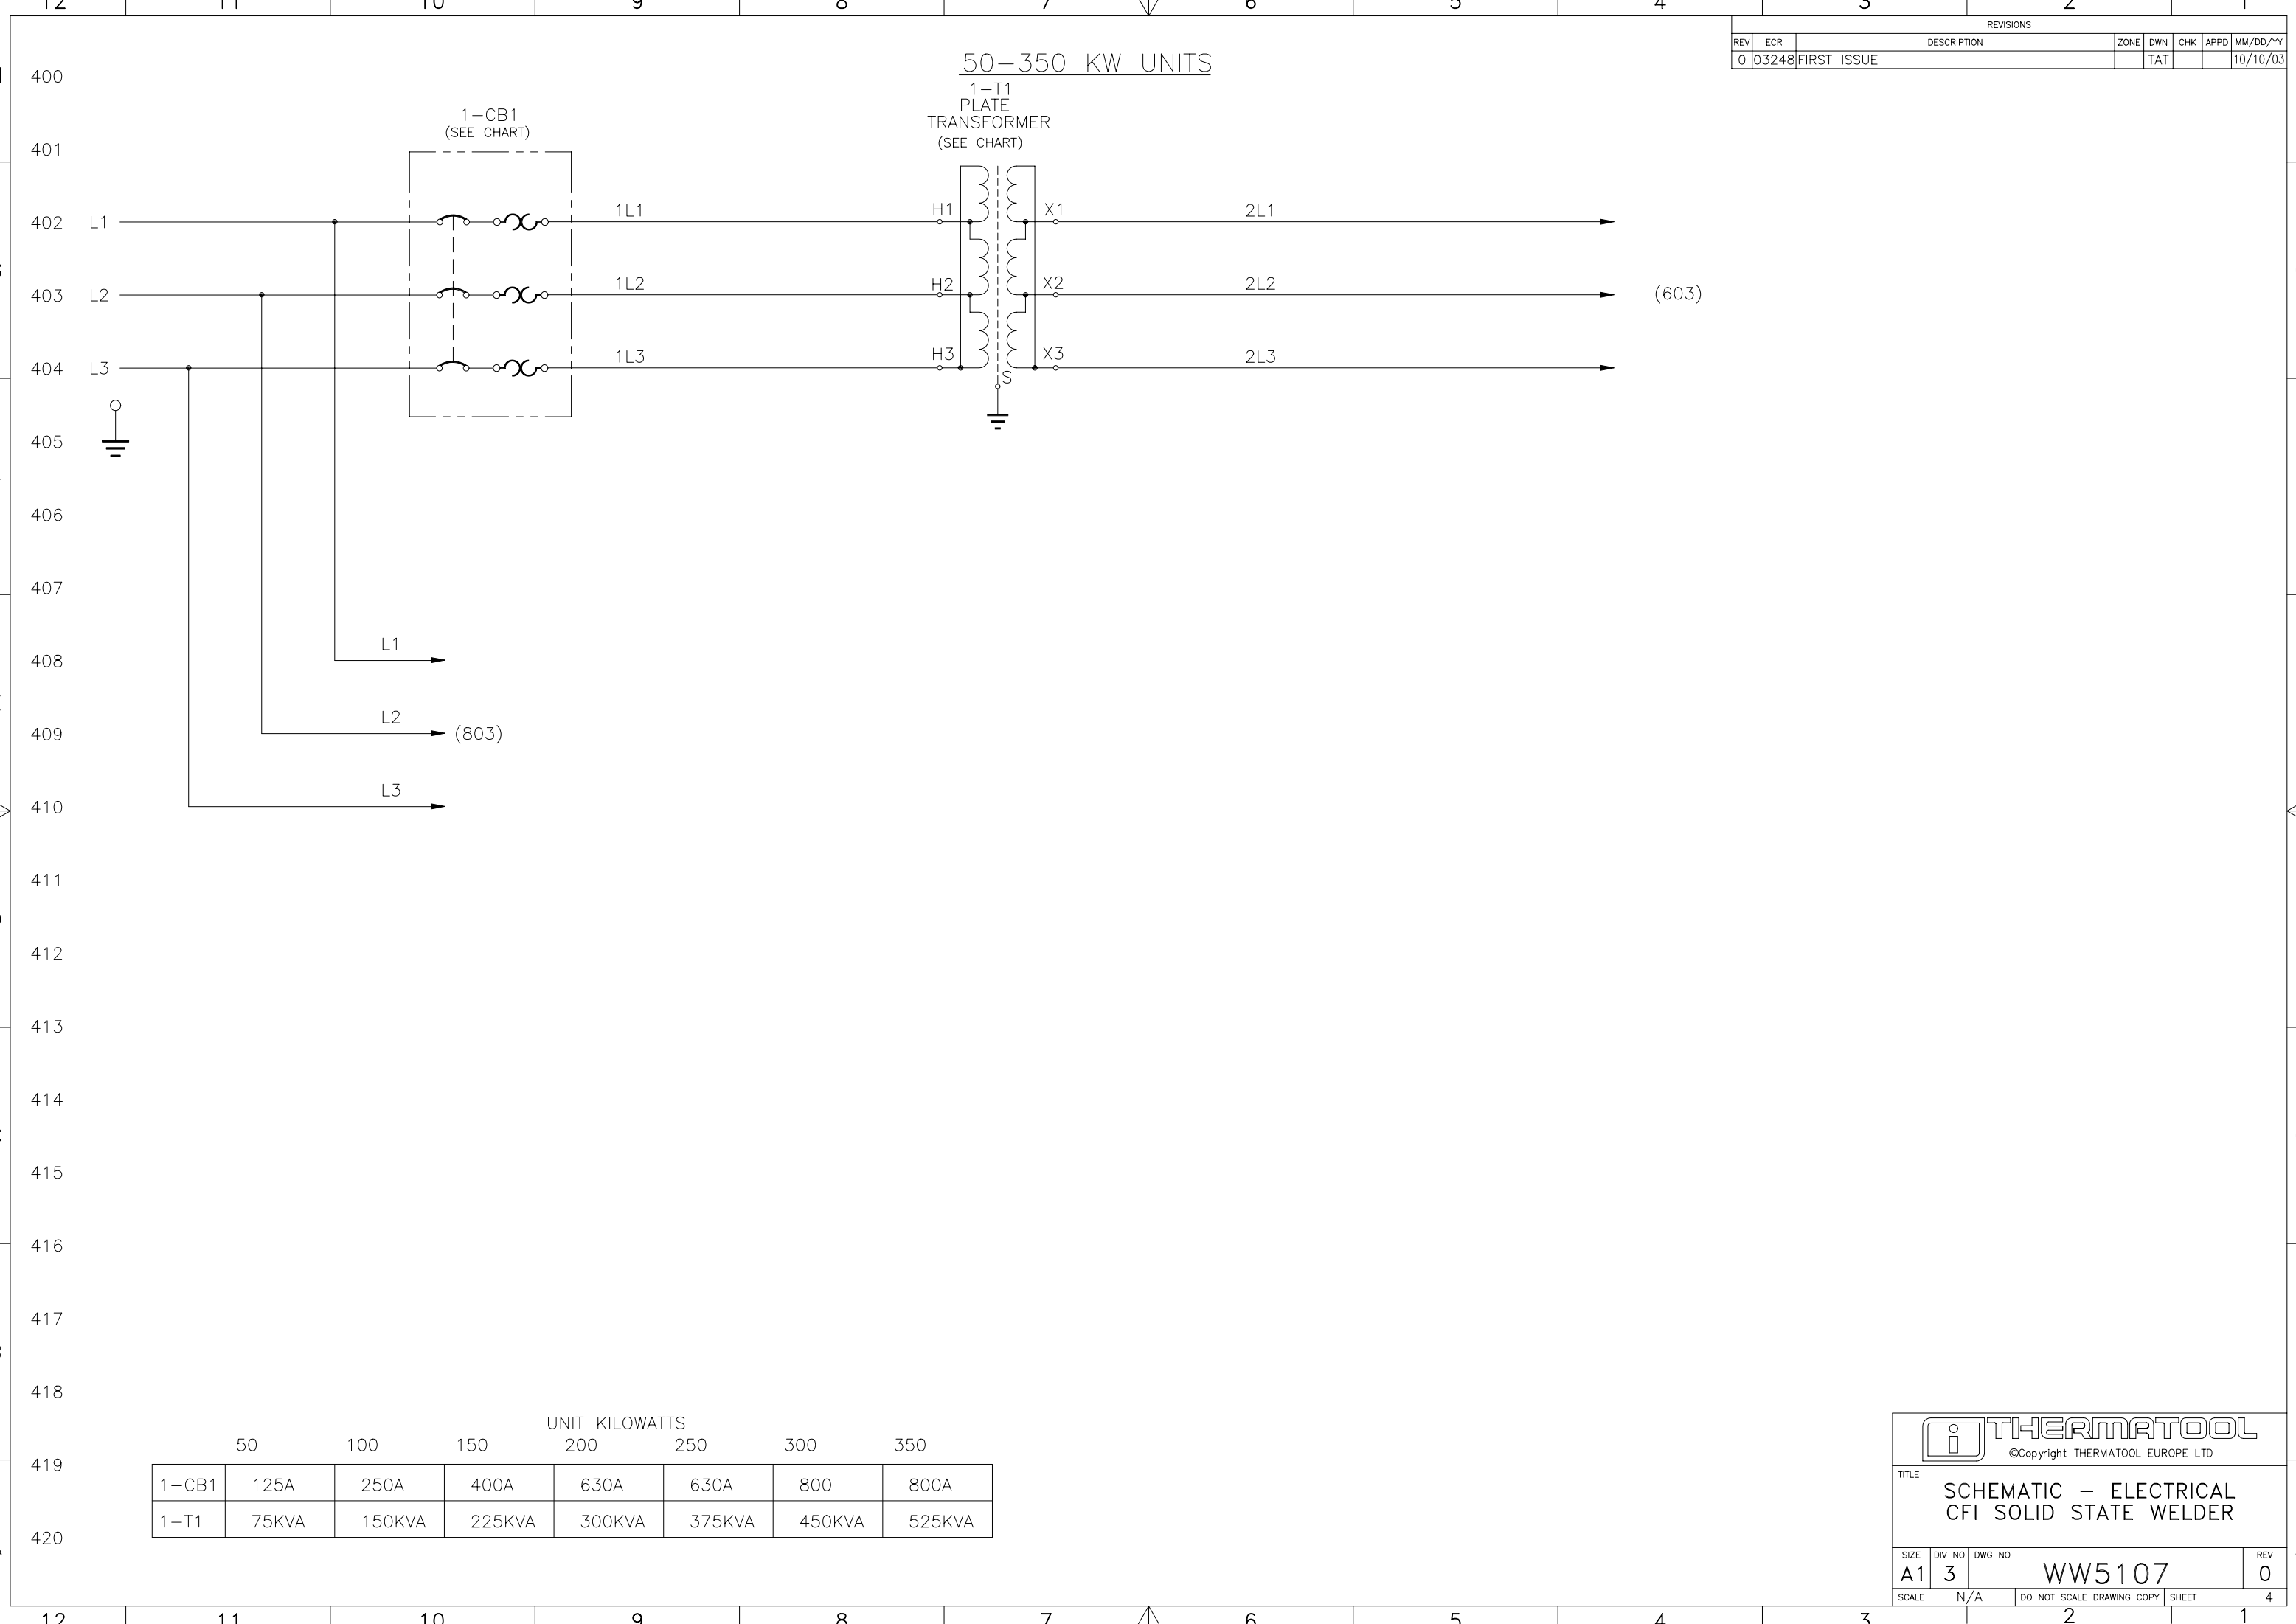

REVISIONS							
REV	ECR	DESCRIPTION	ZONE	DWN	CHK	APPD	MM/DD/YY
0	03248	FIRST ISSUE		TAT			10/10/03

50-350 KW UNITS

1-T1
PLATE
TRANSFORMER
(SEE CHART)

1-CB1
(SEE CHART)


	UNIT KILOWATTS							
	50	100	150	200	250	300	350	
1-CB1	125A	250A	400A	630A	630A	800	800A	
1-T1	75KVA	150KVA	225KVA	300KVA	375KVA	450KVA	525KVA	

THERMATOOL
©Copyright THERMATOOL EUROPE LTD

TITLE
**SCHEMATIC – ELECTRICAL
CFI SOLID STATE WELDER**

SIZE A1	DIV NO 3	DWG NO WW5107	REV 0
SCALE N/A	DO NOT SCALE DRAWING COPY		SHEET 4

ENG-REF: 2 1

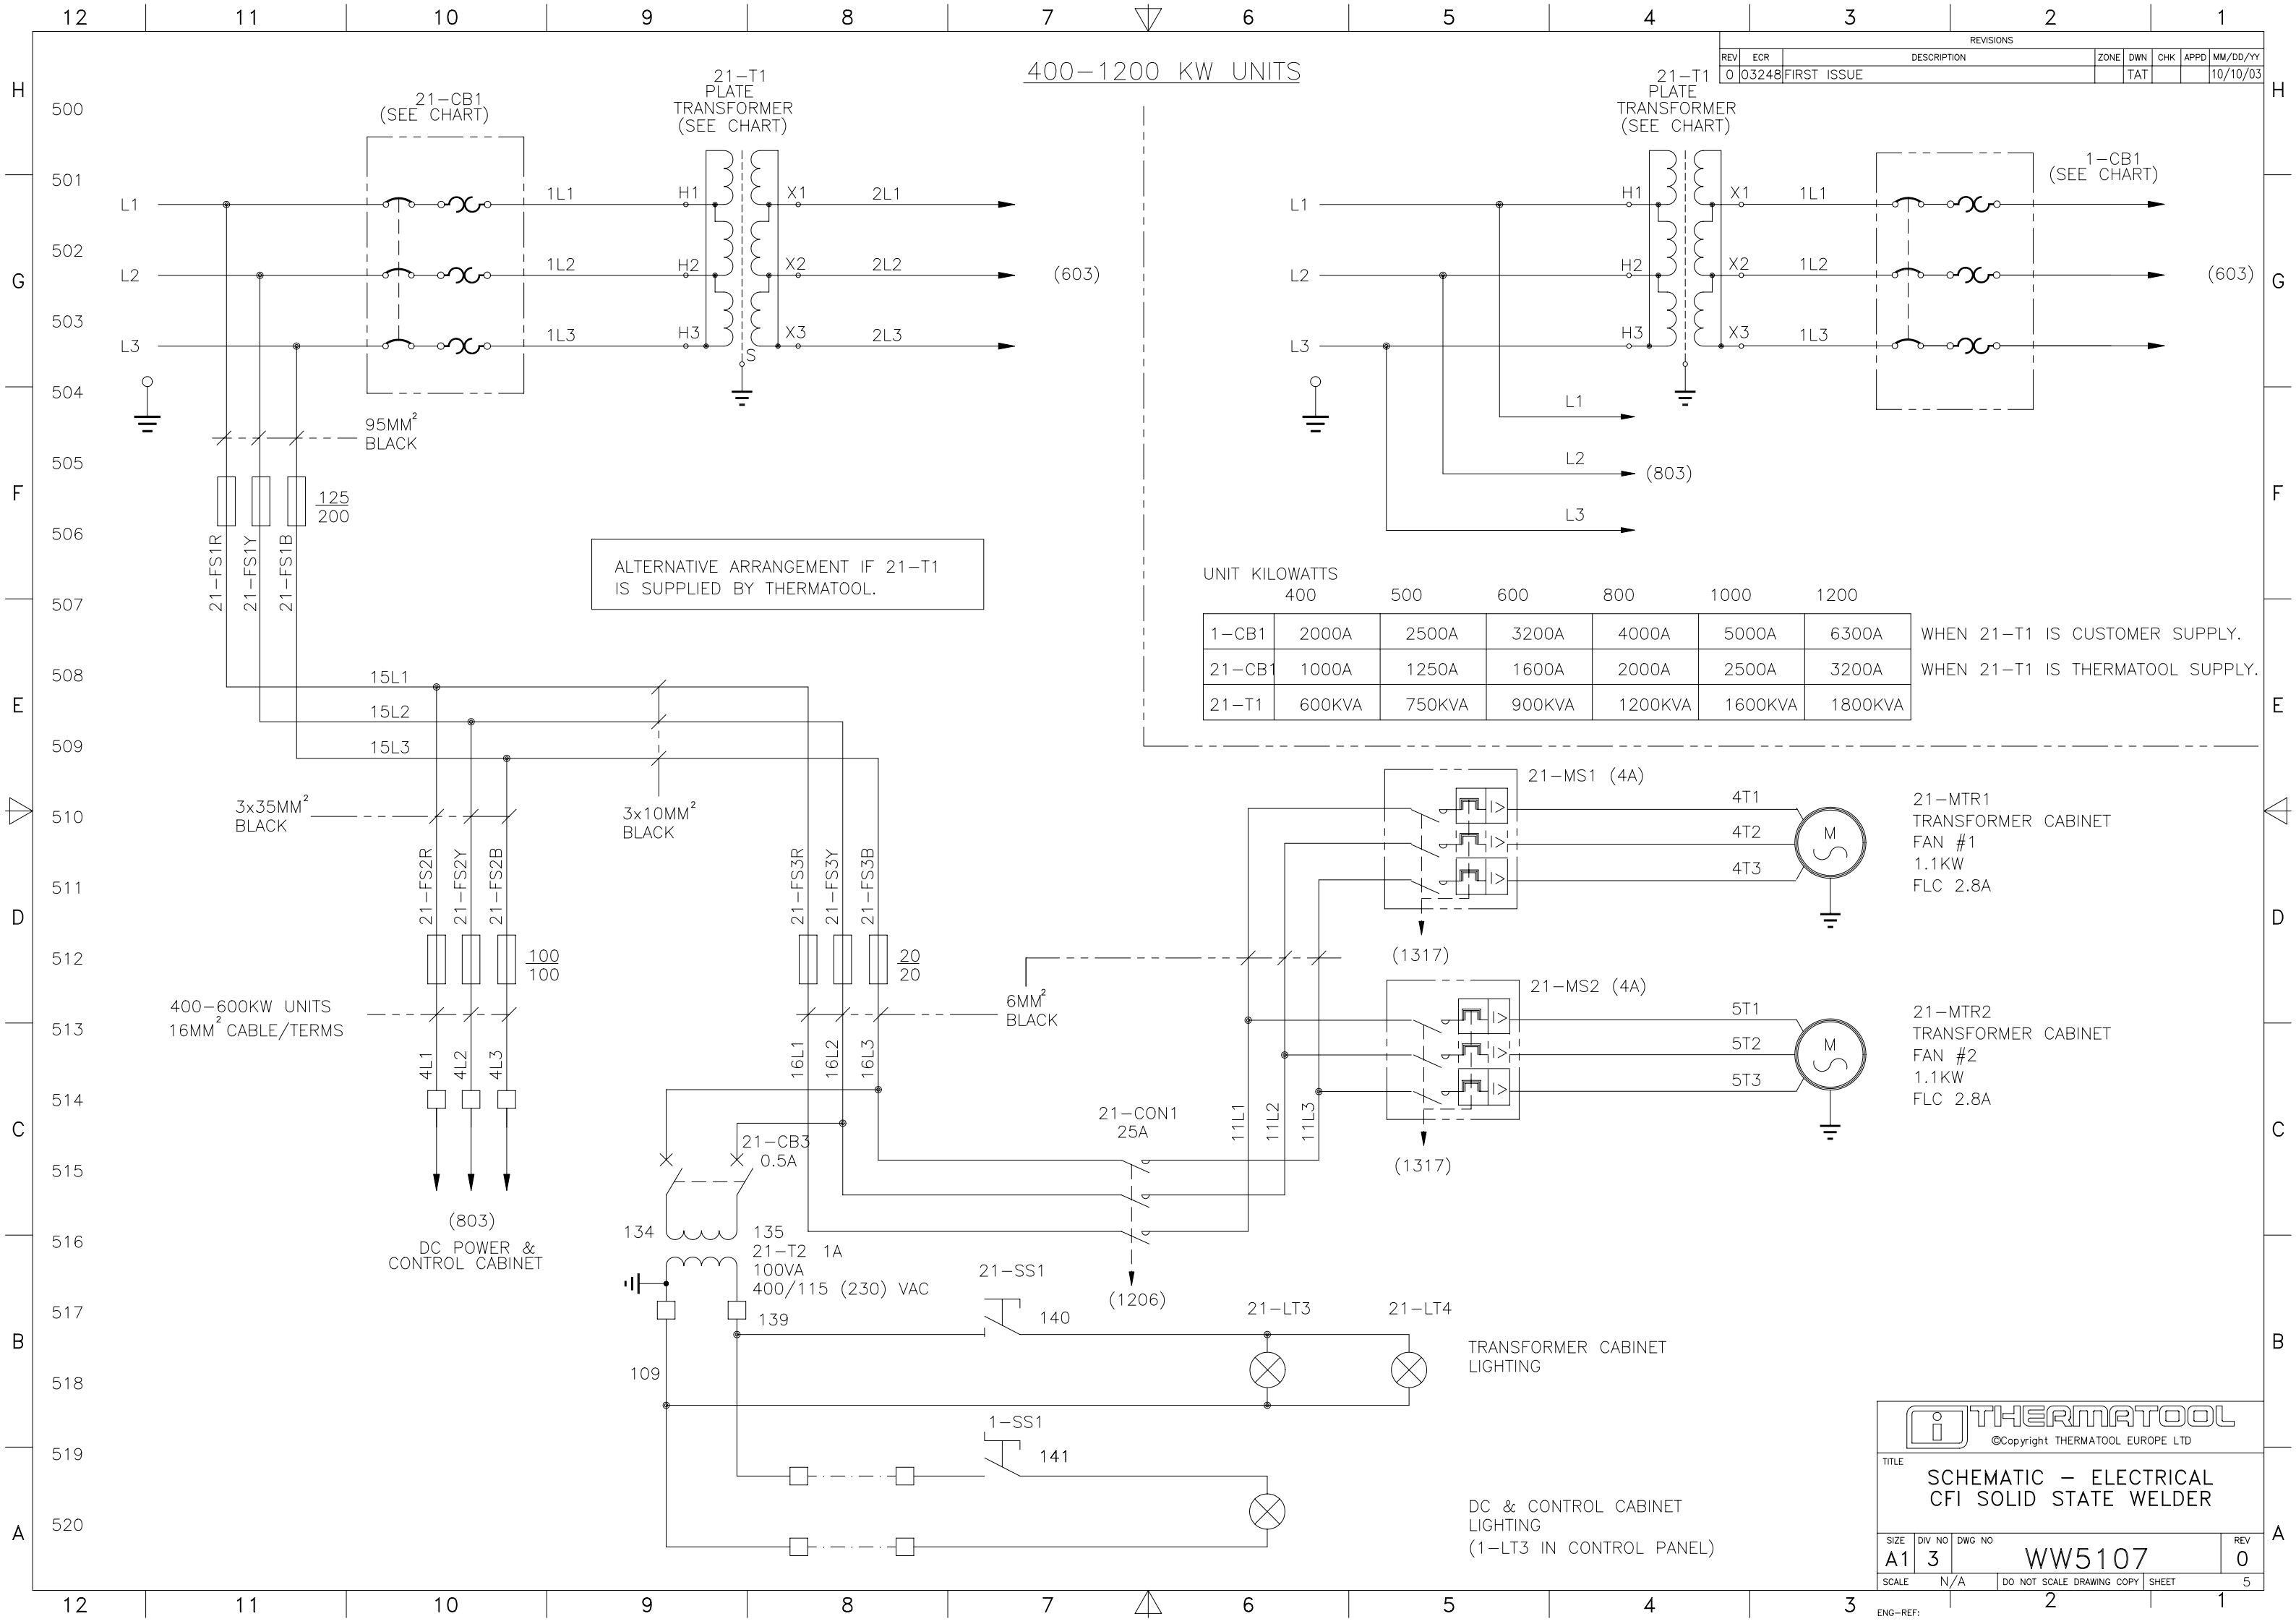

400-1200 KW UNITS

REVISIONS						
REV	ECR	DESCRIPTION	ZONE	DWN	CHK	APPD
0	03248	FIRST ISSUE		TAT		10/10/03

UNIT KILOWATTS	400	500	600	800	1000	1200
1-CB1	2000A	2500A	3200A	4000A	5000A	6300A
21-CB1	1000A	1250A	1600A	2000A	2500A	3200A
21-T1	600KVA	750KVA	900KVA	1200KVA	1600KVA	1800KVA

WHEN 21-T1 IS CUSTOMER SUPPLY.
WHEN 21-T1 IS THERMATOOL SUPPLY.

ALTERNATIVE ARRANGEMENT IF 21-T1 IS SUPPLIED BY THERMATOOL.

21-MTR1
TRANSFORMER CABINET
FAN #1
1.1KW
FLC 2.8A

21-MTR2
TRANSFORMER CABINET
FAN #2
1.1KW
FLC 2.8A

TRANSFORMER CABINET LIGHTING

DC & CONTROL CABINET LIGHTING
(1-LT3 IN CONTROL PANEL)

THERMATOOL
©Copyright THERMATOOL EUROPE LTD


TITLE
SCHEMATIC - ELECTRICAL CFI SOLID STATE WELDER

SIZE A1	DIV NO 3	DWG NO WW5107	REV 0
SCALE N/A	DO NOT SCALE DRAWING COPY		SHEET 5

ENG-REF: 2

AC POWER DISTRIBUTION (CURRENT FEEDBACK)

REVISIONS						
REV	ECR	DESCRIPTION	ZONE	DWN	CHK	APPD
0	03248	FIRST ISSUE		TAT		
						MM/DD/YY
						10/10/03

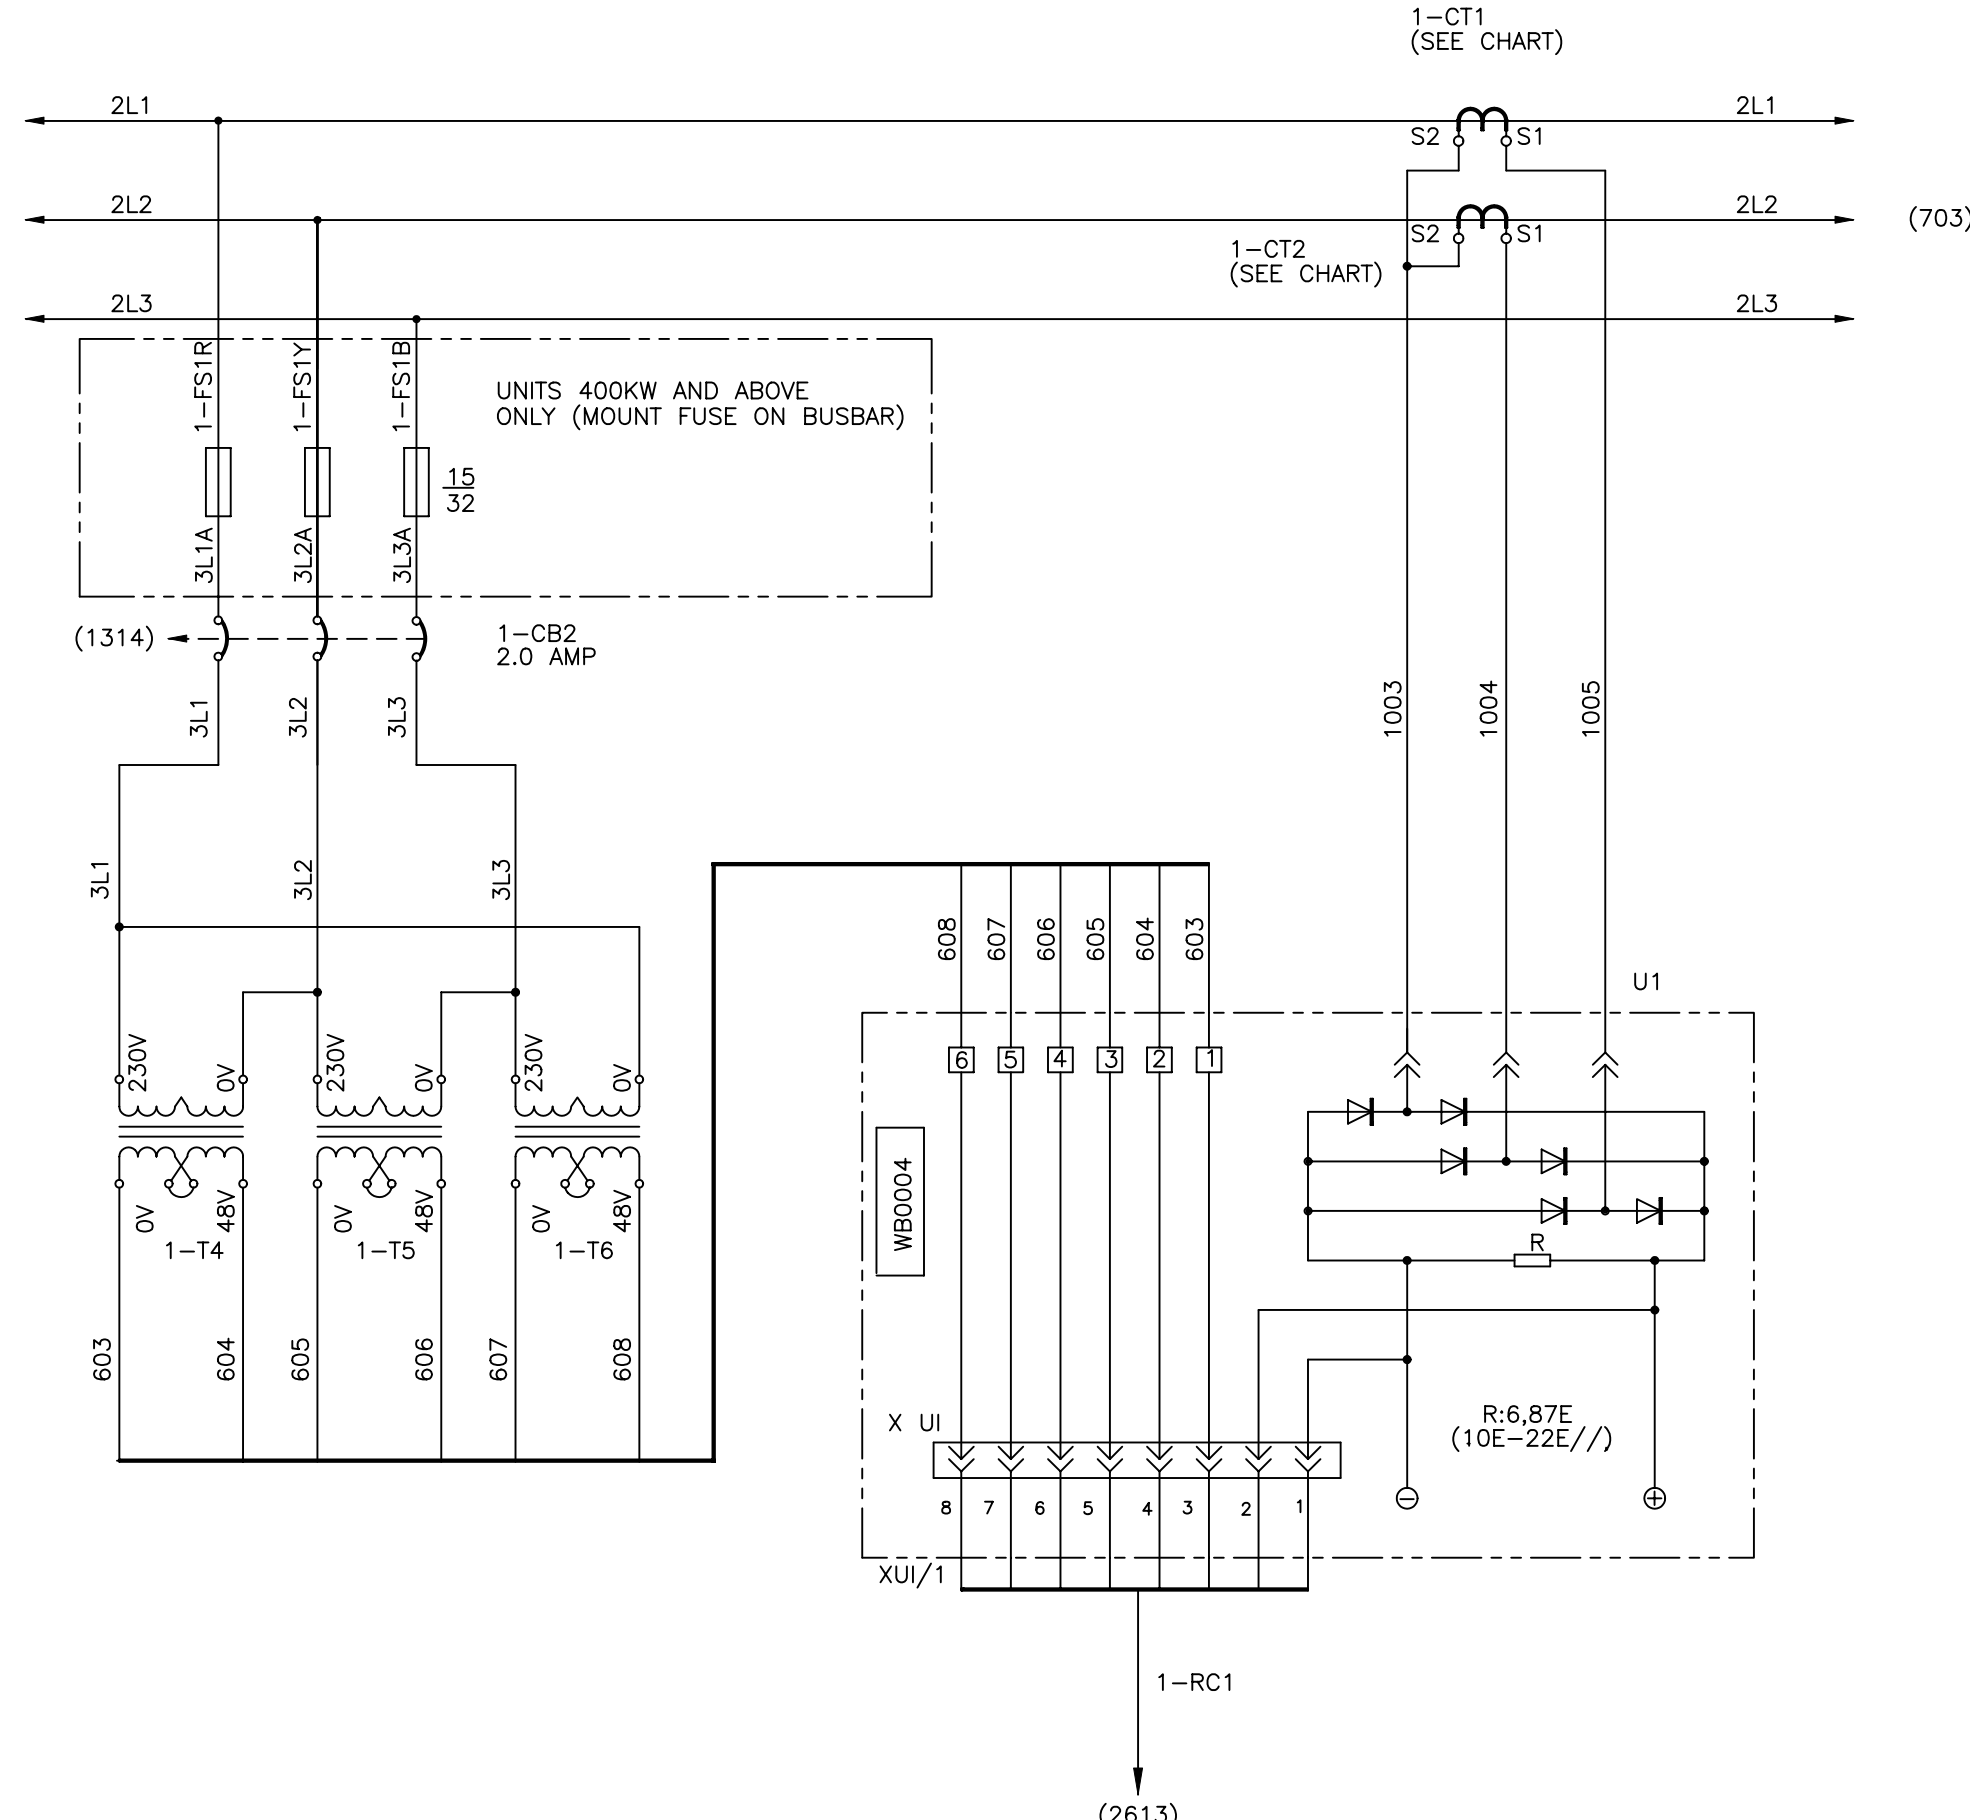

UNITS 400KW AND ABOVE ONLY (MOUNT FUSE ON BUSBAR)

UNIT KILOWATTS	1-CT1,1-CT2 RATIO
50KW	300:1
100KW	600:1
150KW	1000:1
200KW	1250:1
250KW	1800:1
300KW	1800:1
350KW	2500:1
400KW	2500:1
500KW	3500:1
600KW	3500:1
800KW	5000:1
1000KW	6000:1
1200KW	8000:1

THERMATOOL
©Copyright THERMATOOL EUROPE LTD


TITLE
**SCHEMATIC – ELECTRICAL
CFI SOLID STATE WELDER**

SIZE A1	DIV NO 3	DWG NO WW5107	REV 0
SCALE N/A	DO NOT SCALE DRAWING COPY		SHEET 6



ENG-REF: 2

AC POWER DISTRIBUTION (DC RECTIFIERS)

REVISIONS						
REV	ECR	DESCRIPTION	ZONE	DWN	CHK	APPD
0	03248	FIRST ISSUE		TAT		MM/DD/YY 10/10/03

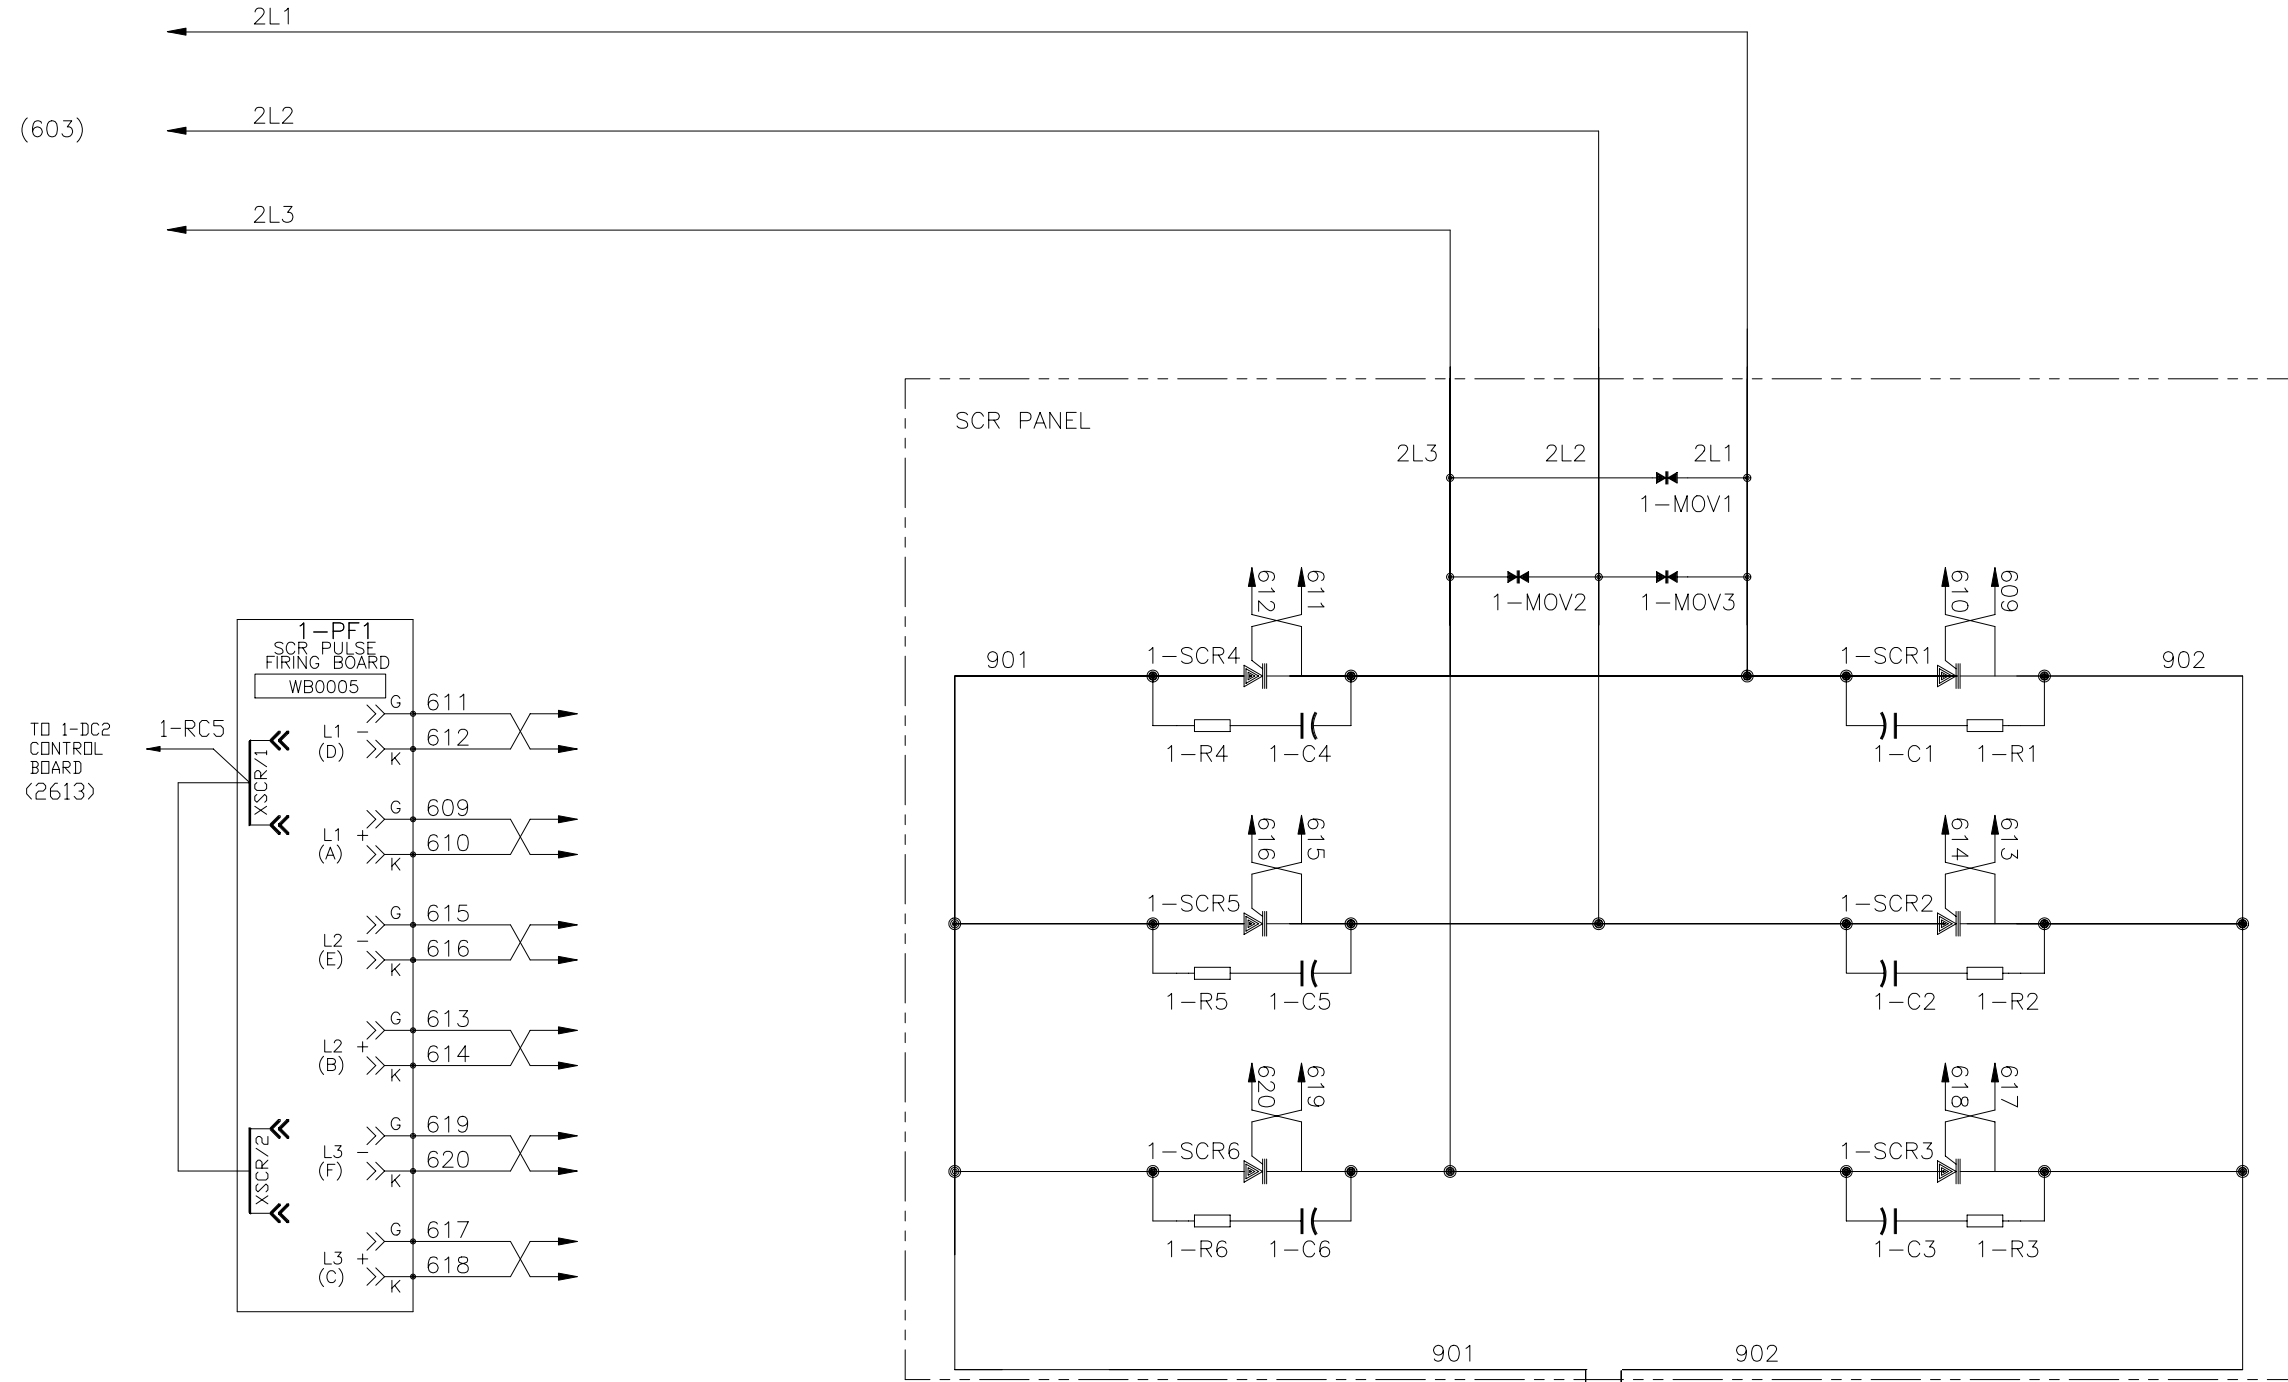

UNIT KILOWATTS	1-L1	"ALTERNATE"
50	4.22mH	
100	2.11mH @520ADC	
150	1.40mH @781ADC	1.40mH @1042@DC
200	1.05mH @1042ADC	
250	0.84mH @1302ADC	0.84mH @1563ADC
300	0.70mH @1563ADC	
350	0.61mH @1800ADC	0.61mH @2057ADC
400	0.53mH @2057ADC	
500	0.42mH @2575ADC	0.42mH @3091ADC
600	0.35mH @3091ADC	
800	0.27mH @4096ADC	0.27mH @5121ADC
1000	0.21mH @5121ADC	
1200	0.18mH	

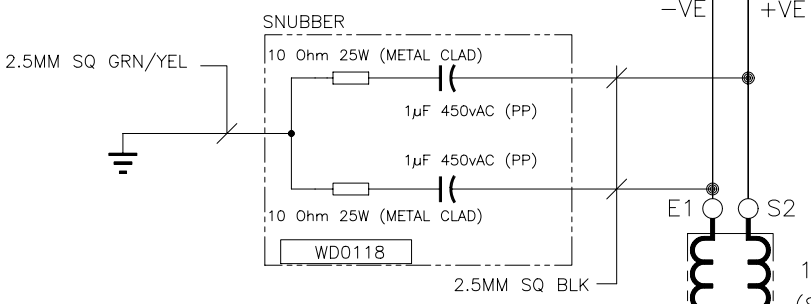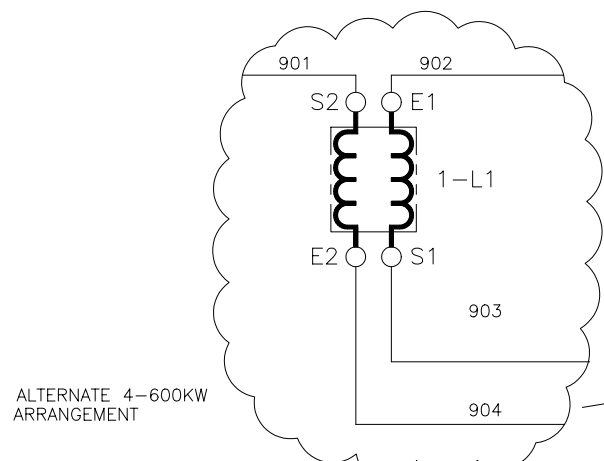

THERMATOOL
©Copyright THERMATOOL EUROPE LTD

TITLE: SCHEMATIC – ELECTRICAL CFI SOLID STATE WELDER

SIZE: A1 | DIV NO: 3 | DWG NO: WW5107 | REV: 0


SCALE: N/A | DO NOT SCALE DRAWING COPY | SHEET: 7

ENG-REF: 2

(3201)

REVISIONS						
REV	ECR	DESCRIPTION	ZONE	DWN	CHK	APPD
0	03248	FIRST ISSUE		TAT		10/10/03
A	04102	CB4 WAS 6A (INRUSH 30x ON T2 FROM BWS)		TAT		07/16/04
B	04256	CB6 WAS 7A (INRUSH 30x ON T3 FROM BWS)		TAT		11/17/04

AC POWER DISTRIBUTION (AUXILLARY CONTROLS)

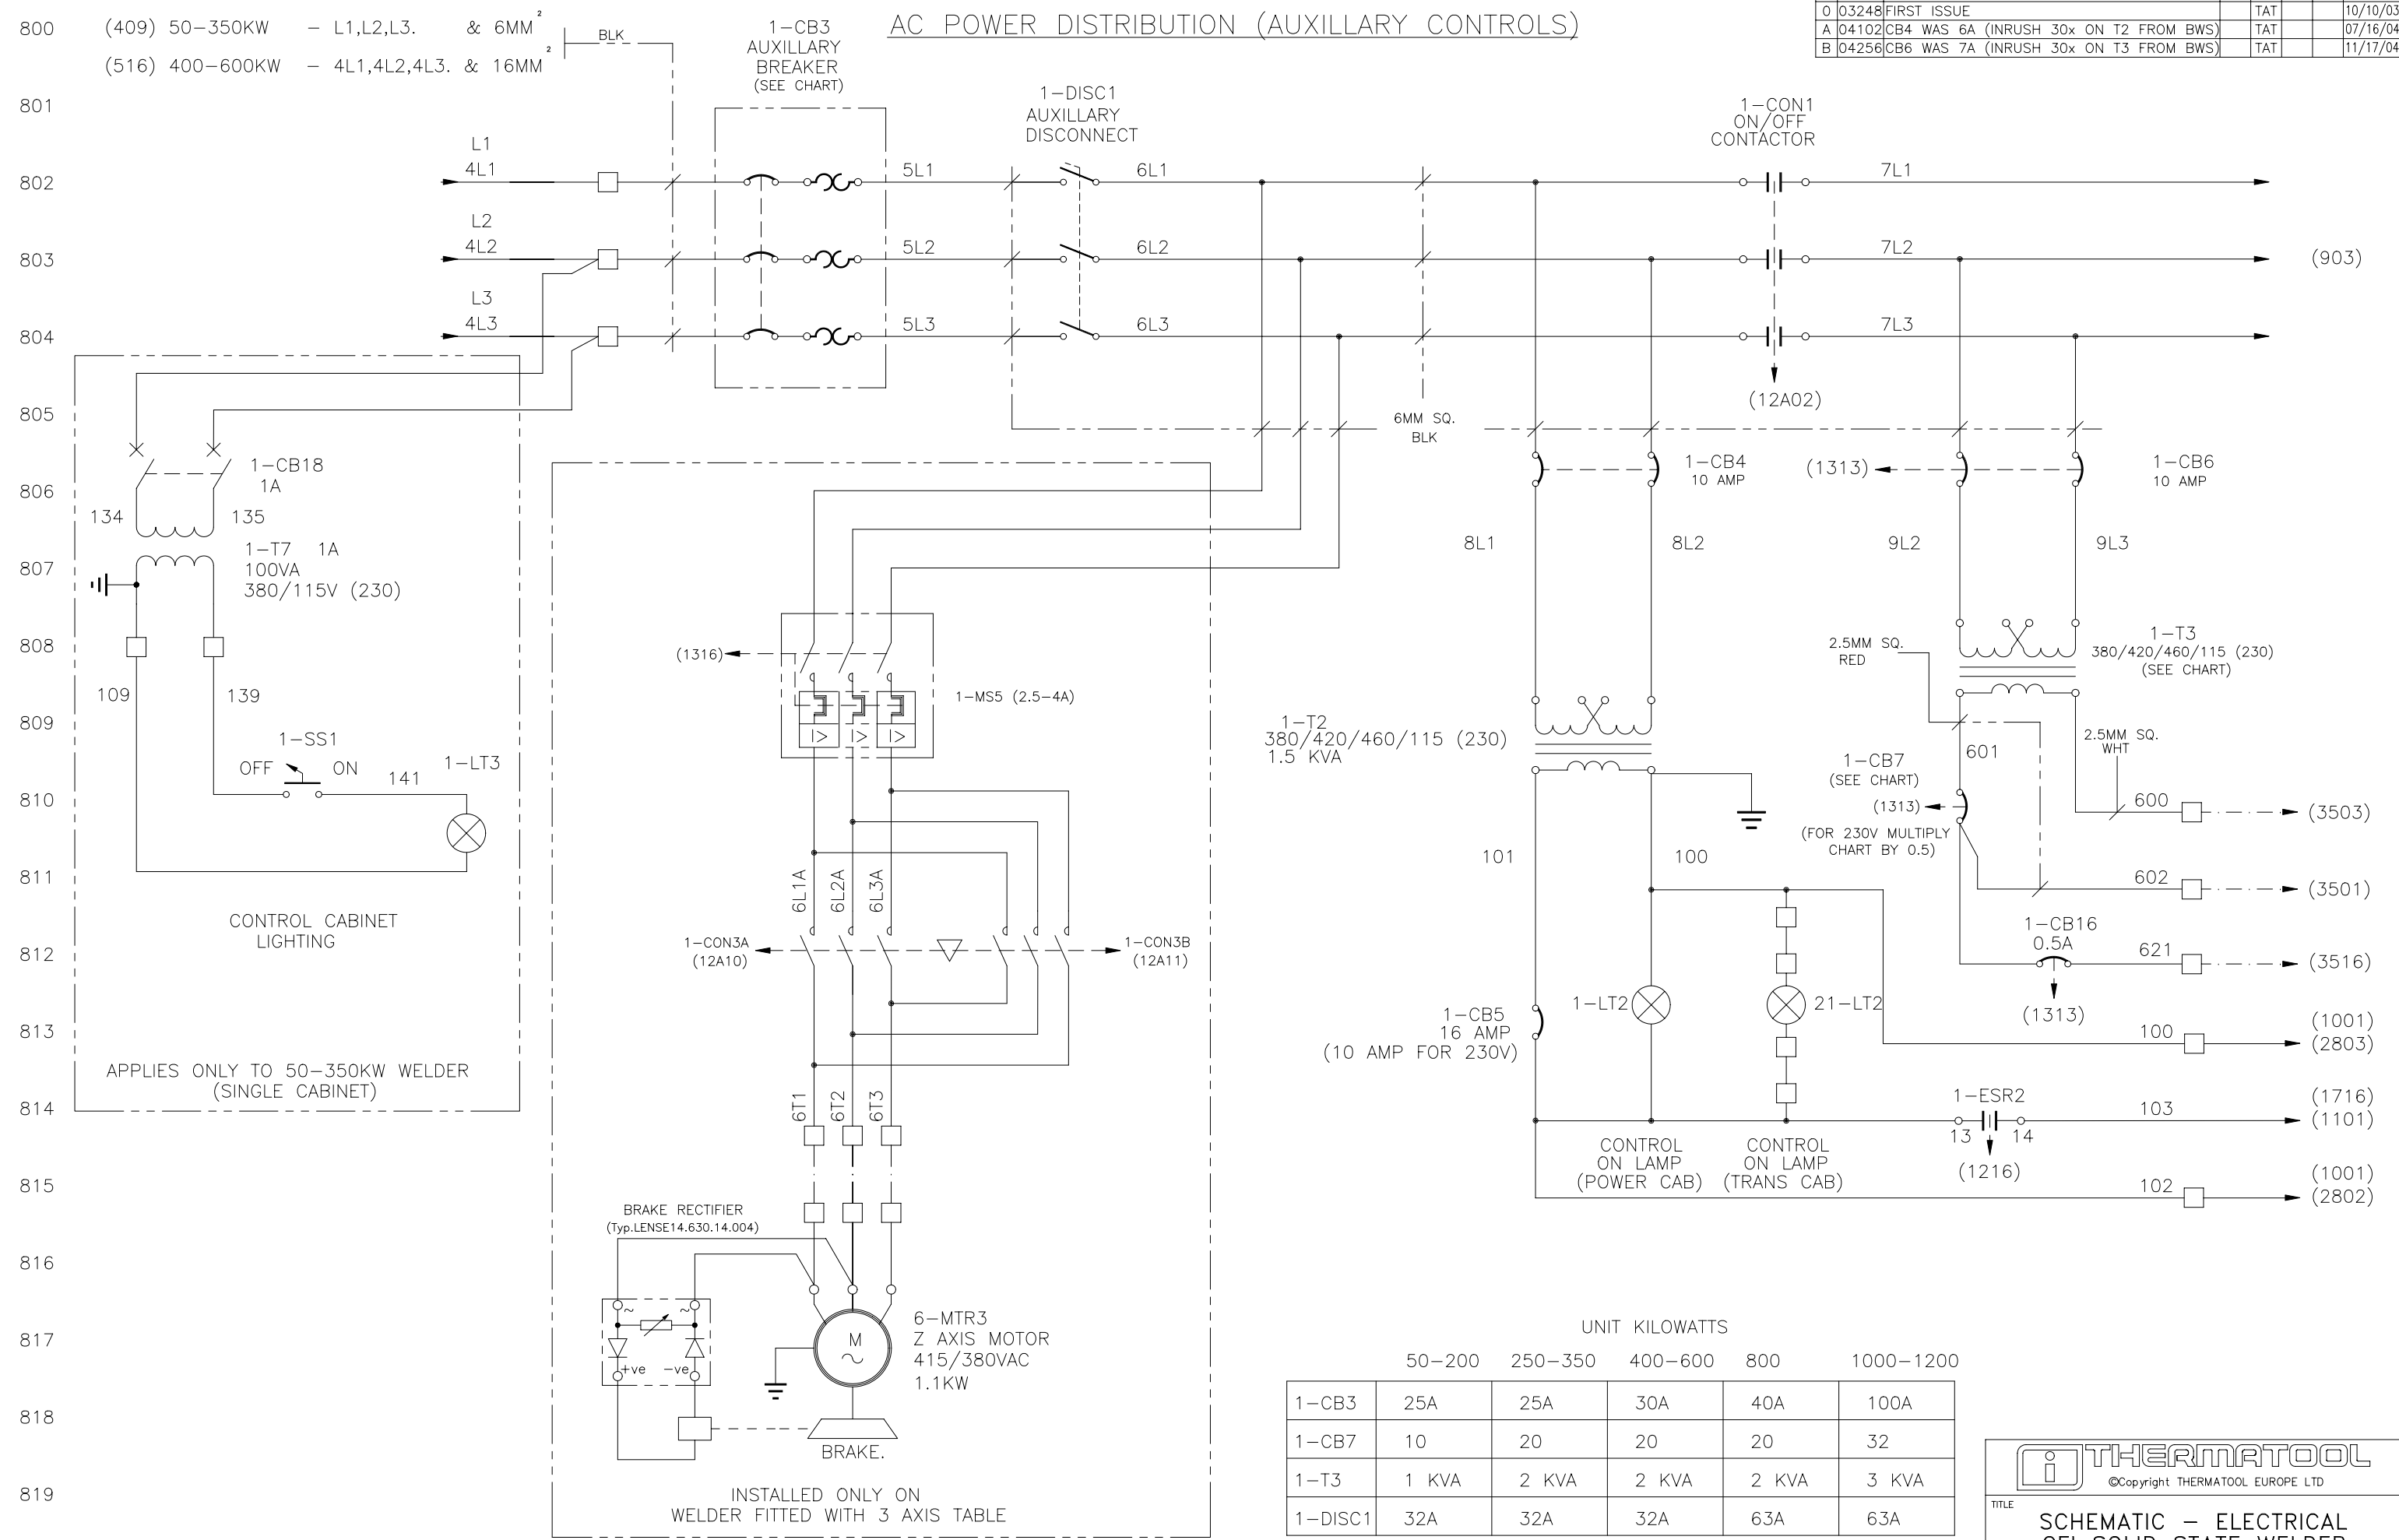

CONTROL CABINET LIGHTING
 APPLIES ONLY TO 50-350KW WELDER (SINGLE CABINET)

INSTALLED ONLY ON WELDER FITTED WITH 3 AXIS TABLE

	UNIT KILOWATTS				
	50-200	250-350	400-600	800	1000-1200
1-CB3	25A	25A	30A	40A	100A
1-CB7	10	20	20	20	32
1-T3	1 KVA	2 KVA	2 KVA	2 KVA	3 KVA
1-DISC1	32A	32A	32A	63A	63A

THERMATOOL
 ©Copyright THERMATOOL EUROPE LTD


TITLE: **SCHEMATIC - ELECTRICAL CFI SOLID STATE WELDER**

SIZE	DIV NO	DWG NO	REV
A1	3	WW5107	B

SCALE: N/A DO NOT SCALE DRAWING COPY SHEET 8

AC POWER DISTRIBUTION

REVISIONS							
REV	ECR	DESCRIPTION	ZONE	DWN	CHK	APPD	MM/DD/YY
0	03248	FIRST ISSUE			TAT		10/10/03
D	06151	50-150KW PUMPS WERE 2.2KW NOW 5.5KW	10A		TAT		06/23/06

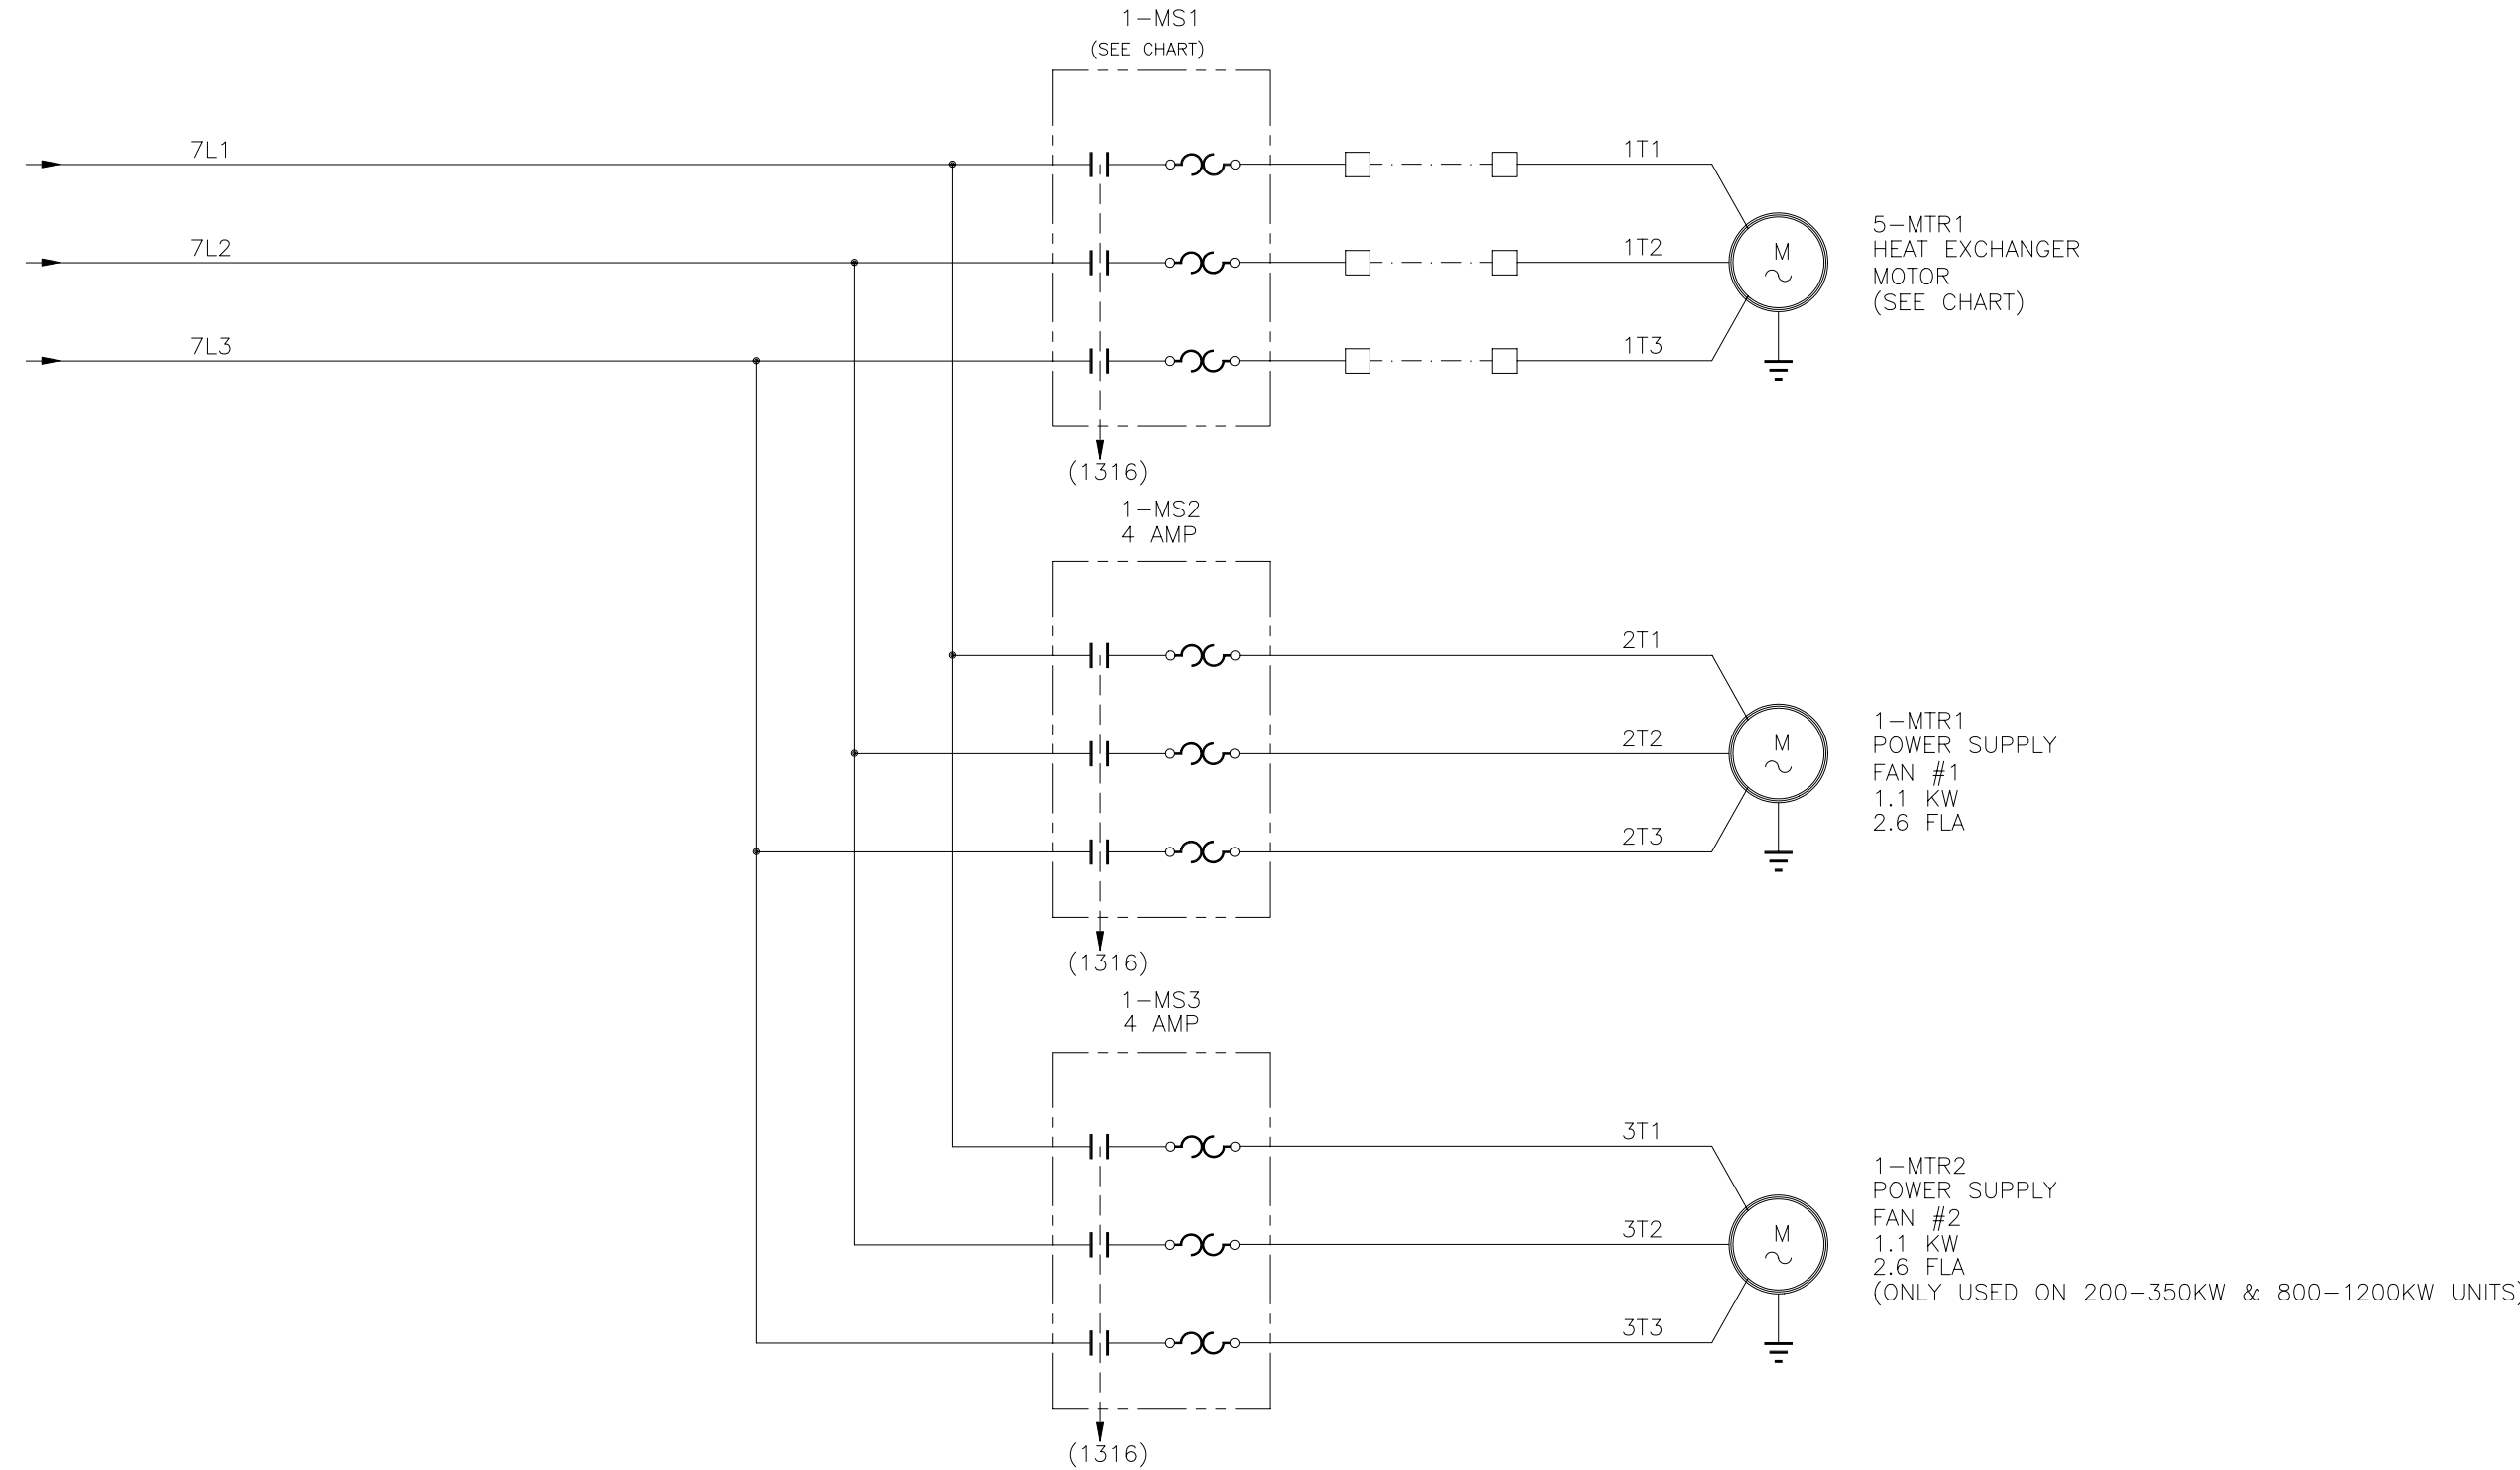

5-MTR1
HEAT EXCHANGER
MOTOR
(SEE CHART)

1-MTR1
POWER SUPPLY
FAN #1
1.1 KW
2.6 FLA

1-MTR2
POWER SUPPLY
FAN #2
1.1 KW
2.6 FLA
(ONLY USED ON 200-350KW & 800-1200KW UNITS)

50/60HZ	UNIT KILOWATTS			
	50-350	400-600	800-1200	
1-MS1	16A	16 A	50 A	
5-MTR1	5.5 KW	7.5 KW	22 KW	

THERMATOOL
©Copyright THERMATOOL EUROPE LTD





TITLE
**ELECTRICAL - SCHEMATIC
CFI SOLID STATE WELDER**

SIZE A1	DIV NO 3	DWG NO WW5107	REV D
SCALE N/A	DO NOT SCALE DRAWING COPY		SHEET 9

ENG-REF: 2

AC CONTROL

REVISIONS						
REV	ECR	DESCRIPTION	ZONE	DWN	CHK	APPD
0	03248	FIRST ISSUE		TAT		10/10/03
A	04102	ALTRNT WIRNG 1-CB1(NZM1,2,3,4,7,10,12+IZM)		TAT		07/15/04

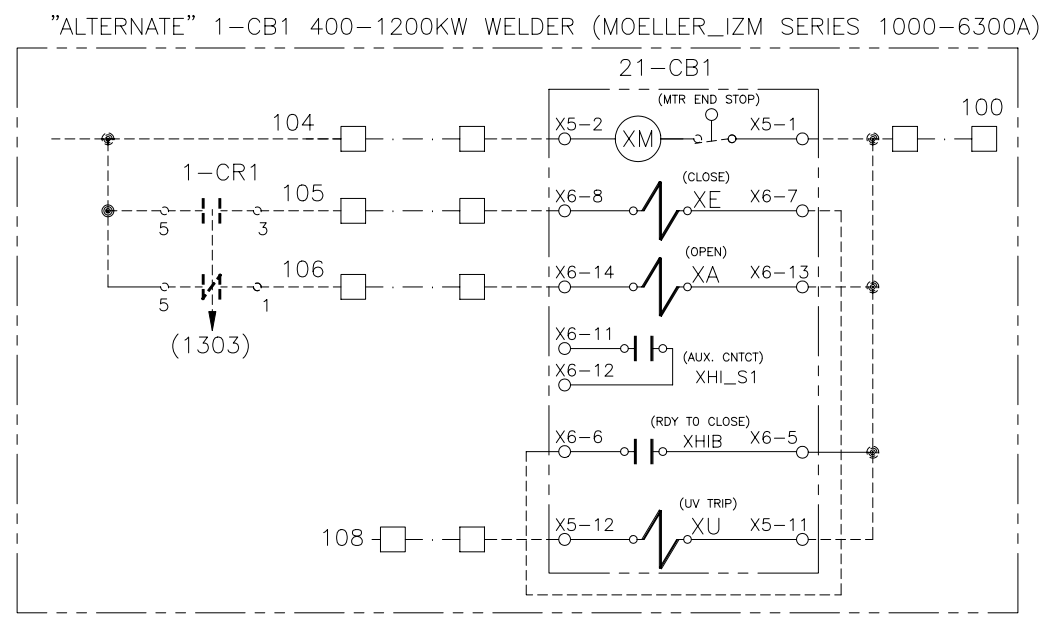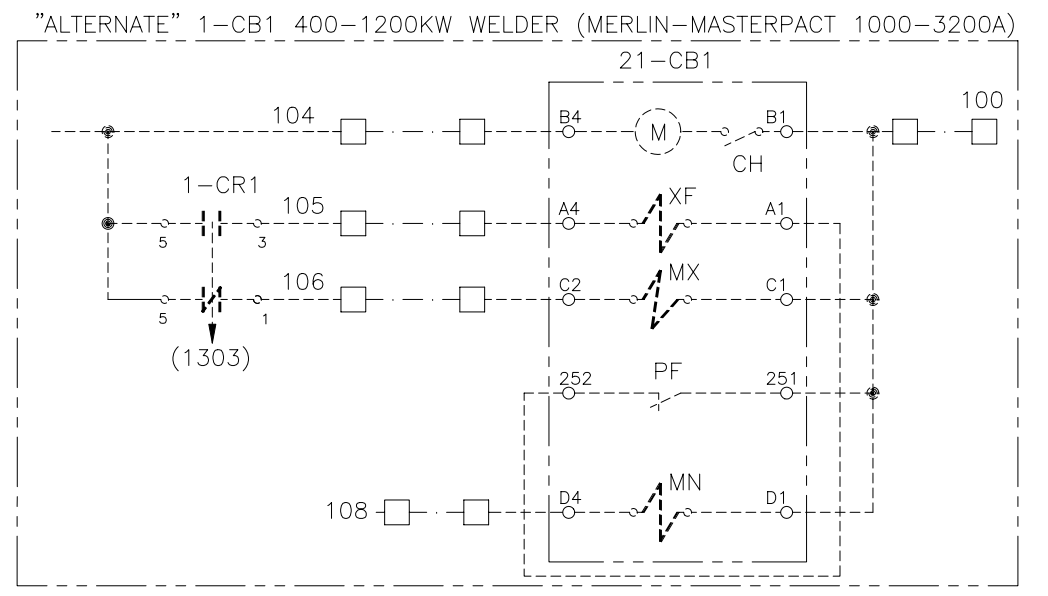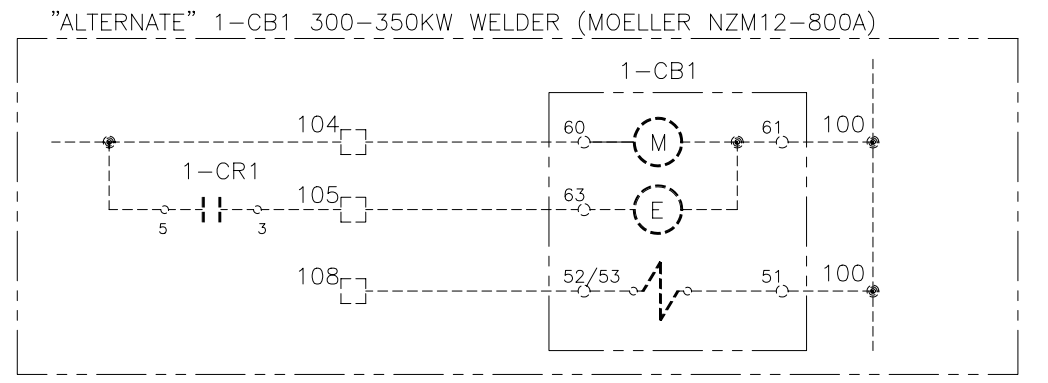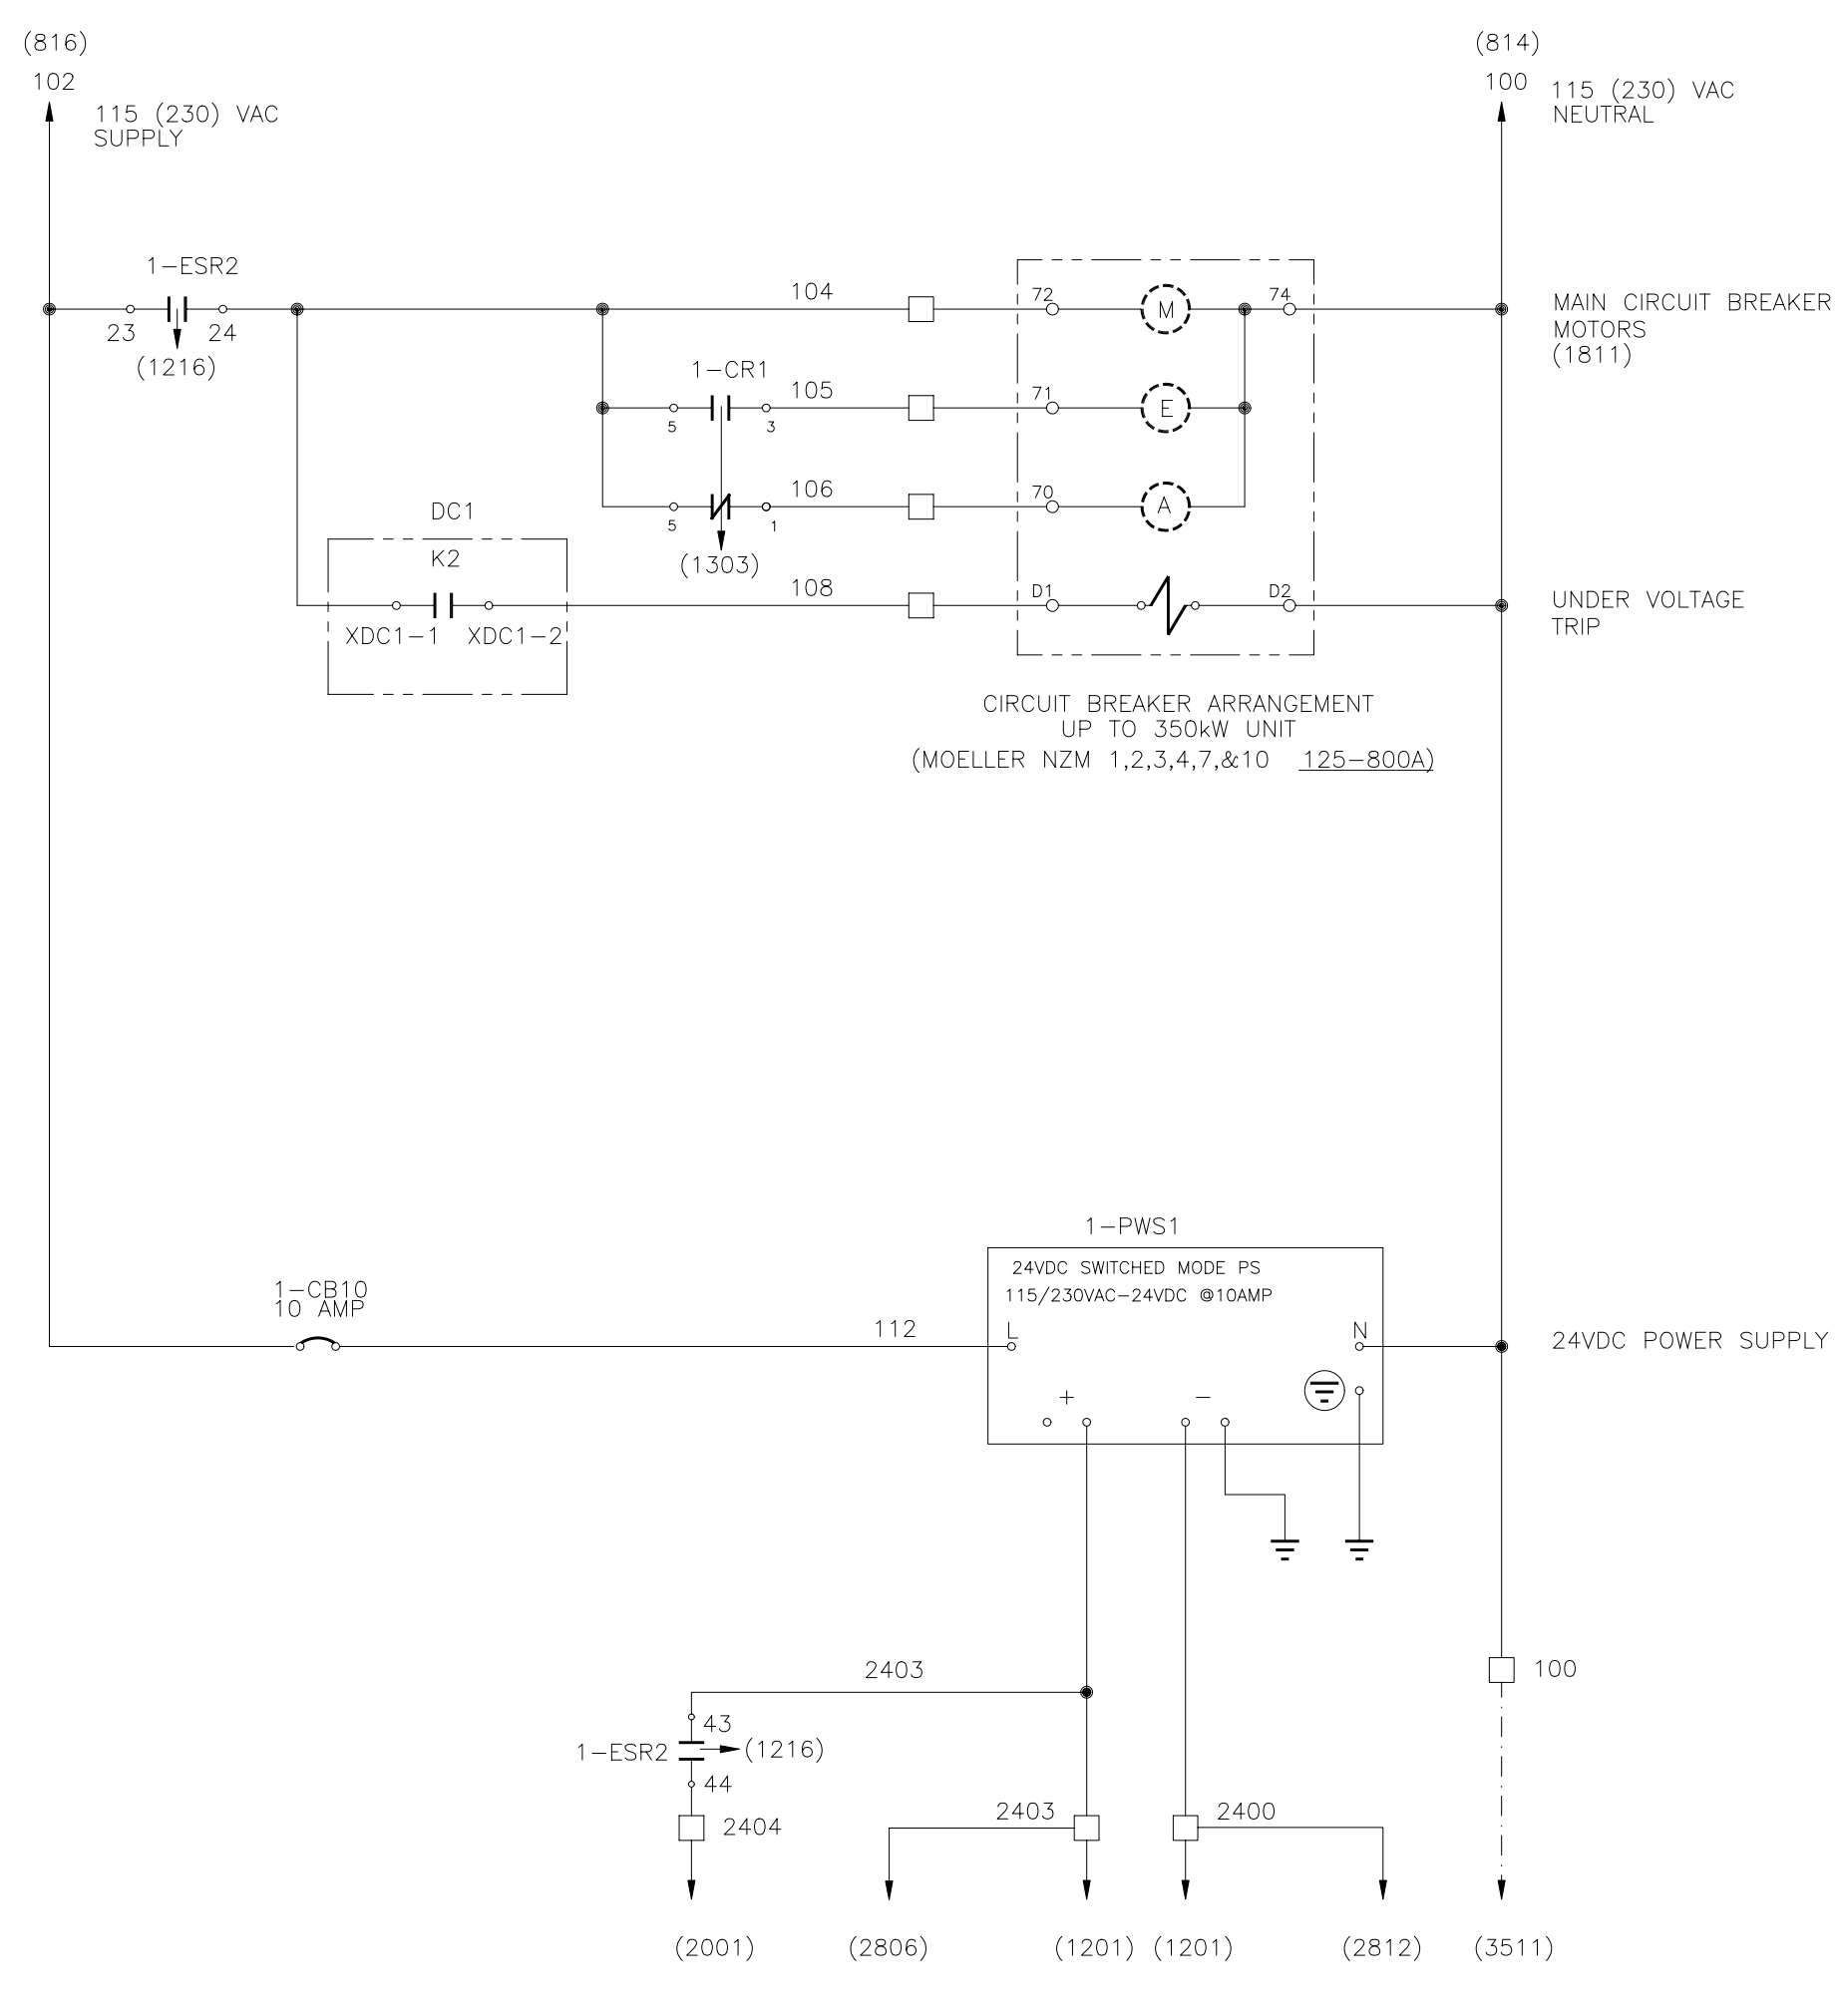

THERMATOOL
©Copyright THERMATOOL EUROPE LTD


TITLE
**SCHEMATIC - ELECTRICAL
CFI SOLID STATE WELDER**

SIZE A1	DIV NO 3	DWG NO WW5107	REV A
SCALE N/A	DO NOT SCALE DRAWING COPY SHEET		10

ENG-REF: 2

SINGLE PHASE AC MOTORS, CONTROL

REVISIONS						
REV	ECR	DESCRIPTION	ZONE	DWN	CHK	APPD
0		FIRST ISSUE		TAT		

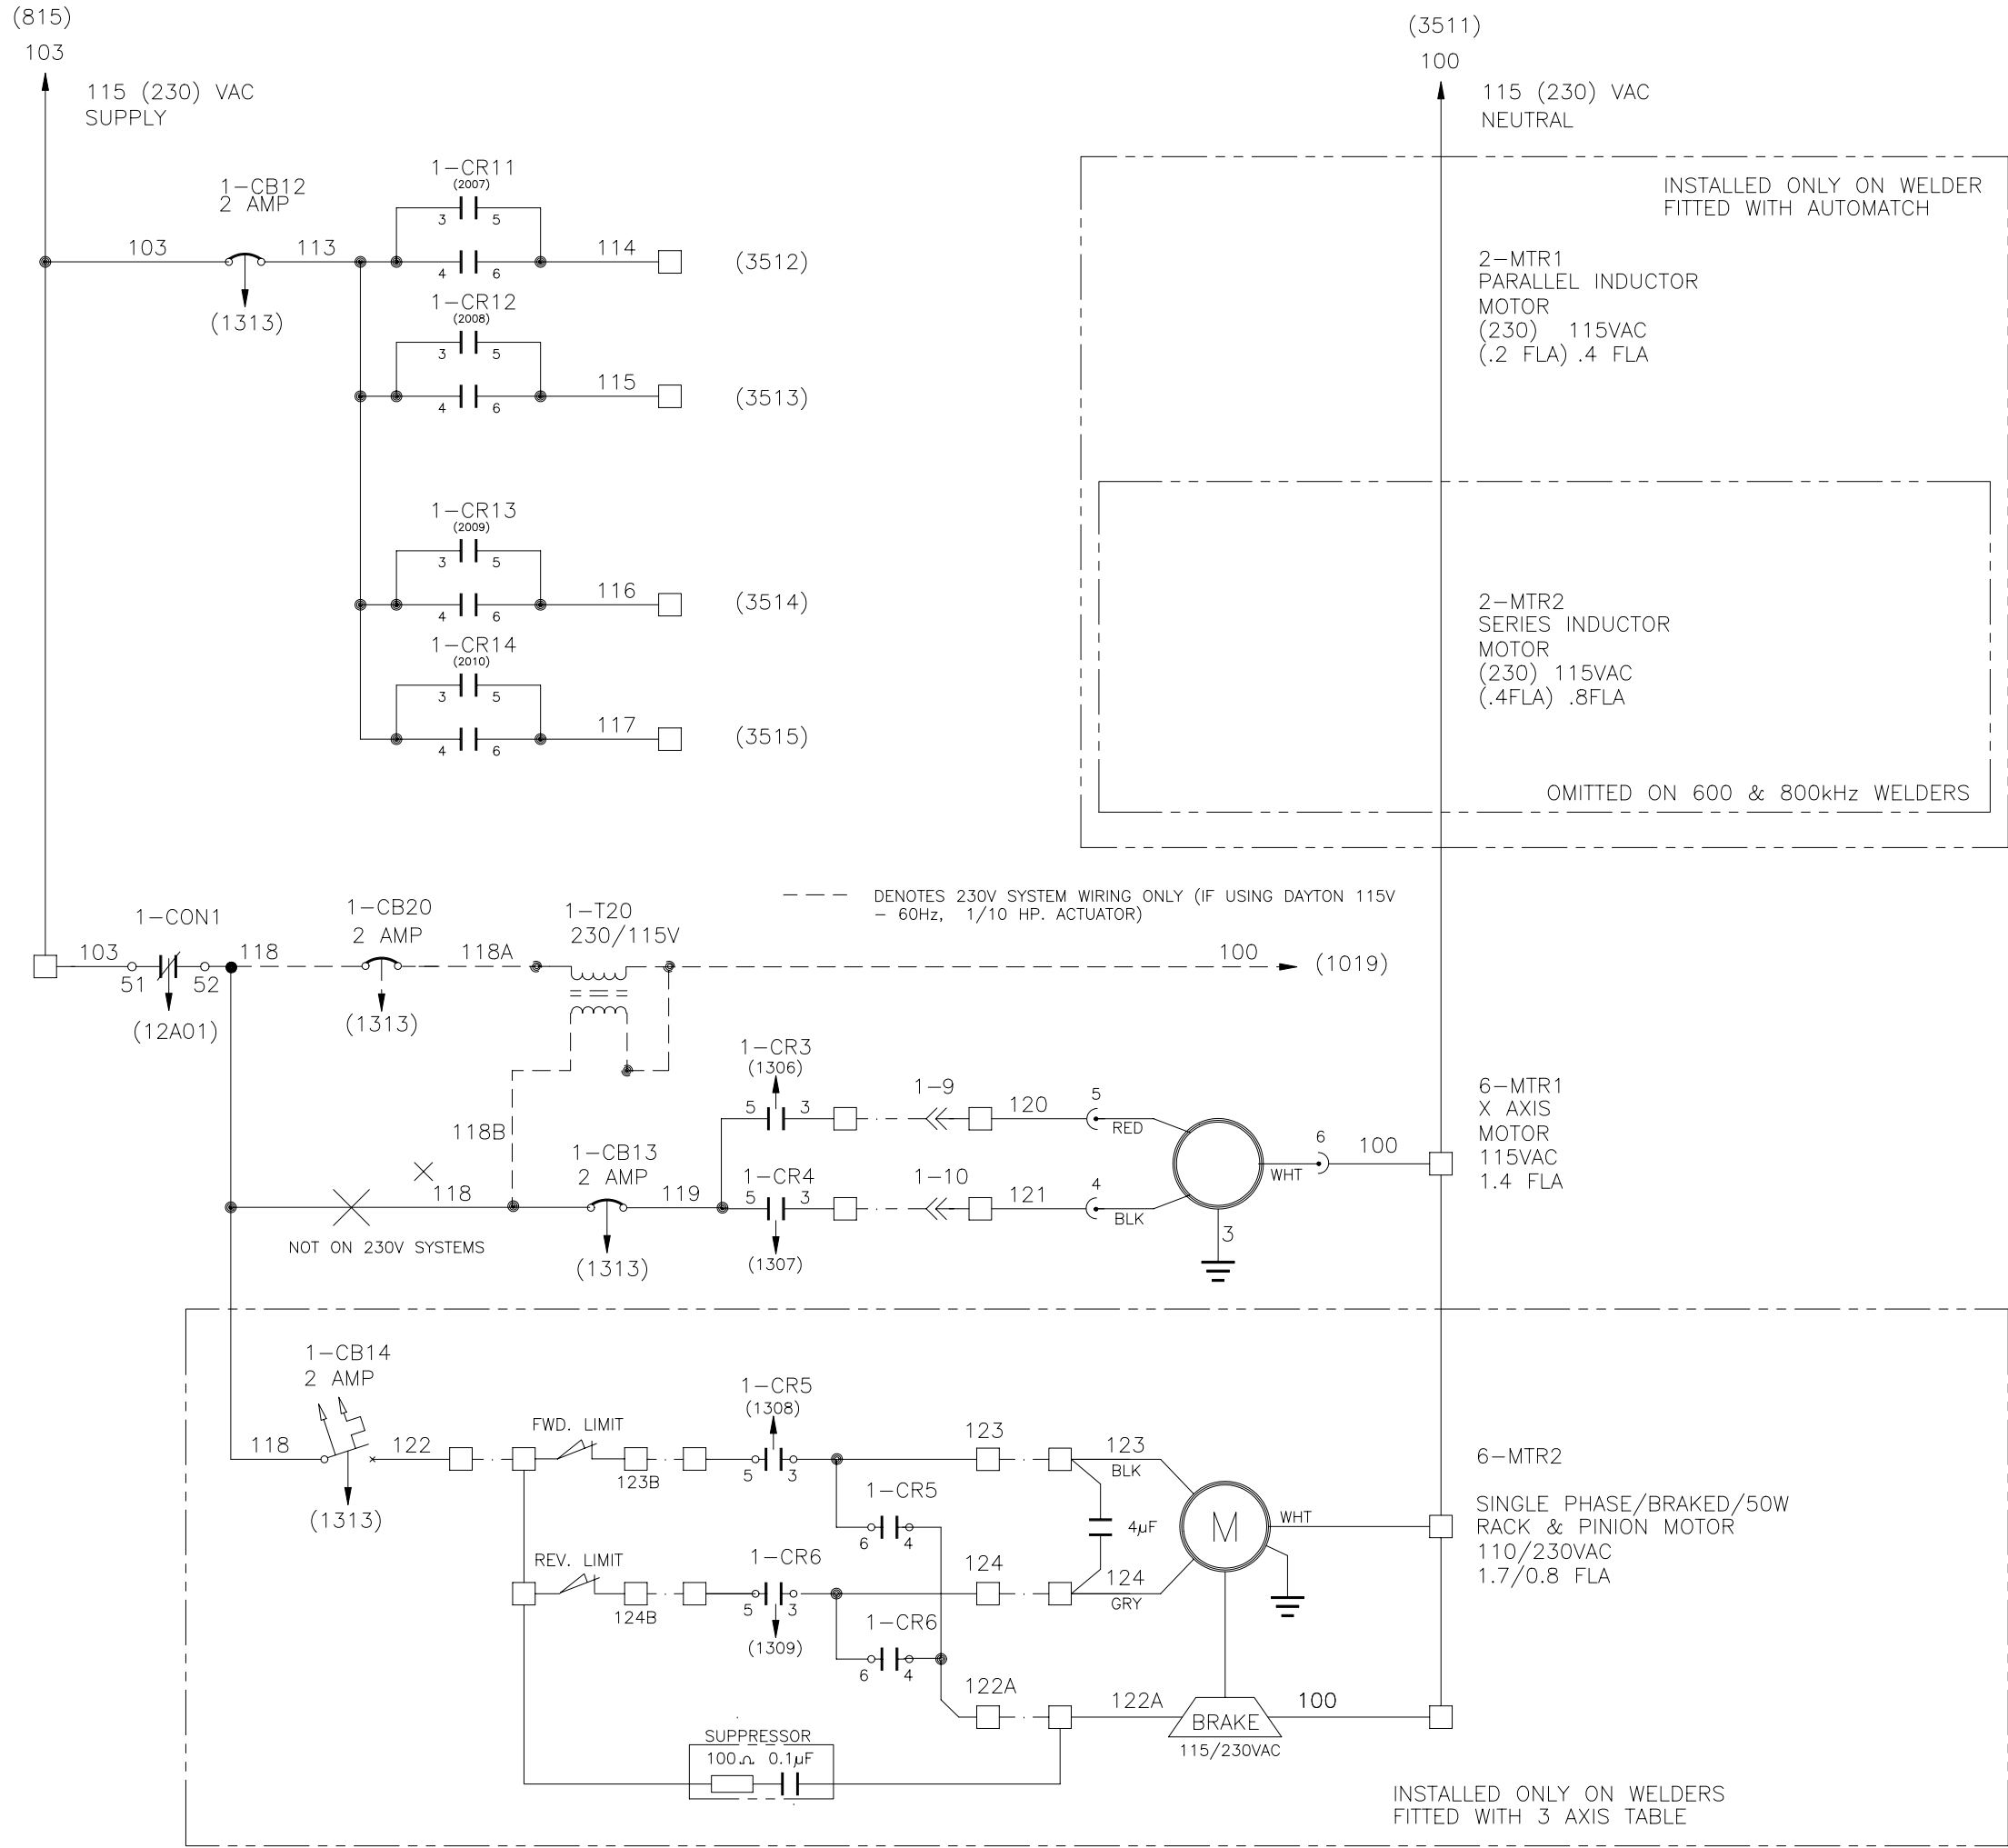

THERMATOOL
©Copyright THERMATOOL EUROPE LTD

TITLE: SCHEMATIC - ELECTRICAL CFI SOLID STATE WELDER

SIZE	DIV NO	DWG NO	REV
A1	3	WW5107	0
SCALE	N/A	DO NOT SCALE DRAWING COPY	SHEET 11



ENG-REF: 2

SINGLE PHASE AC MOTORS, CONTROL


REVISIONS						
REV	ECR	DESCRIPTION	ZONE	DWN	CHK	APPD
C	05222	ADD SH11A "FIRST ISSUE"		TAT		
						MM/DD/YY 11/16/05

(815)
103
115 (230) VAC
SUPPLY

(3511)
100
115 (230) VAC
NEUTRAL

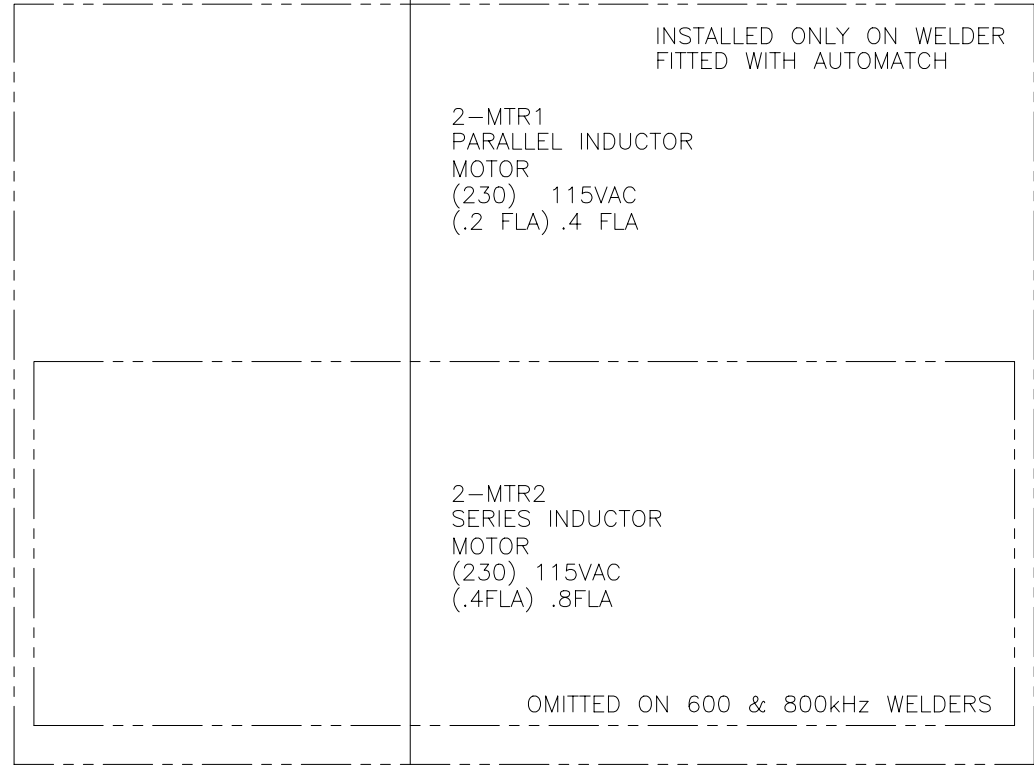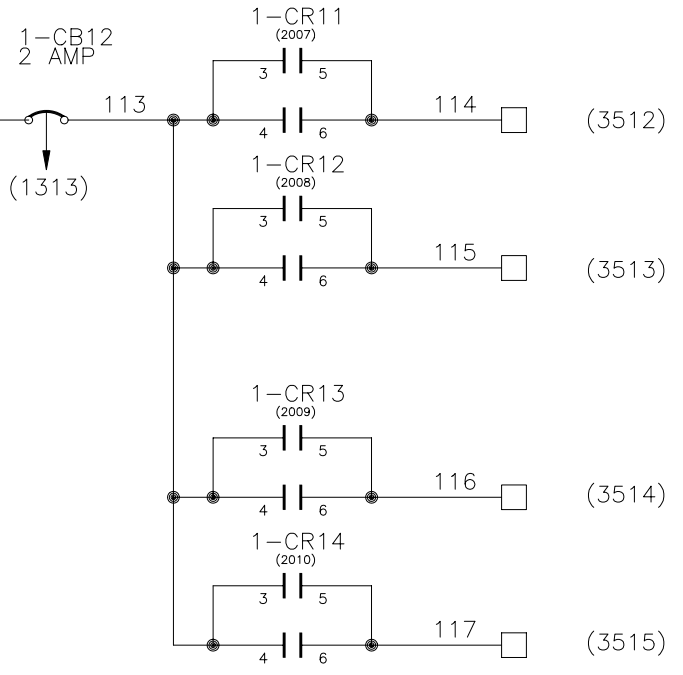

1-CON1
103 51 52 118
(12A01)

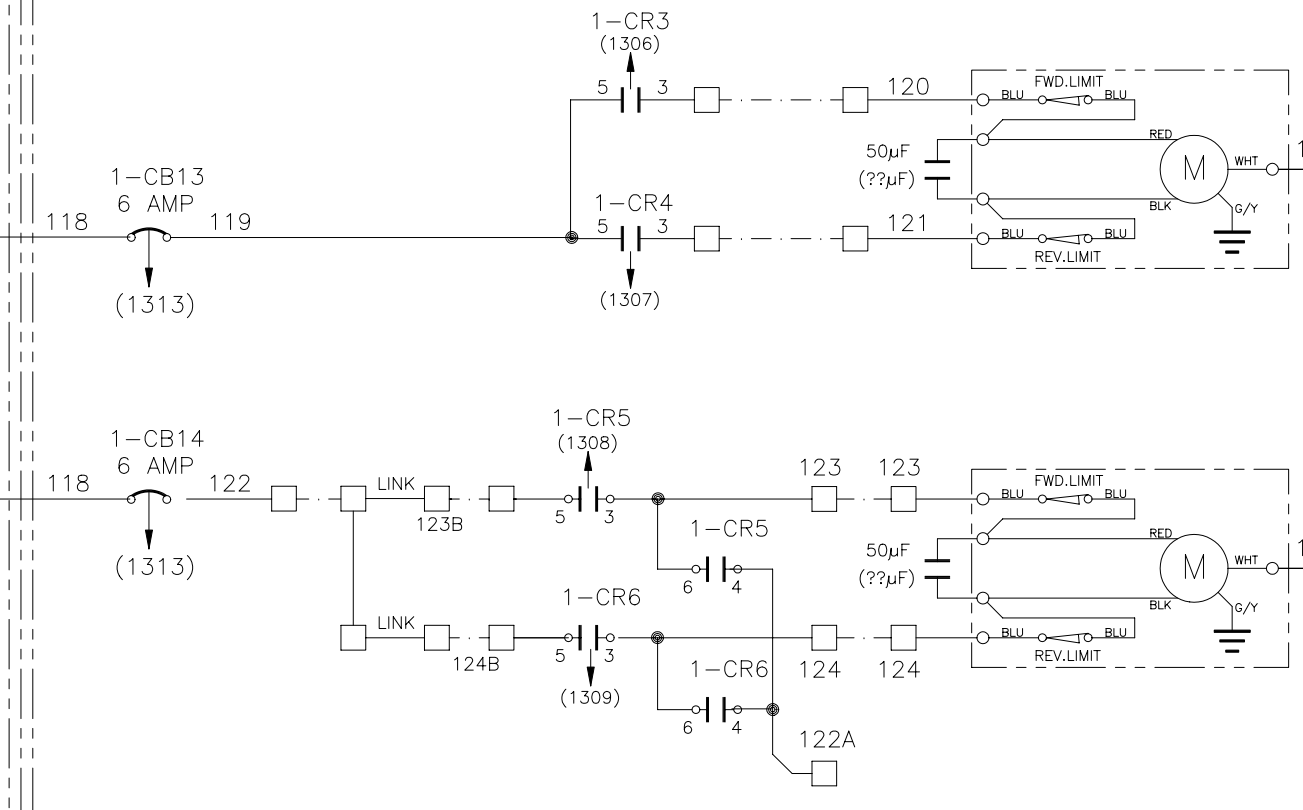

6-MTR1
X AXIS
MOTOR ACTUATOR
(230) 115VAC
(2 FLA) 4 FLA

6-MTR2
Y AXIS
MOTOR ACTUATOR
(230) 115VAC
(2 FLA) 4 FLA

3 AXIS TABLE WIRING
(BUILT AFTER OCTOBER 2005
NEW DESIGN WITH Y AXIS ACTUATOR)

THERMATOOL
©Copyright THERMATOOL EUROPE LTD


TITLE
**SCHEMATIC – ELECTRICAL
CFI SOLID STATE WELDER**

SIZE A1	DIV NO 3	DWG NO WW5107	REV C
SCALE N/A	DO NOT SCALE DRAWING COPY		SHEET 11A

ENG-REF: 2 1

REVISIONS						
REV	ECR	DESCRIPTION	ZONE	DWN	CHK	APPD
0	03248	FIRST ISSUE		TAT		

DC CONTROL

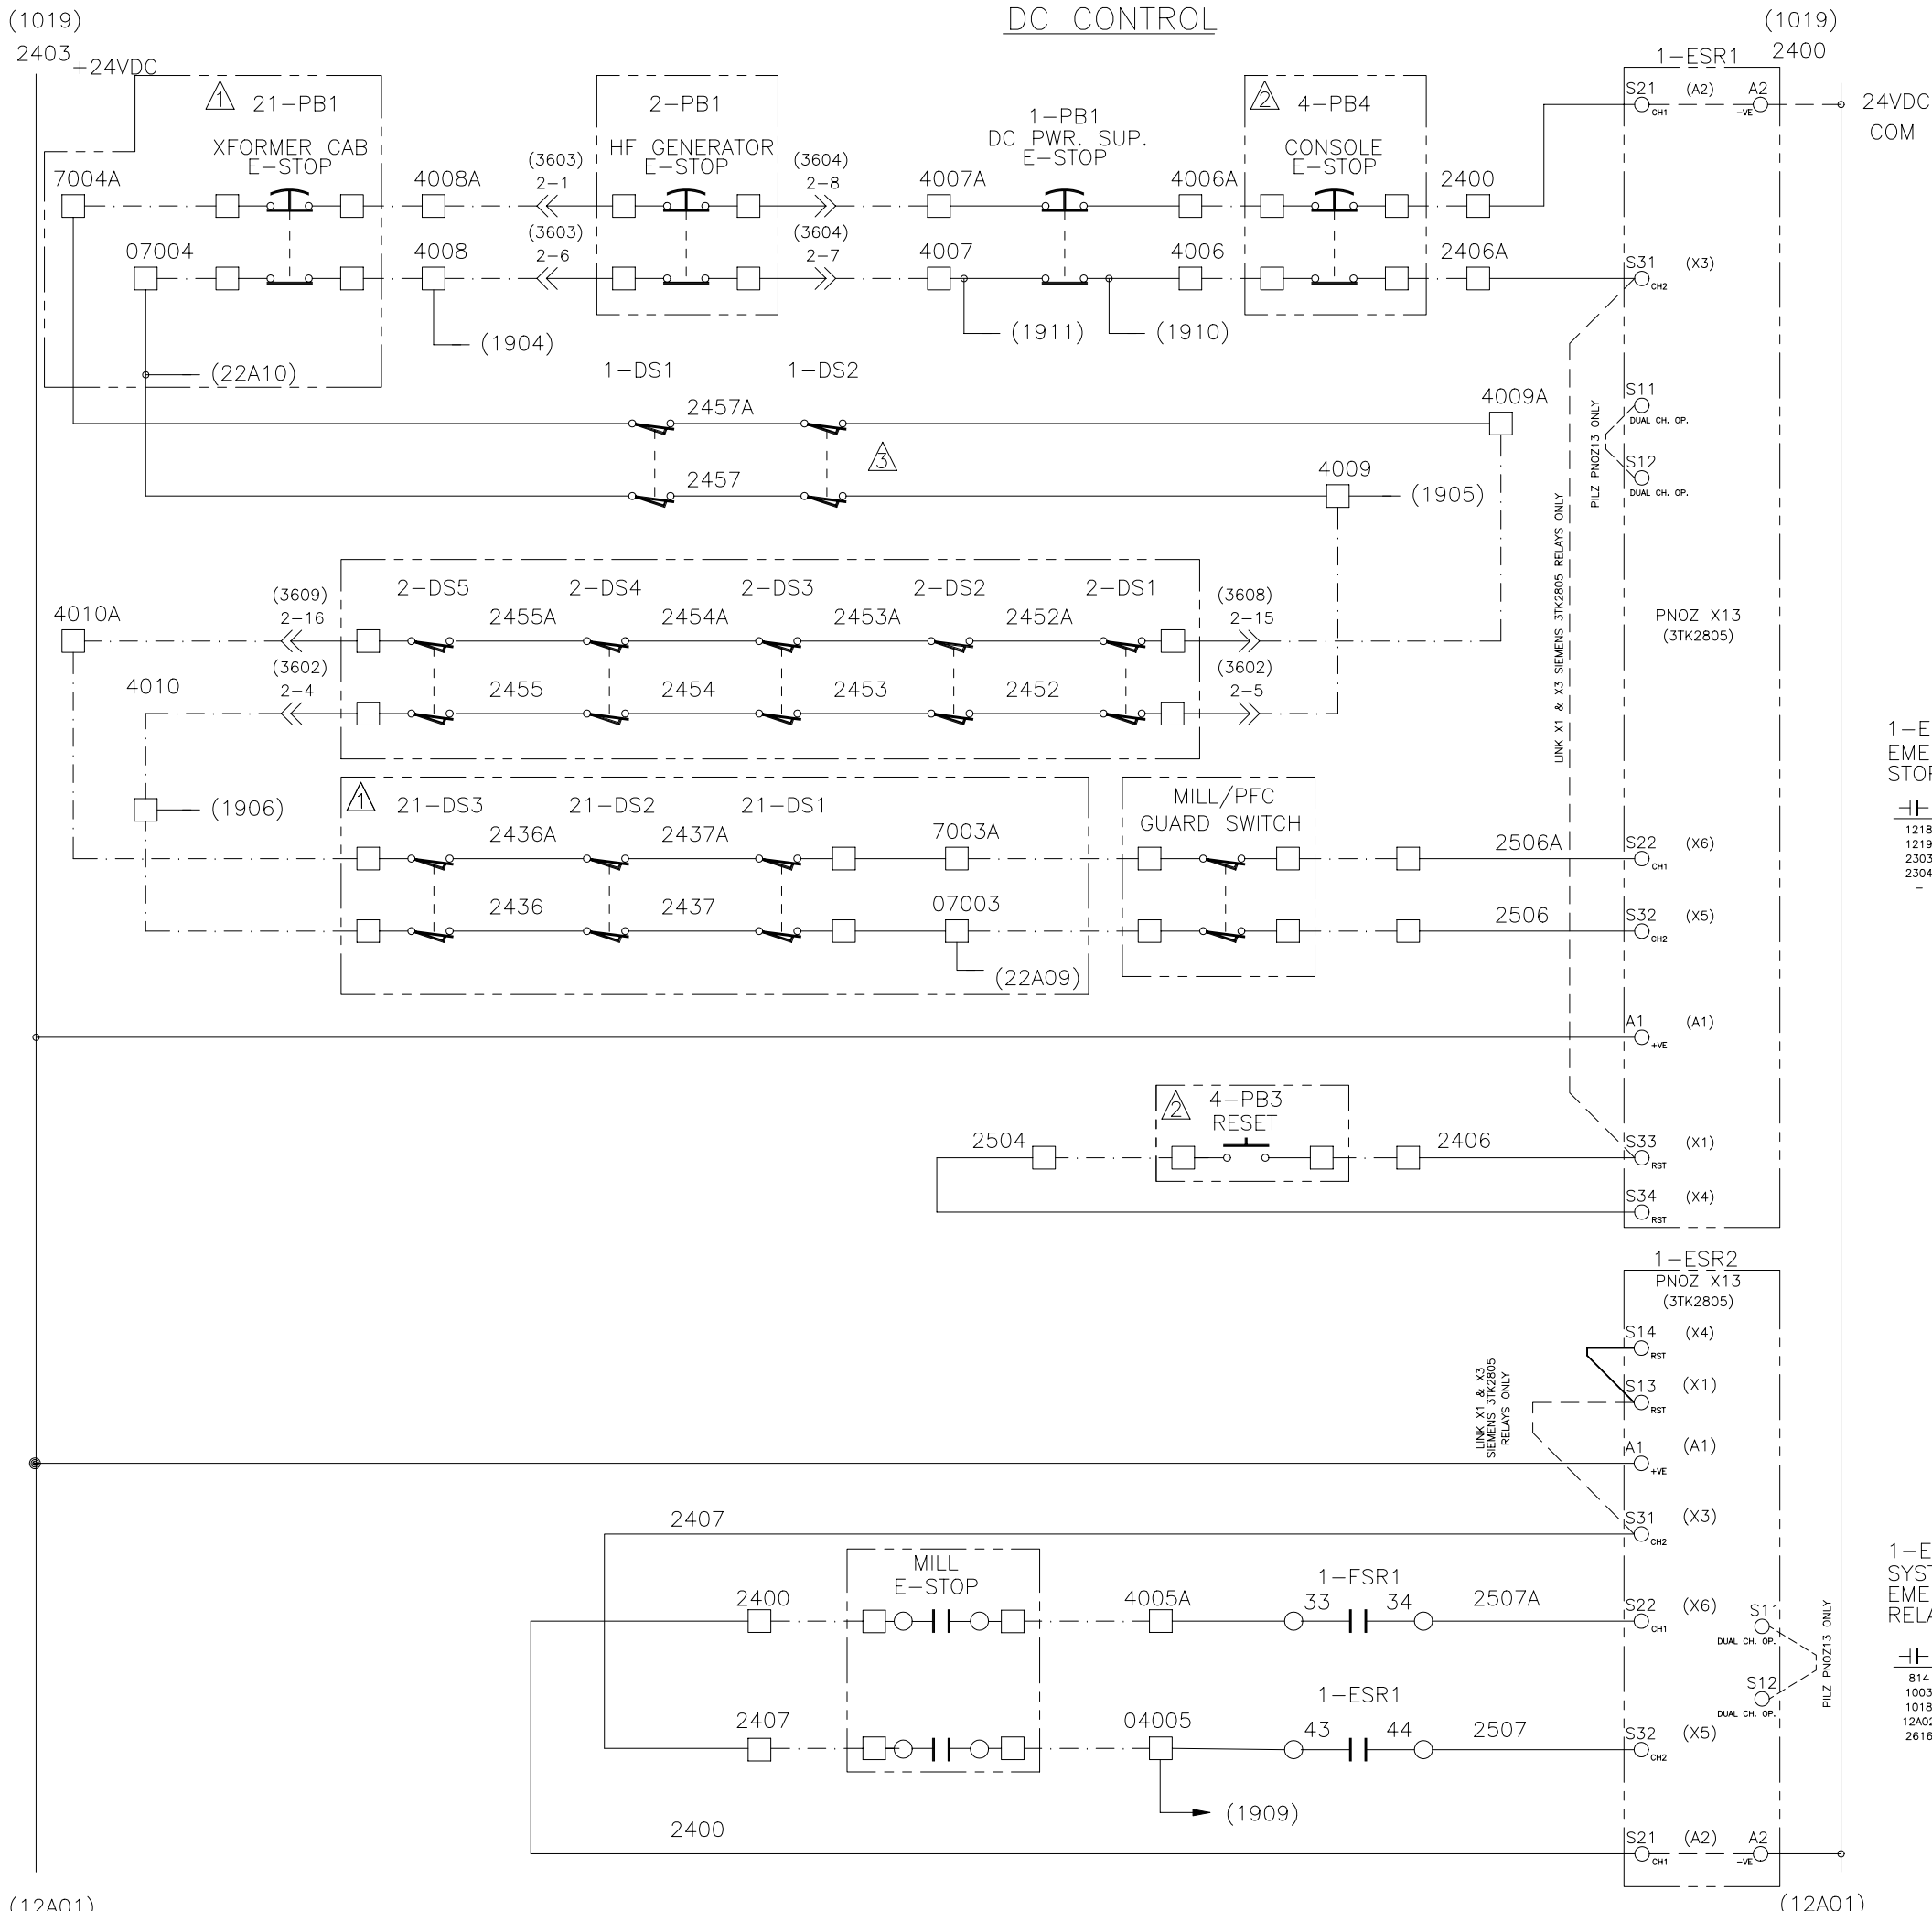

1-ESR1
EMERGENCY
STOP RELAY (WELDER)

1218	1907
1219	
2303	
2304	
-	

1-ESR2
SYSTEM
EMERGENCY STOP
RELAY (MILL)

814	
1003	
1018	
12A02	
2616	


- NOTES:
- ⚠ ONLY USED ON 400-1200KW UNIT WITH THERMATOOL SUPPLIED TRANSFORMER.
 - ⚠ NORMALLY FITTED ON CONSOLE BUT MAY BE FITTED IN REMOTE LOCATION
 - ⚠ 1-DS2 NOT FITTED ON 50 - 150KW UNITS

THERMATOOL
©Copyright THERMATOOL EUROPE LTD

TITLE
**SCHEMATIC - ELECTRICAL
CFI SOLID STATE WELDER**

SIZE A1	DIV NO 3	DWG NO WW5107	REV 0
SCALE N/A	DO NOT SCALE DRAWING COPY		SHEET 12

ENG-REF: 2

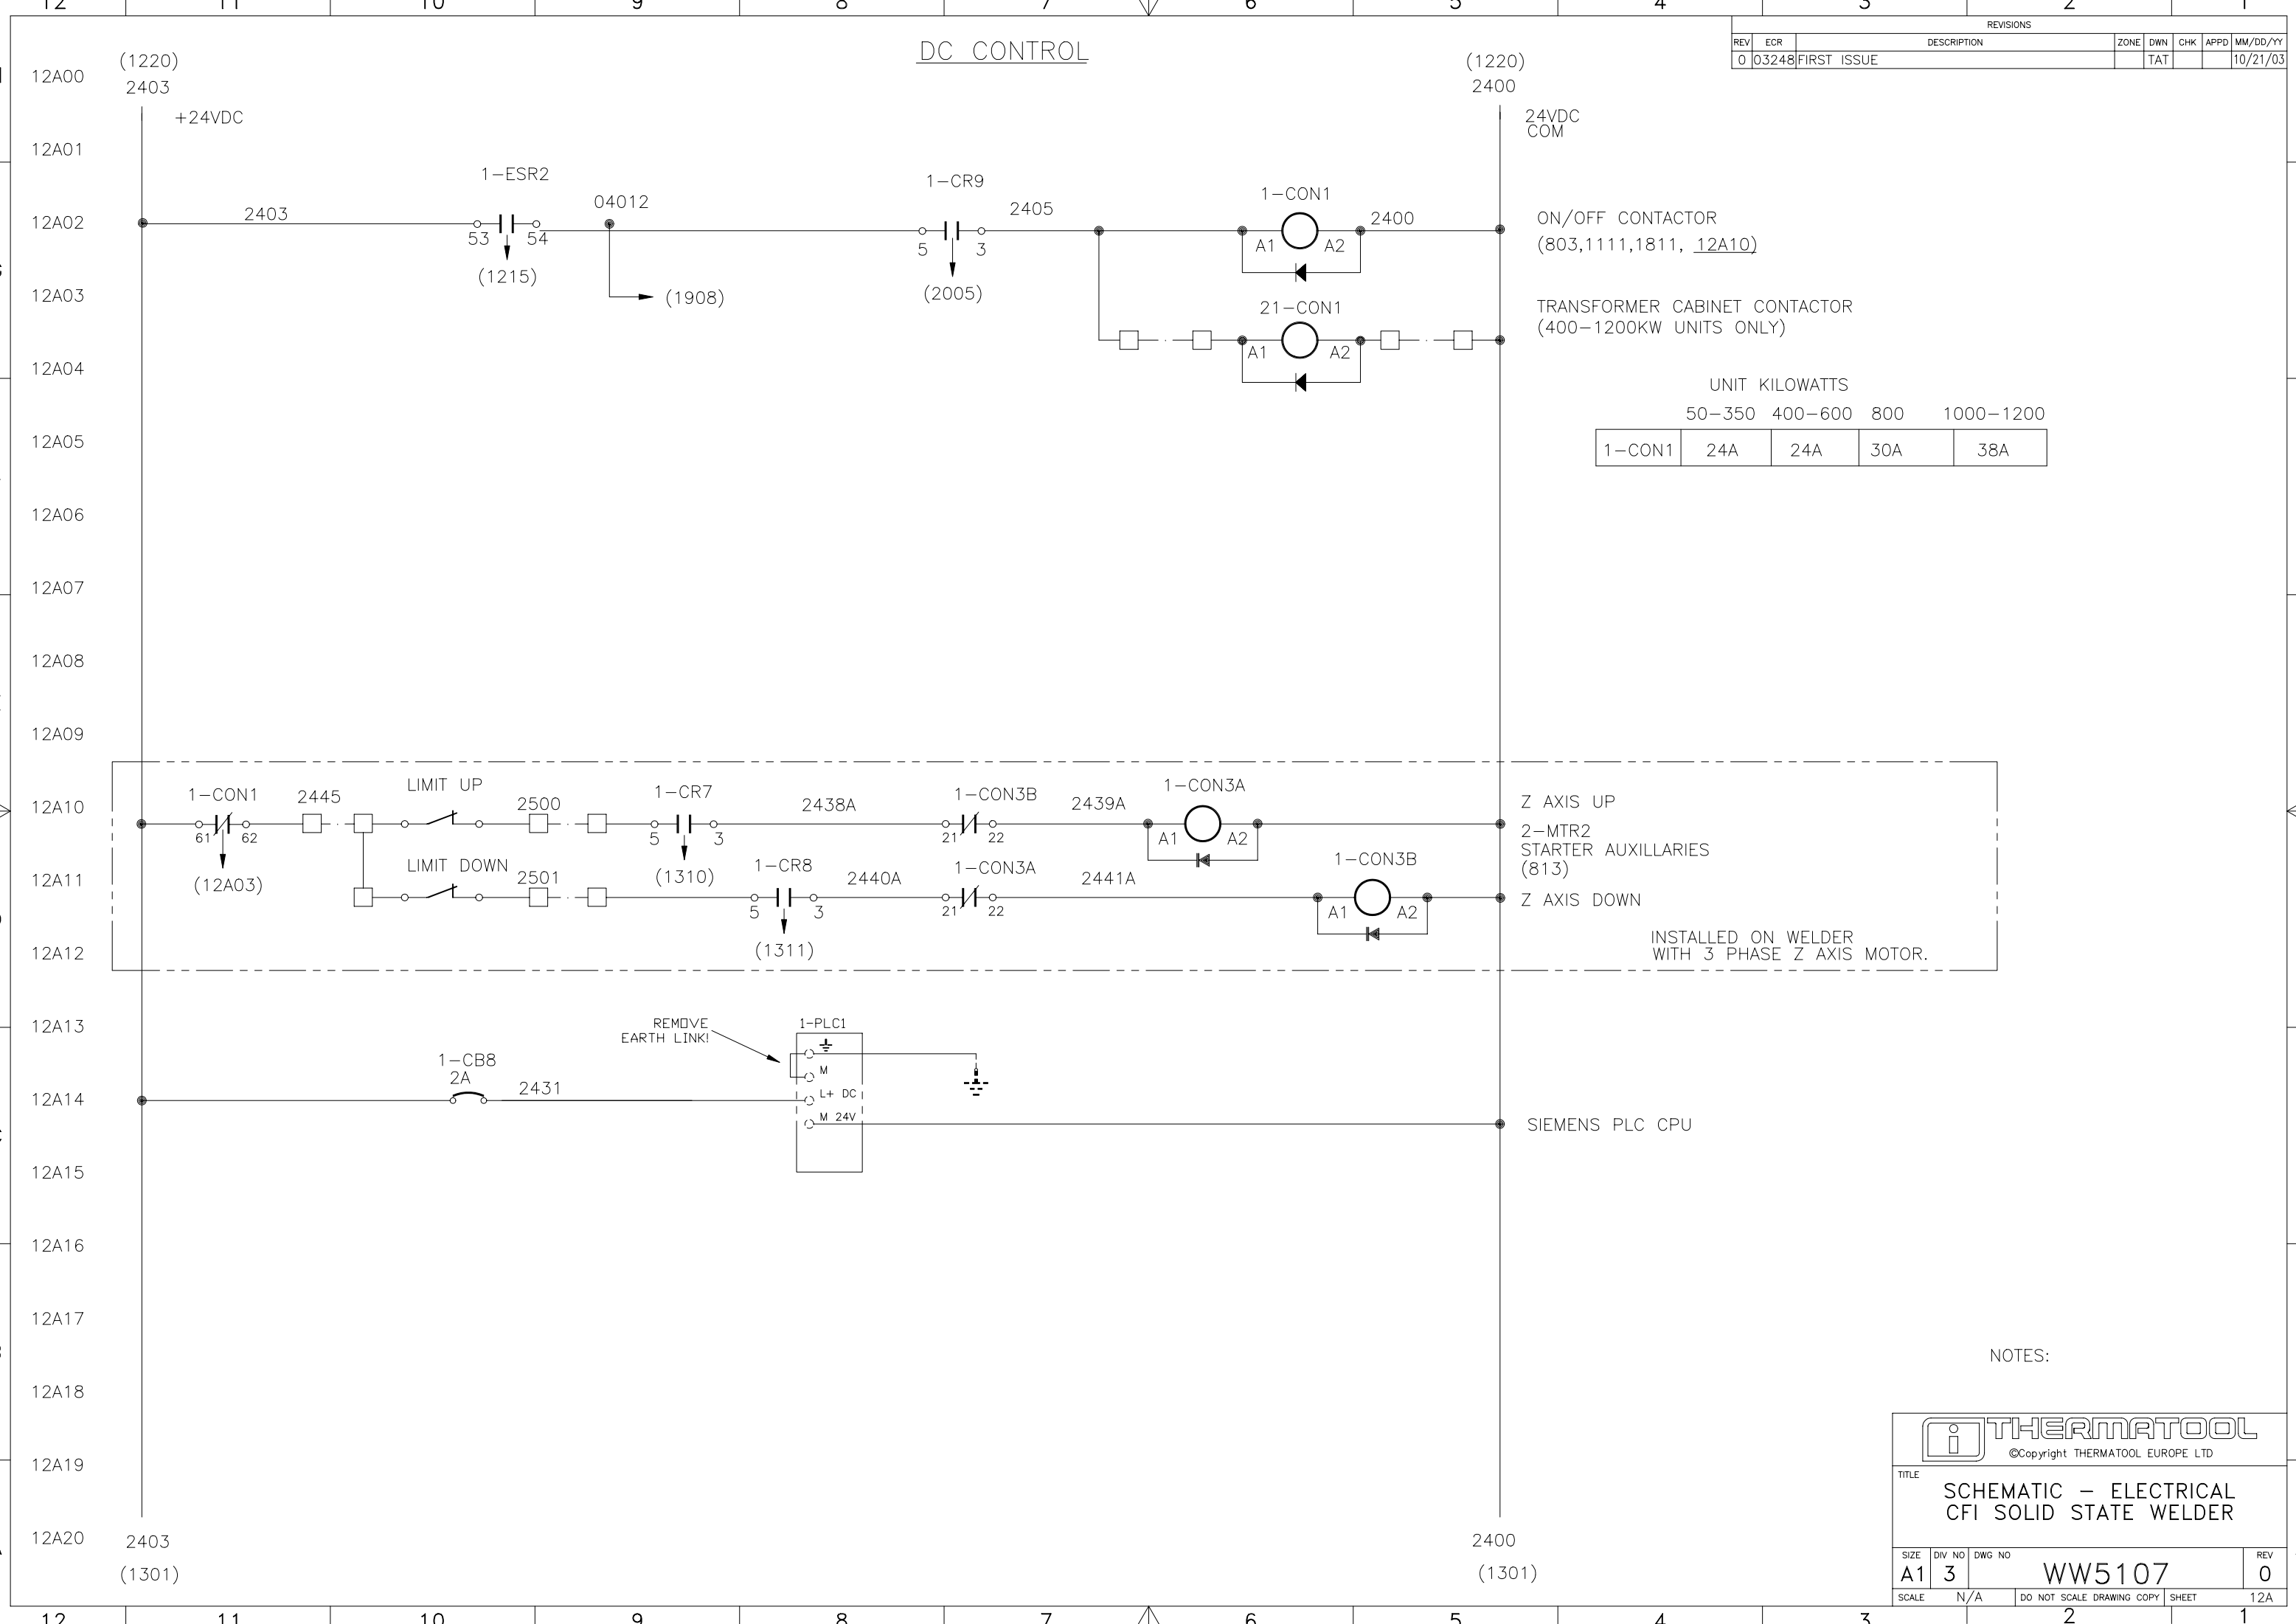

DC CONTROL

REVISIONS						
REV	ECR	DESCRIPTION	ZONE	DWN	CHK	APPD
0	03248	FIRST ISSUE		TAT		10/21/03

UNIT KILOWATTS

	50-350	400-600	800	1000-1200
1-CON1	24A	24A	30A	38A

Z AXIS UP
2-MTR2
STARTER AUXILLARIES
(813)

INSTALLED ON WELDER
WITH 3 PHASE Z AXIS MOTOR.

SIEMENS PLC CPU

NOTES:

THERMATOOL
©Copyright THERMATOOL EUROPE LTD


TITLE
**SCHEMATIC – ELECTRICAL
CFI SOLID STATE WELDER**

SIZE A1	DIV NO 3	DWG NO WW5107	REV 0
SCALE N/A	DO NOT SCALE DRAWING COPY		SHEET 12A

ENG-REF: 2

DC CONTROL


REVISIONS						
REV	ECR	DESCRIPTION	ZONE	DWN	CHK	APPD
0	03248	FIRST ISSUE		TAT		MM/DD/YY 11/06/03

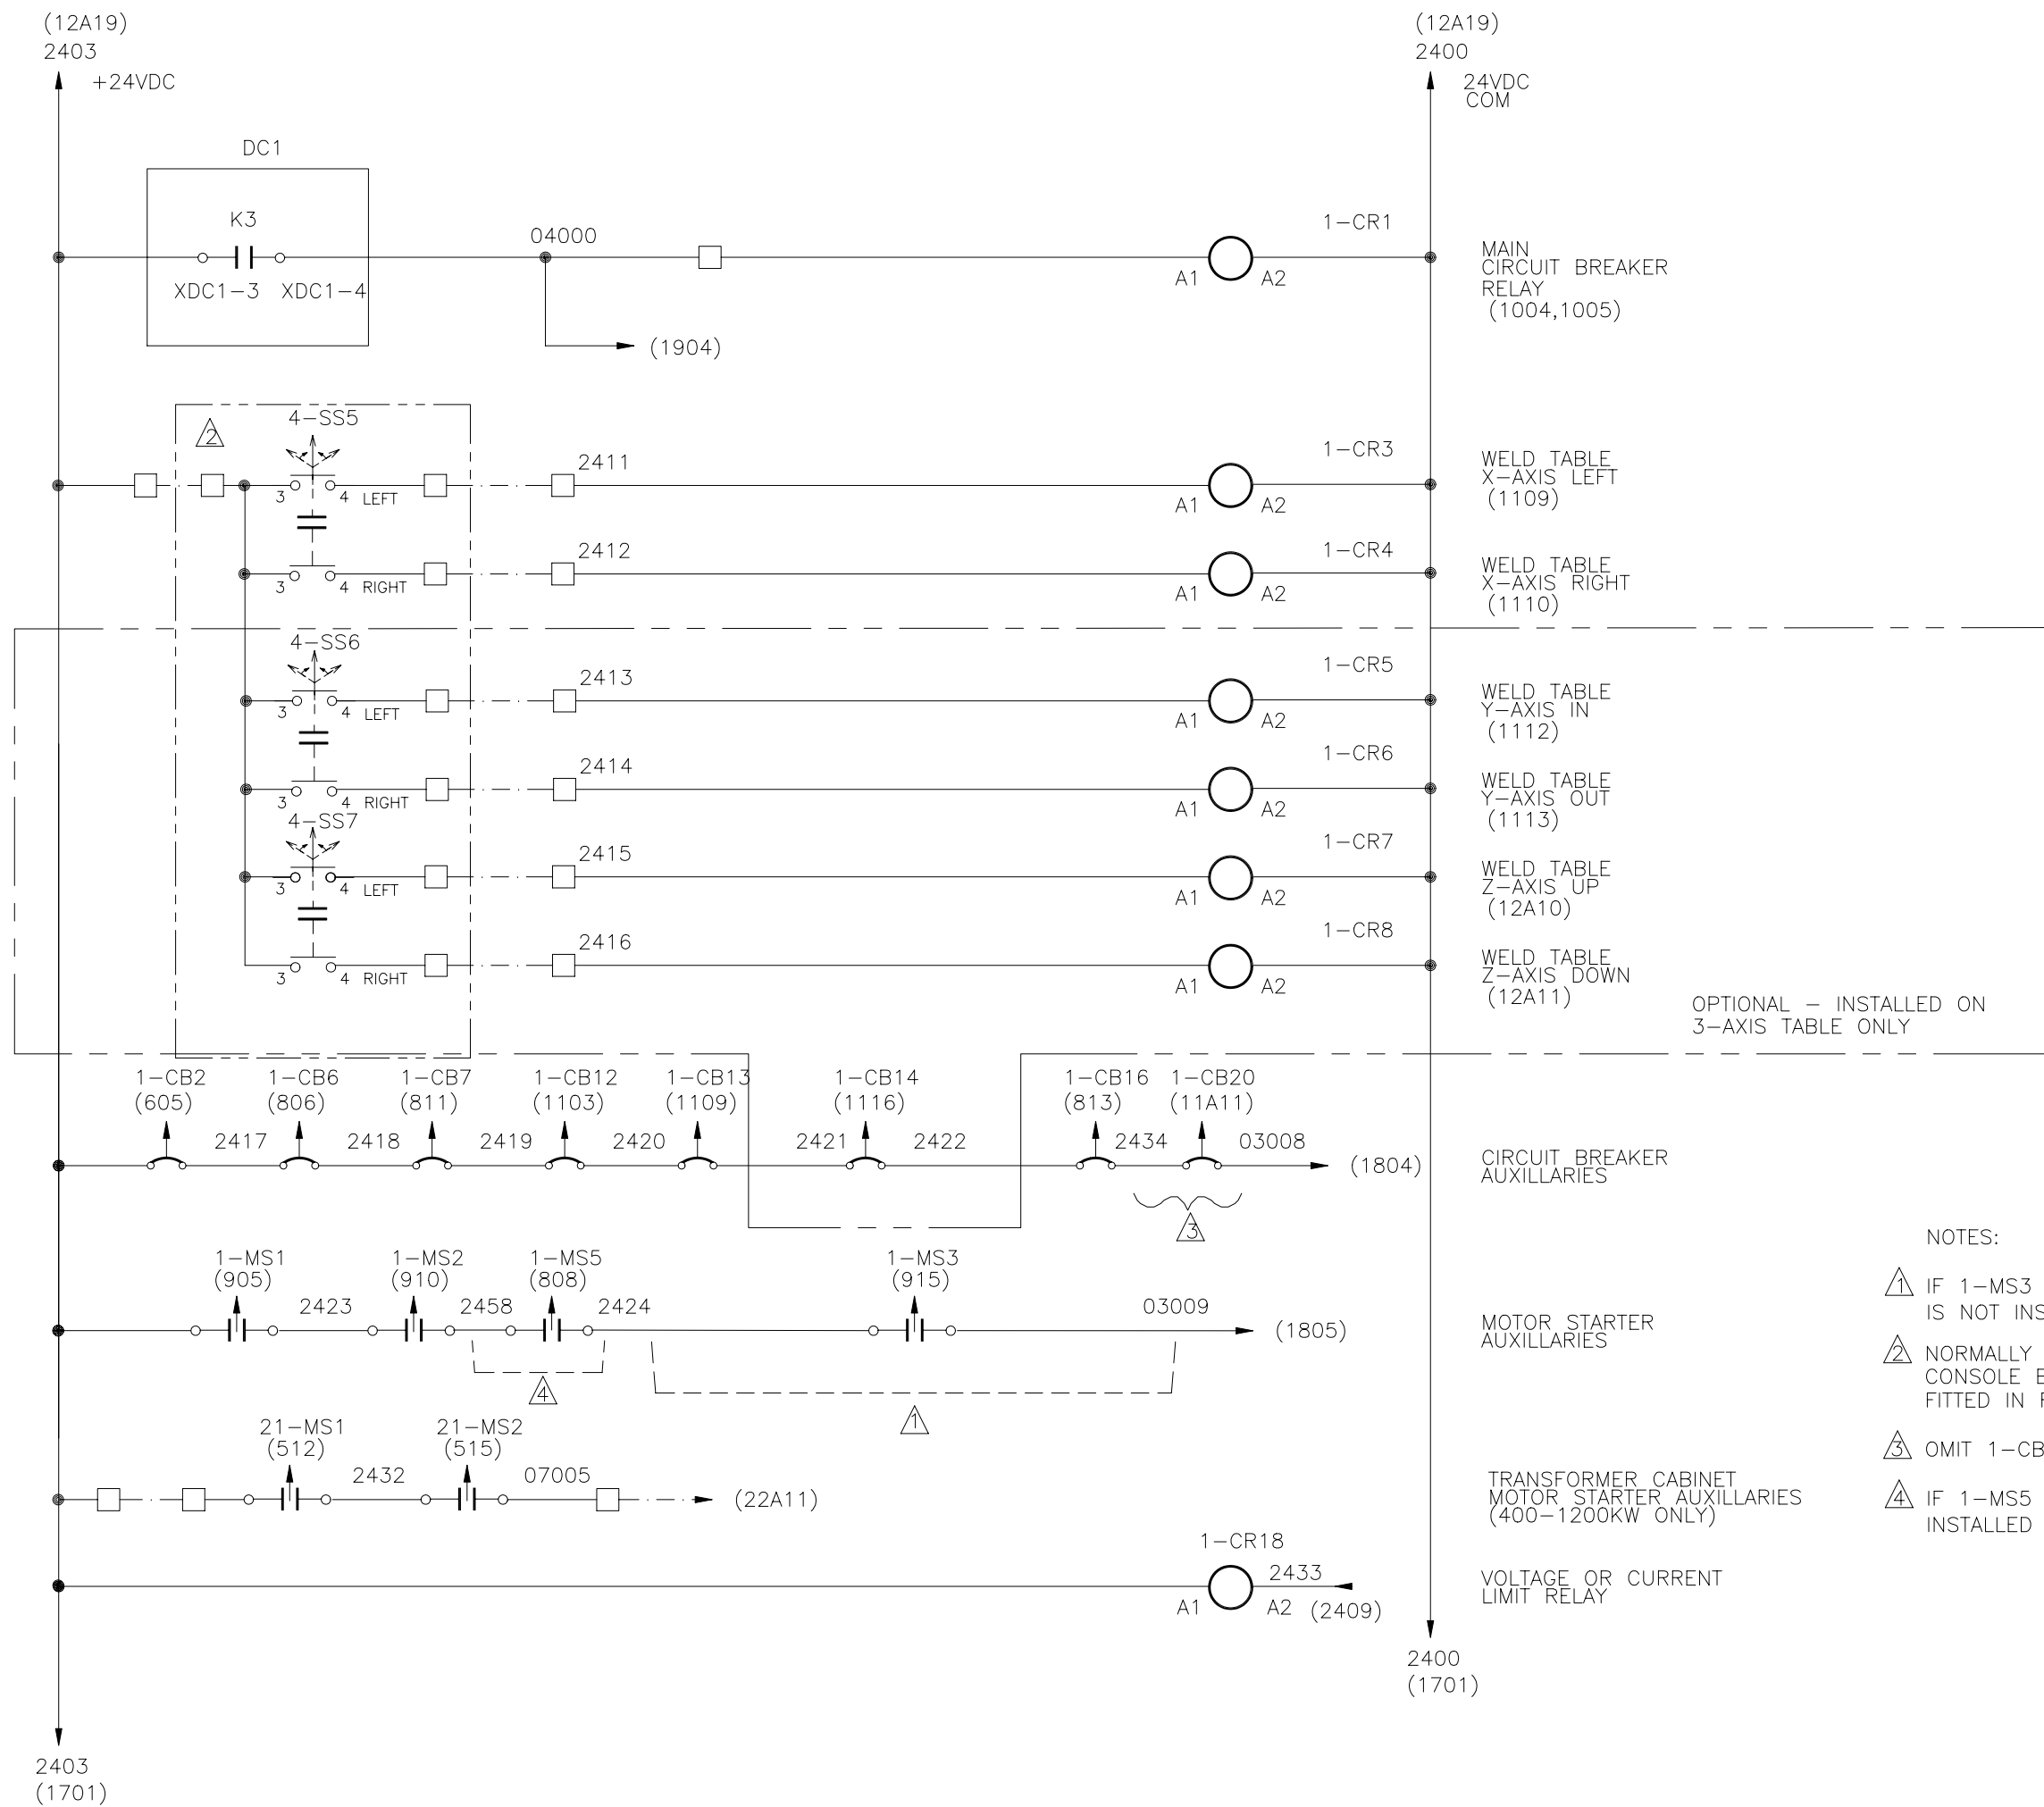

OPTIONAL - INSTALLED ON 3-AXIS TABLE ONLY

- NOTES:
- ⚠ IF 1-MS3 (FITTED ON 200-350 UNITS ONLY) IS NOT INSTALLED OMIT 2424.
 - ⚠ NORMALLY FITTED ON CONSOLE BUT MAY BE FITTED IN REMOTE LOCATION
 - ⚠ OMIT 1-CB20 AND 2434A IF 115V CONTROL
 - ⚠ IF 1-MS5 (FITTED ON 3 AXIS TABLES WELDER ONLY) IS NOT INSTALLED OMIT 2458

THERMATOOL ©Copyright THERMATOOL EUROPE LTD			
TITLE SCHEMATIC - ELECTRICAL CFI SOLID STATE WELDER			
SIZE A1	DIV NO 3	DWG NO WW5107	REV 0
SCALE N/A	DO NOT SCALE DRAWING COPY		SHEET 13

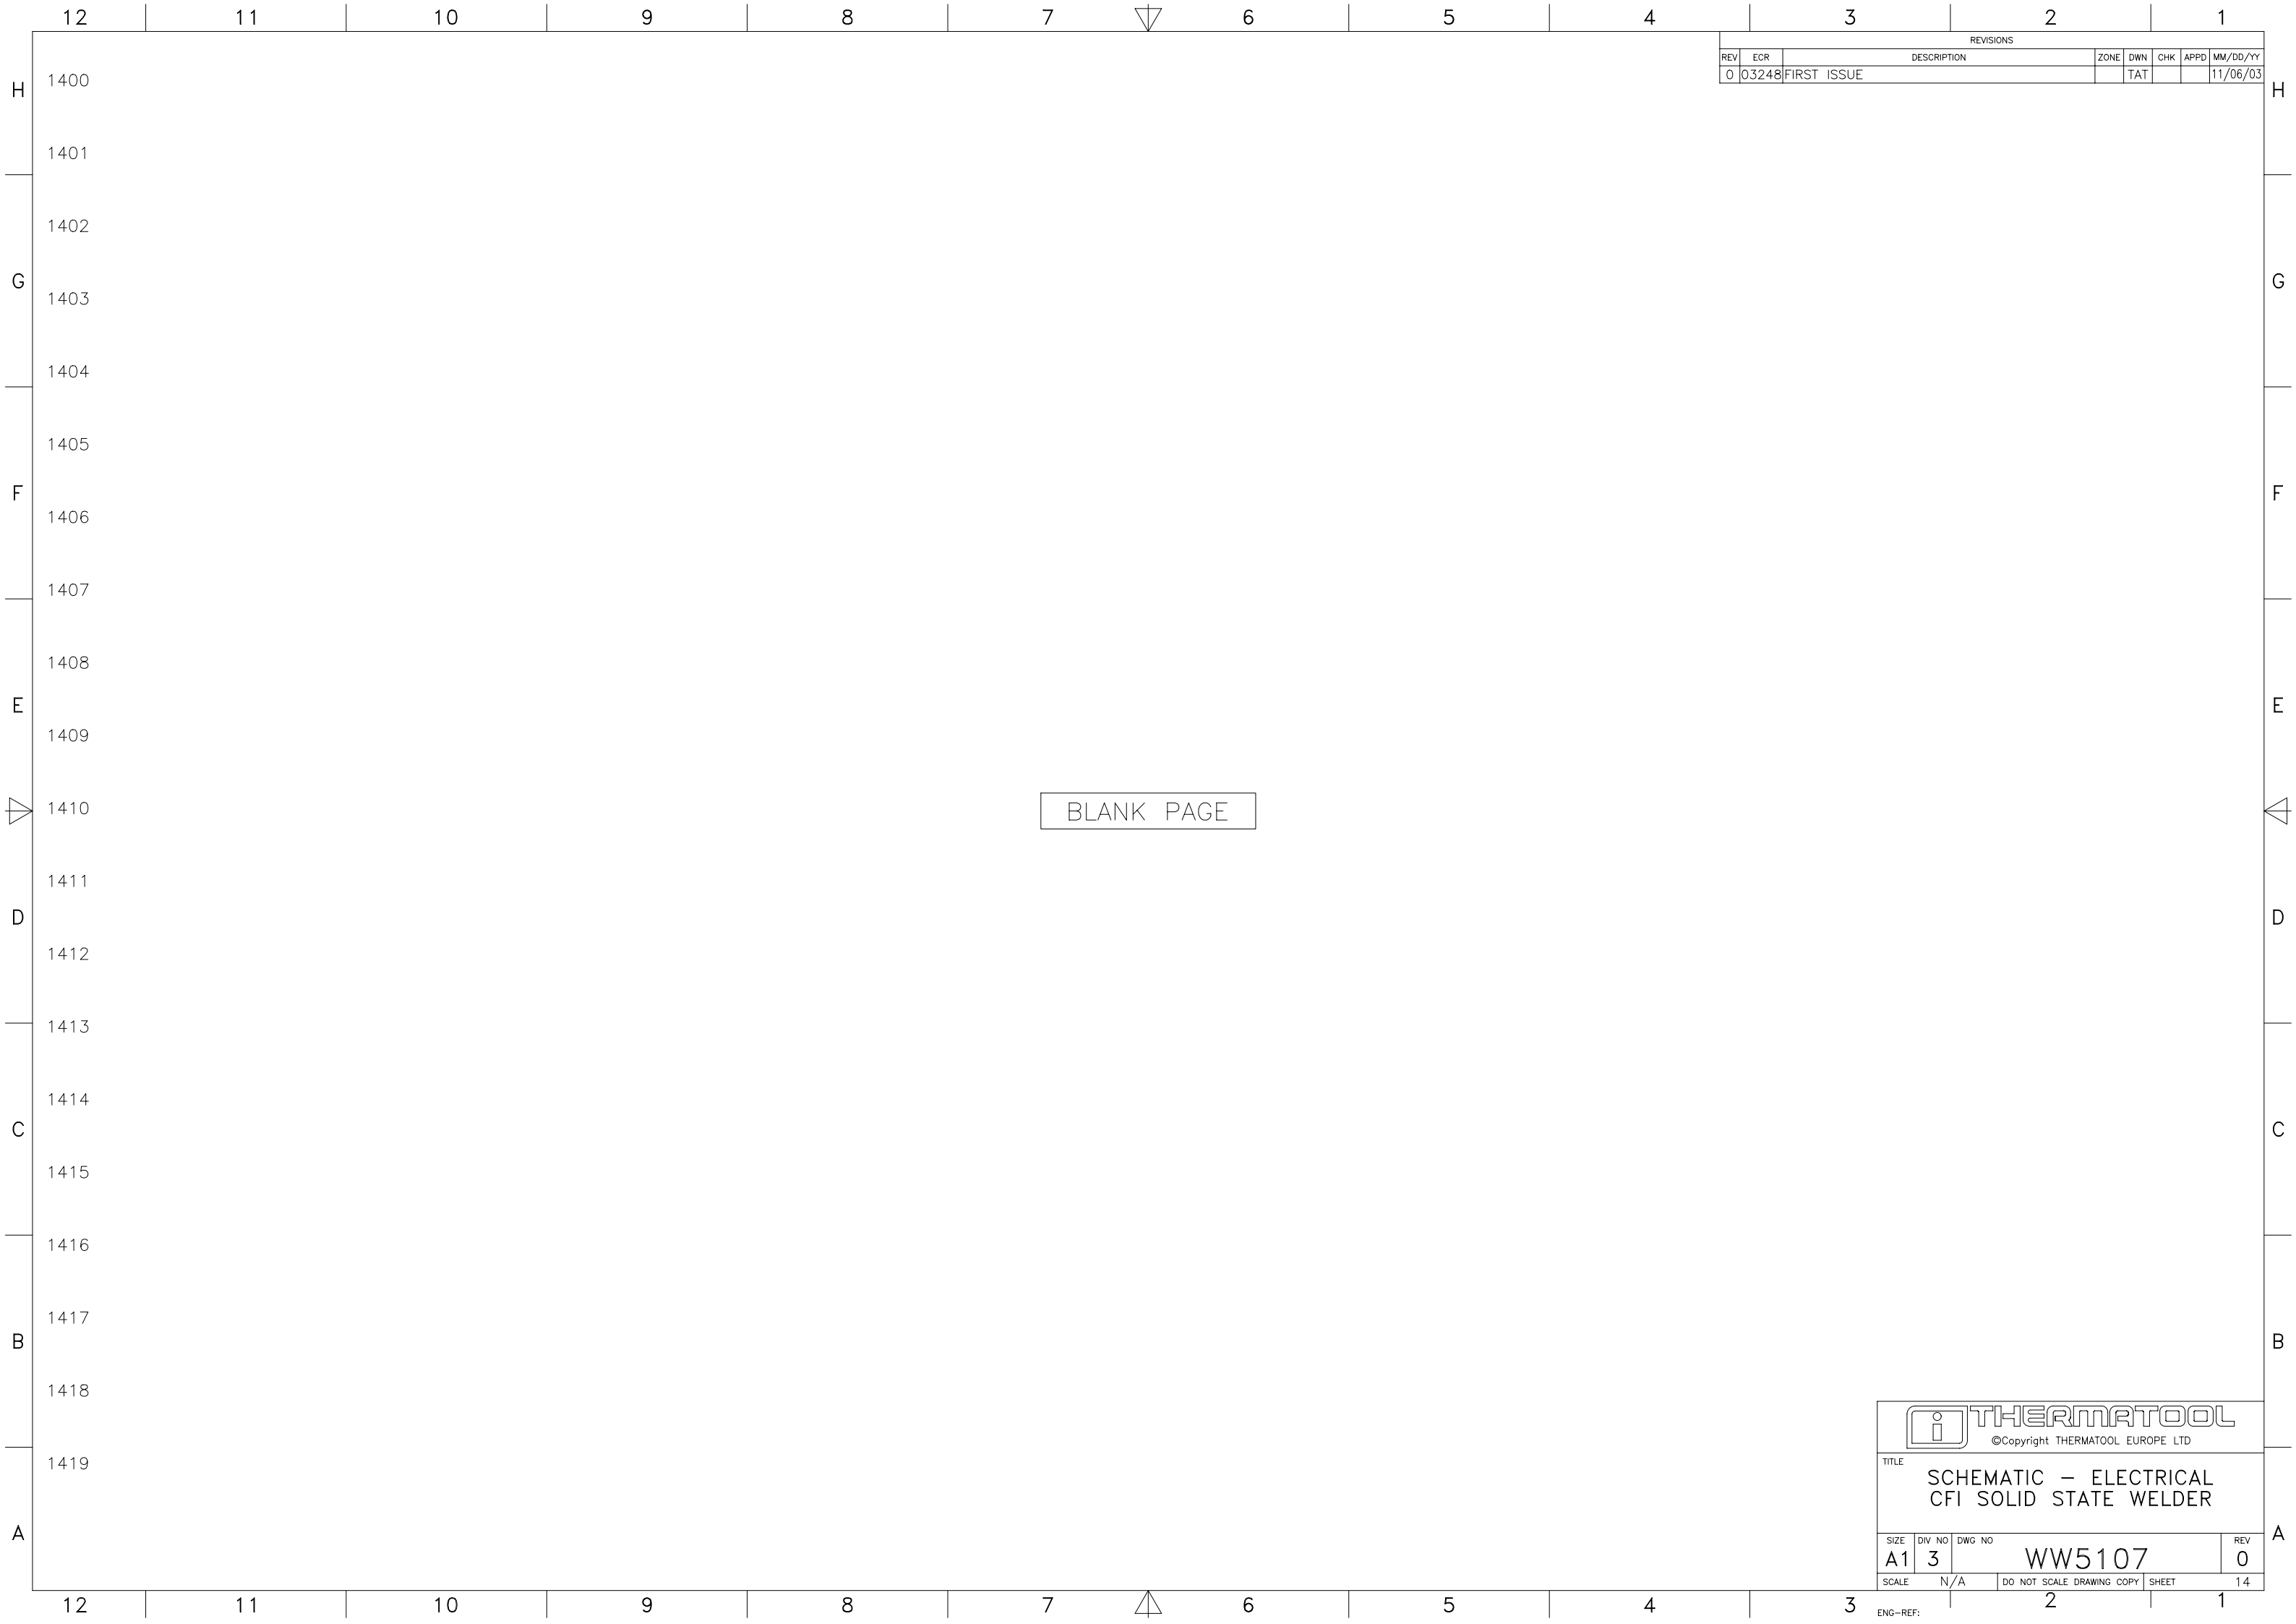

REVISIONS							
REV	ECR	DESCRIPTION	ZONE	DWN	CHK	APPD	MM/DD/YY
0	03248	FIRST ISSUE		TAT			11/06/03

BLANK PAGE




TITLE
**SCHEMATIC – ELECTRICAL
 CFI SOLID STATE WELDER**

SIZE	DIV NO	DWG NO	REV
A1	3	WW5107	0

SCALE	N/A	DO NOT SCALE DRAWING COPY	SHEET	14
-------	-----	---------------------------	-------	----

ENG-REF: 2 1

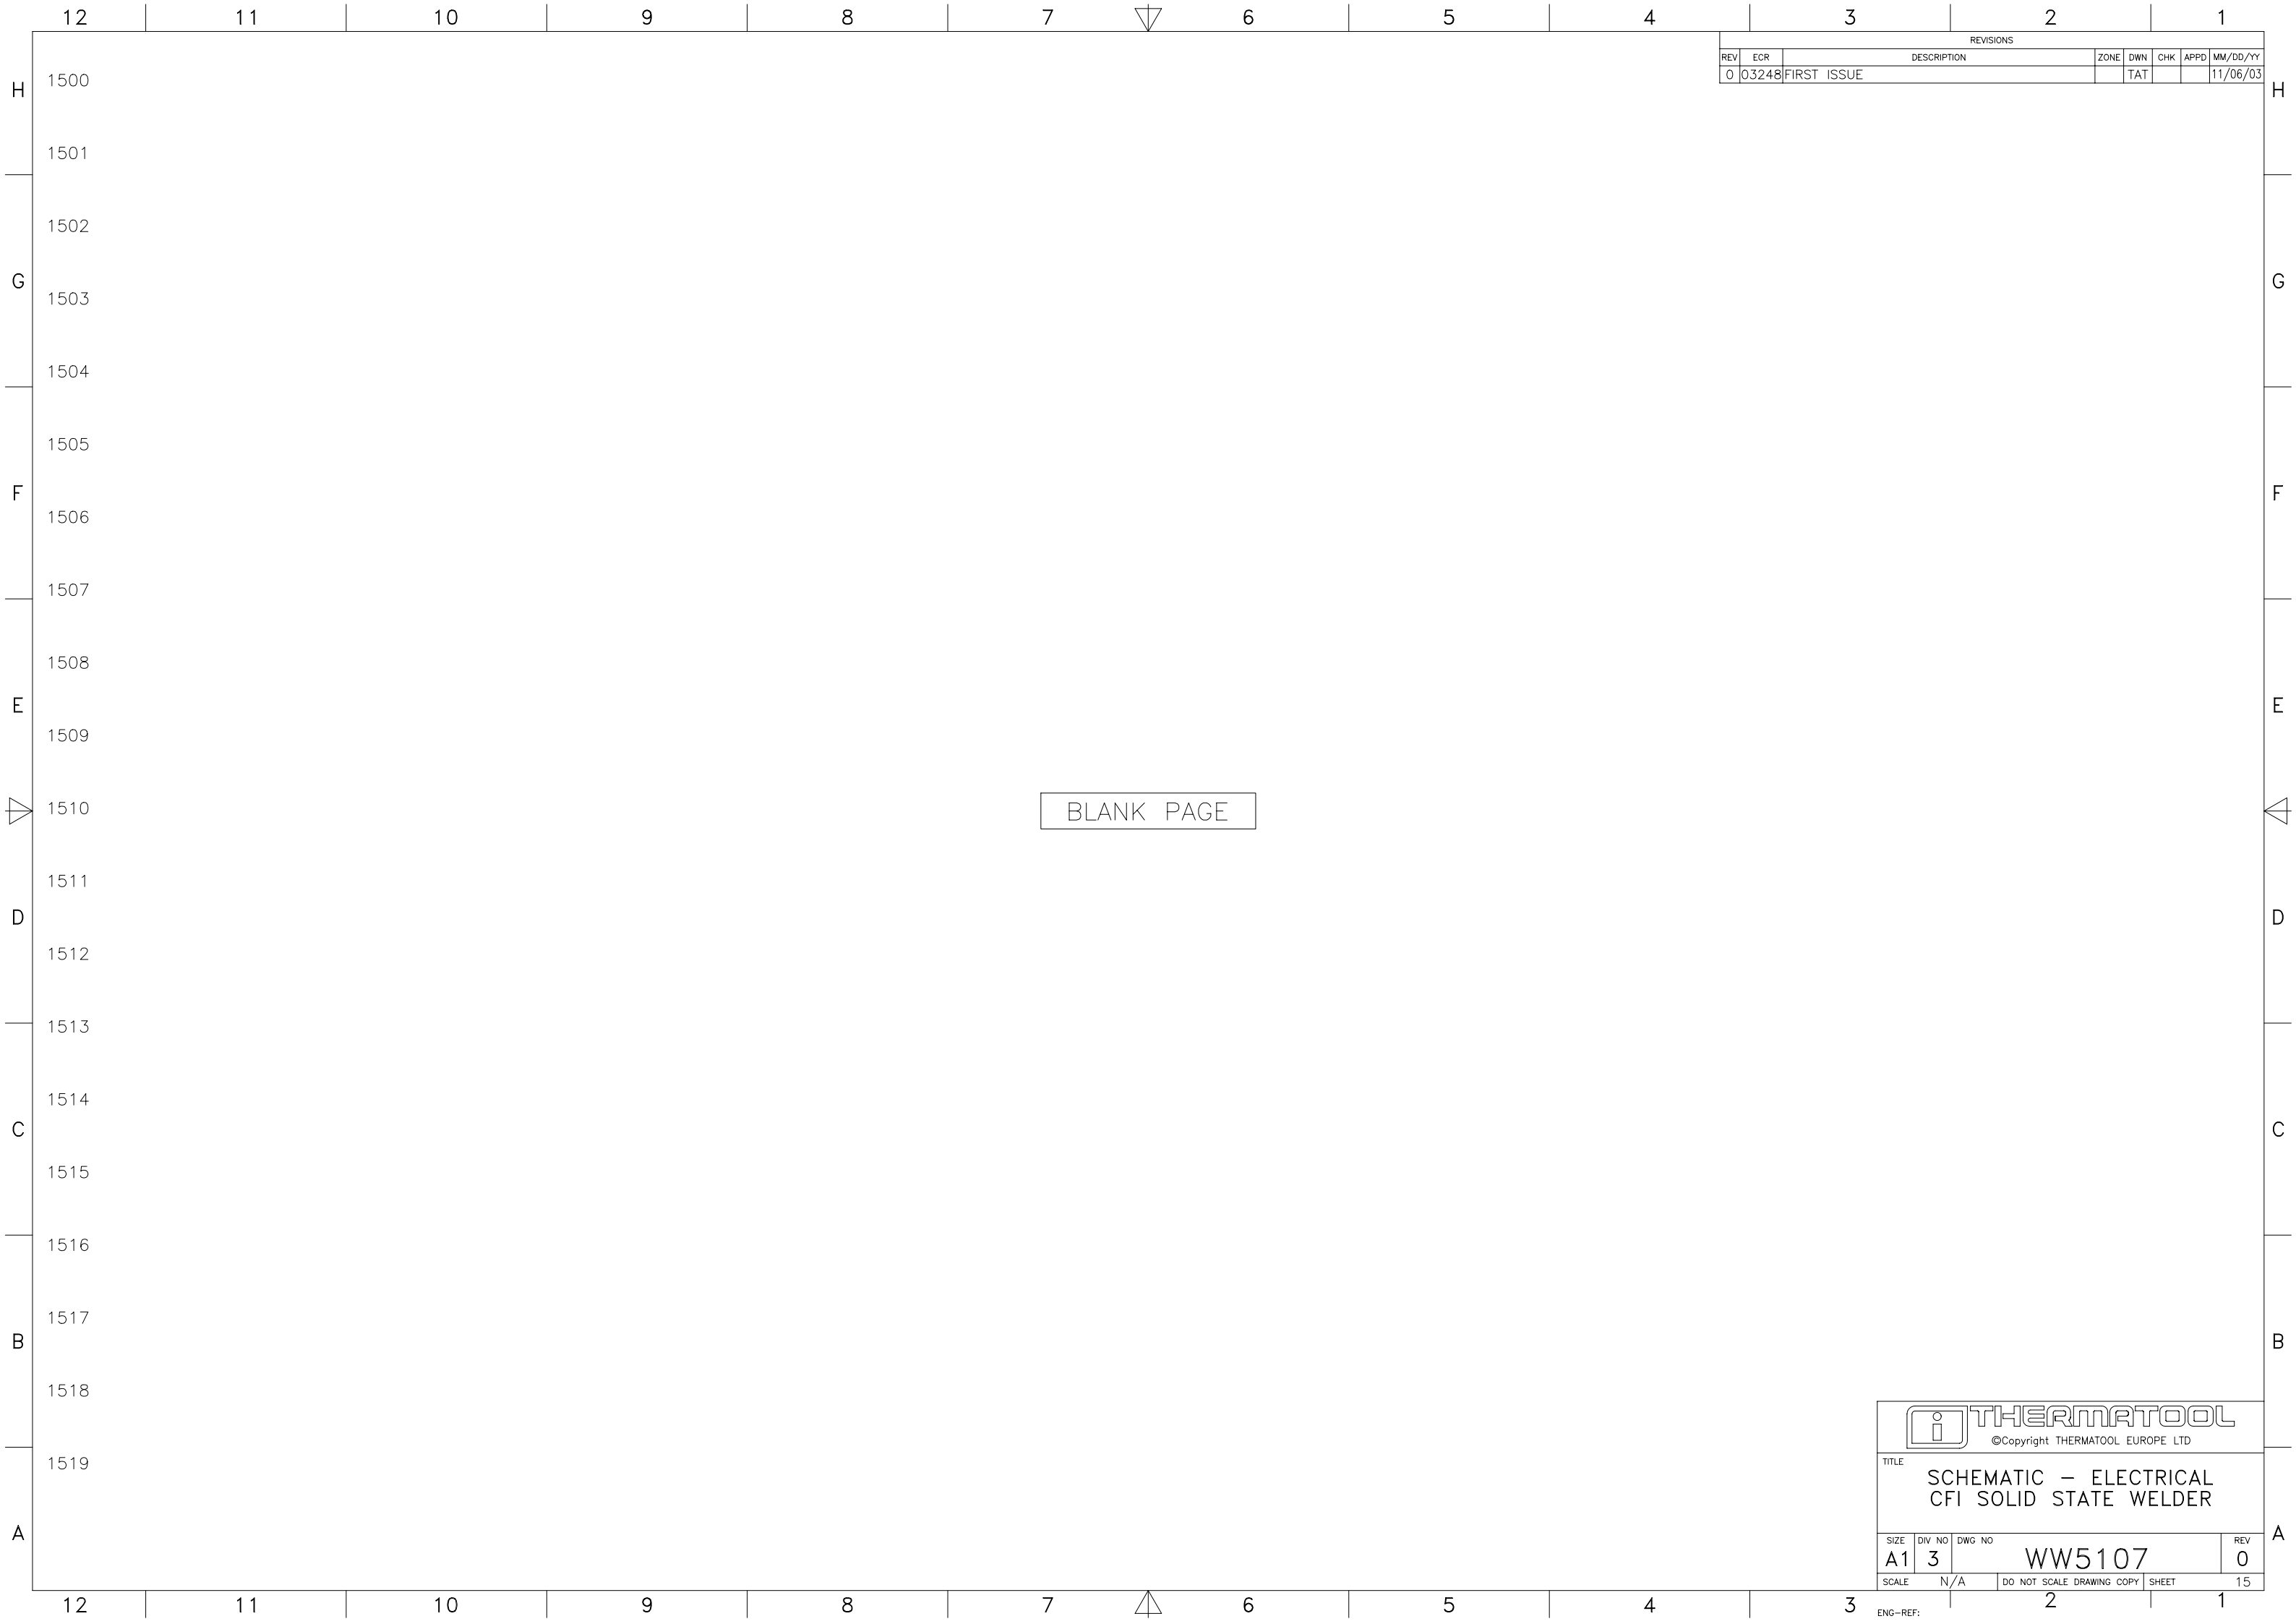

REVISIONS							
REV	ECR	DESCRIPTION	ZONE	DWN	CHK	APPD	MM/DD/YY
0	03248	FIRST ISSUE		TAT			11/06/03

BLANK PAGE




TITLE
**SCHEMATIC – ELECTRICAL
 CFI SOLID STATE WELDER**

SIZE	DIV NO	DWG NO	REV
A1	3	WW5107	0
SCALE	N/A	DO NOT SCALE DRAWING COPY	SHEET 15

ENG-REF: 2 1

PLC ANALOG INPUTS

REVISIONS							
REV	ECR	DESCRIPTION	ZONE	DWN	CHK	APPD	MM/DD/YY
0	03248	FIRST ISSUE				TAT	11/06/03
B	04256	PLC,CH 0, CORRECT TERM.NO FROM 3 TO 4	4F			TAT	11/16/04

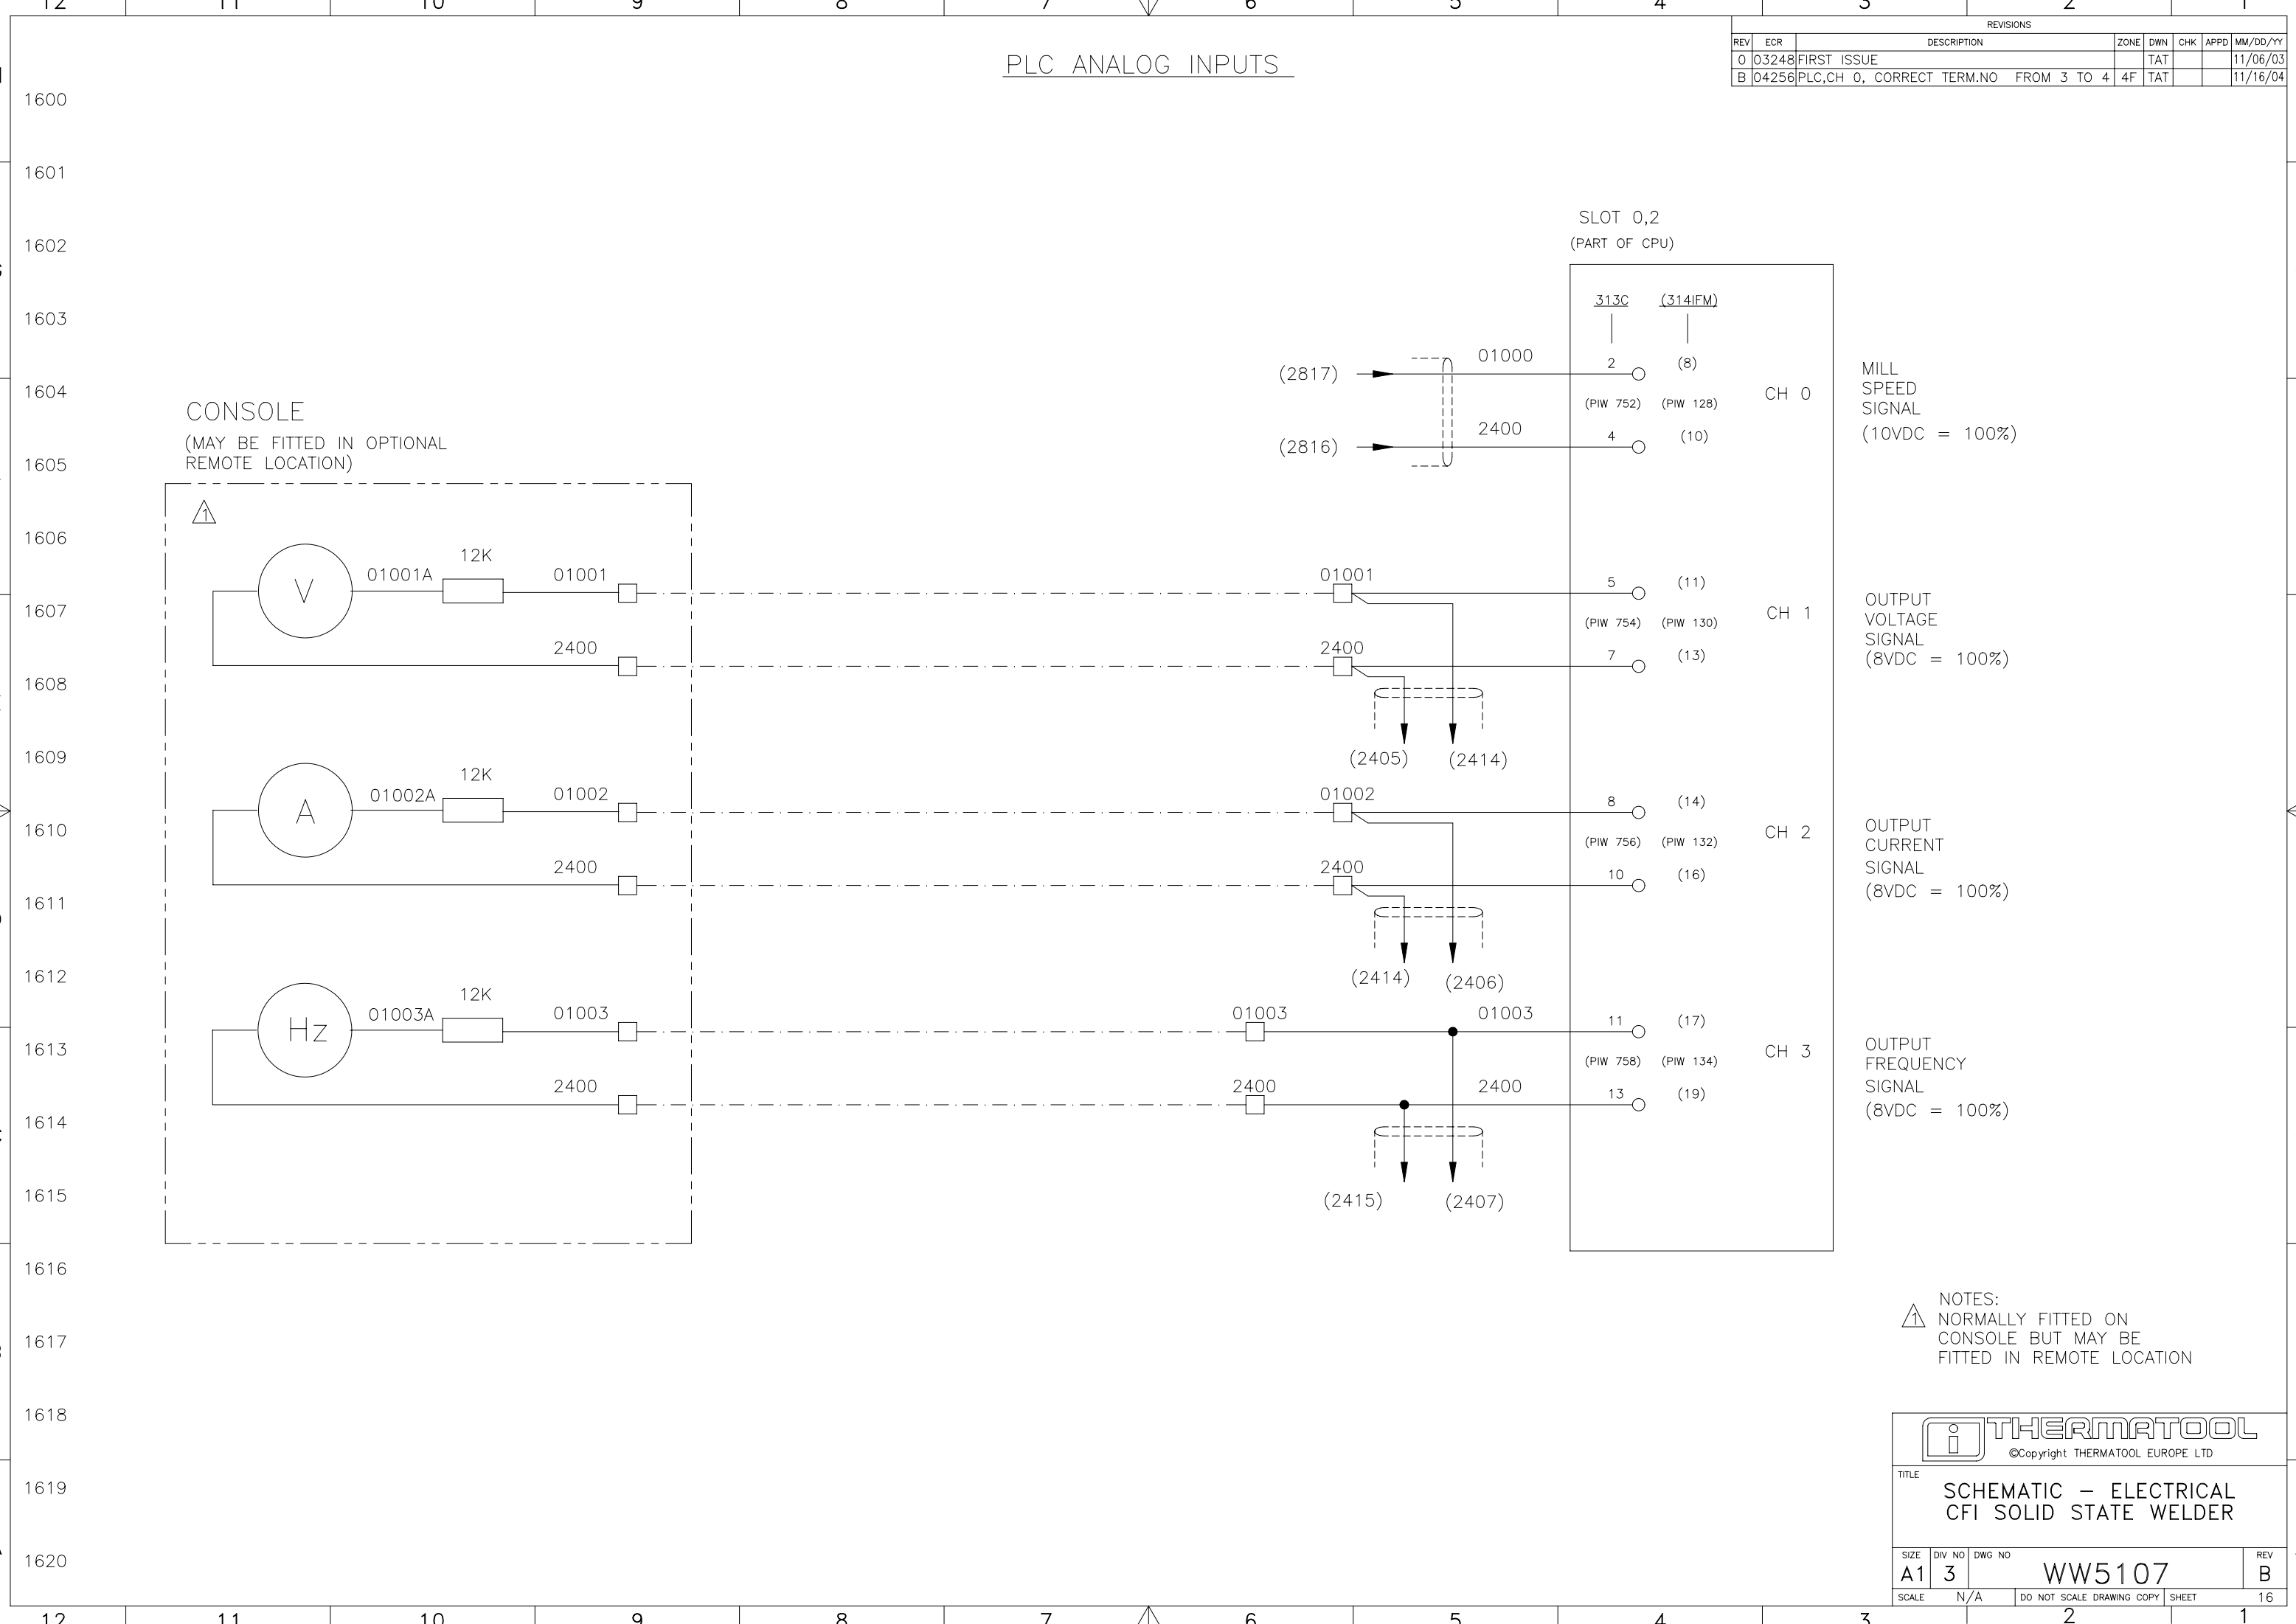

CONSOLE
(MAY BE FITTED IN OPTIONAL
REMOTE LOCATION)

SLOT 0,2
(PART OF CPU)

CH 0
MILL
SPEED
SIGNAL
(10VDC = 100%)

CH 1
OUTPUT
VOLTAGE
SIGNAL
(8VDC = 100%)

CH 2
OUTPUT
CURRENT
SIGNAL
(8VDC = 100%)


CH 3
OUTPUT
FREQUENCY
SIGNAL
(8VDC = 100%)

NOTES:
1. NORMALLY FITTED ON
CONSOLE BUT MAY BE
FITTED IN REMOTE LOCATION


©Copyright THERMATOOL EUROPE LTD			
TITLE SCHEMATIC – ELECTRICAL CFI SOLID STATE WELDER			
SIZE A1	DIV NO 3	DWG NO WW5107	REV B
SCALE N/A	DO NOT SCALE DRAWING COPY		SHEET 16

REVISIONS						
REV	ECR	DESCRIPTION	ZONE	DWN	CHK	APPD
0	03248	FIRST ISSUE		TAT		11/06/03

PLC DIGITAL INPUTS

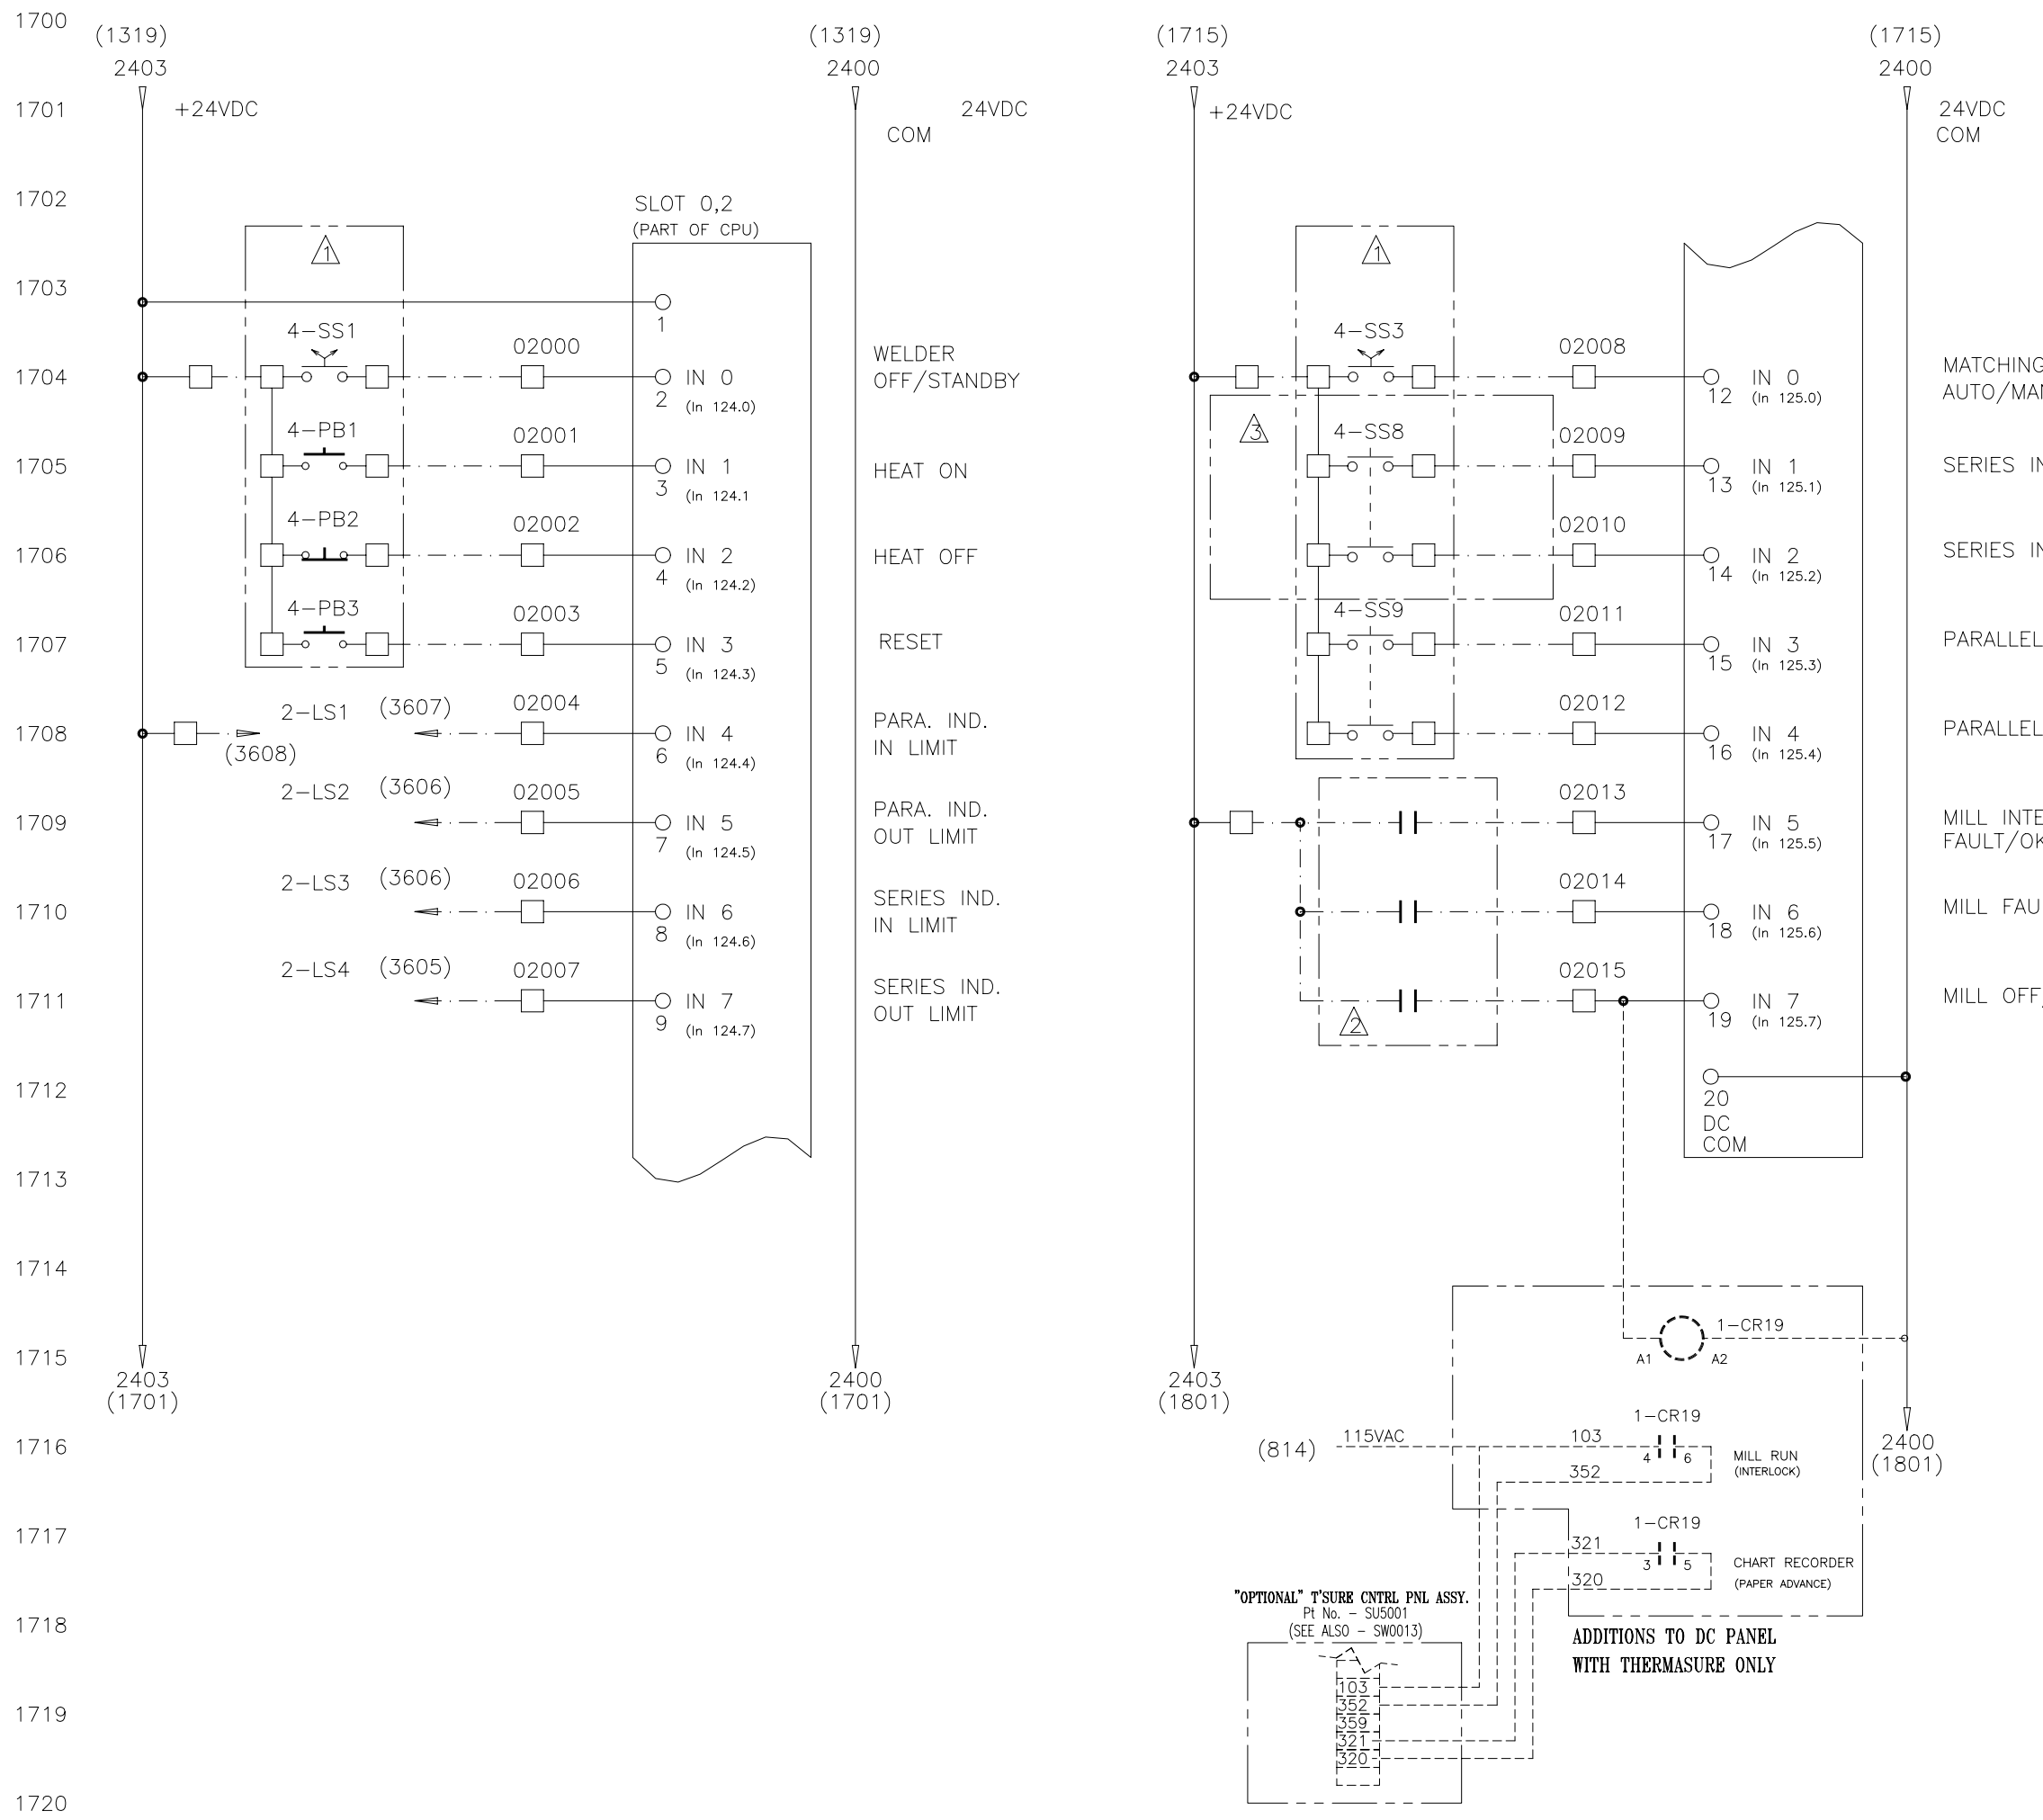

- NOTES:-
- ⚠️ NORMALLY FITTED ON CONSOLE BUT MAY BE FITTED IN REMOTE LOCATION
 - ⚠️ CUSTOMER INTERLOCK (SEE SHEET 23)
 - ⚠️ OMITTED ON 600 & 800kHz WELDERS

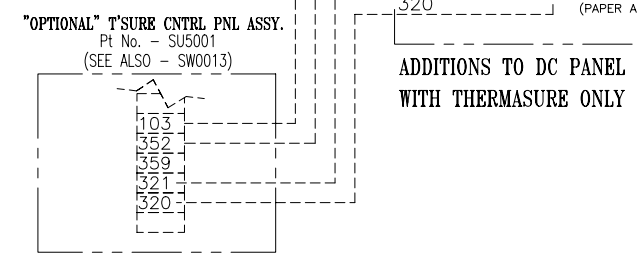

THERMATOOL
©Copyright THERMATOOL EUROPE LTD


TITLE: SCHEMATIC - ELECTRICAL CFI SOLID STATE WELDER

SIZE	DIV NO	DWG NO	REV
A1	3	WW5107	0

SCALE: N/A DO NOT SCALE DRAWING COPY SHEET 17

PLC DIGITAL INPUTS

REVISIONS							
REV	ECR	DESCRIPTION	ZONE	DWN	CHK	APPD	MM/DD/YY
0	03248	FIRST ISSUE		TAT			11/06/03
A	04102	SHOW ALTRNT 1-FLS & 1-PS1 WIRING	10F	TAT			07/15/04
B	04256	ALTRNT FLS1/FLS3 & CB1(NZM2/3/4) WIRNG	11	TAT			11/16/04

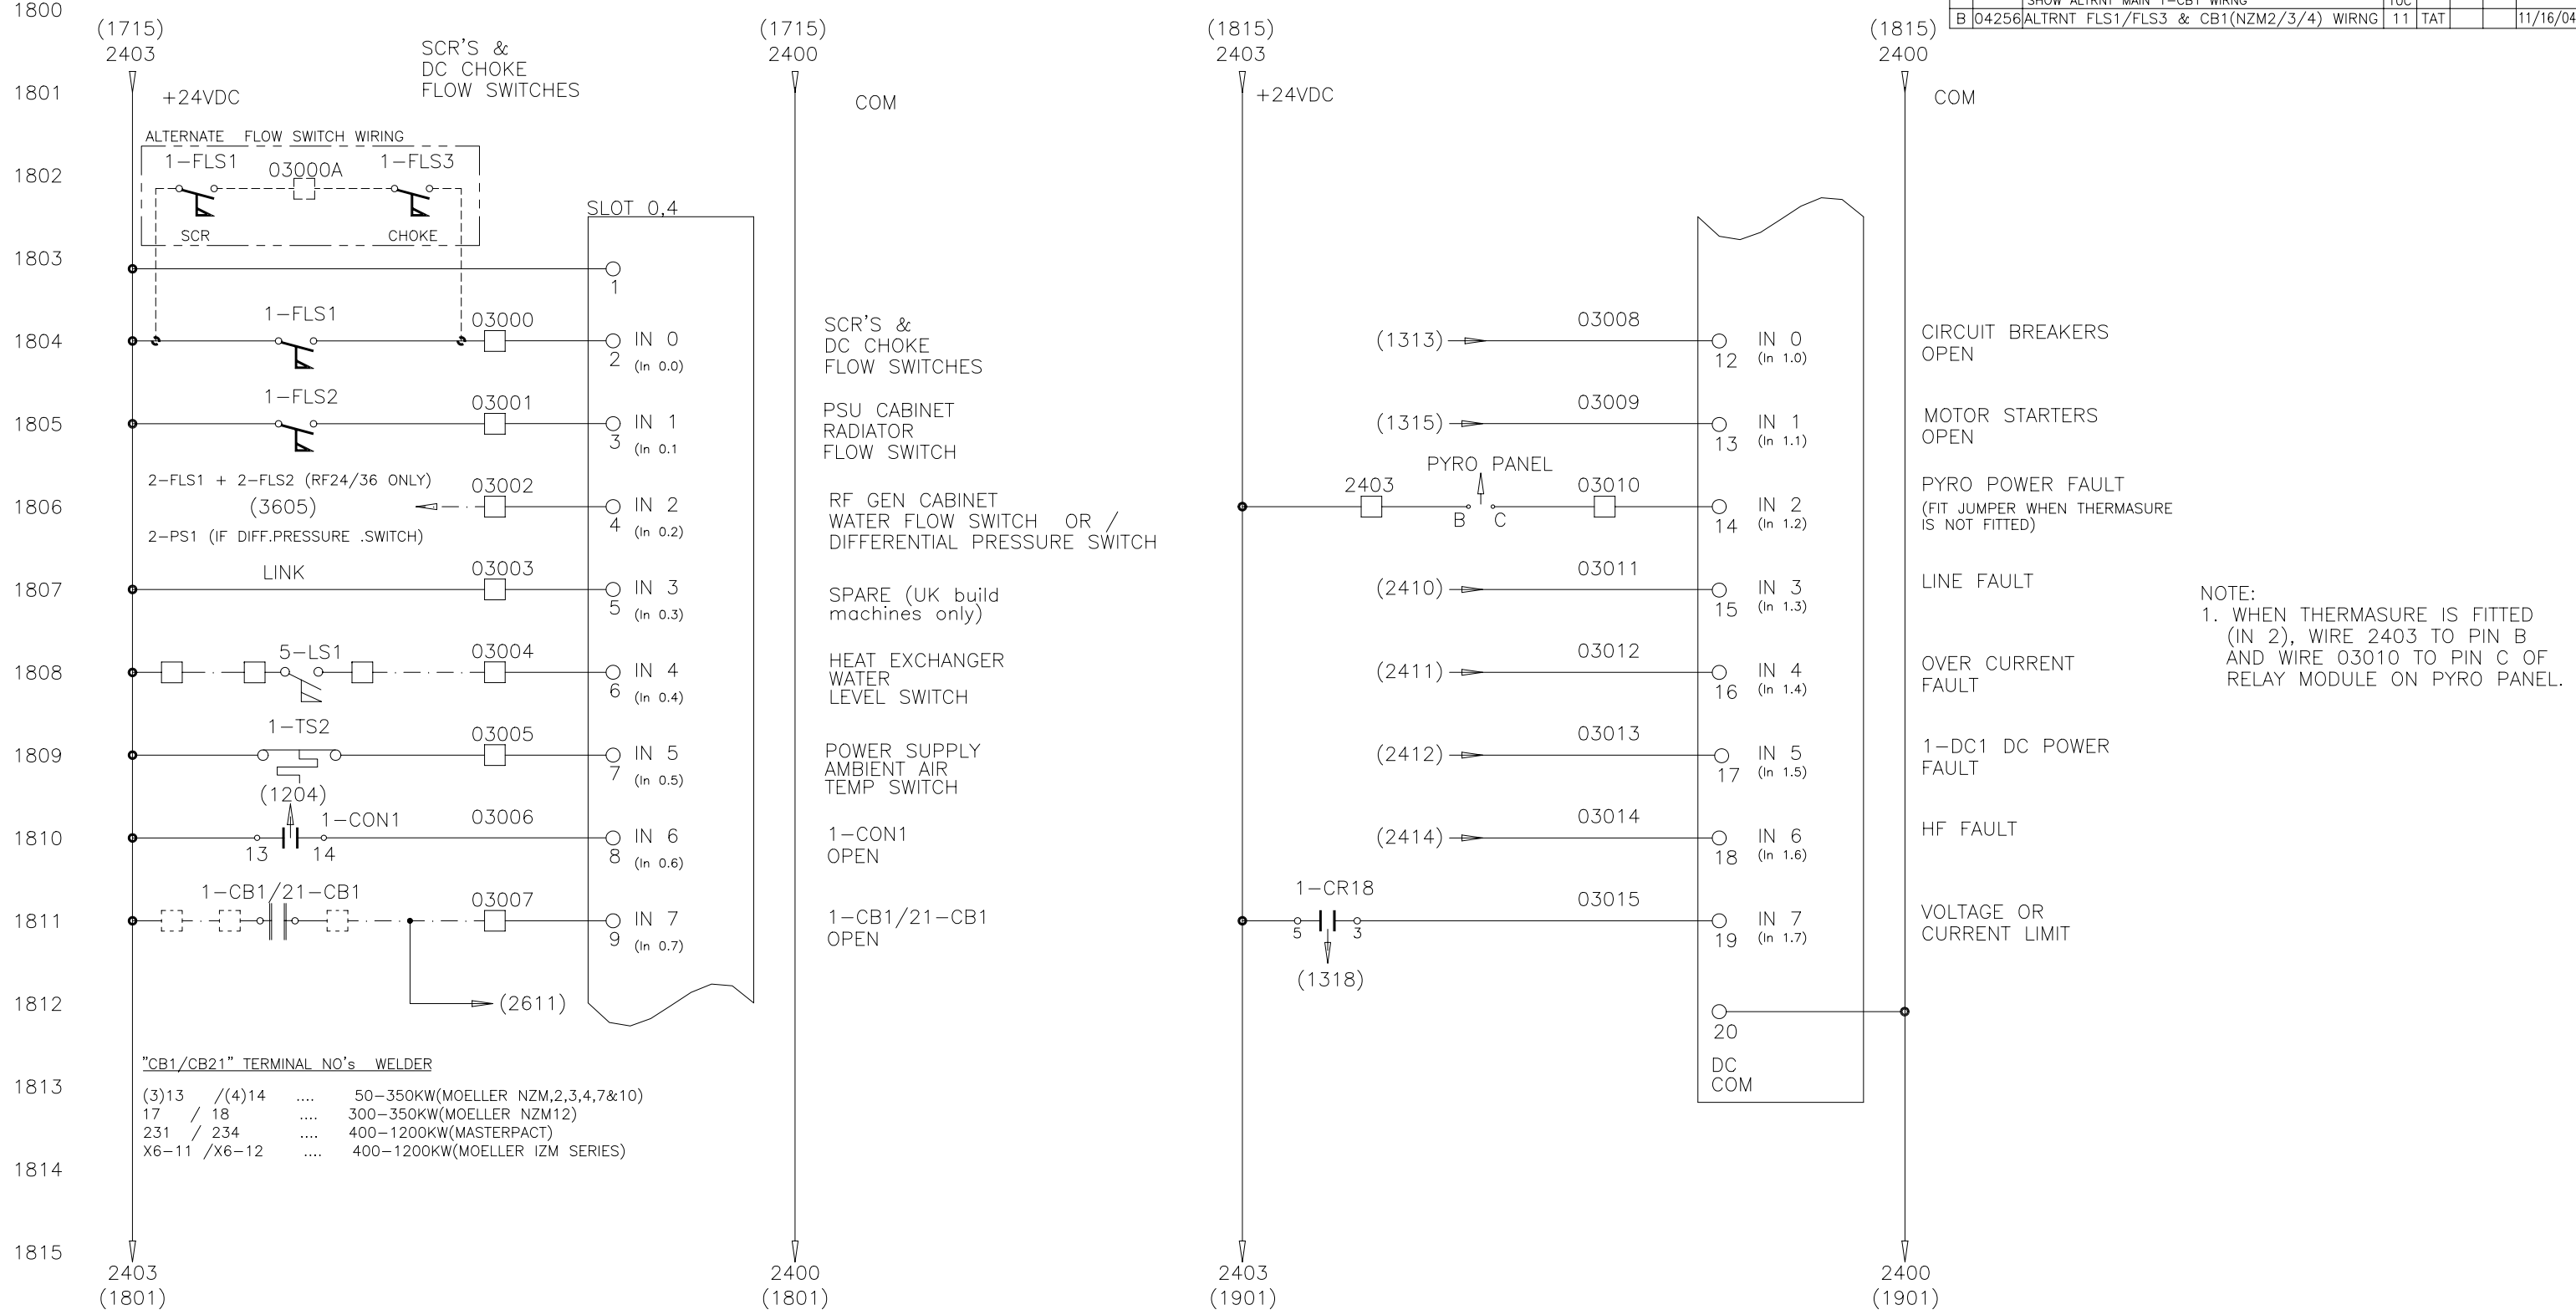

THERMATOOL
©Copyright THERMATOOL EUROPE LTD

TITLE: SCHEMATIC – ELECTRICAL CFI SOLID STATE WELDER


SIZE	DIV NO	DWG NO	REV
A1	3	WW5107	B

SCALE: N/A DO NOT SCALE DRAWING COPY SHEET 18

ENG-REF: 2

REVISIONS						
REV	ECR	DESCRIPTION	ZONE	DWN	CHK	APPD
0		FIRST ISSUE		TAT		
						MM/DD/YY
						11/06/03

PLC DIGITAL INPUTS

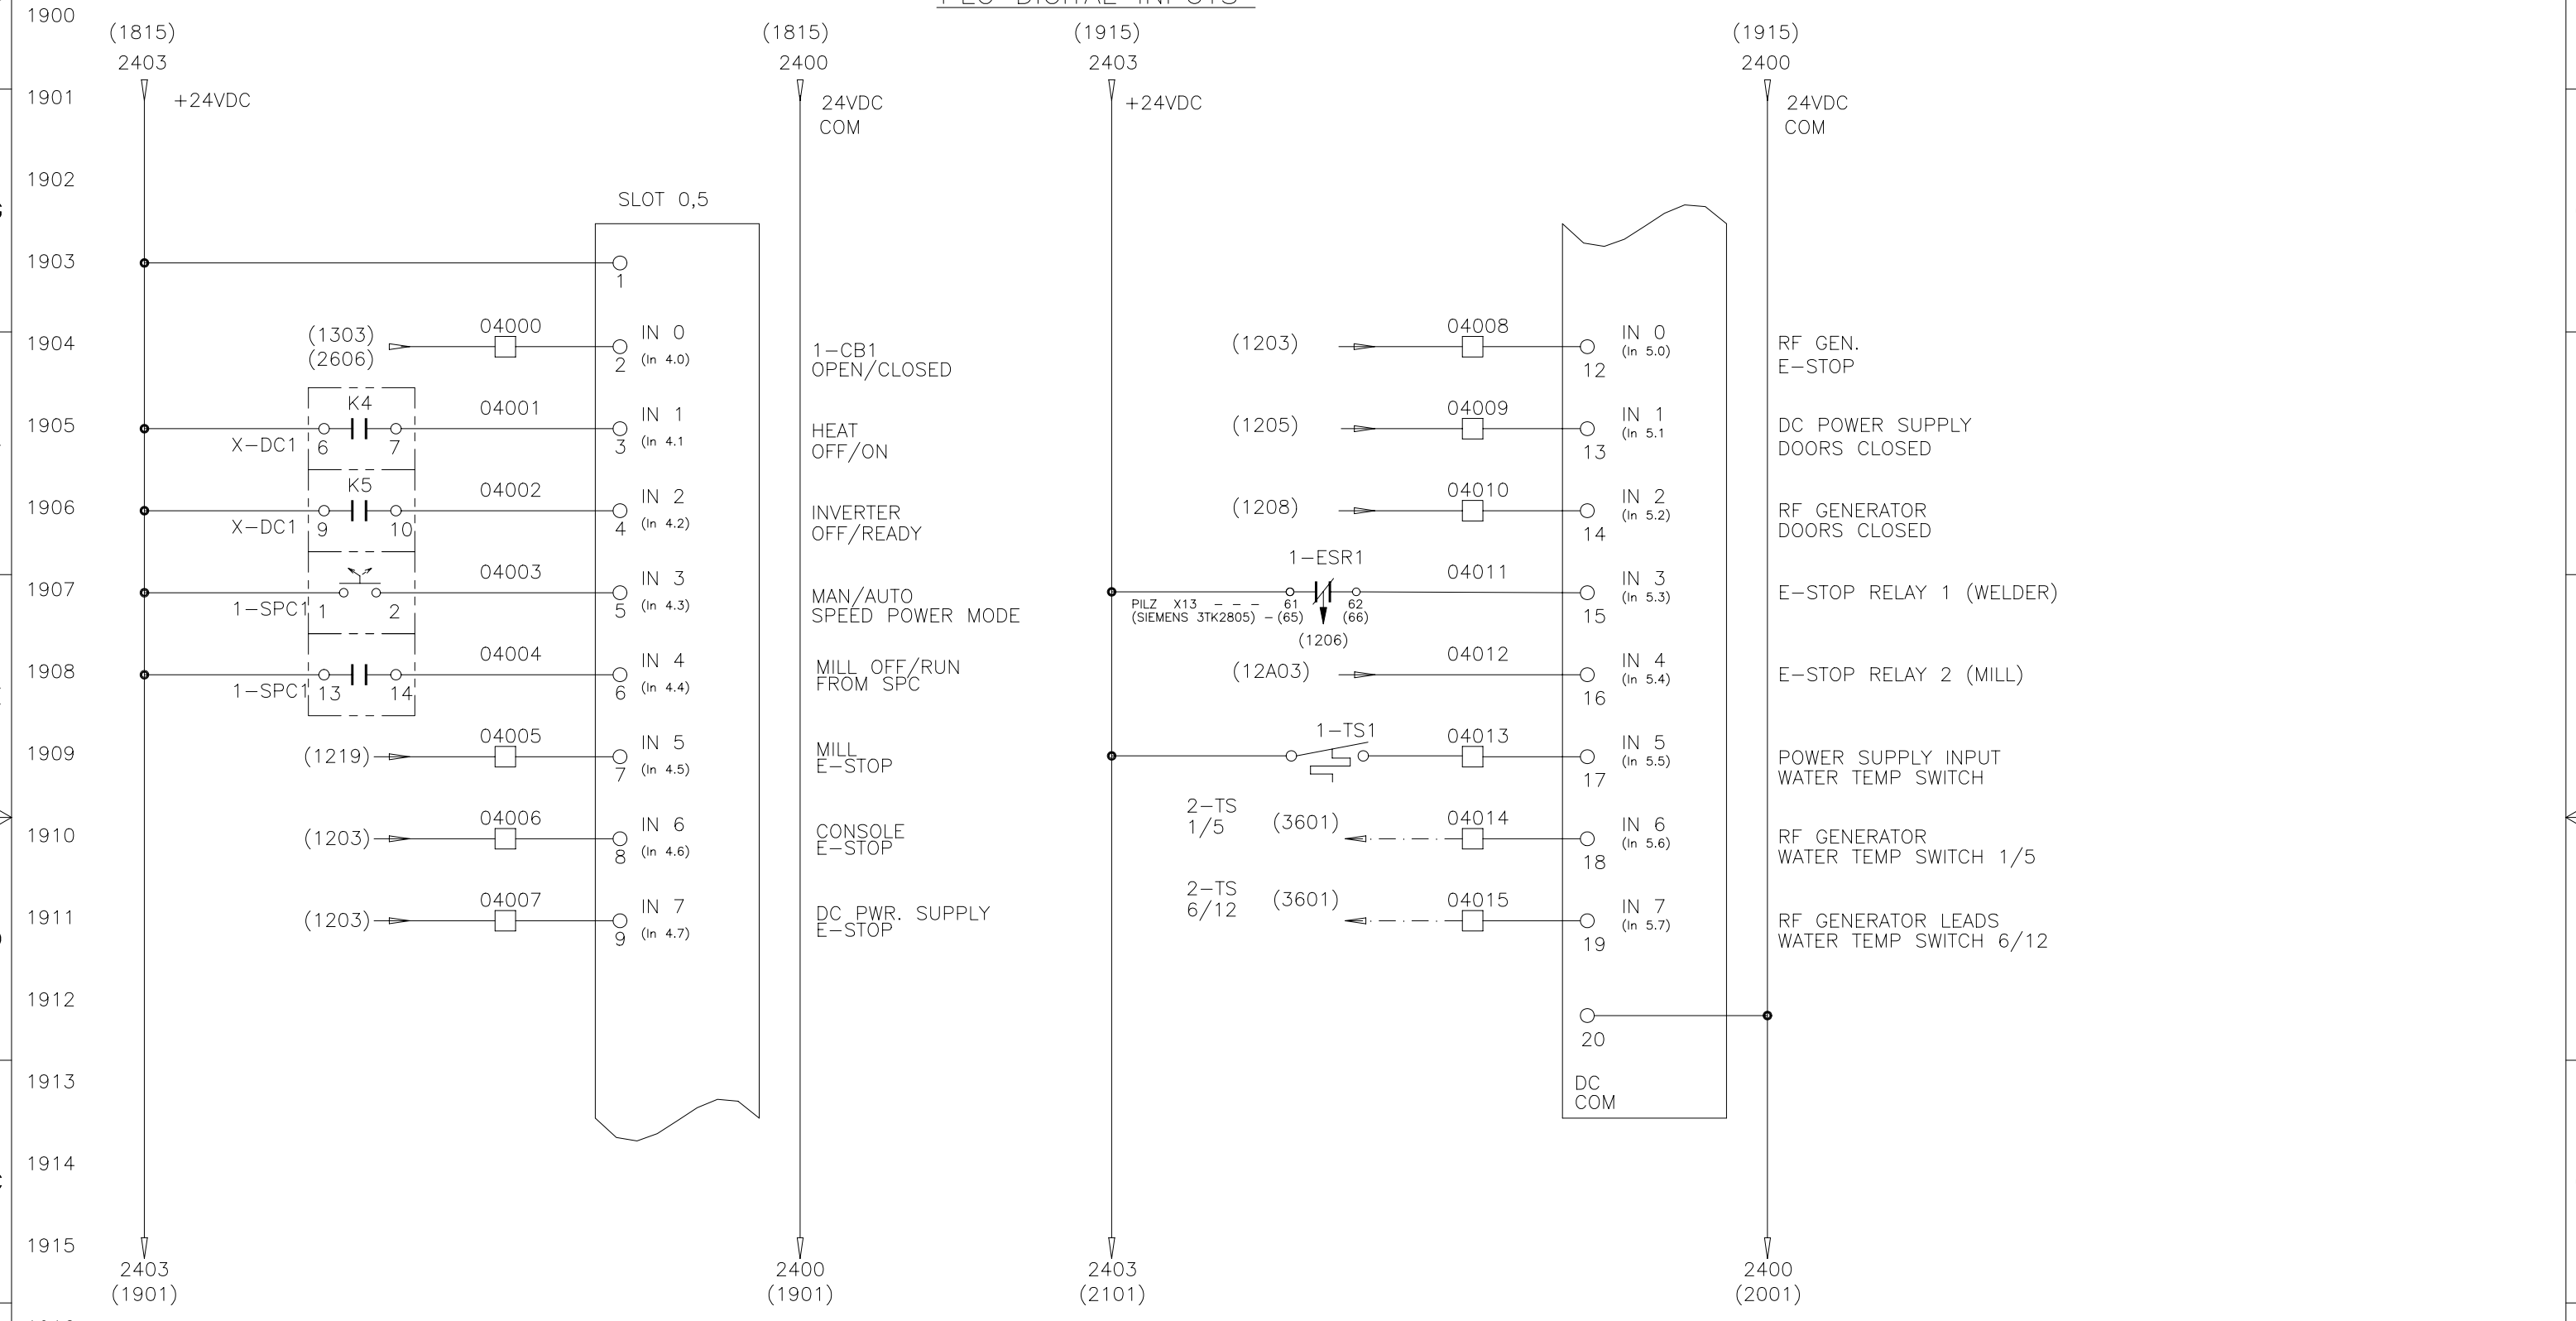

THERMATOOL
©Copyright THERMATOOL EUROPE LTD


TITLE: SCHEMATIC – ELECTRICAL CFI SOLID STATE WELDER

SIZE	DIV NO	DWG NO	REV
A1	3	WW5107	0
SCALE	DO NOT SCALE DRAWING COPY		SHEET
N/A			19

ENG-REF: 2

REVISIONS						
REV	ECR	DESCRIPTION	ZONE	DWN	CHK	APPD
0	03248	FIRST ISSUE		TAT		MM/DD/YY 11/06/03


PLC DIGITAL OUTPUTS (E-STOPPED)

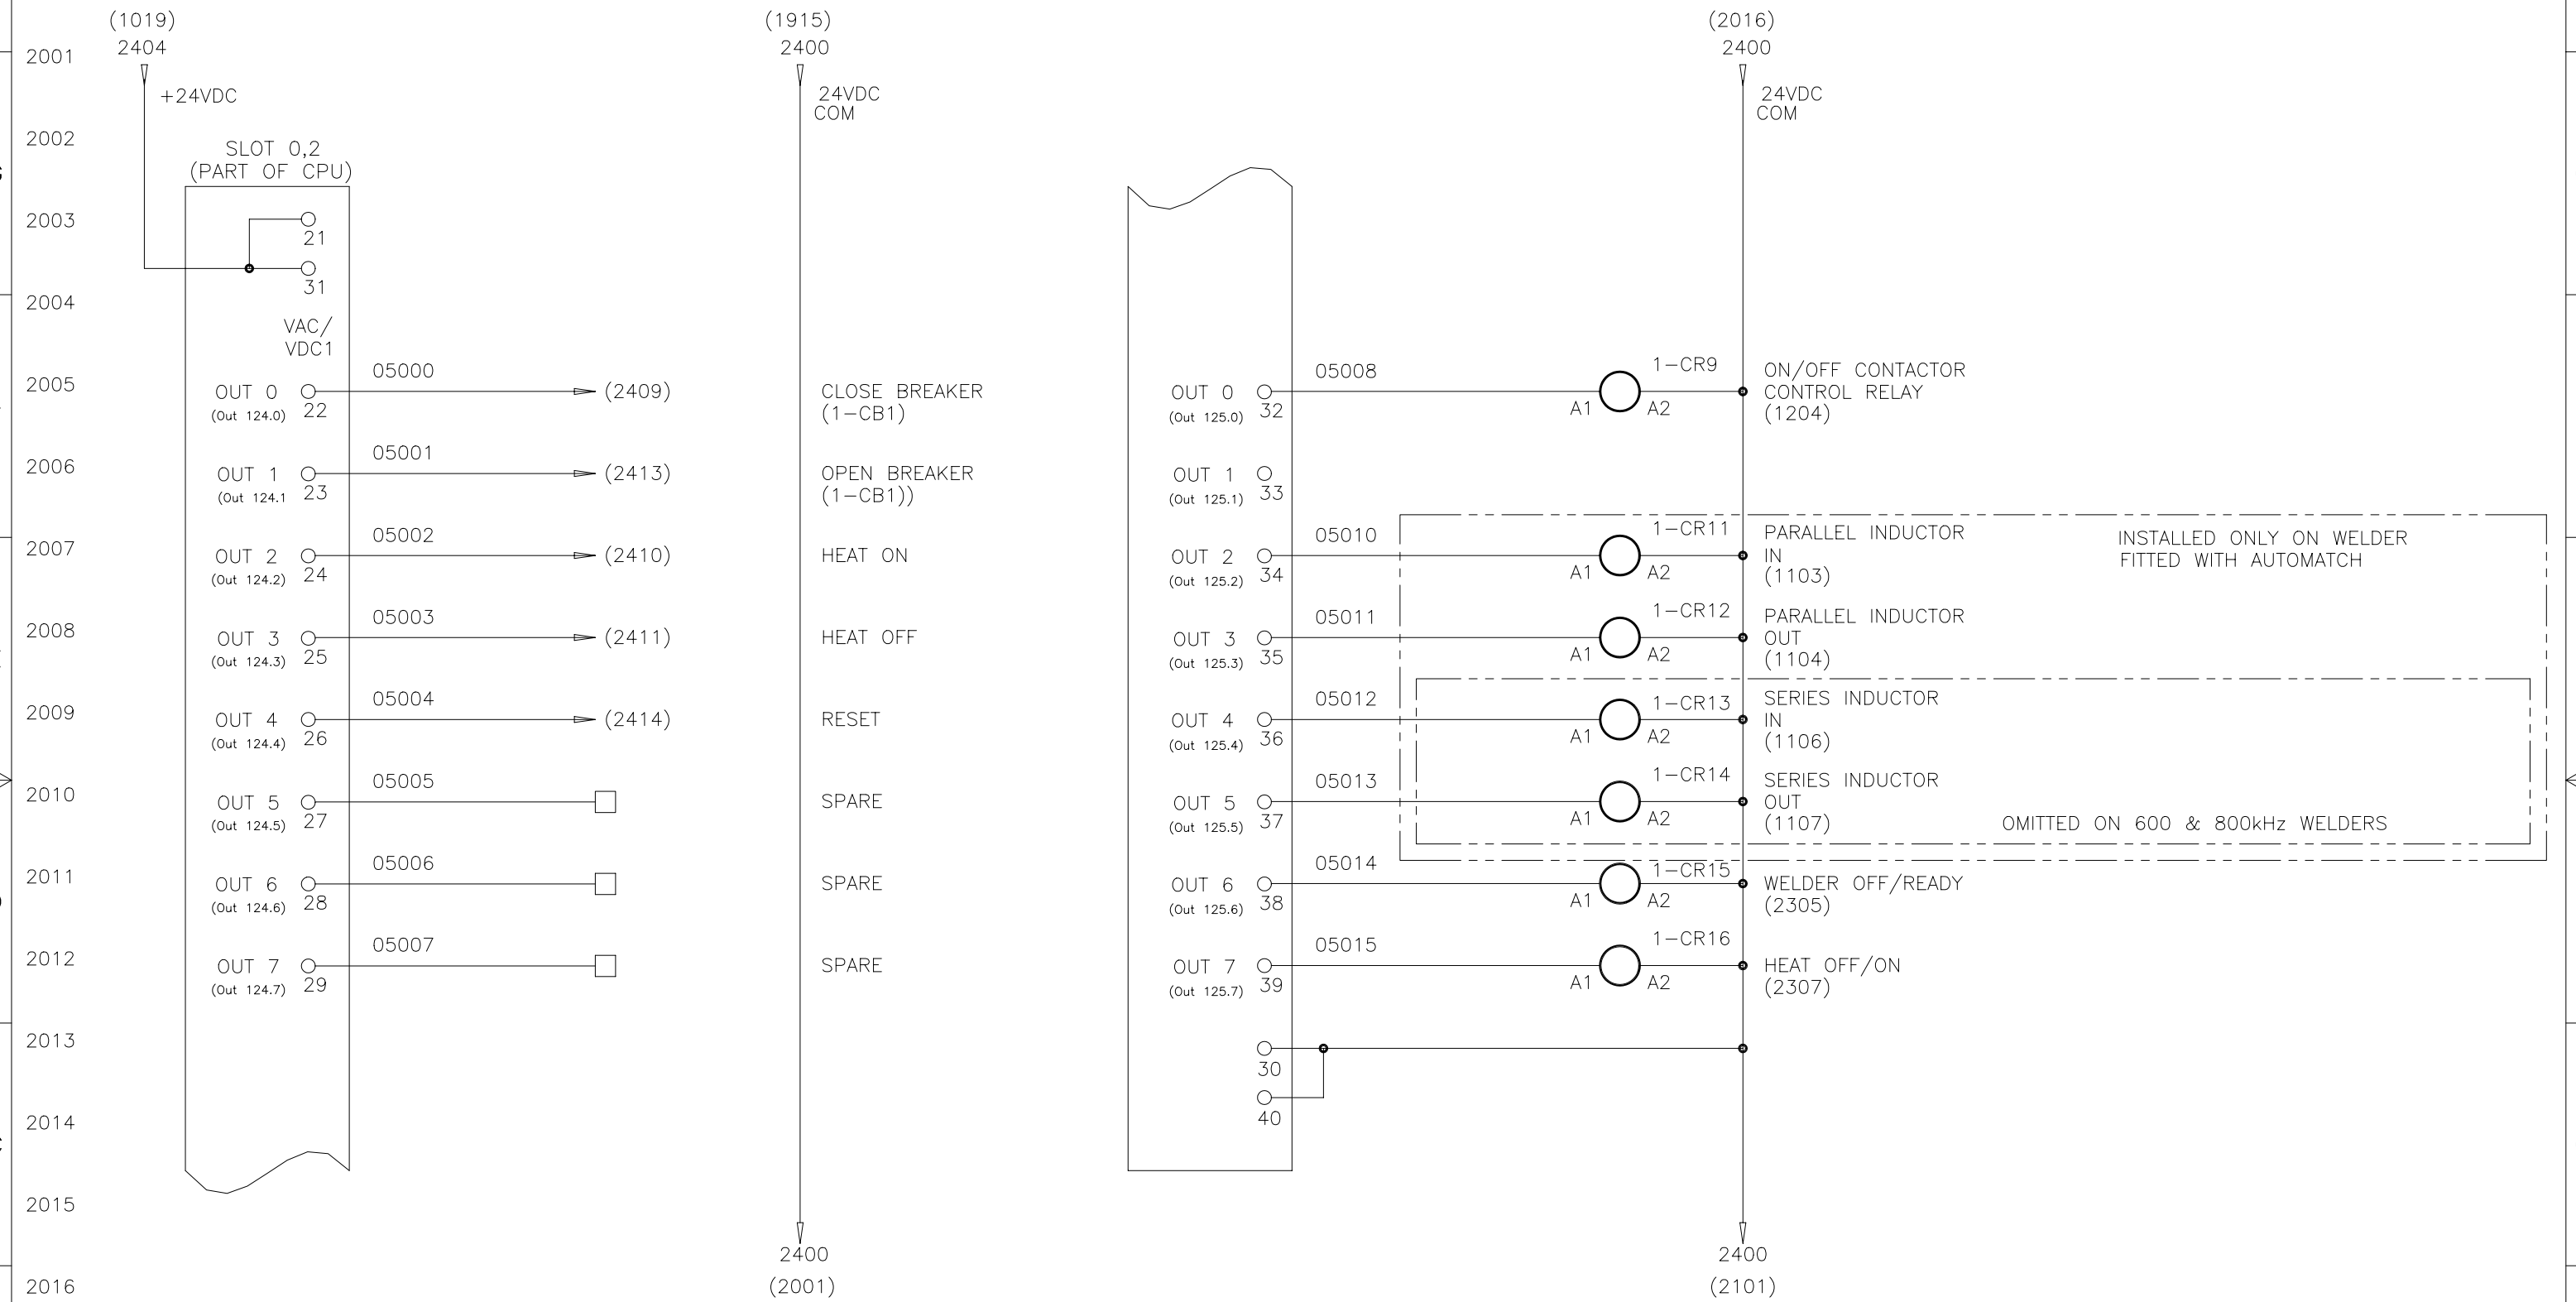

©Copyright THERMATOOL EUROPE LTD			
TITLE SCHEMATIC - DIAGRAM CFI SOLID STATE WELDER			
SIZE A1	DIV NO 3	DWG NO WW5107	REV 0
SCALE N/A		DO NOT SCALE DRAWING COPY SHEET 20	
ENG-REF: 2			

REVISIONS							
REV	ECR	DESCRIPTION	ZONE	DWN	CHK	APPD	MM/DD/YY
0	03248	FIRST ISSUE		TAT			11/06/03

PLC DIGITAL OUTPUTS

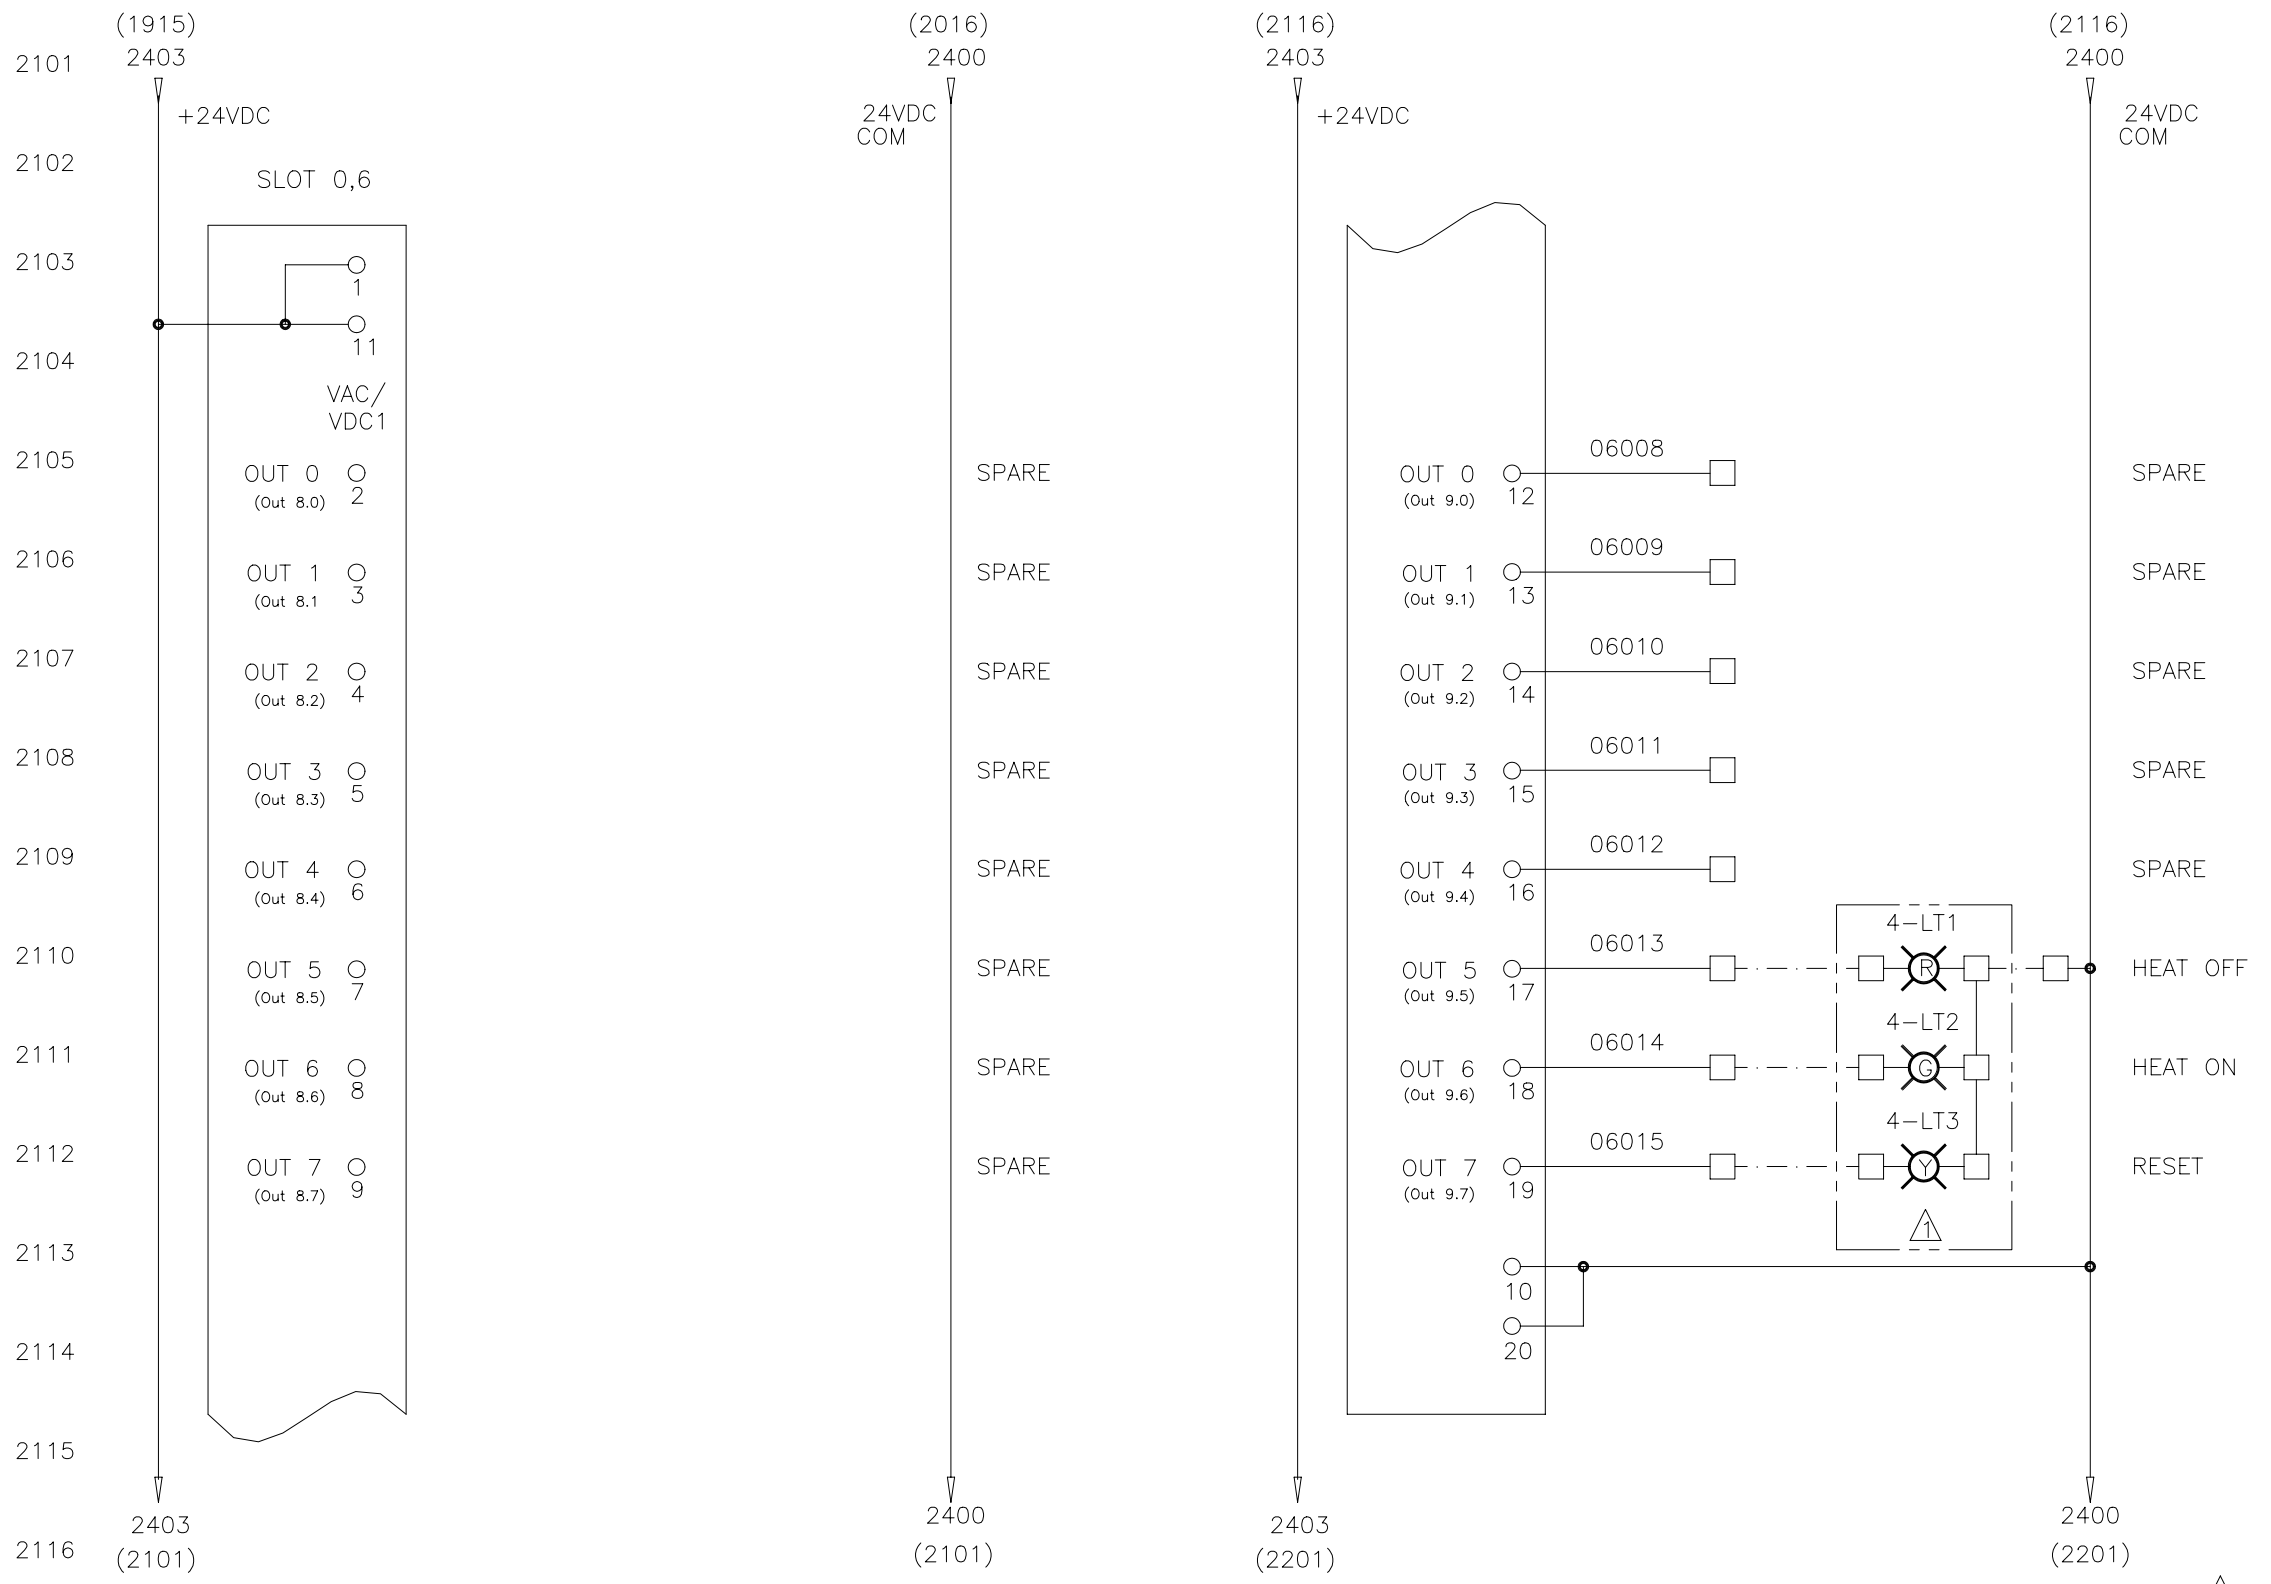


⚠️ NORMALLY FITTED ON CONSOLE BUT MAY BE FITTED IN REMOTE LOCATION

 ©Copyright THERMATOOL EUROPE LTD			
TITLE			
SCHEMATIC – ELECTRICAL CFI SOLID STATE WELDER			
SIZE	DIV NO	DWG NO	REV
A1	3	WW5107	0
SCALE	DO NOT SCALE DRAWING COPY		SHEET
N/A			21
ENG-REF:			2

PLC DIGITAL INPUTS (CUSTOMER FAULTS)


REVISIONS							
REV	ECR	DESCRIPTION	ZONE	DWN	CHK	APPD	MM/DD/YY
0	03248	FIRST ISSUE		TAT			11/06/03
B	04256	ADD COMMENTS TO CUSTOMER FAULTS		TAT			11/16/04

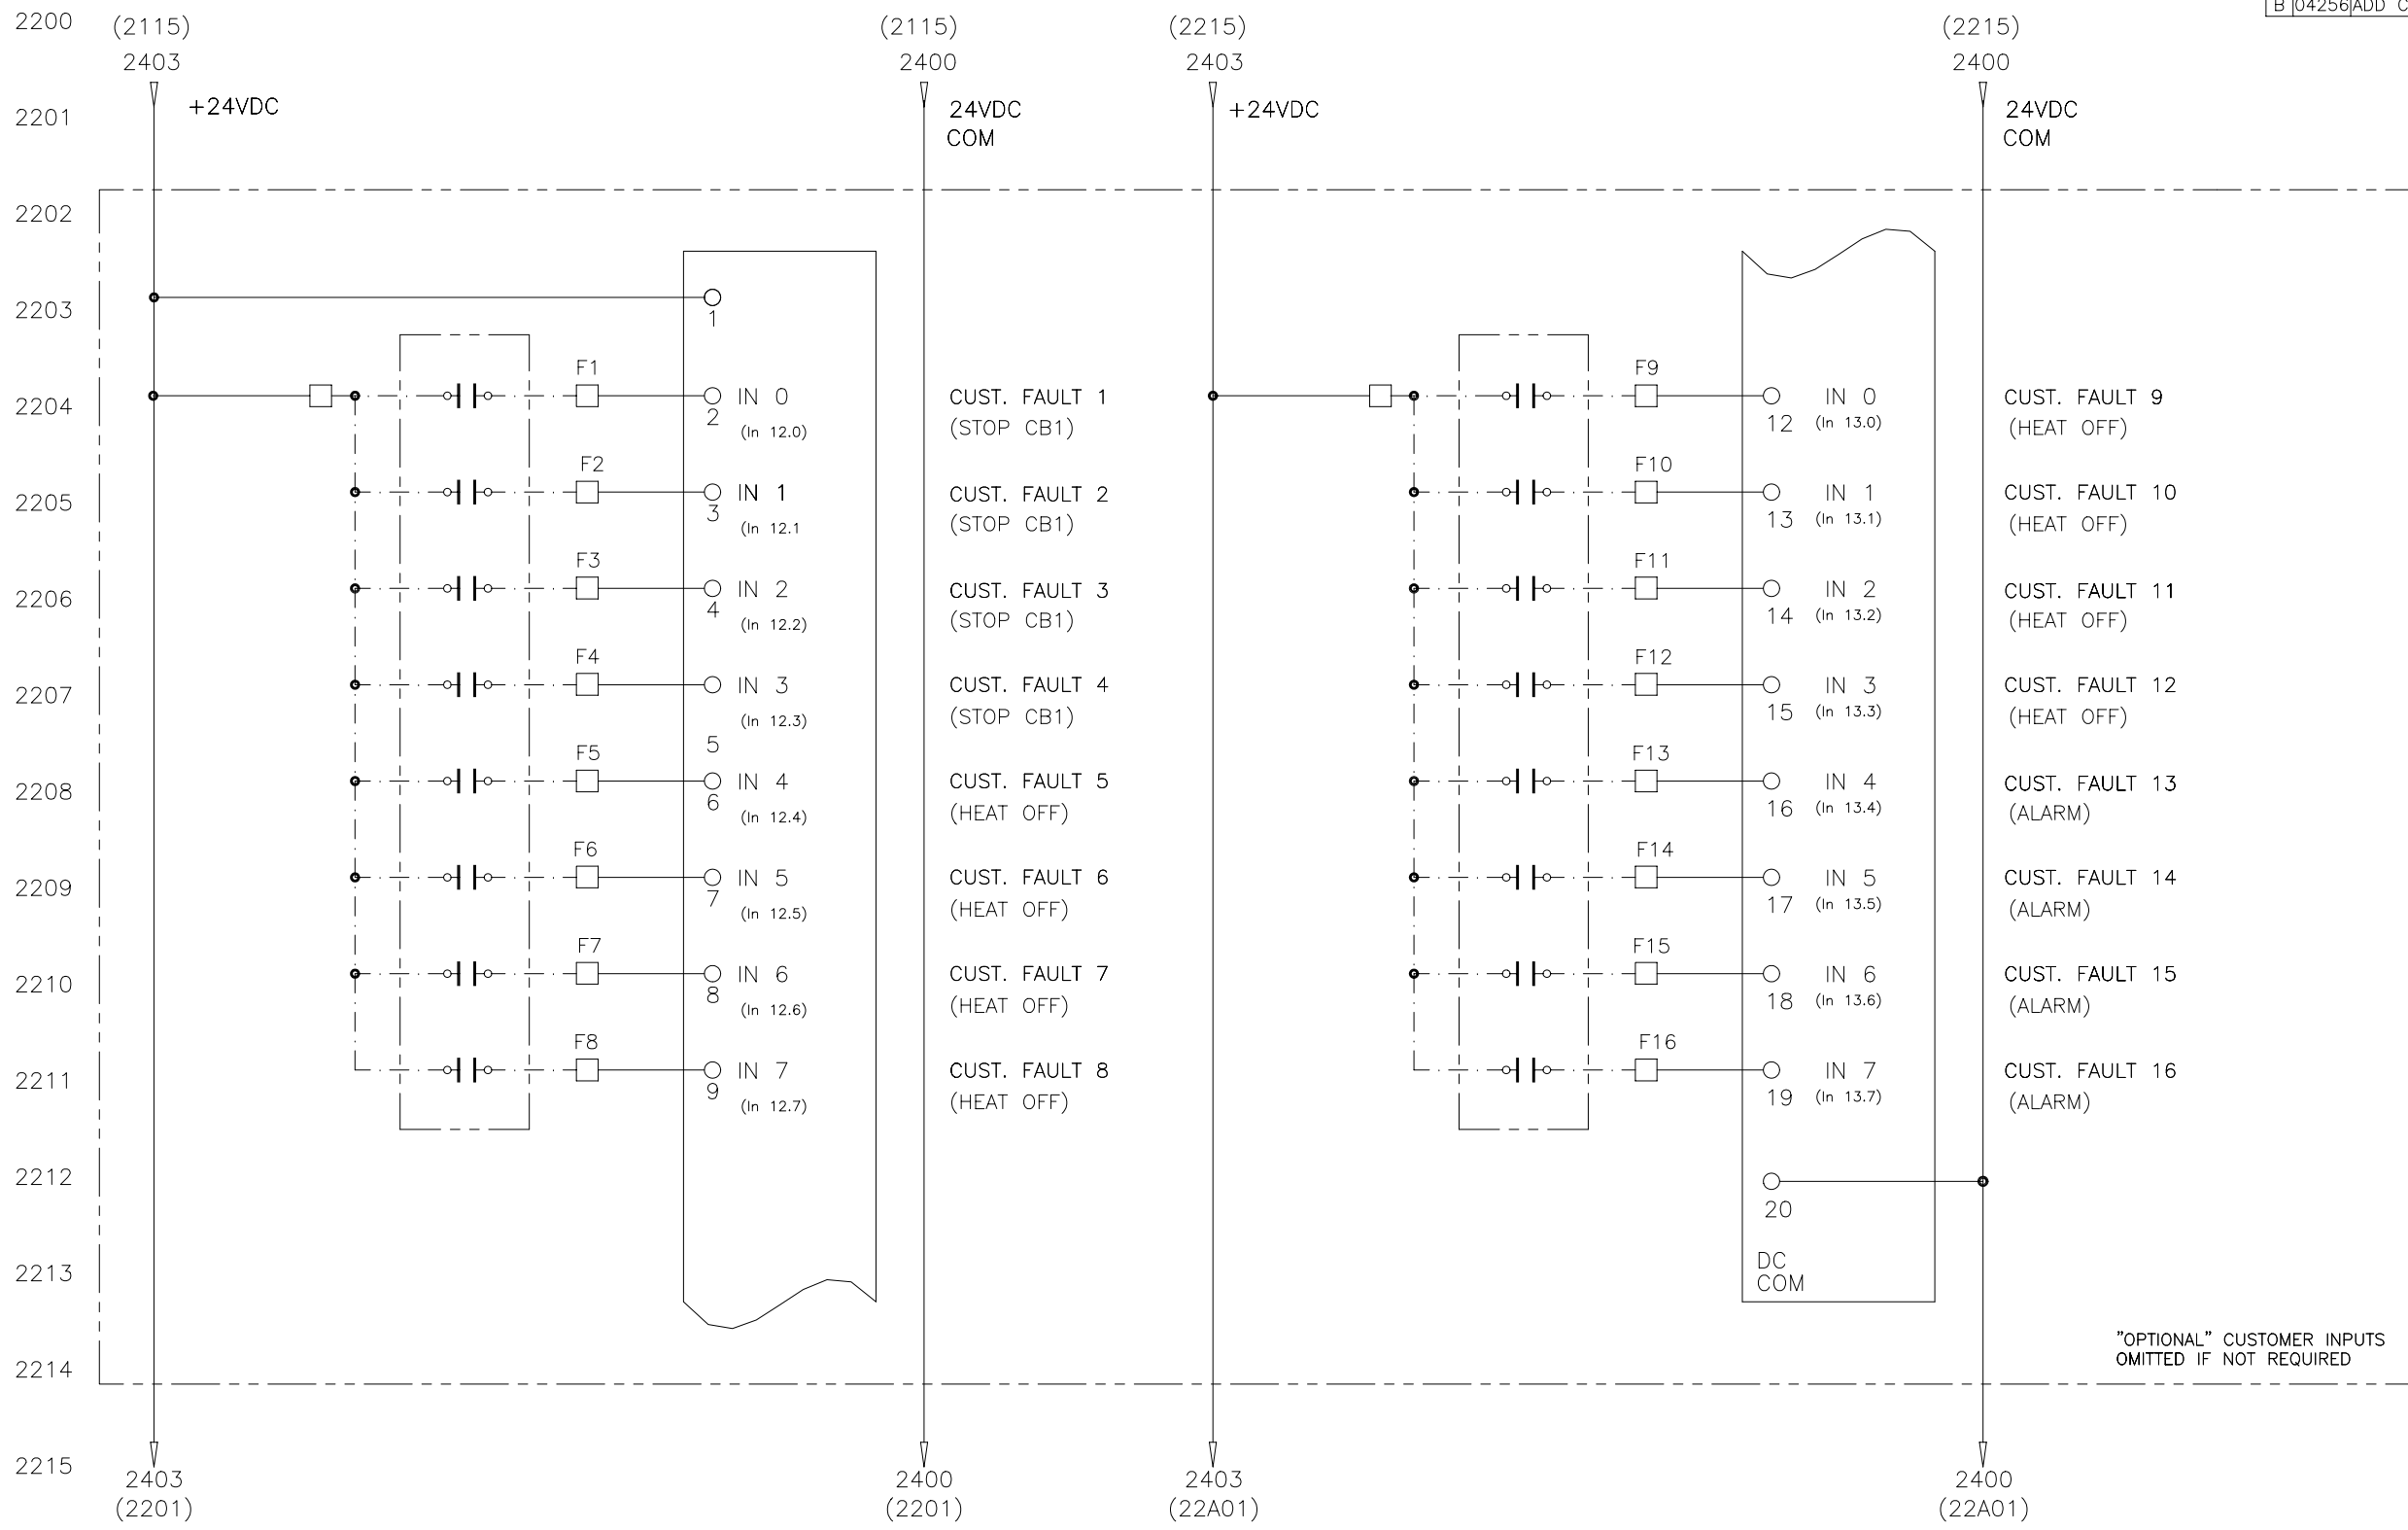

©Copyright THERMATOOL EUROPE LTD			
TITLE SCHEMATIC – ELECTRICAL CFI SOLID STATE WELDER.			
SIZE A1	DIV NO 3	DWG NO WW5107	REV B
SCALE N/A	DO NOT SCALE DRAWING COPY		SHEET 22

PLC DIGITAL INPUTS (CUSTOMER FAULTS)

REVISIONS							
REV	ECR	DESCRIPTION	ZONE	DWN	CHK	APPD	MM/DD/YY
0	03248	FIRST ISSUE		TAT			11/06/03
B	04256	ADD COMMENTS TO CUSTOMER FAULTS		TAT			11/16/04

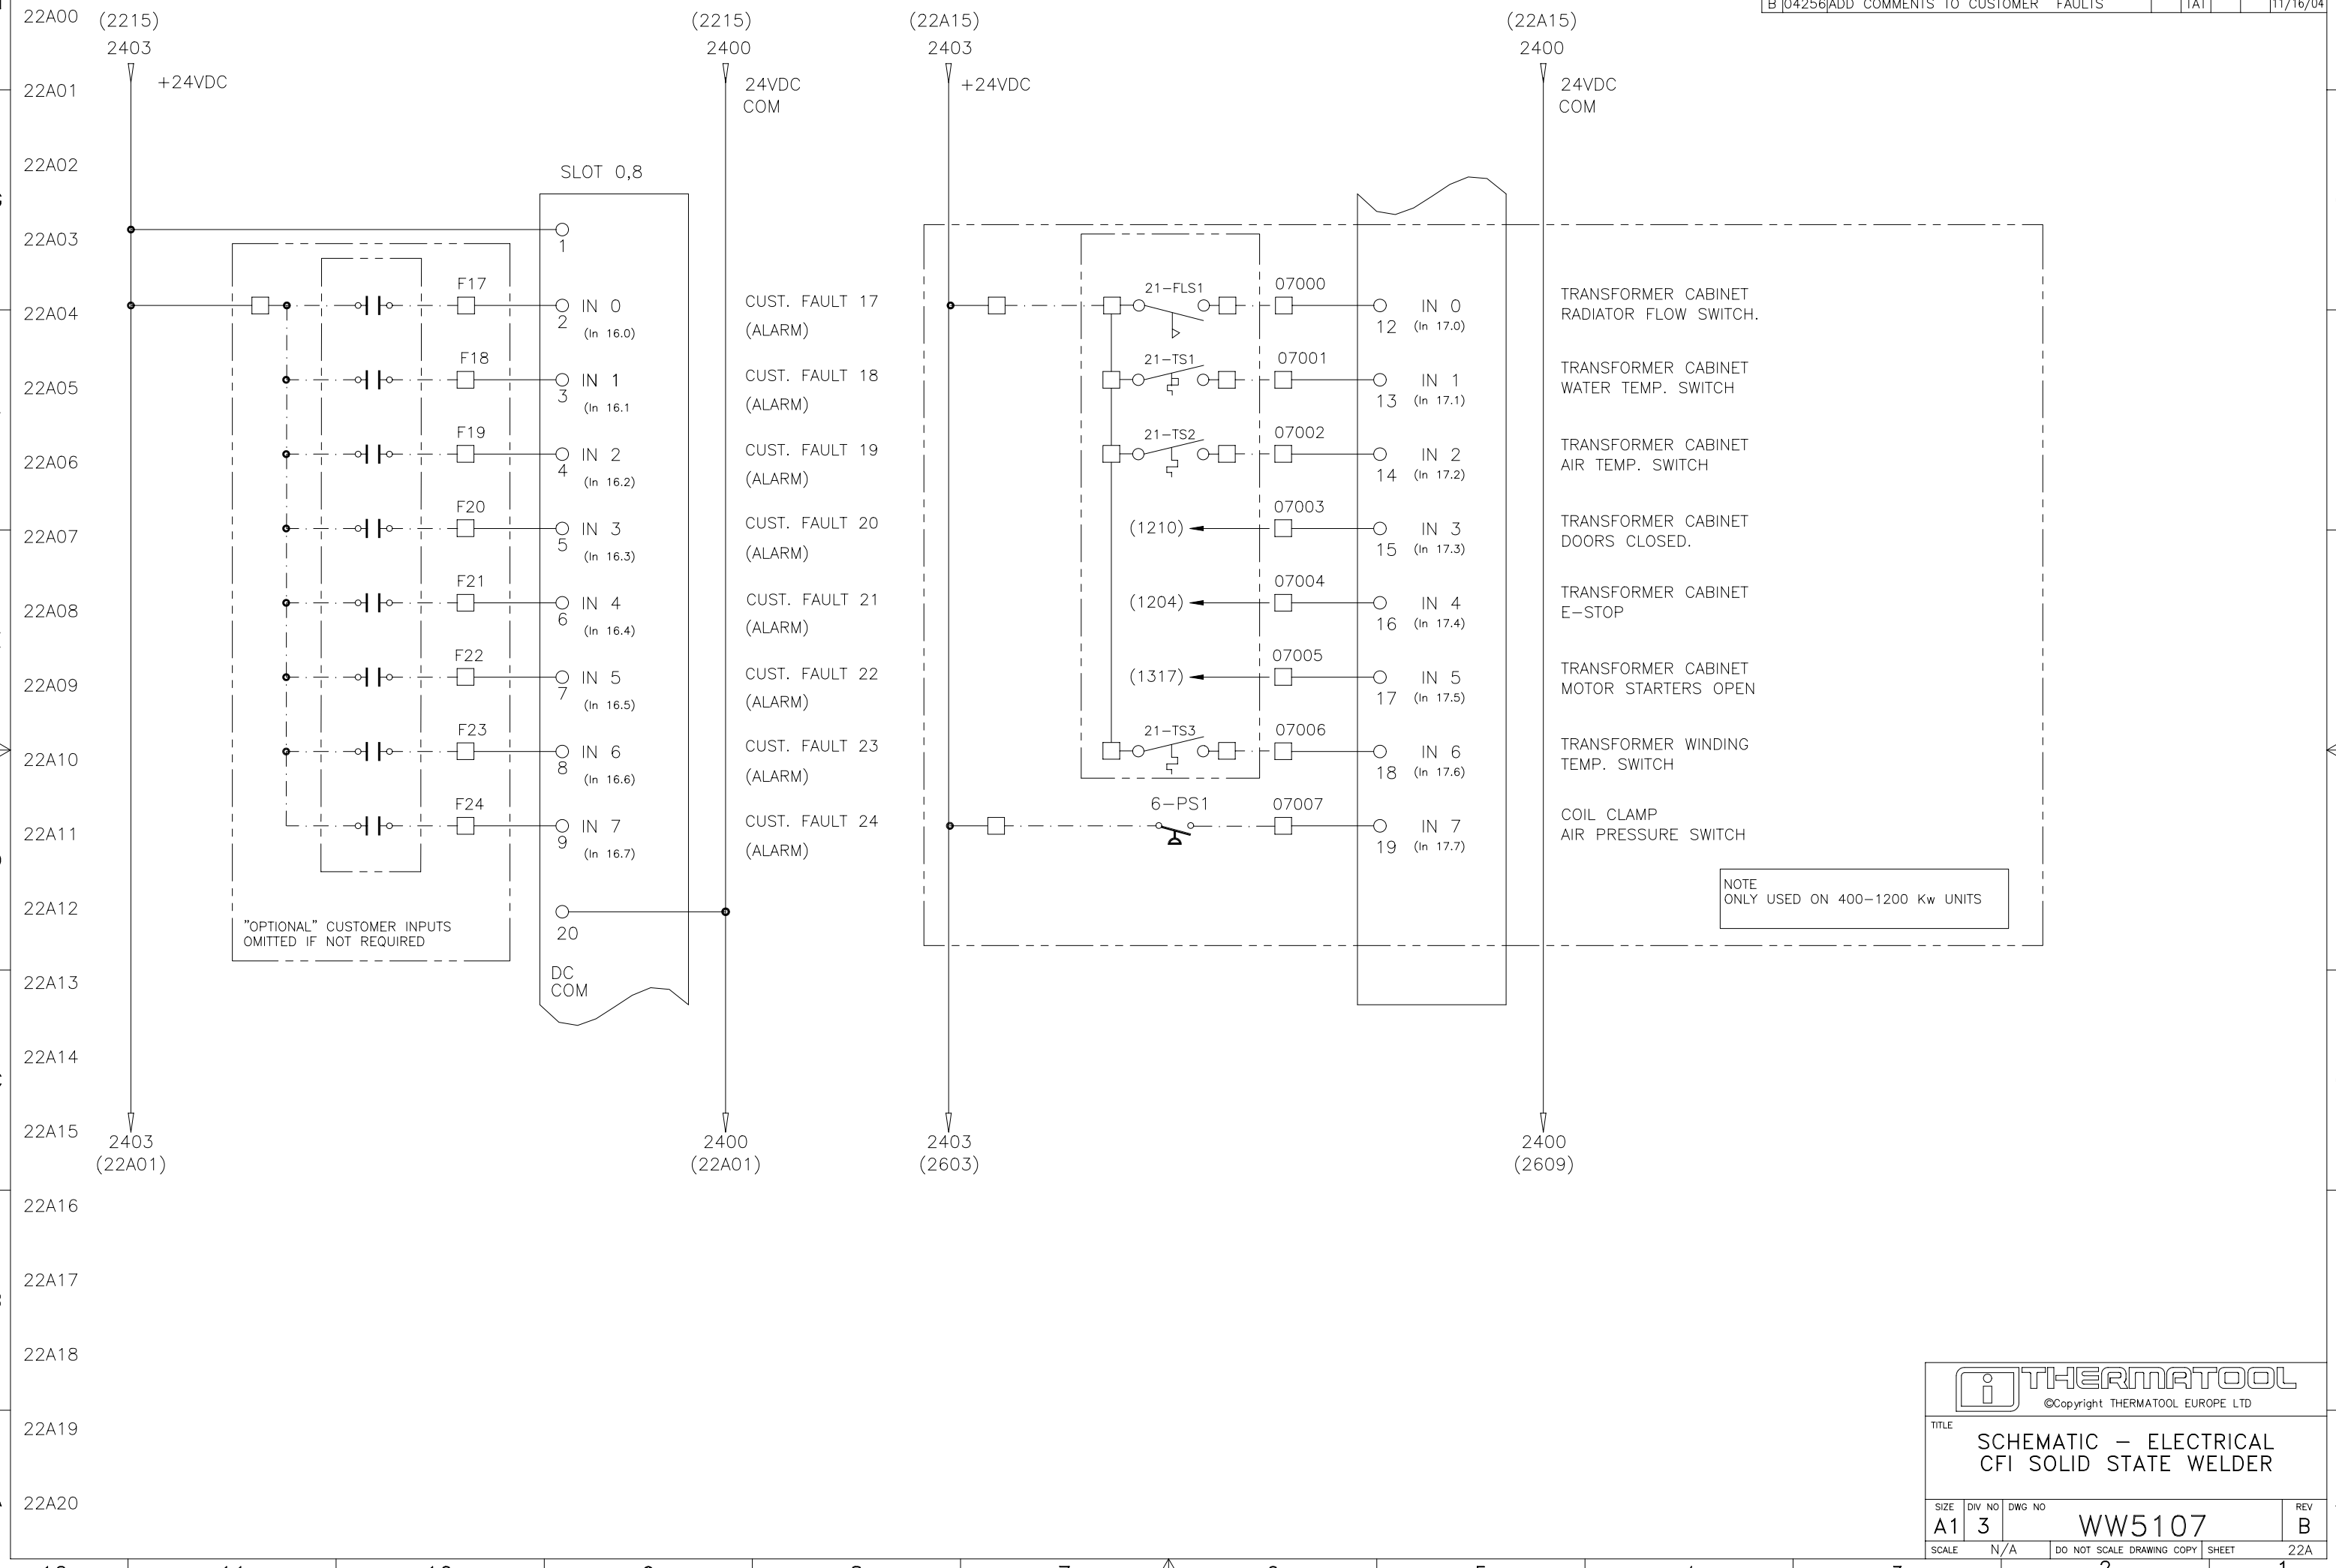


<p>©Copyright THERMATOOL EUROPE LTD</p>			
<p>TITLE</p> <p>SCHEMATIC – ELECTRICAL</p> <p>CFI SOLID STATE WELDER</p>			
SIZE	DIV NO	DWG NO	REV
A1	3	WW5107	B
SCALE	N/A	DO NOT SCALE DRAWING COPY	SHEET
			22A


REVISIONS							
REV	ECR	DESCRIPTION	ZONE	DWN	CHK	APPD	MM/DD/YY
0	03248	FIRST ISSUE		TAT			11/06/03

MILL INTERLOCKS


INPUTS FROM MILL CONTROLS
TO WELDER CONTROLS
CUSTOMER SUPPLIED
DRY CONTACTS

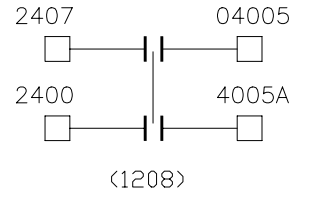


MILL EMERGENCY STOP
WHEN THESE CONTACTS ARE OPENED IT WILL OPEN THE WELDER MAIN CIRCUIT BREAKER (1-CB1) REMOVING ALL POWER EXCEPT AUXILLIARY POWER FOR CONTROLS.

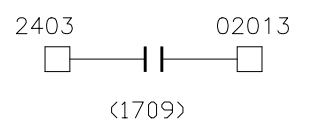


MILL INTERLOCK FAULT/OK
WHEN THIS CONTACT IS OPEN IT WILL TURN THE WELDER HEAT OFF. SHOULD BE USED TO MONITOR WORK COIL AND IMPEDER COOLANT FLOW. JUMPER IF NOT BEING USED.

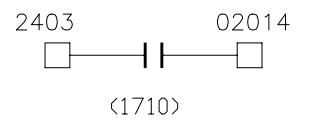

MILL FAULT/READY
WHEN THIS CONTACT IS OPEN IT WILL TURN HEAT OFF. THIS CONTACT MUST BE OPEN WHEN JOGGING MILL.

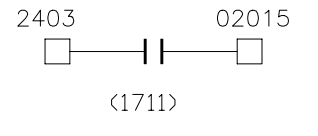


MILL OFF/RUN
THIS CONTACT MUST BE CLOSED TO TURN OUTPUT HEAT ON.
"MANUAL" SPEED POWER MODE - IN "MANUAL" MODE THE OUTPUT HEAT WILL TURN OFF WHEN THIS CONTACT OPENS.
"AUTOMATIC" SPEED POWER CONTROL MODE - IN "AUTOMATIC" MODE THE OUTPUT HEAT WILL TURN OFF WHEN THIS CONTACT IS OPEN AND THE MILL TACH HAS STOPPED.

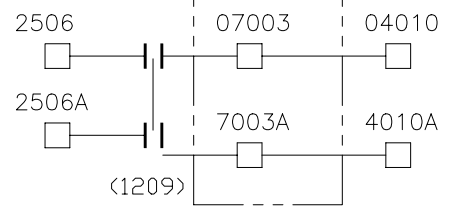


MILL GUARDSWITCH
WHEN THIS CONTACT IS OPEN IT WILL EMERGENCY STOP THE WELDER
IT CAN BE USED FOR MILL GUARDS OR "OTHER" SAFETY INTERFACES JUMPER IF NOT BEING USED.


OUTPUTS FROM WELDER CONTROLS
TO MILL CONTROLS
THERMATOOL SUPPLIED
DRY CONTACTS

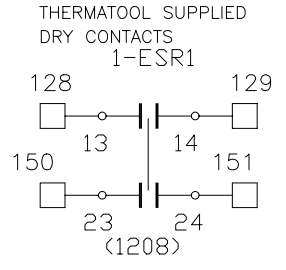


WELDER EMERGENCY STOP
THIS NORMALLY OPEN CONTACT IS OPEN IF A WELDER DOOR SWITCH OR EMERGENCY PUSH BUTTON IS PRESSED. AFTER ALL CABINET DOOR SWITCHES AND EMERGENCY STOP BUTTONS ARE RETURNED TO A SAFE CONDITION THE EMERGENCY STOP RELAY MAY BE RESET BY PUSHING THE WELDER "RESET" PUSH BUTTON.

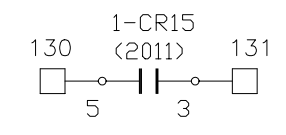

WELDER FAULT/READY
THIS NORMALLY OPEN CONTACT IS CLOSED UNDER THE FOLLOWING CONDITIONS
1.) IF THE WELDER "SHUT DOWN/STANDBY" SWITCH IS IN "SHUTDOWN" POSITION AND THE EMERGENCY STOP RELAY IS RESET.
2.) IN "MANUAL" SPEED POWER CONTROL MODE - THE "SHUTDOWN/STANDBY" SWITCH IS IN "STANDBY" POSITION AND THERE ARE NO WELDER FAULTS.
3.) IN "AUTOMATIC" SPEED POWER CONTROL MODE - THE CONDITION IS THE SAME AS IN "MANUAL" WITH THE ADDITION OF THE WELDER "HEAT ON" PUSH BUTTON MUST BE PRESSED.

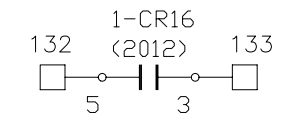

WELD HEAT OFF/ON
THIS NORMALLY OPEN CONTACT IS OPEN WHEN OUTPUT HEAT IS OFF. THE CONTACT IS CLOSED WHEN OUTPUT HEAT IS ON.

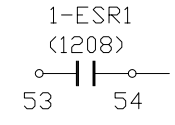


WELDER EMERGENCY STOP (AUXILIARY SIGNAL)
AVAILABLE AUXILIARY CONTACT FROM EMERGENCY STOP
"MAY BE USED FOR INDICATION"
NOT WIRED TO TERMINALS!

NOTES:-
⚠ ONLY USED ON 400-1200KW UNIT WITH THERMATOOL SUPPLIED TRANSFORMER


THERMATOOL ©Copyright THERMATOOL EUROPE LTD			
TITLE SCHEMATIC - ELECTRICAL CFI SOLID STATE WELDER			
SIZE A1	DIV NO 3	DWG NO WW5107	REV 0
SCALE N/A	DO NOT SCALE DRAWING COPY		SHEET 23

1-XLOC TERM. BLOCK

REVISIONS						
REV	ECR	DESCRIPTION	ZONE	DWN	CHK	APPD
0	03248	FIRST ISSUE		TAT		MM/DD/YY 11/06/03

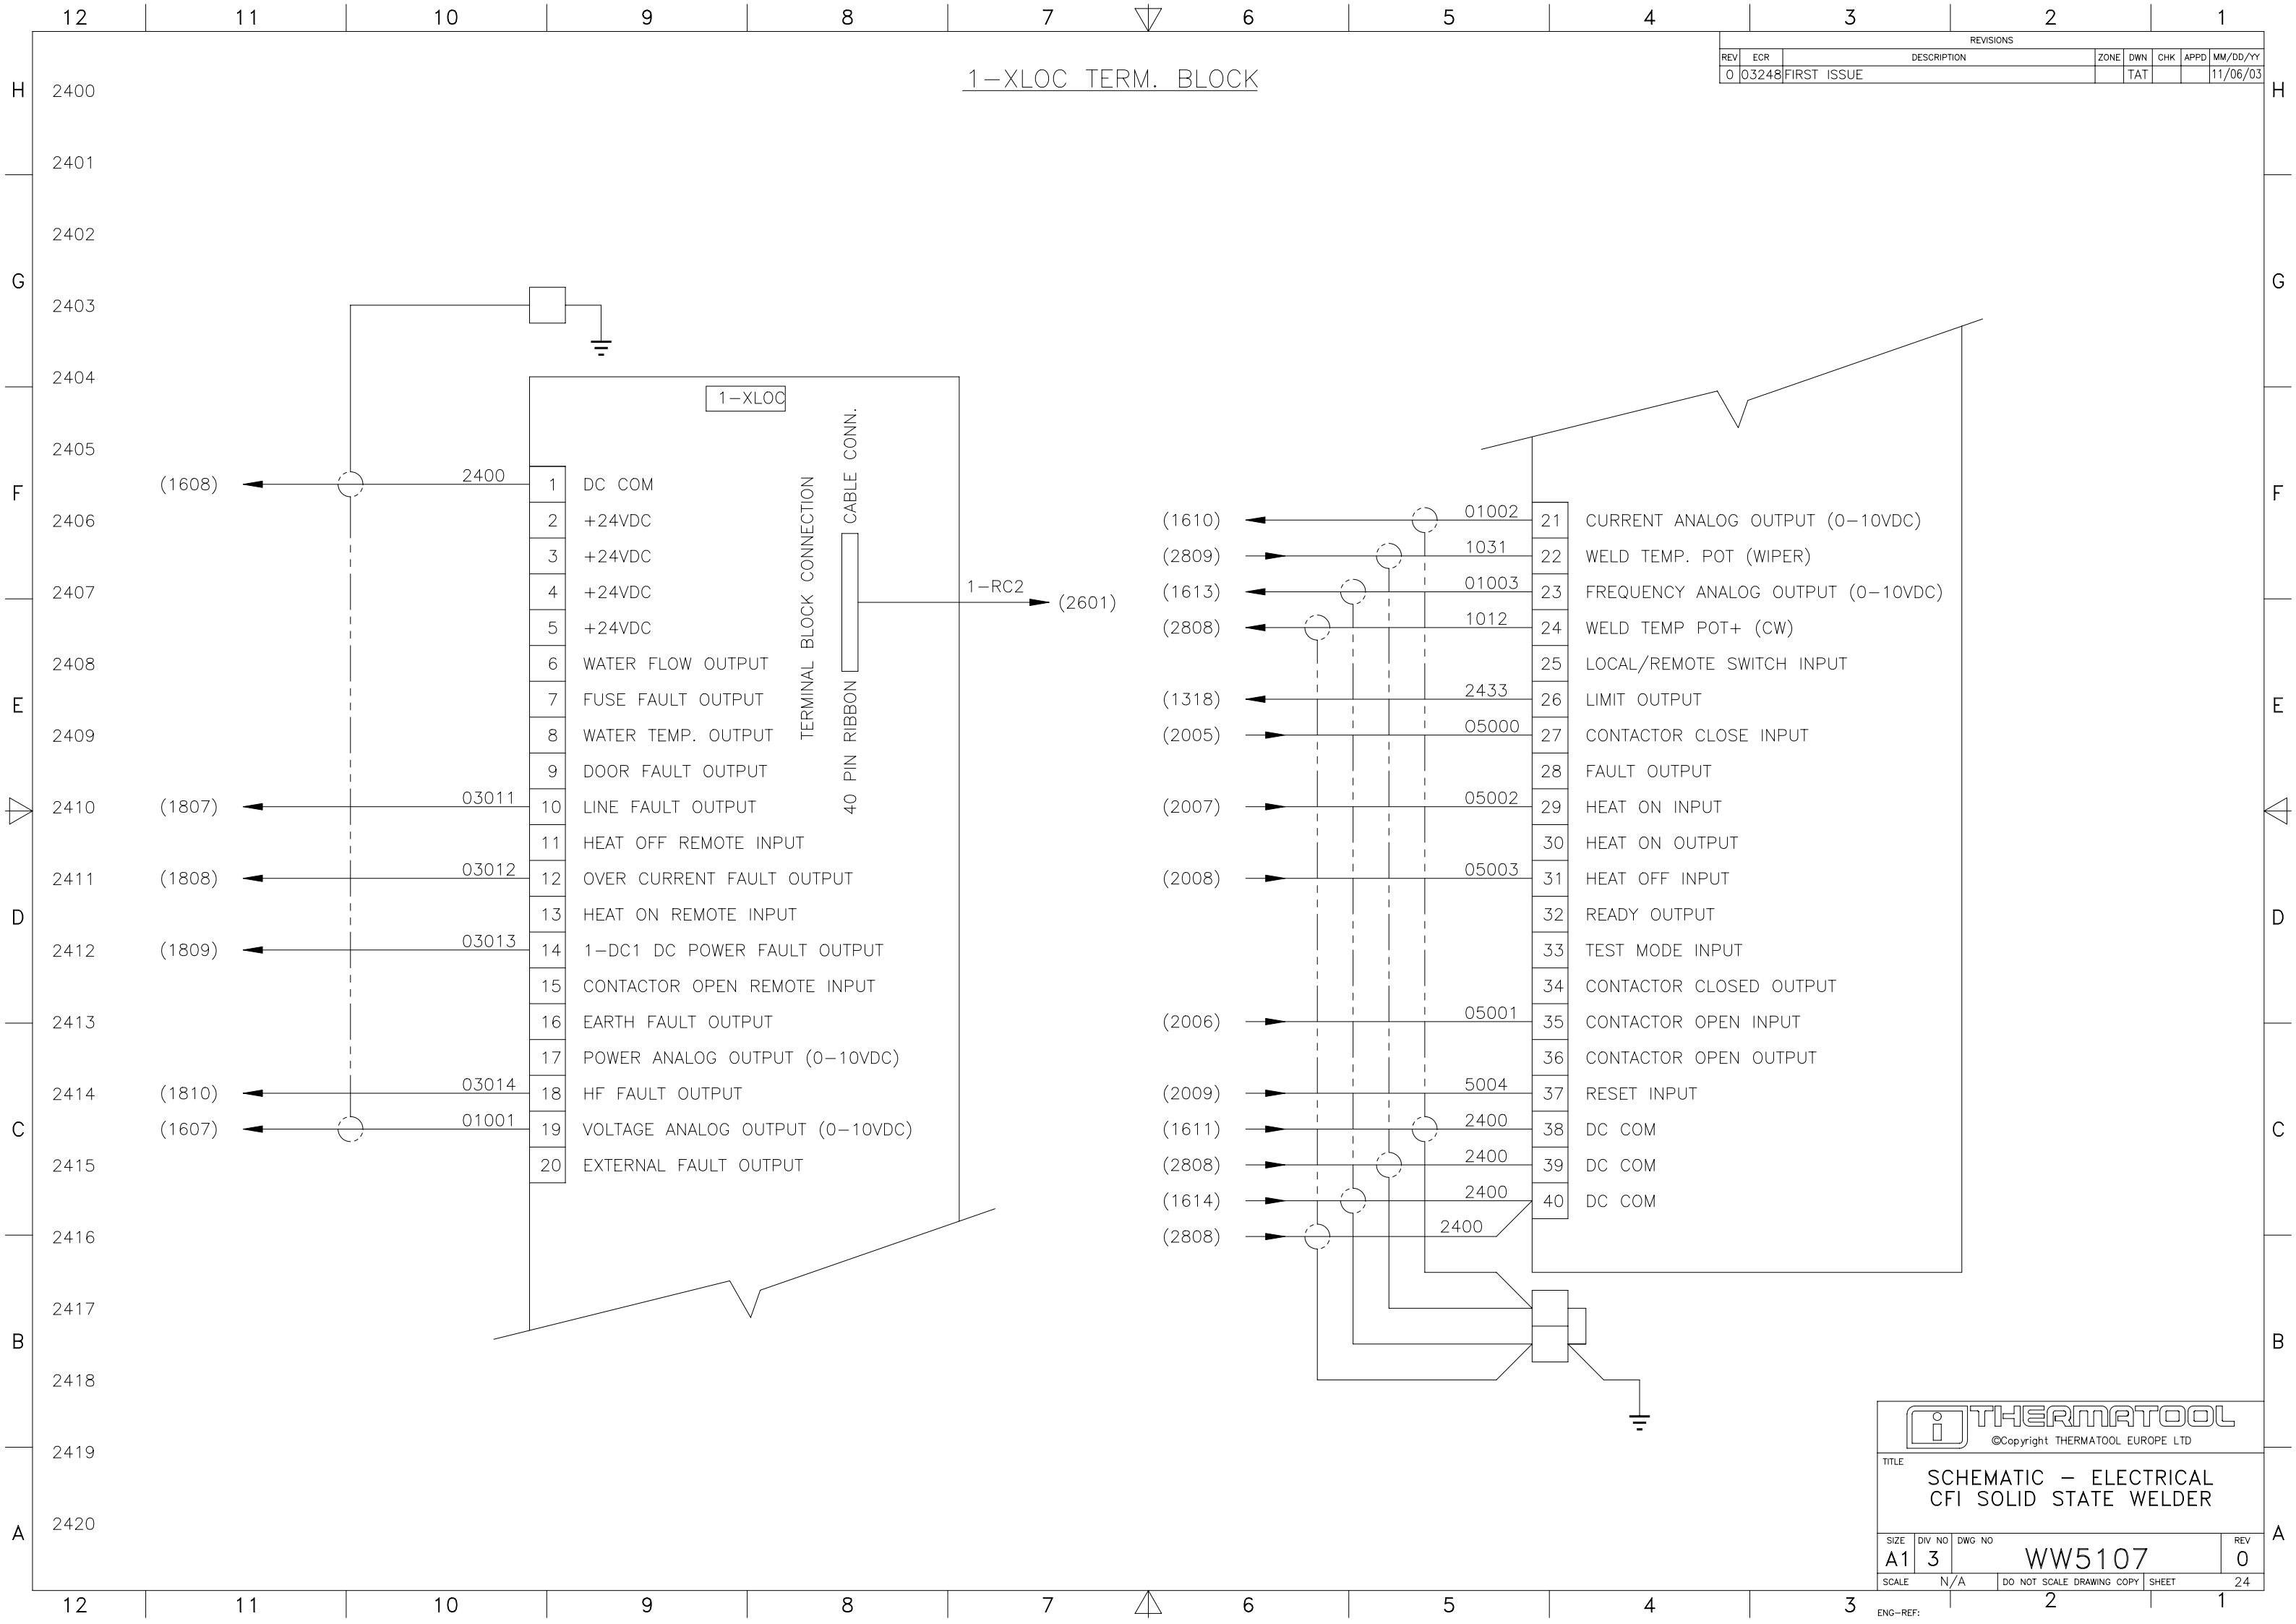

 ©Copyright THERMATOOL EUROPE LTD			
TITLE			
SCHEMATIC – ELECTRICAL CFI SOLID STATE WELDER			
SIZE	DIV NO	DWG NO	REV
A1	3	WW5107	0
SCALE	N/A	DO NOT SCALE DRAWING COPY	SHEET
			24
ENG-REF:		2	1

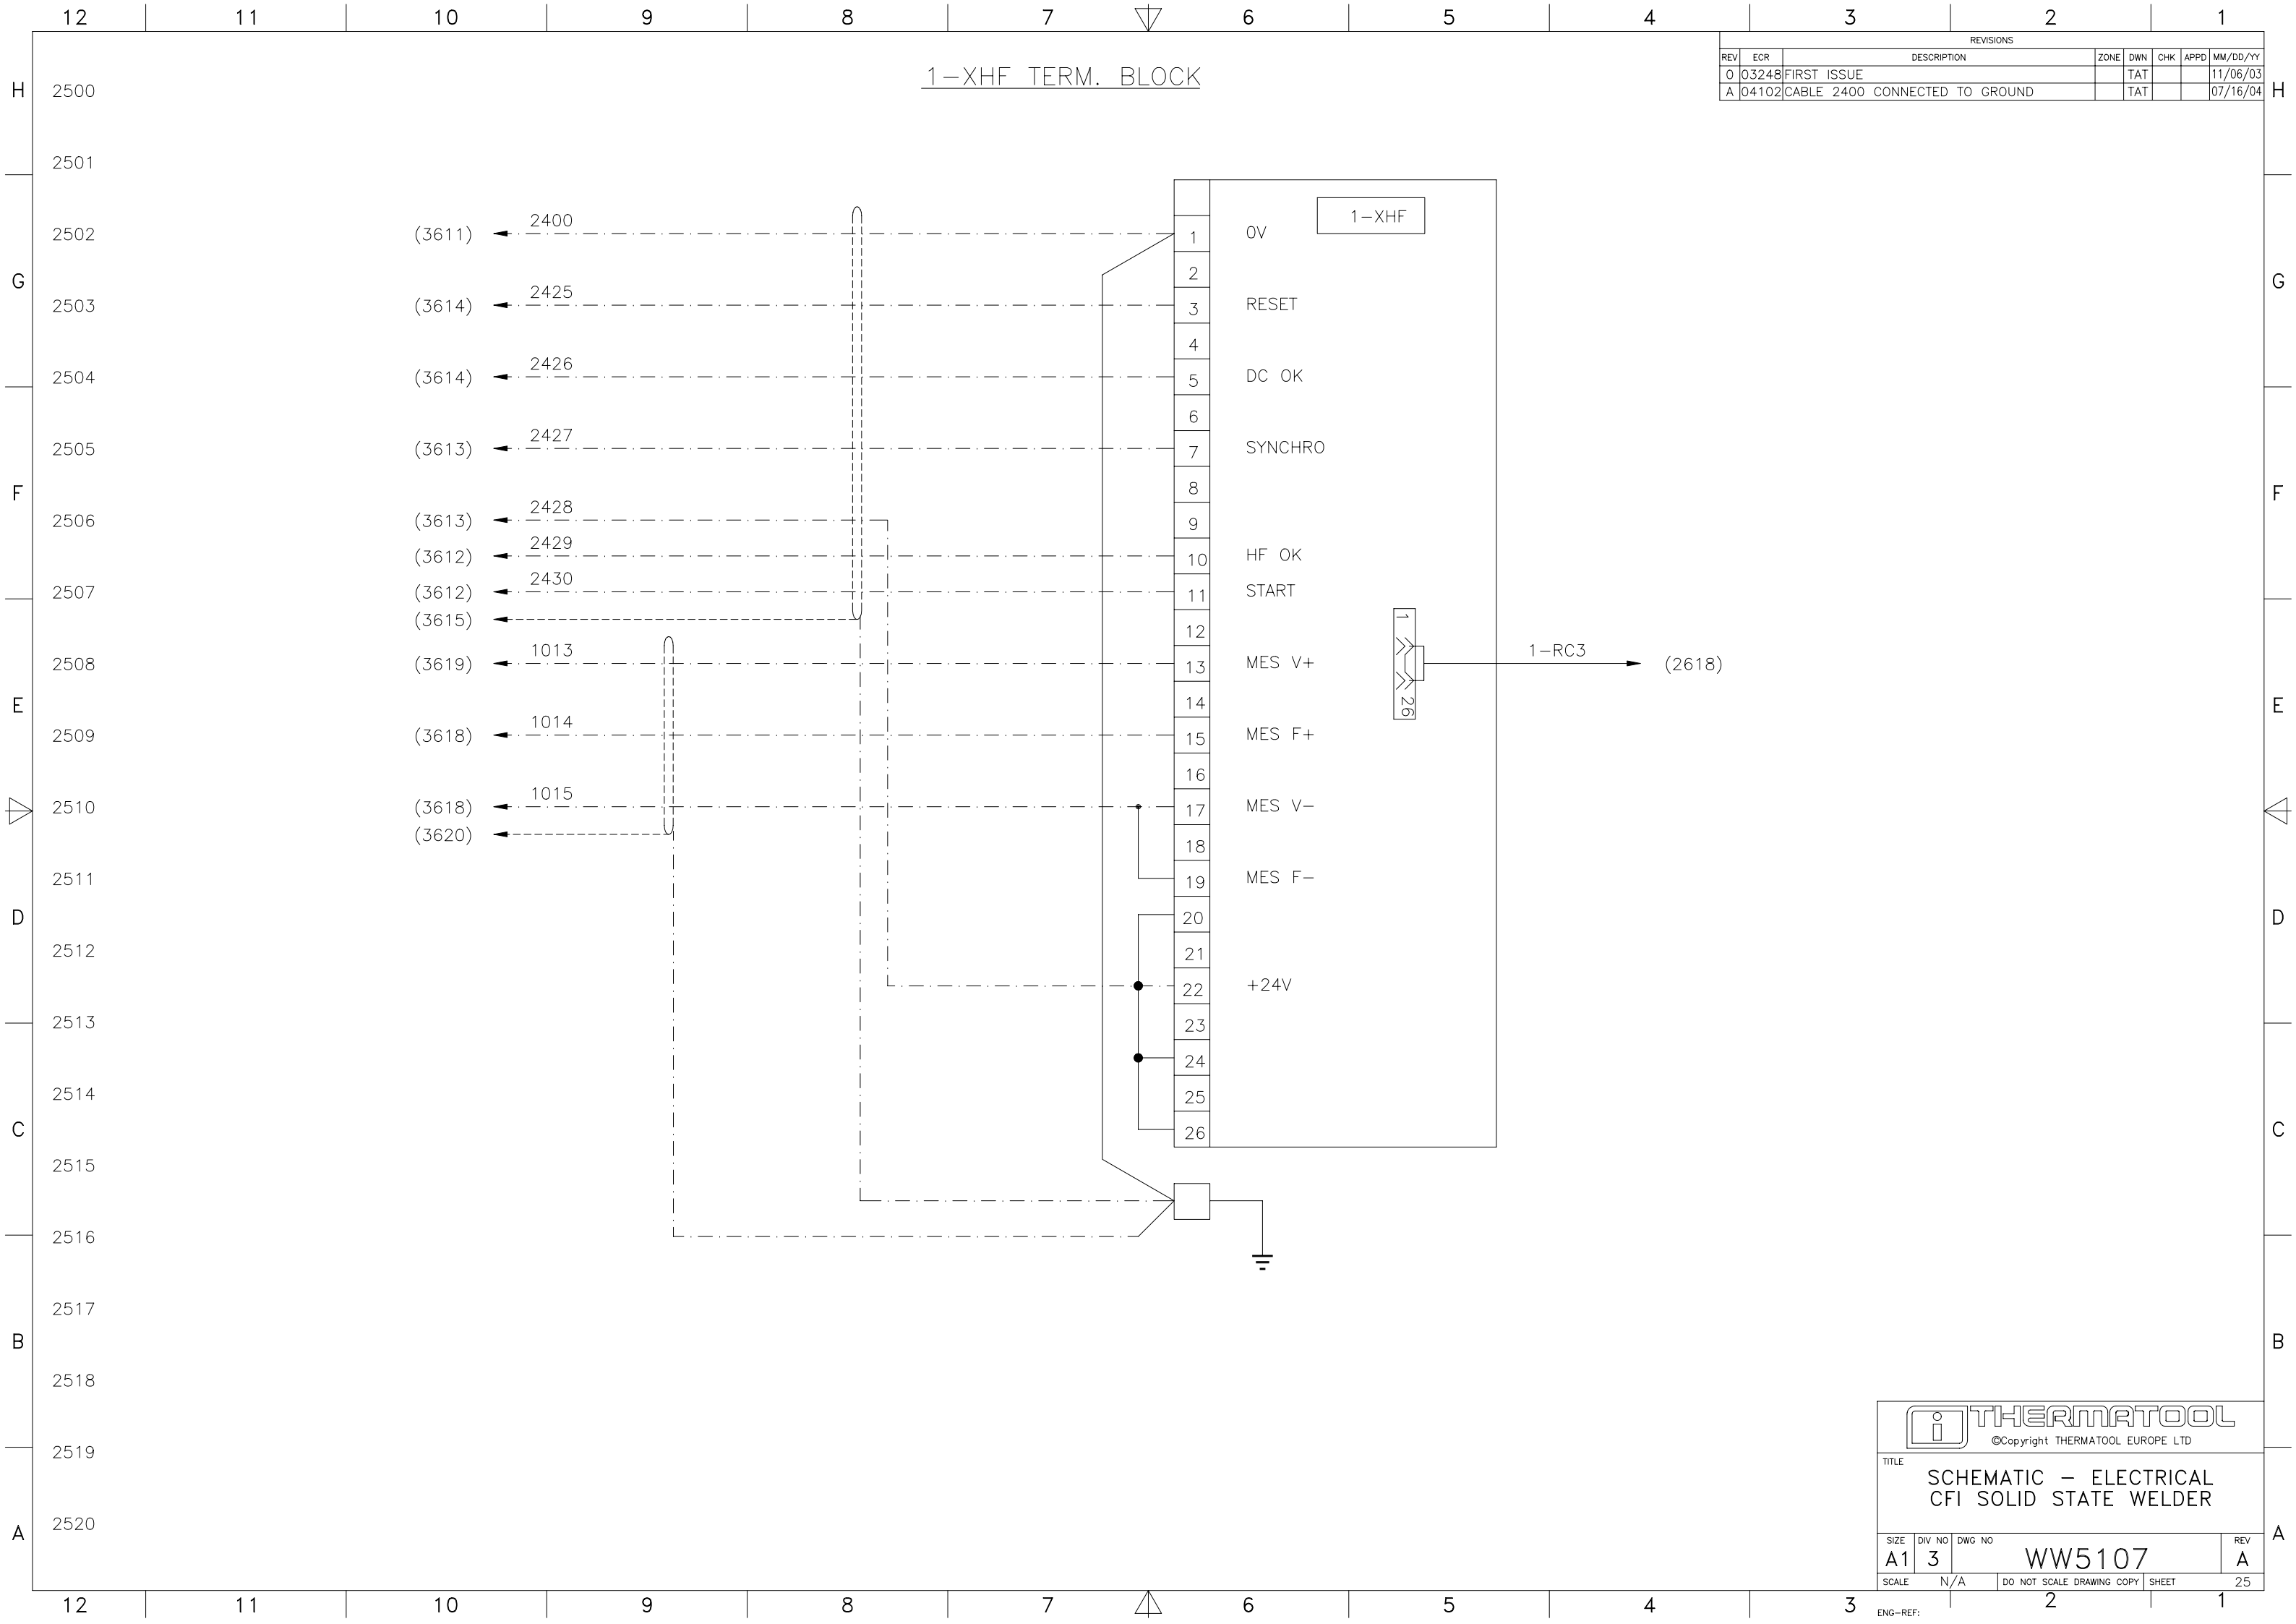

REVISIONS						
REV	ECR	DESCRIPTION	ZONE	DWN	CHK	APPD
0	03248	FIRST ISSUE		TAT		11/06/03
A	04102	CABLE 2400 CONNECTED TO GROUND		TAT		07/16/04

THERMATOOL
©Copyright THERMATOOL EUROPE LTD



TITLE: SCHEMATIC – ELECTRICAL CFI SOLID STATE WELDER

SIZE	DIV NO	DWG NO	REV
A1	3	WW5107	A
SCALE	N/A	DO NOT SCALE DRAWING COPY	SHEET 25

ENG-REF: 2

REVISIONS						
REV	ECR	DESCRIPTION	ZONE	DWN	CHK	APPD
0	03248	FIRST ISSUE		TAT		MM/DD/YY 11/06/03

1-DC1 & 1-DC2 CONTROL BOARDS

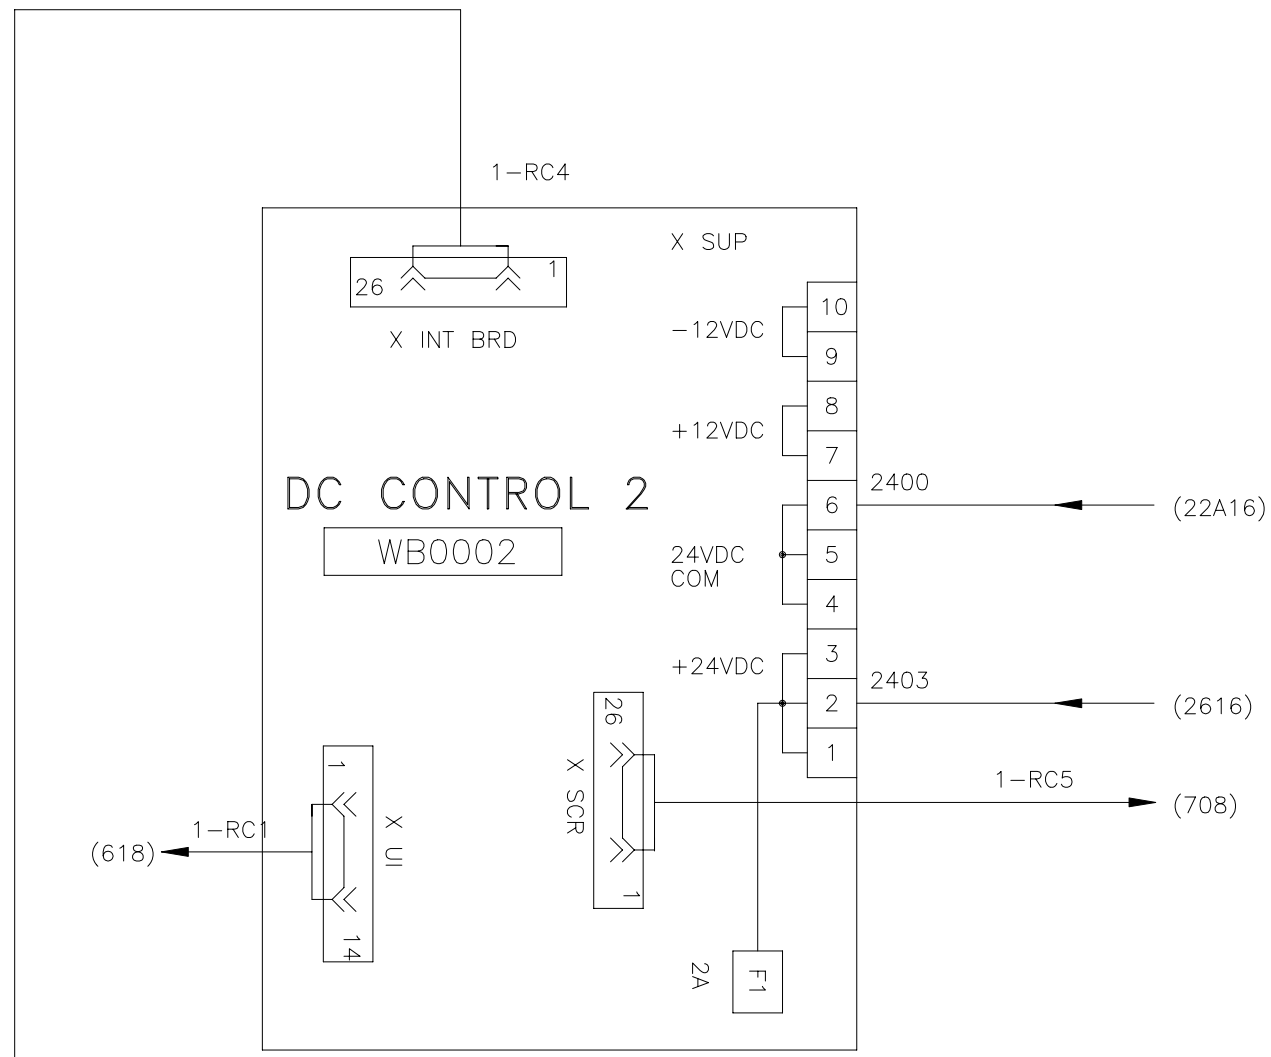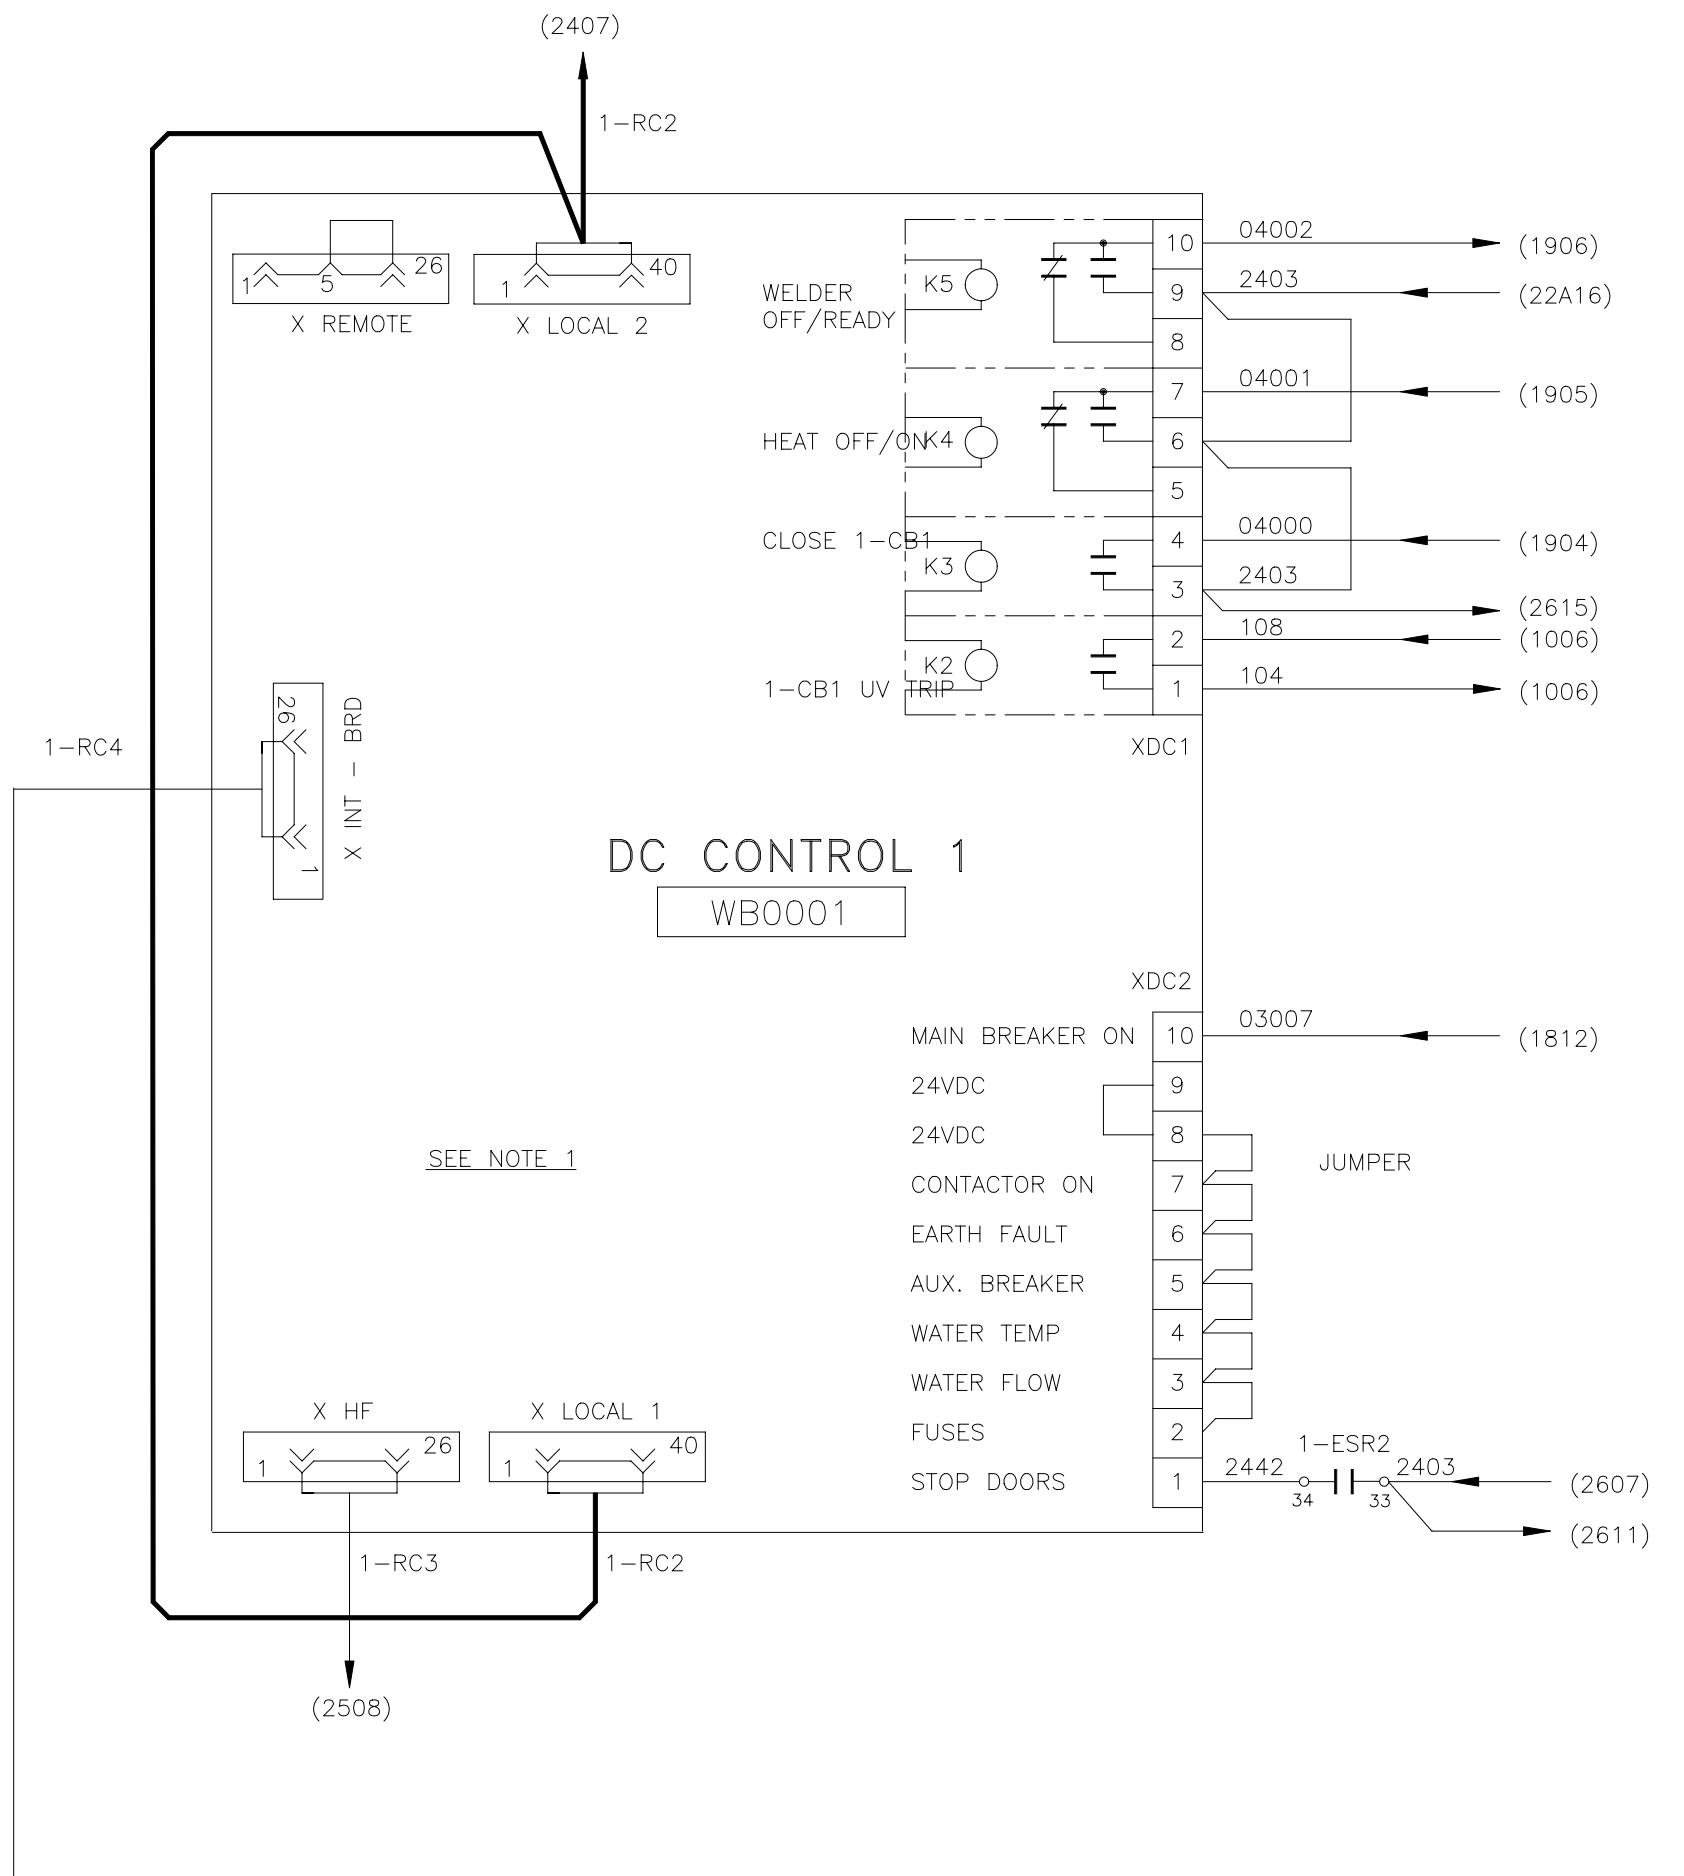


NOTES;
 ⚠ UP TO 250KW WELDER, LINK RT13 ON DC CONTROL BOARD 1.

TITLE SCHEMATIC – ELECTRICAL CFI SOLID STATE WELDER			
SIZE A1	DIV NO 3	DWG NO WW5107	REV 0
SCALE N/A	DO NOT SCALE DRAWING COPY		SHEET 26

REVISIONS						
REV	ECR	DESCRIPTION	ZONE	DWN	CHK	APPD
0	03248	FIRST ISSUE		TAT		
A	04102	ADD ALTRNT COOLING FAN DATA	10E	TAT		

2-HF1 CONTROL BOARD

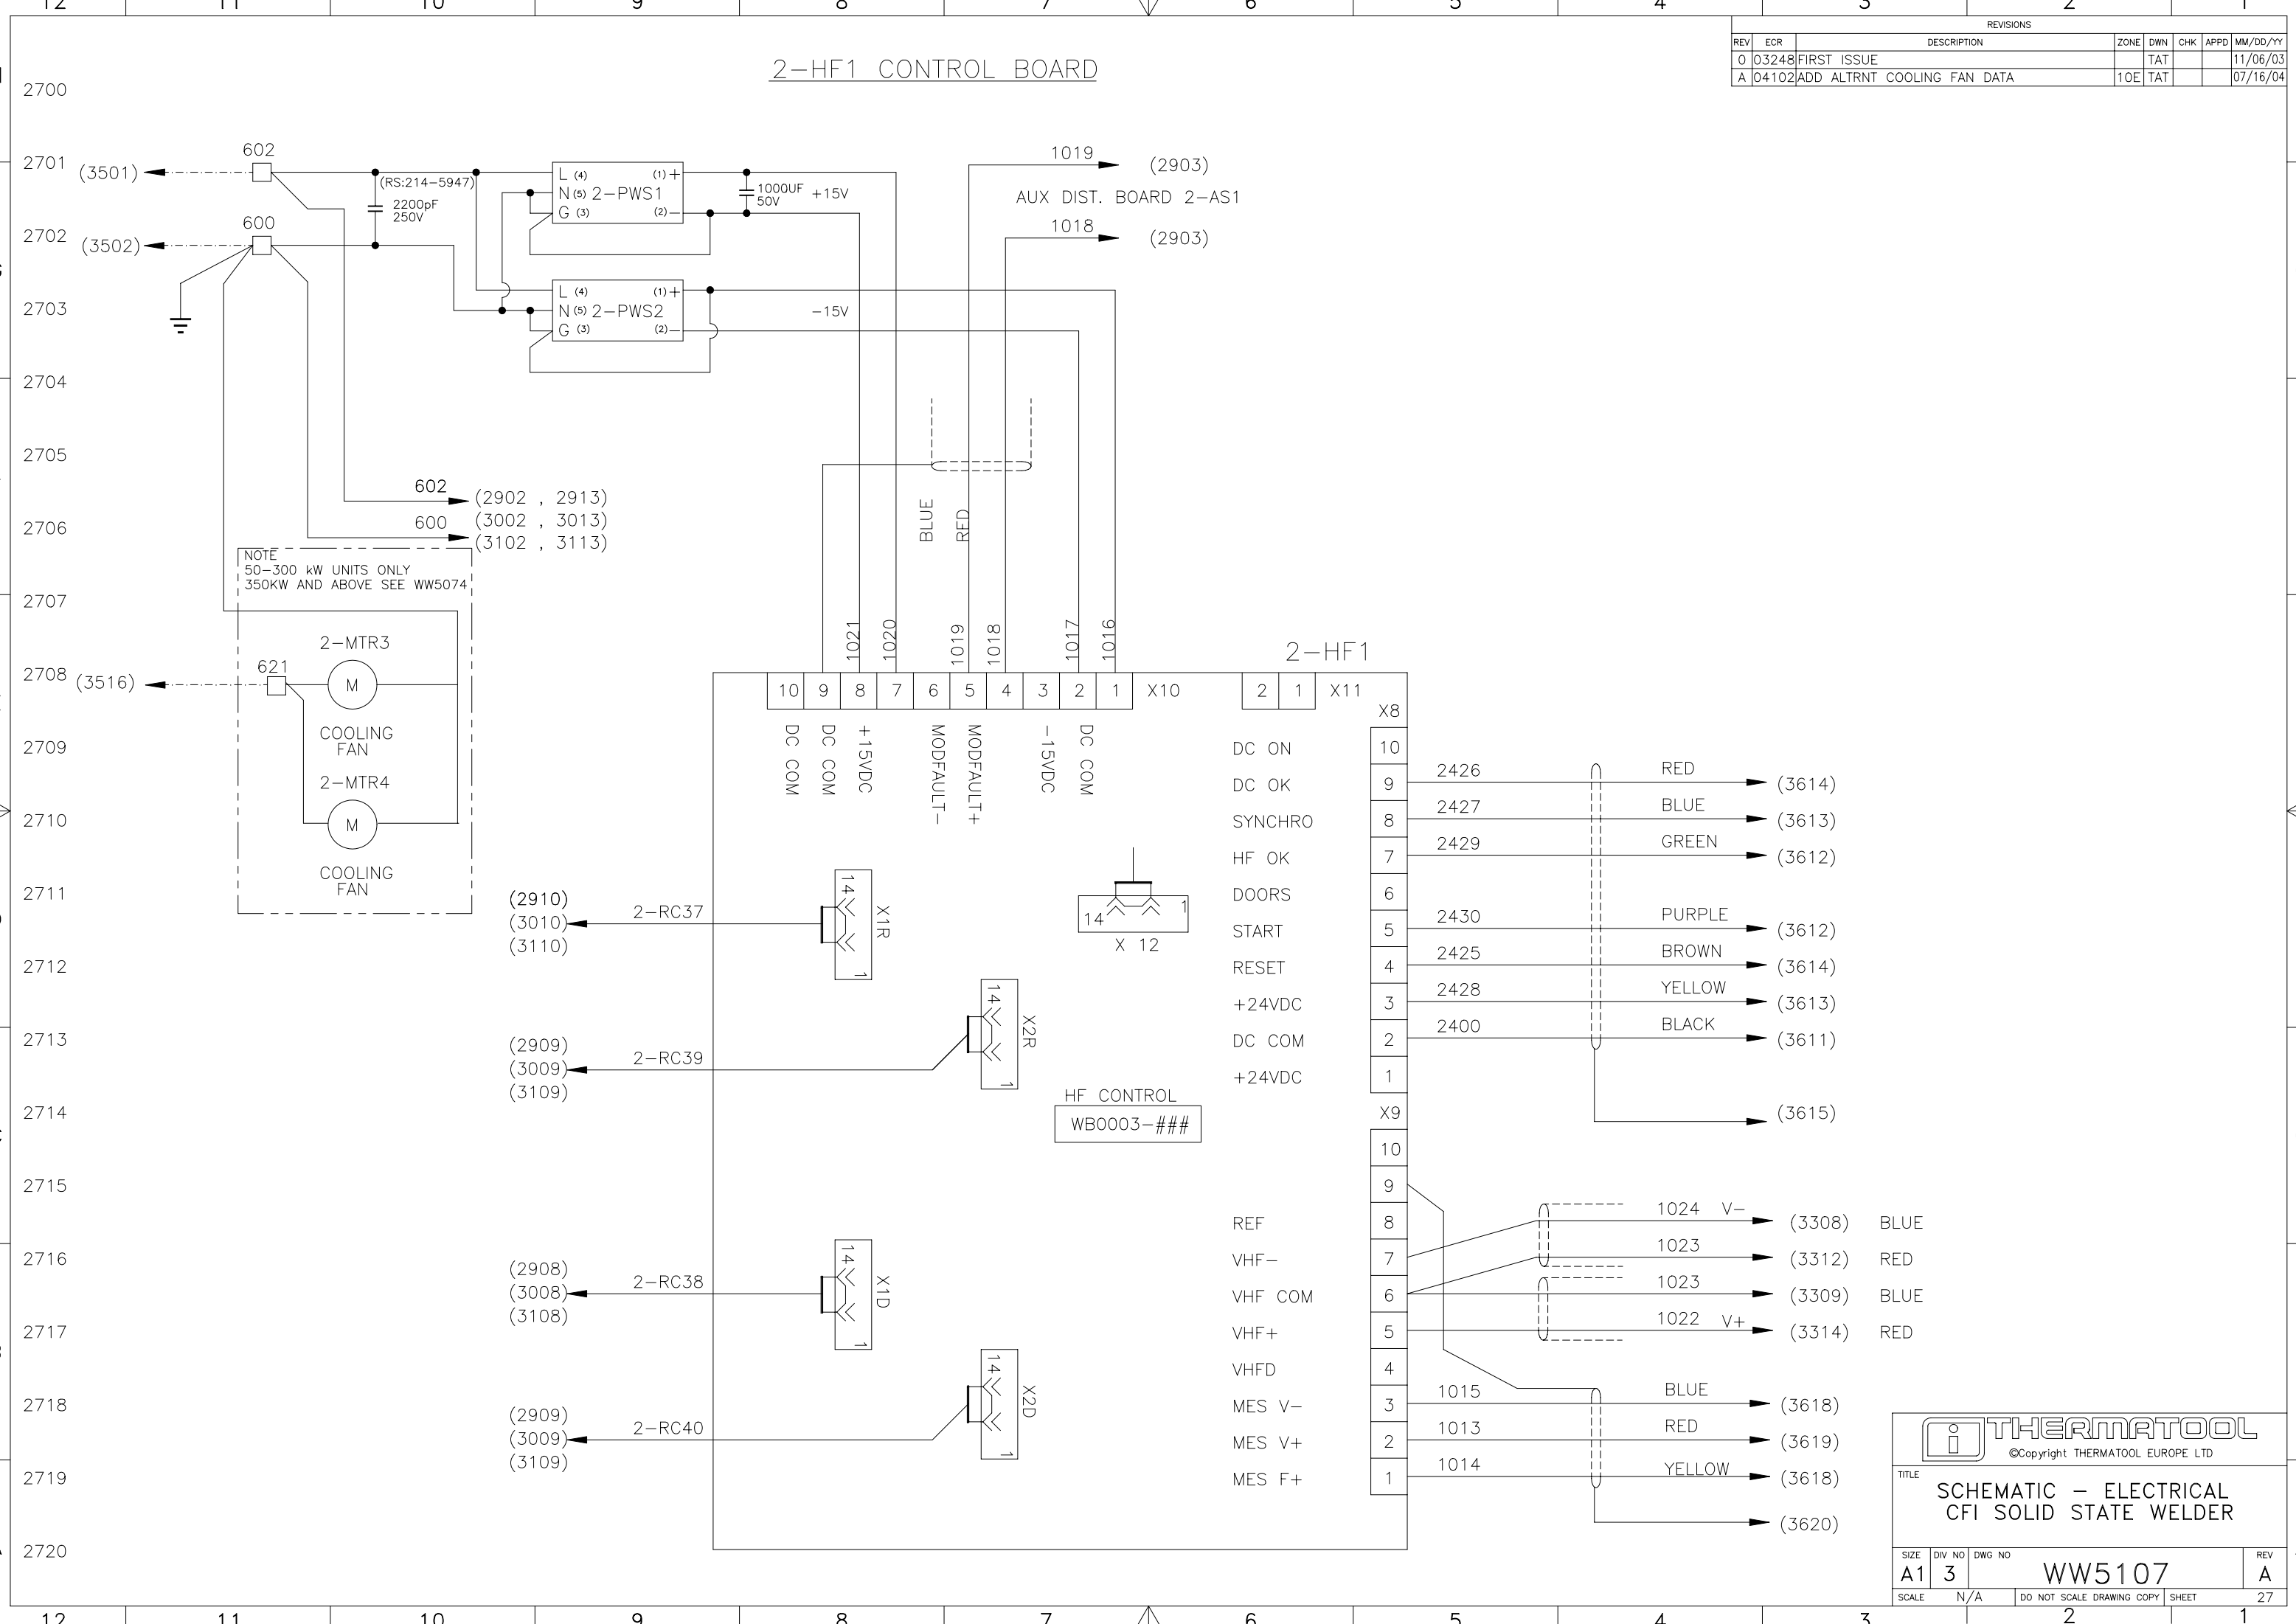

NOTE
50-300 kW UNITS ONLY
350KW AND ABOVE SEE WW5074

THERMATOOL
©Copyright THERMATOOL EUROPE LTD

TITLE
SCHEMATIC - ELECTRICAL
CFI SOLID STATE WELDER


SIZE A1	DIV NO 3	DWG NO WW5107	REV A
SCALE N/A	DO NOT SCALE DRAWING COPY		SHEET 27

ENG-REF: 2

REVISIONS						
REV	ECR	DESCRIPTION	ZONE	DWN	CHK	APPD
0		FIRST ISSUE		TAT		
						MM/DD/YY
						11/06/03




1-SPC1 SPEED POWER CONTROL BOARD

1-SPC1

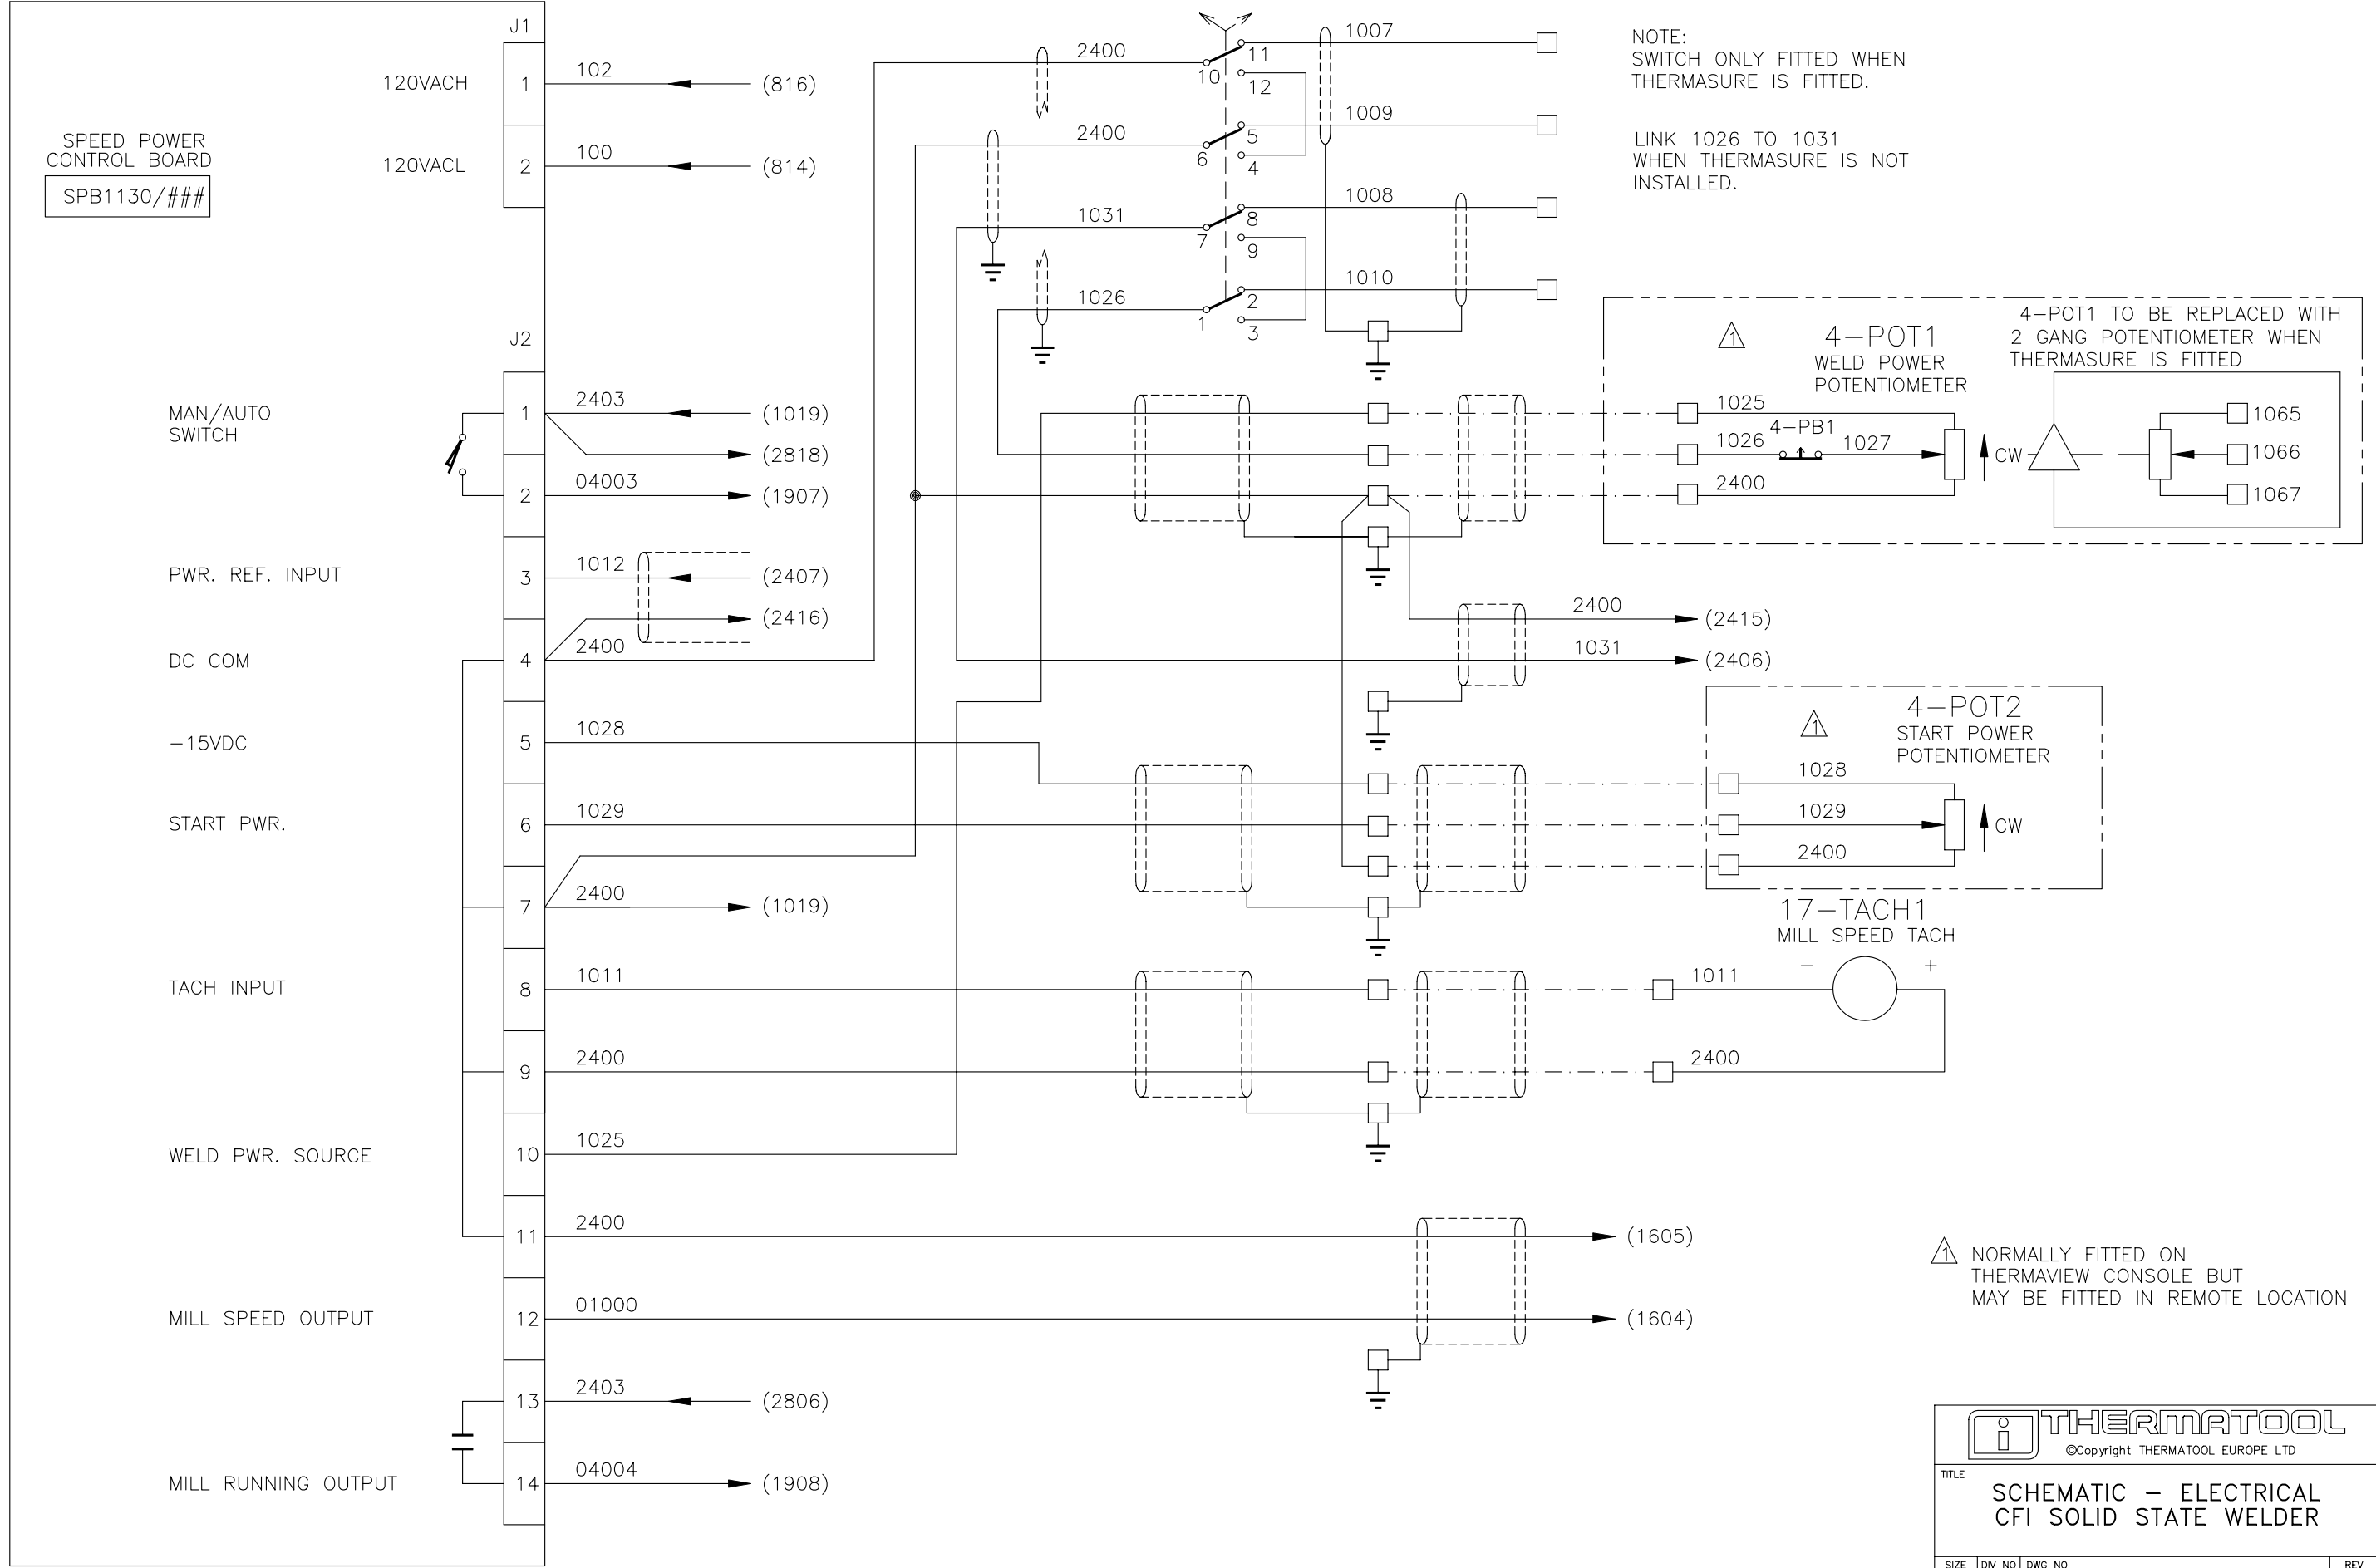

NOTE:
SWITCH ONLY FITTED WHEN
THERMASURE IS FITTED.

LINK 1026 TO 1031
WHEN THERMASURE IS NOT
INSTALLED.

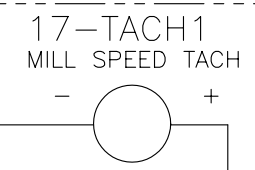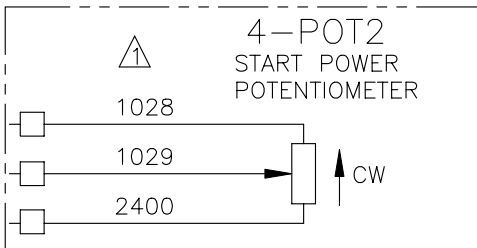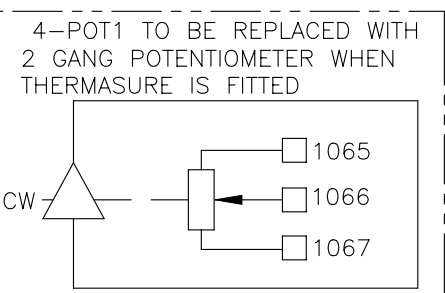

⚠ NORMALLY FITTED ON
THERMAVIEW CONSOLE BUT
MAY BE FITTED IN REMOTE LOCATION

THERMATOOL
©Copyright THERMATOOL EUROPE LTD




TITLE
**SCHEMATIC - ELECTRICAL
CFI SOLID STATE WELDER**

SIZE A1	DIV NO 3	DWG NO WW5107	REV 0
SCALE N/A	DO NOT SCALE DRAWING COPY		SHEET 28


ENG-REF: 2

HF MODULES POWER SUPPLY'S (50-350 KW)

REVISIONS						
REV	ECR	DESCRIPTION	ZONE	DWN	CHK	APPD
0	03248	FIRST ISSUE		TAT		11/06/03
1		CORRECT WIRE NUMBERS	BB/C8	AM		10/01/12

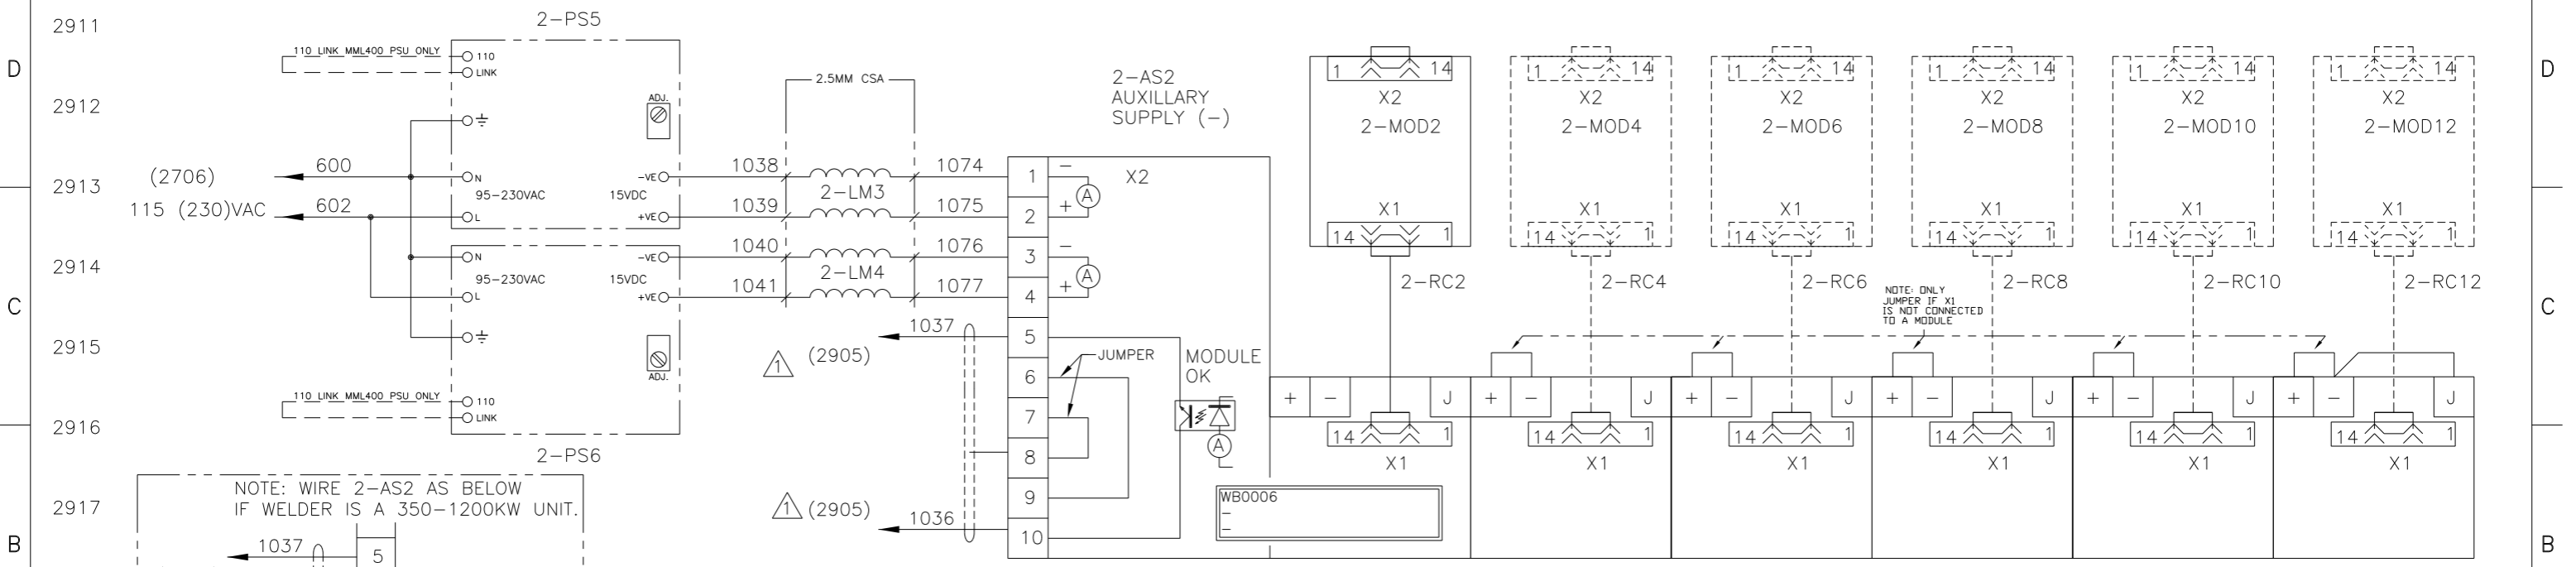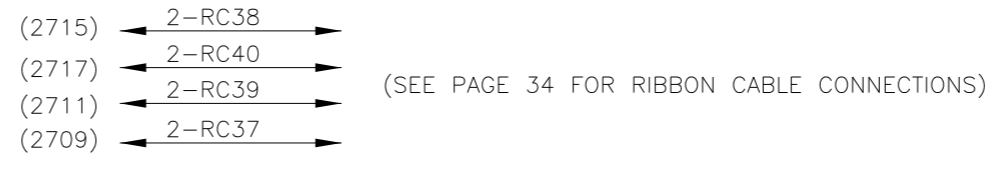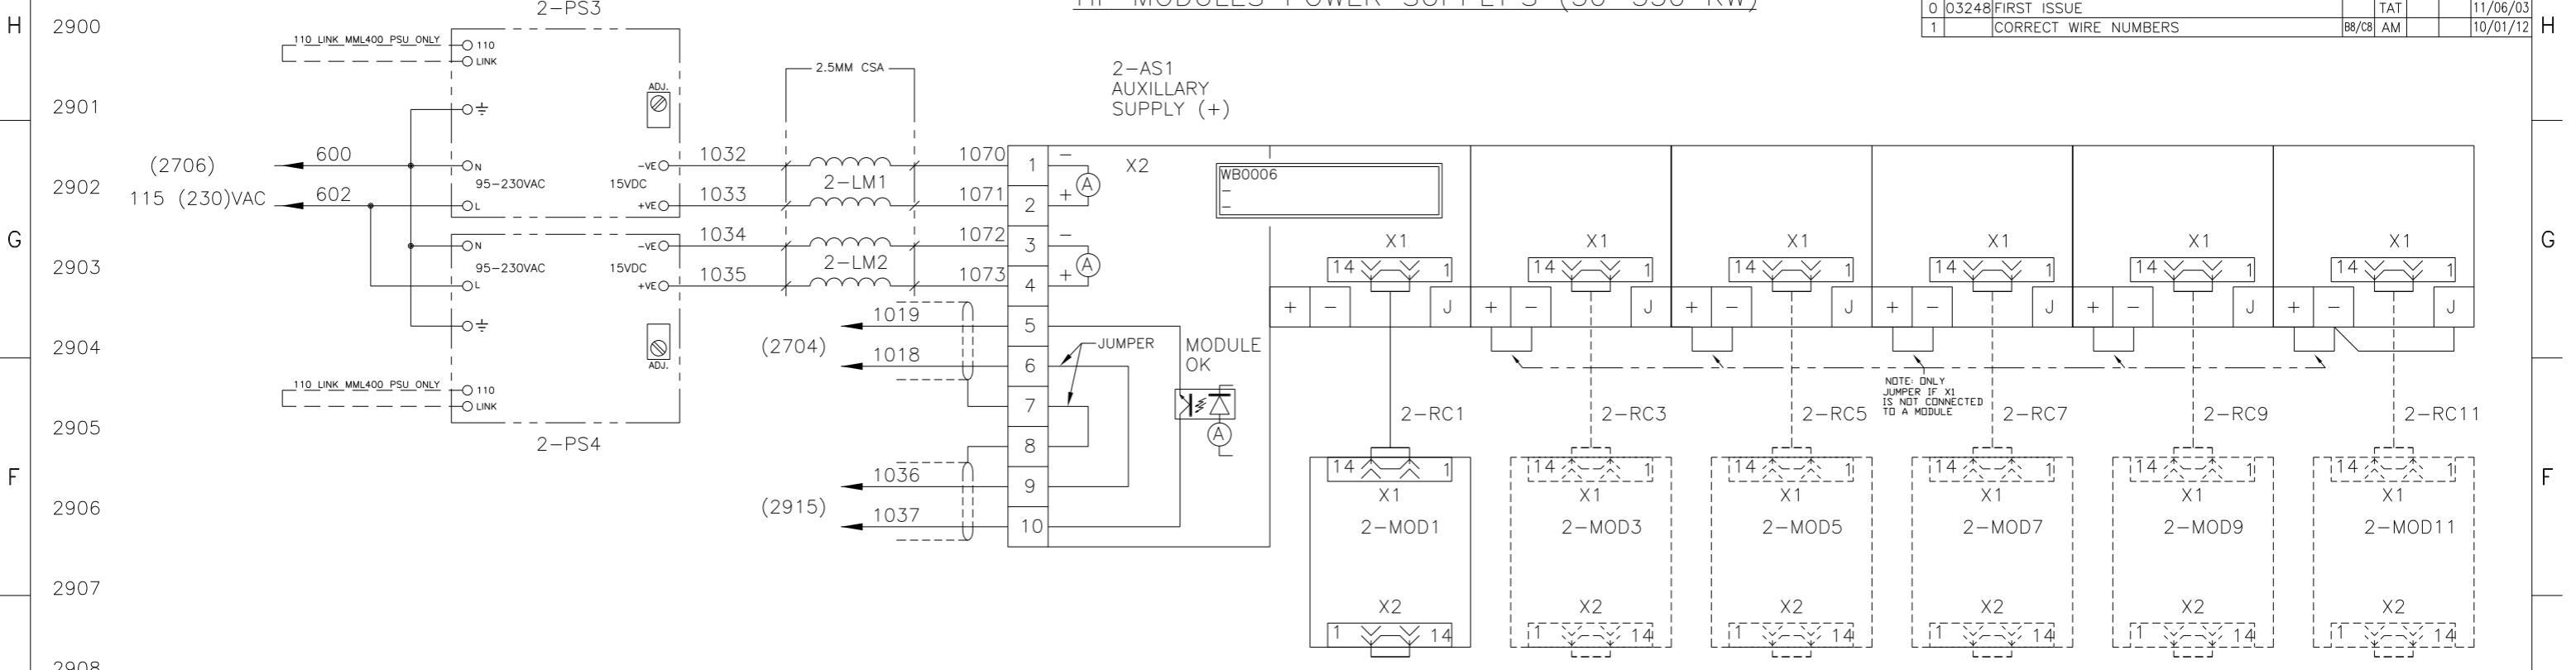

NOTE: WIRE 2-AS2 AS BELOW IF WELDER IS A 350-1200KW UNIT.



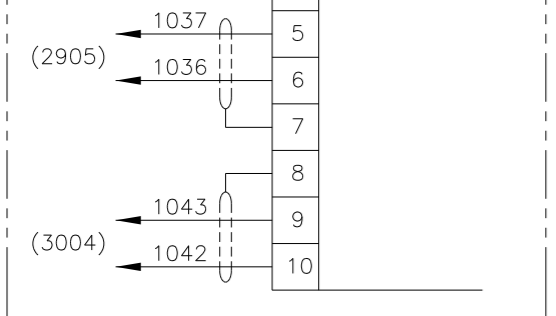


TITLE
**SCHEMATIC - ELECTRICAL
CFI SOLID STATE WELDER**

SIZE	DIV NO	DWG NO	REV
A1	3	WW5107	1
SCALE	DO NOT SCALE DRAWING COPY		SHEET
	N/A		29

HF MODULES POWER SUPPLY'S (400-800KW)

REVISIONS						
REV	ECR	DESCRIPTION	ZONE	DWN	CHK	APPD
0	03248	FIRST ISSUE		TAT		MM/DD/YY 11/06/03

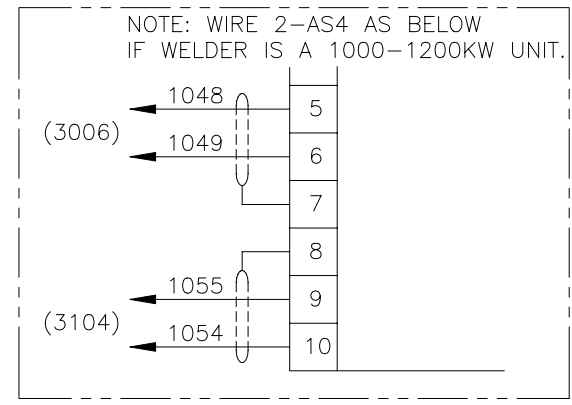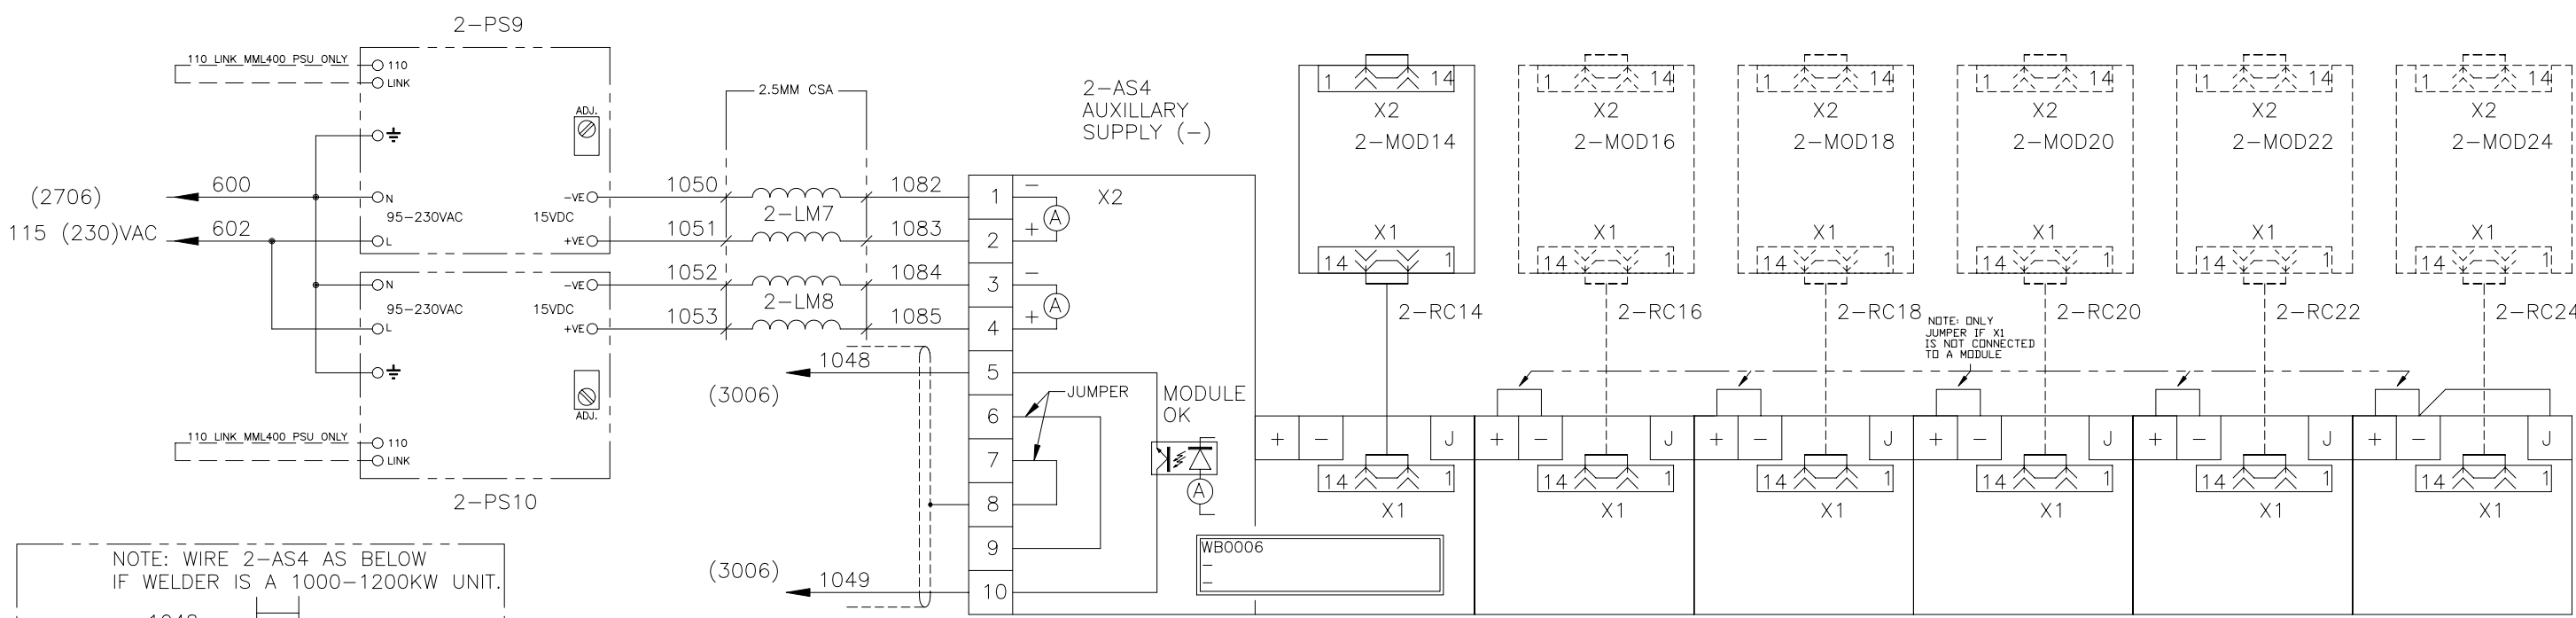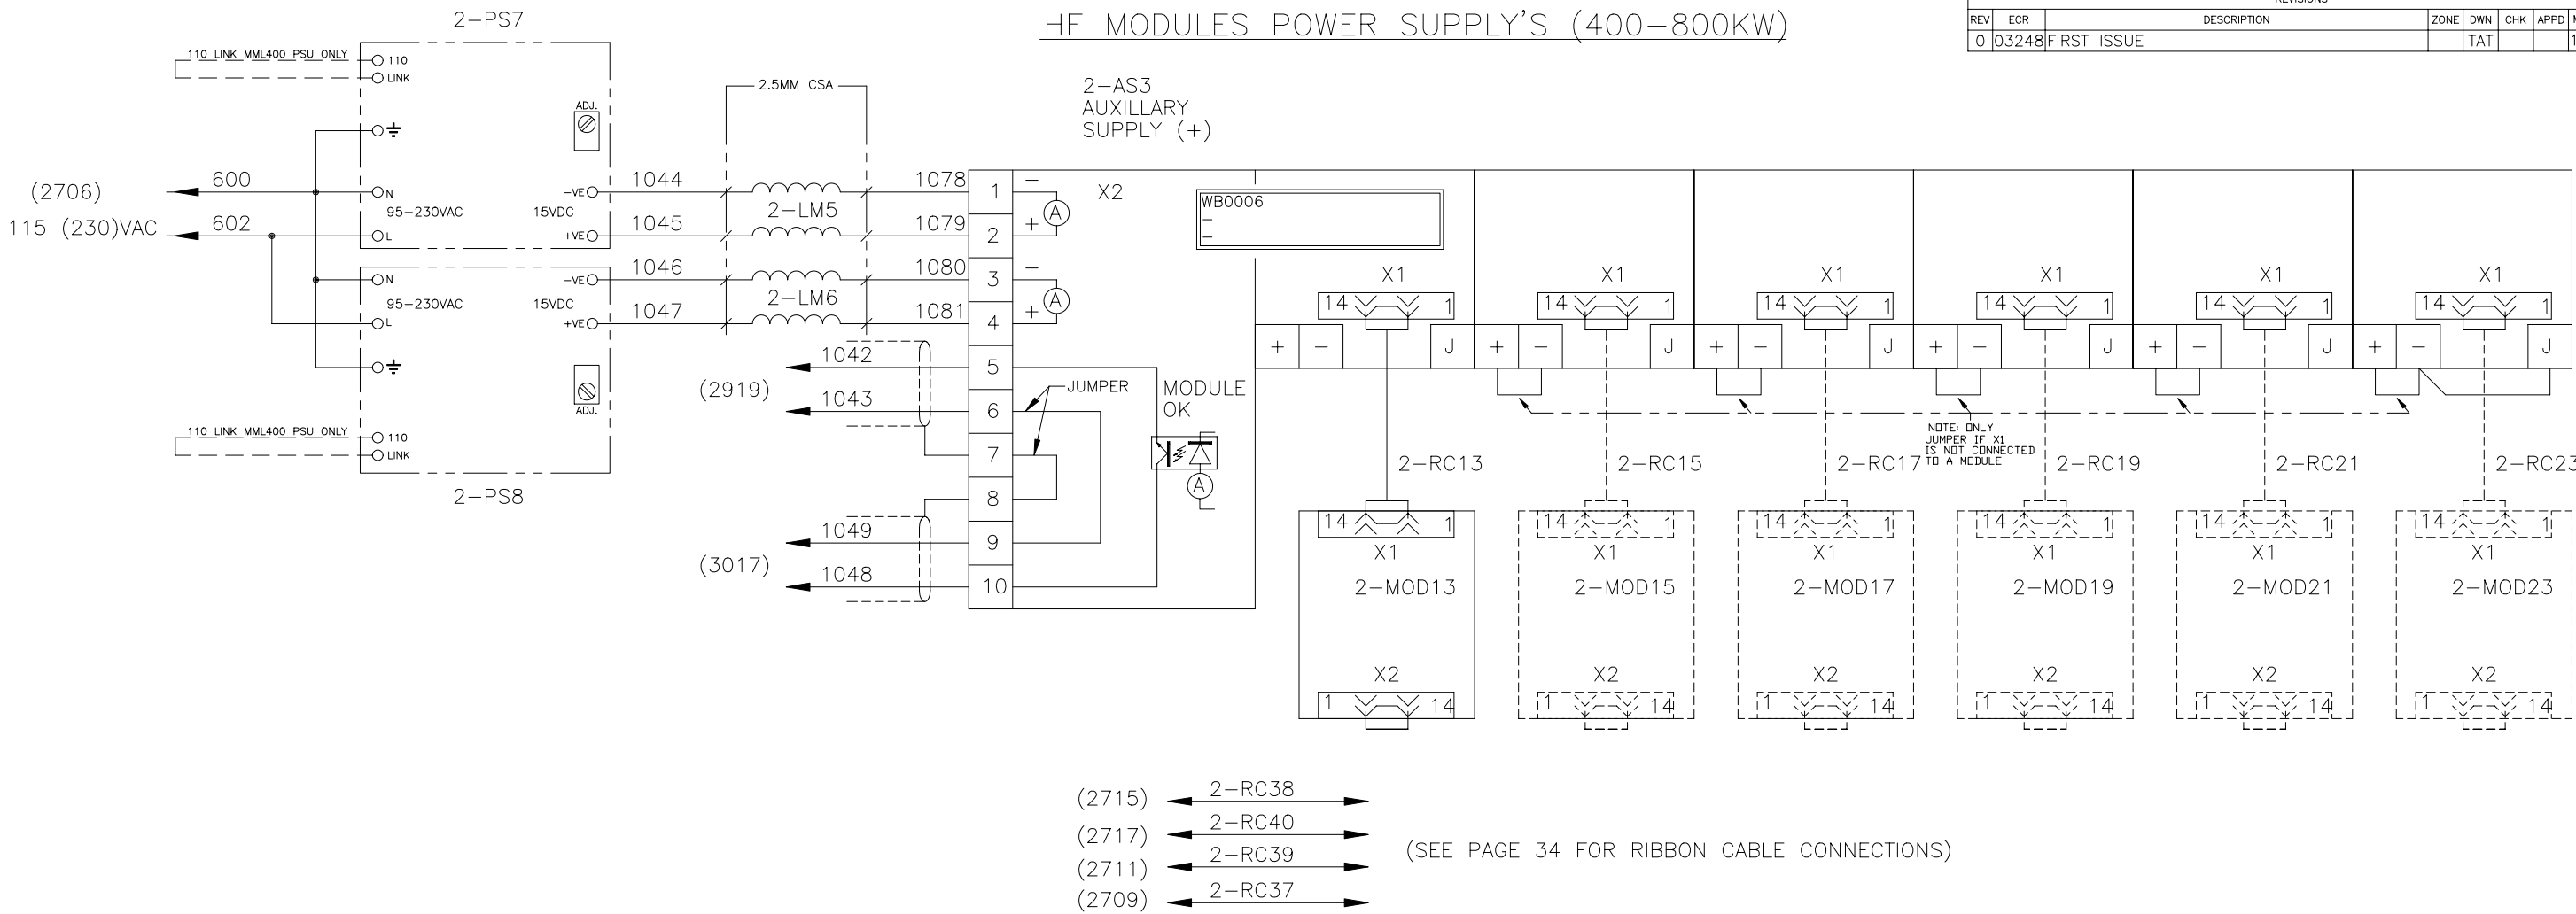

THERMATOOL
©Copyright THERMATOOL EUROPE LTD



TITLE
**SCHEMATIC - ELECTRICAL
CFI SOLID STATE WELDER**

SIZE A1	DIV NO 3	DWG NO WW5107	REV 0
SCALE N/A	DO NOT SCALE DRAWING COPY		SHEET 30

ENG-REF: 2

HF MODULE POWER SUPPLY'S (1000-1200 KW)

REVISIONS						
REV	ECR	DESCRIPTION	ZONE	DWN	CHK	APPD
0	03248	FIRST ISSUE		TAT		MM/DD/YY 11/06/03

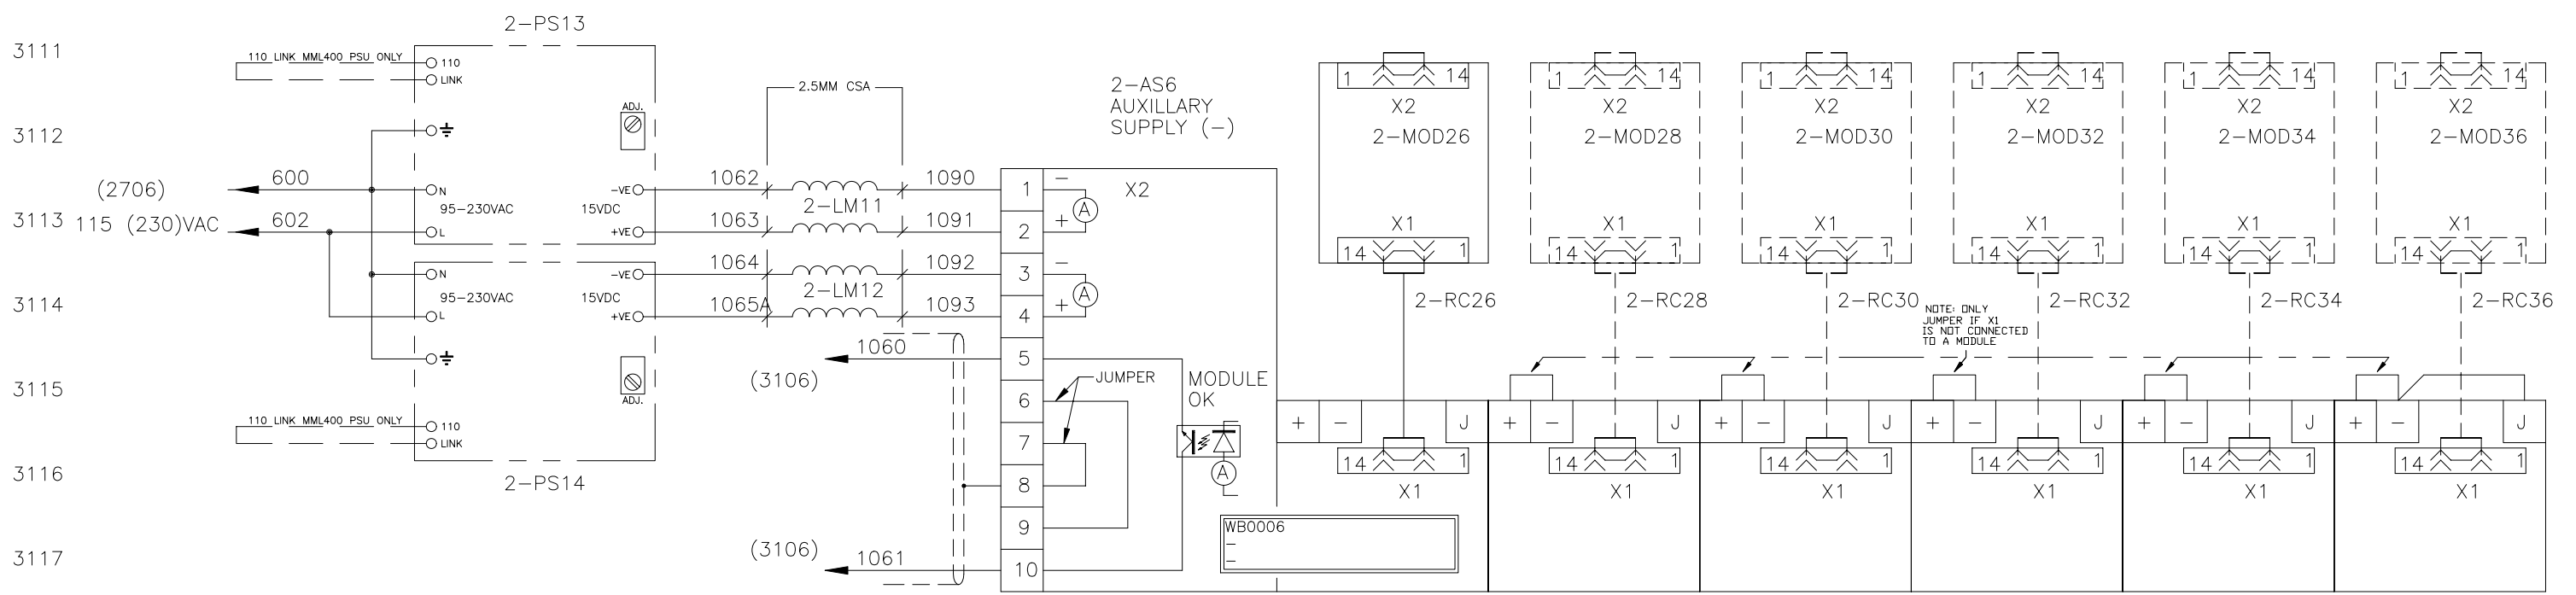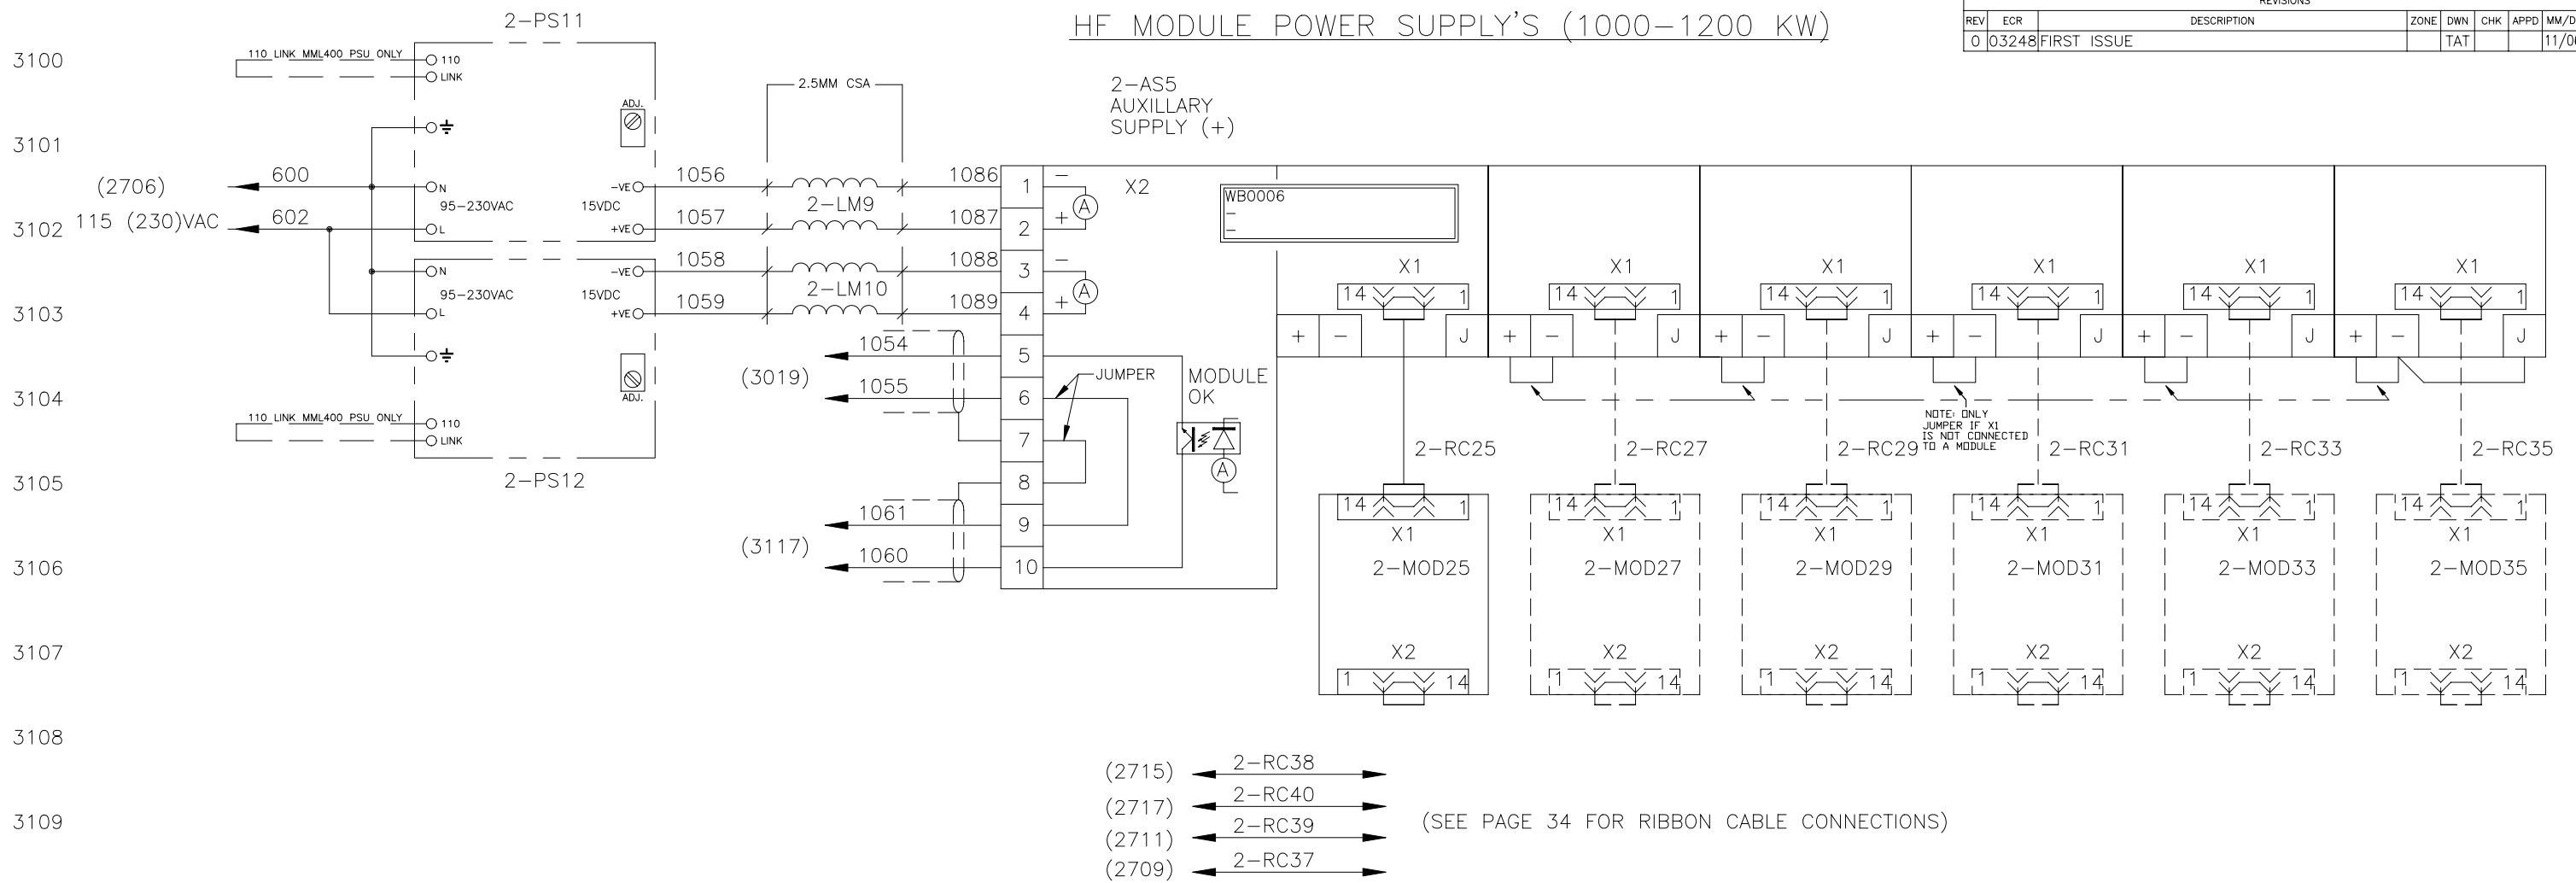

THERMATOOL
©Copyright THERMATOOL EUROPE LTD


**SCHEMATIC – ELECTRICAL
 CFI SOLID STATE WELDER**

SIZE A1	DIV NO 3	DWG NO WW5107	REV 0
SCALE N/A	DO NOT SCALE DRAWING COPY		SHEET 31

ENG-REF: 2


REVISIONS						
REV	ECR	DESCRIPTION	ZONE	DWN	CHK	APPD
0	03248	FIRST ISSUE			TAT	
A	04102	1000-1200KW L2 WAS 74-130 μH/250A & CABLE @ A WAS 95MM, RECORDED "TRUE AS BUILT" STATUS	8B 8A		TAT	
						MM/DD/YY 11/06/03 07/16/04

DC HARMONIC FILTER

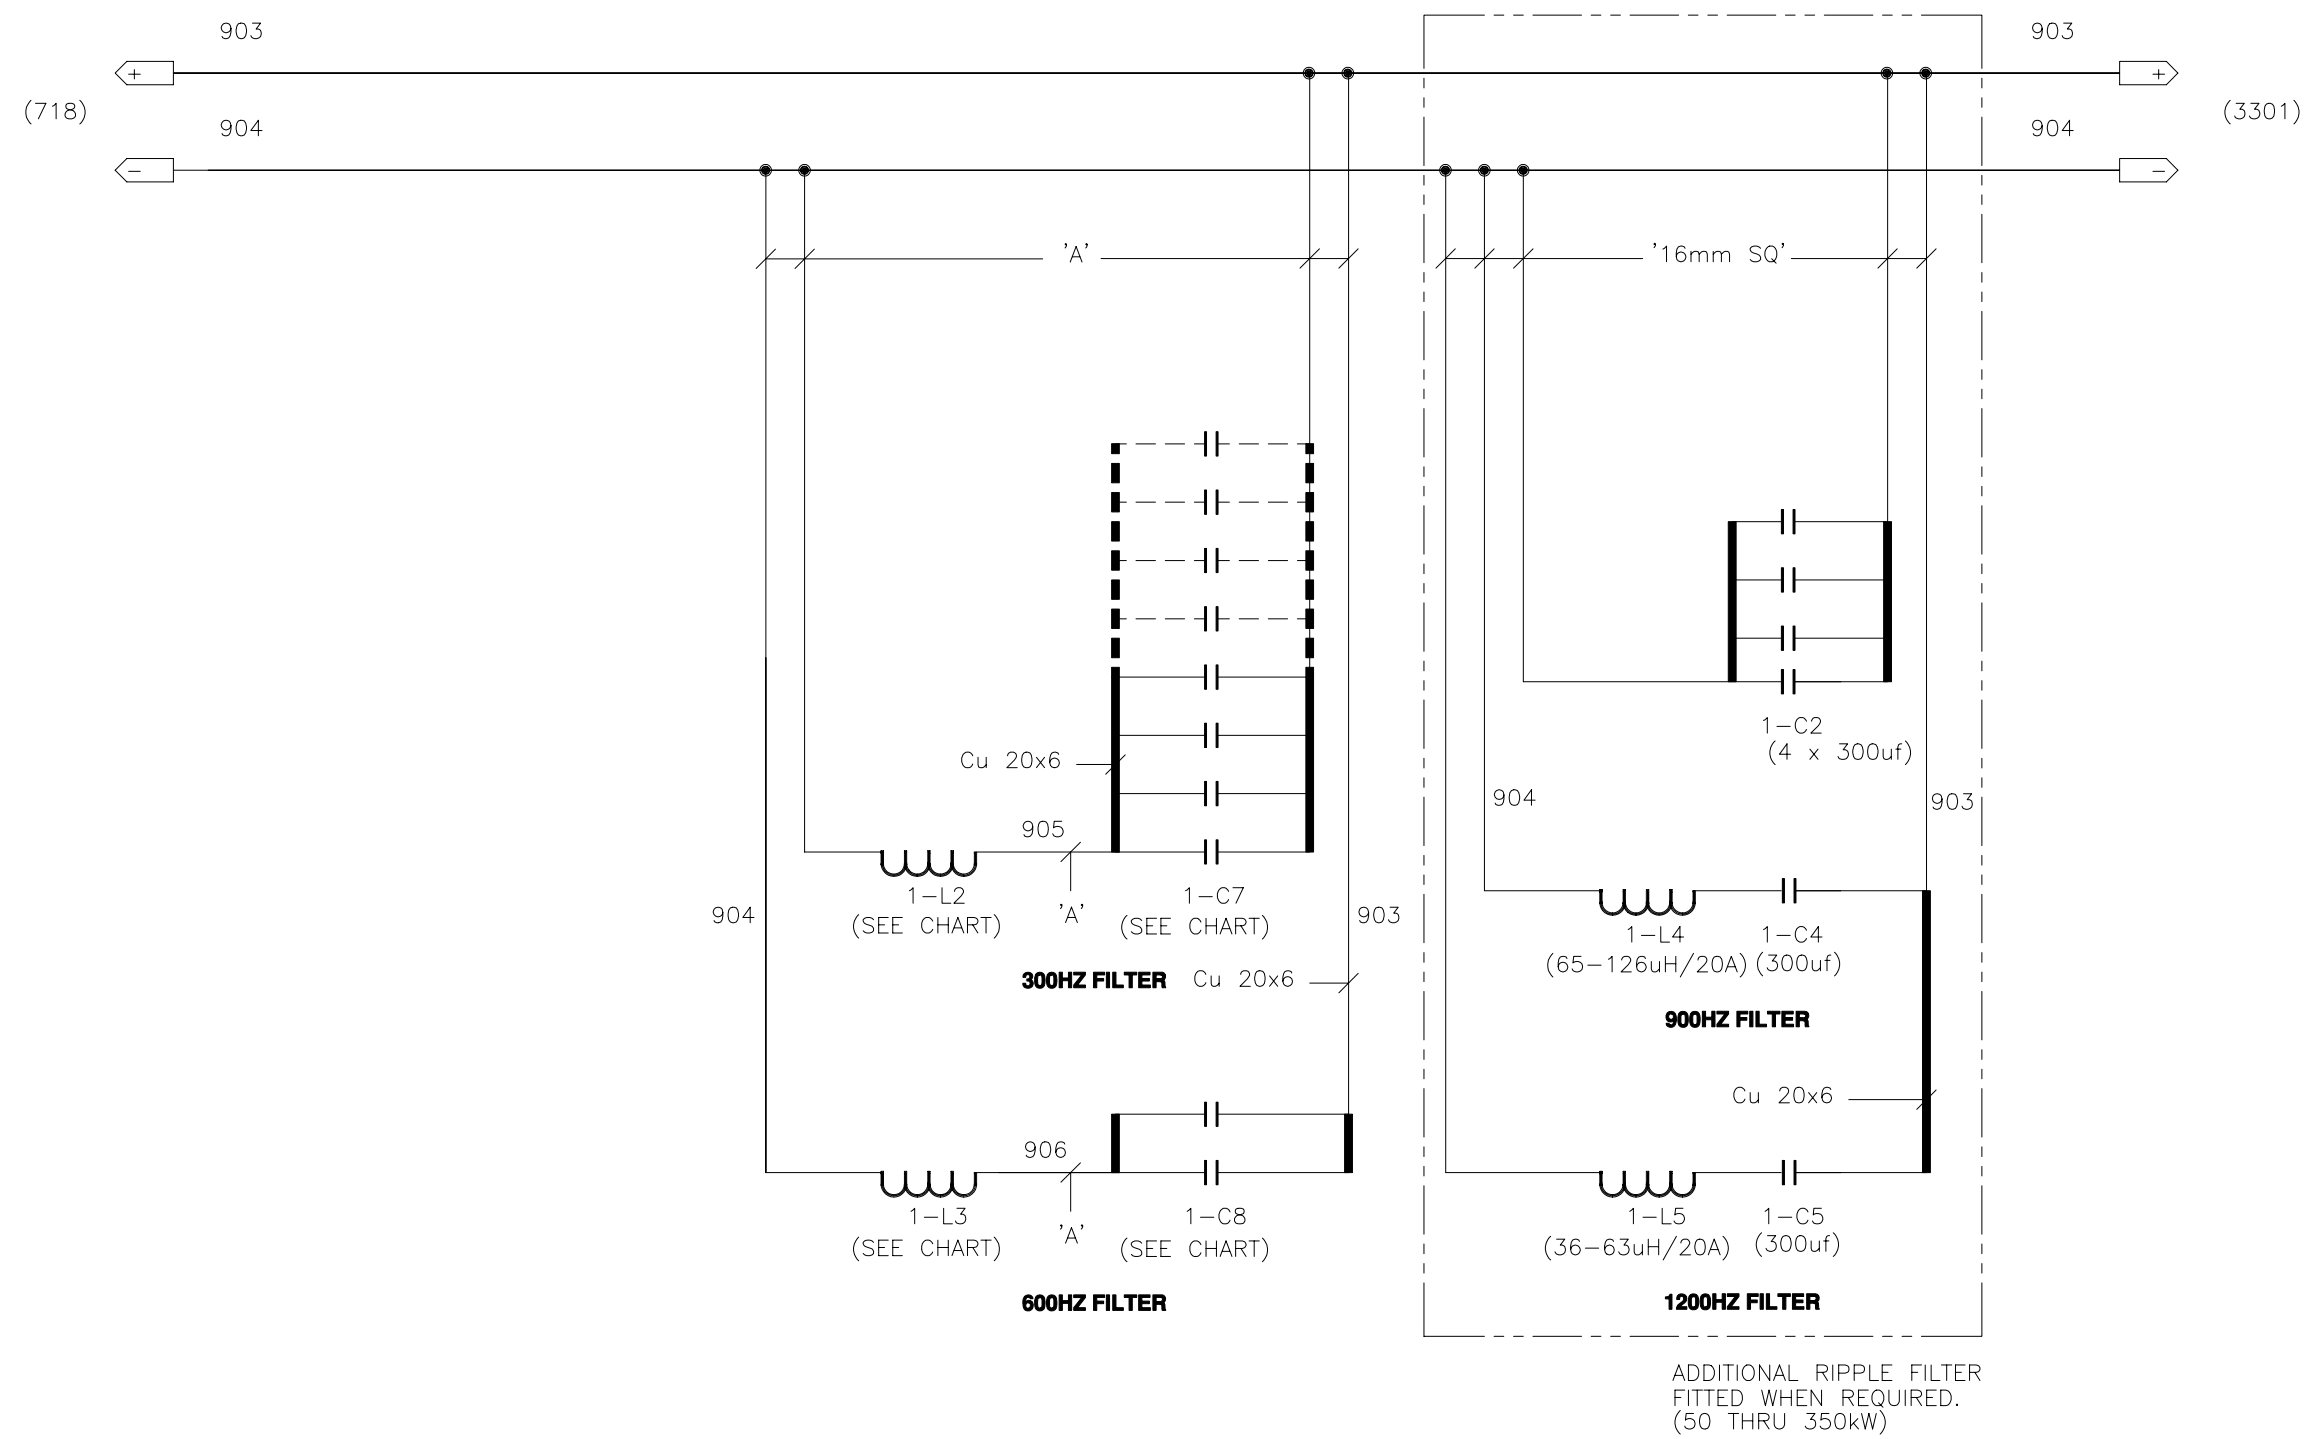

UNIT KILOWATTS

	50-350	400-800	1000-1200
1-C7	(4) x 300uf	(6) x 300uf	(8) x 300uf
1-L2	148-260 μH/70A	98-173 μH/180A	98-173 μH/180A
1-C8	(2) x 300uf	(2) x 300uf	(2) x 300uf
1-L3	74-130 μH/20A	74-130 μH/70A	74-130 μH/70A
MAX. CURRENT@ "A"	70AMPS	180AMPS	180AMPS
CABLE SIZE 'A'	16MM SQ	70MM SQ	70MM SQ




©Copyright THERMATOOL EUROPE LTD

TITLE			
SCHEMATIC – ELECTRICAL CFI SOLID STATE WELDER			
SIZE	DIV NO	DWG NO	REV
A1	3	WW5107	A
SCALE	N/A	DO NOT SCALE DRAWING COPY	SHEET
			32

ENG-REF: 2

REVISIONS						
REV	ECR	DESCRIPTION	ZONE	DWN	CHK	APPD
0	03248	FIRST ISSUE		TAT		MM/DD/YY 11/06/03

RF OUTPUT CIRCUIT

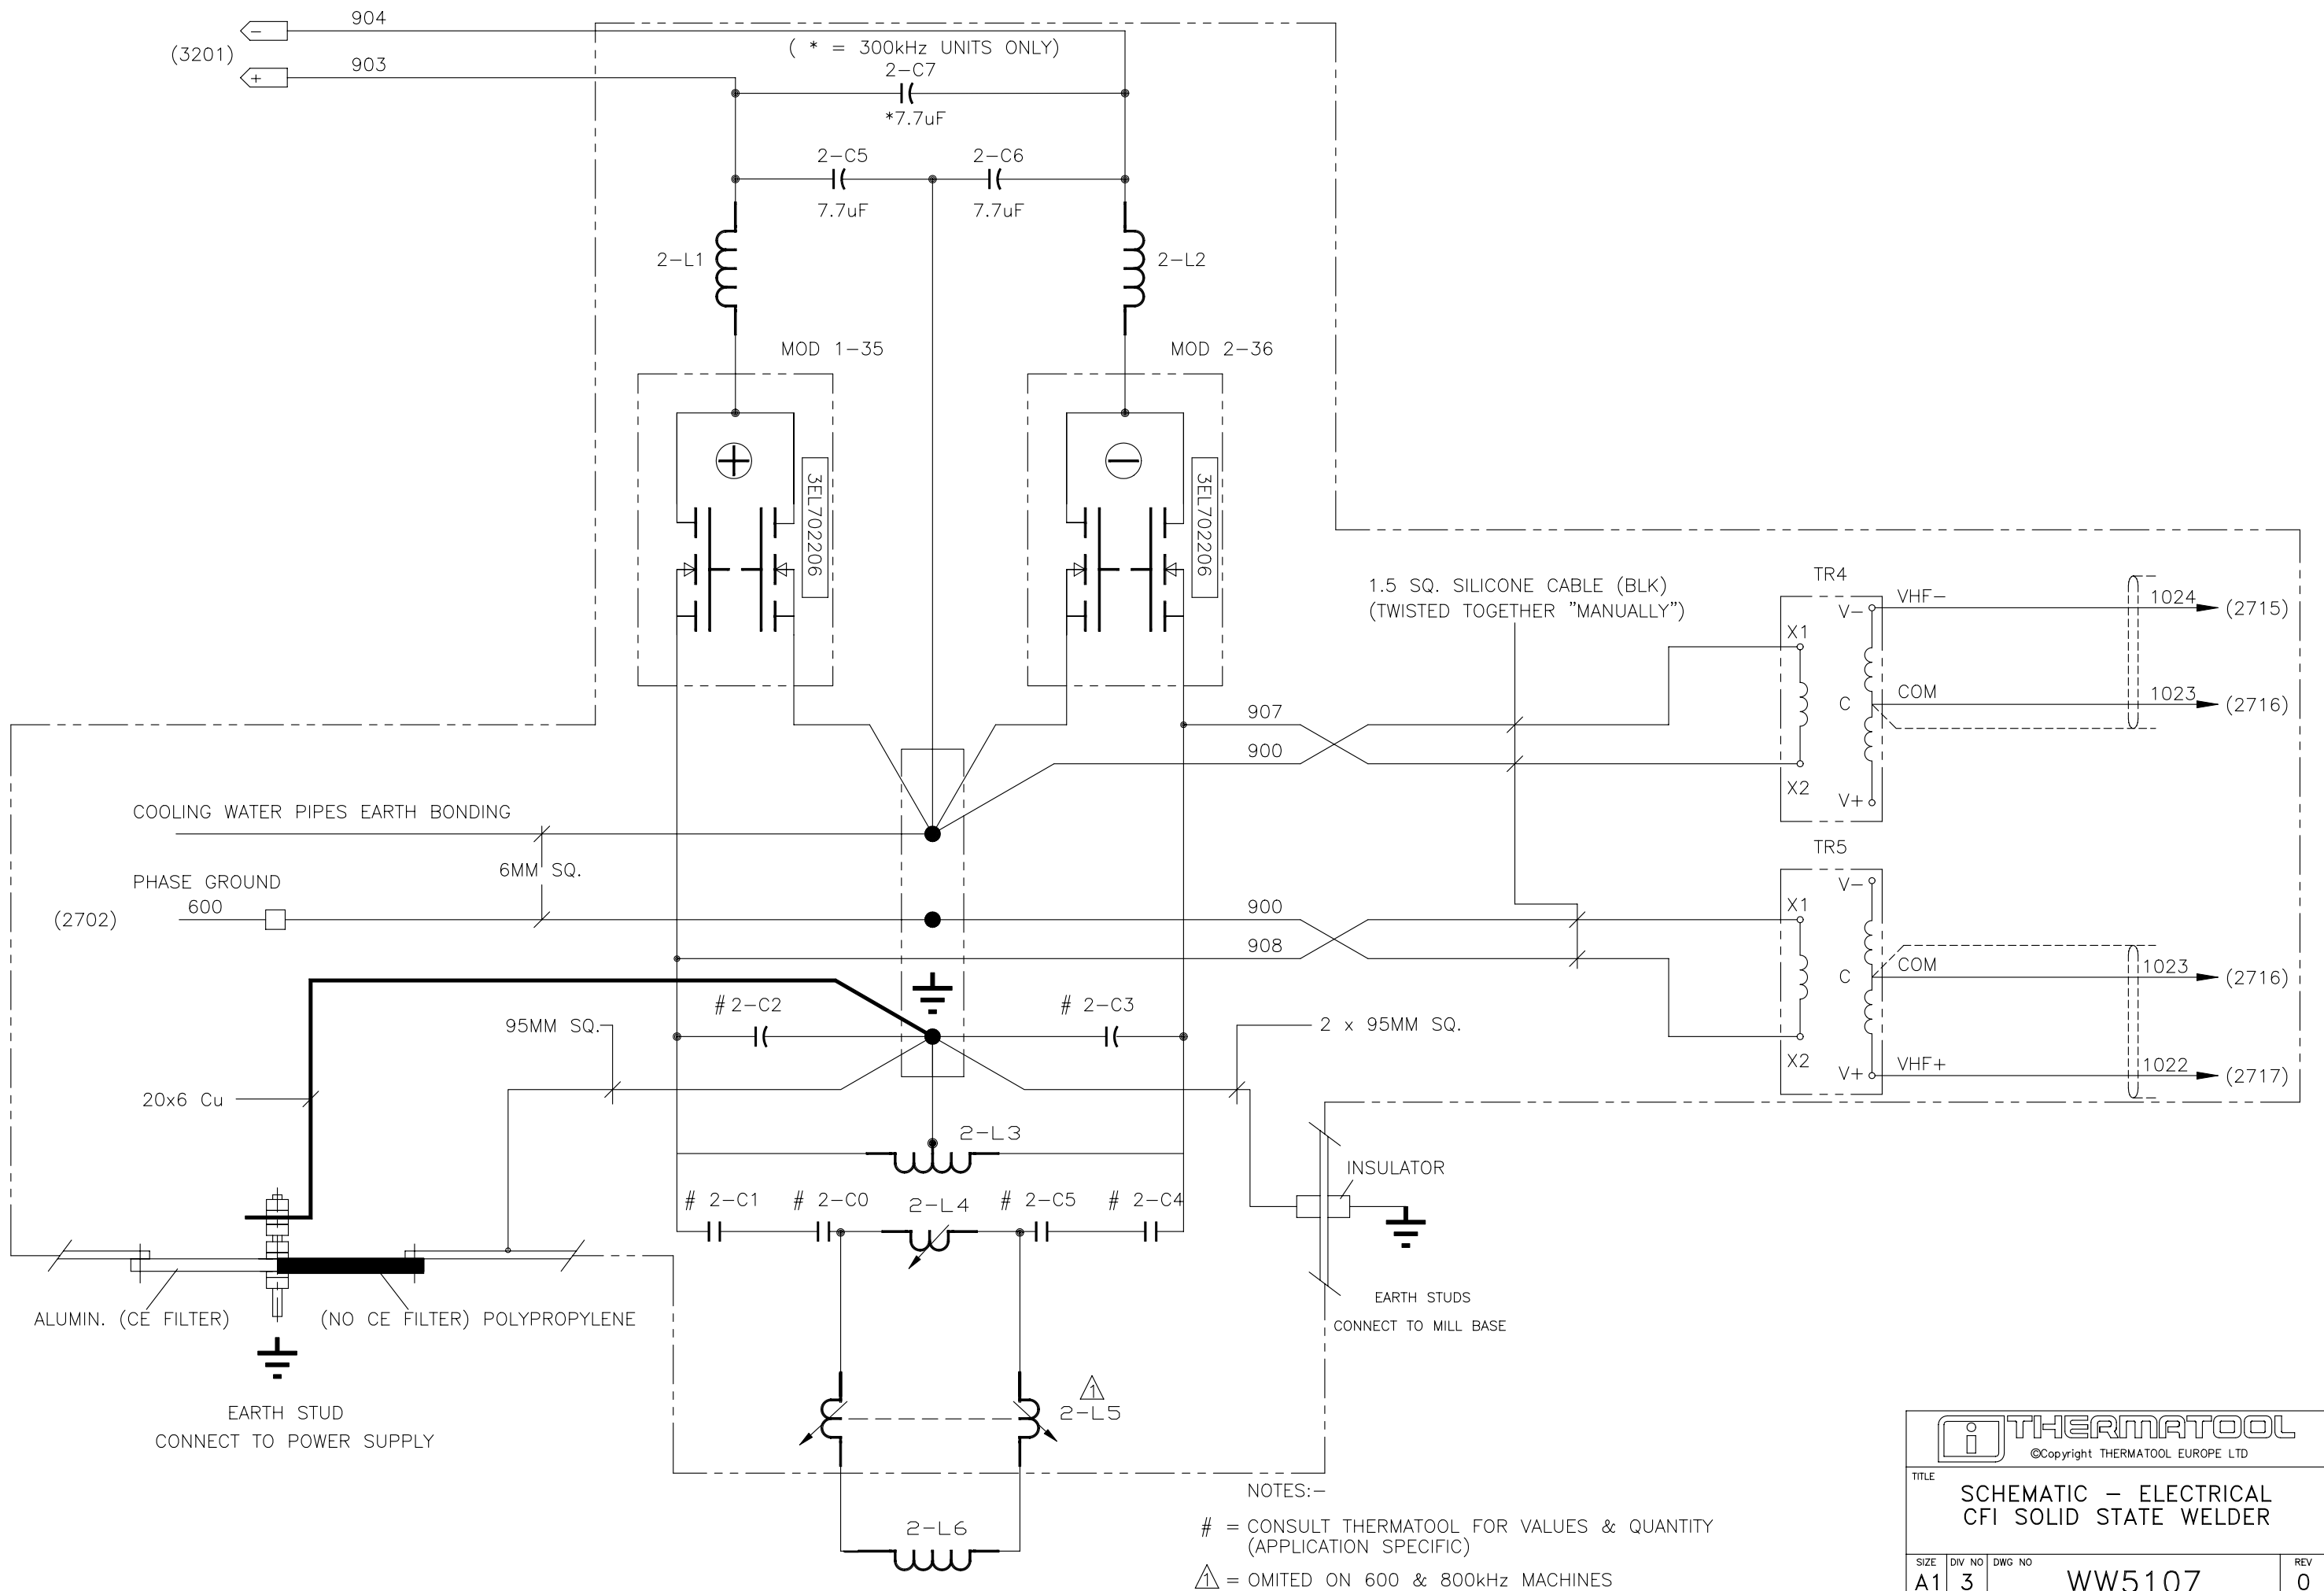

NOTES:-
= CONSULT THERMATOOL FOR VALUES & QUANTITY (APPLICATION SPECIFIC)
△ = OMITED ON 600 & 800kHz MACHINES

 ©Copyright THERMATOOL EUROPE LTD			
TITLE			
SCHEMATIC – ELECTRICAL CFI SOLID STATE WELDER			
SIZE	DIV NO	DWG NO	REV
A1	3	WW5107	0
SCALE	N/A	DO NOT SCALE DRAWING COPY	SHEET
			33

REVISIONS							
REV	ECR	DESCRIPTION	ZONE	DWN	CHK	APPD	MM/DD/YY
0	03248	FIRST ISSUE		TAT			11/06/03

2-HF1 BOARD TO HF MODULE CONNECTIONS

RIBBON CABLE CONNECTIONS FROM 2-HF1 BOARD TO HF MODULES:

CABINET	NUMBER OF MODULES	2-RC37 FROM 2-HF1 (X1R) TO	2-RC39 FROM 2-HF1 (X2R) TO	2-RC38 FROM 2-HF1 (X1D) TO	2-RC40 FROM 2-HF1 (X2D) TO
RF12	2	2-MOD1	-	2-MOD2	-
RF12	4	2-MOD1,3	-	2-MOD2,4	-
RF12	6	2-MOD1,3,5	-	2-MOD2,4,6	-
RF12	8	2-MOD1,3,5,7	-	2-MOD2,4,6,8	-
RF12	10	2-MOD1,3,5,7,9	-	2-MOD2,4,6,8,10	-
RF12	12	2-MOD1,3,5,7,9,11	-	2-MOD2,4,6,8,10,12	-
RF24	14	2-MOD1,3,5,7	2-MOD9,11,13	2-MOD2,4,6,8	2-MOD10,12,14
RF24	16	2-MOD1,3,5,7	2-MOD9,11,13,15	2-MOD2,4,6,8	2-MOD10,12,14,16
RF24	18	2-MOD1,3,5,7,9	2-MOD11,13,15,17	2-MOD2,4,6,8,10	2-MOD12,14,16,18
RF24	20	2-MOD1,3,5,7,9	2-MOD11,13,15,17,19	2-MOD2,4,6,8,10	2-MOD12,14,16,18,20
RF24	22	2-MOD1,3,5,7,9,11	2-MOD13,15,17,19,21	2-MOD2,4,6,8,10,12	2-MOD14,16,18,20,22
RF24	24	2-MOD1,3,5,7,9,11	2-MOD13,15,17,19,21,23	2-MOD2,4,6,8,10,12	2-MOD14,16,18,20,22,24
RF36	26	2-MOD1,3,5,7,9,11,13	2-MOD15,17,19,21,23,25	2-MOD2,4,6,8,10,12,14	2-MOD16,18,20,22,24,26
RF36	28	2-MOD1,3,5,7,9,11,13	2-MOD15,17,19,21,23,25,27	2-MOD2,4,6,8,10,12,14	2-MOD16,18,20,22,24,26,28
RF36	30	2-MOD1,3,5,7,9,11,13,15	2-MOD17,19,21,23,25,27,29	2-MOD2,4,6,8,10,12,14,16	2-MOD18,20,22,24,26,28,30
RF36	32	2-MOD1,3,5,7,9,11,13,15	2-MOD17,19,21,23,25,27,29,31	2-MOD2,4,6,8,10,12,14,16	2-MOD18,20,22,24,26,28,30,32
RF36	34	2-MOD1,3,5,7,9,11,13,15,17	2-MOD19,21,23,25,27,29,31,33	2-MOD2,4,6,8,10,12,14,16,18	2-MOD18,20,22,24,26,28,30,32,34
RF36	36	2-MOD1,3,5,7,9,11,13,15,17	2-MOD19,21,23,25,27,29,31,33,35	2-MOD2,4,6,8,10,12,14,16,18	2-MOD18,20,22,24,26,28,30,32,34

©Copyright THERMATOOL EUROPE LTD


TITLE
SCHEMATIC – ELECTRICAL
CFI SOLID STATE WELDER

SIZE	DIV NO	DWG NO	REV
A1	3	WW5107	0
SCALE	N/A		SHEET
		DO NOT SCALE DRAWING COPY	34


ENG-REF: 2 1

REVISIONS						
REV	ECR	DESCRIPTION	ZONE	DWN	CHK	APPD
0	03248	FIRST ISSUE			TAT	11/06/03
A	04102	DEL PHYSCL PLG BLOCKING PIN DATA	4F	TAT		07/16/04
E	09047	UPDATE MTR & CAP DETAIL, PANASONIC G SERIES TO 3 SERIES, SHOW TERM BOX ON 2-MTR1, DEL 2-MTR1/2 TERM NO'S & CABL CLRS			TAT	04/08/09

HF GENERATOR PLUG INTERCONNECTION DETAILS

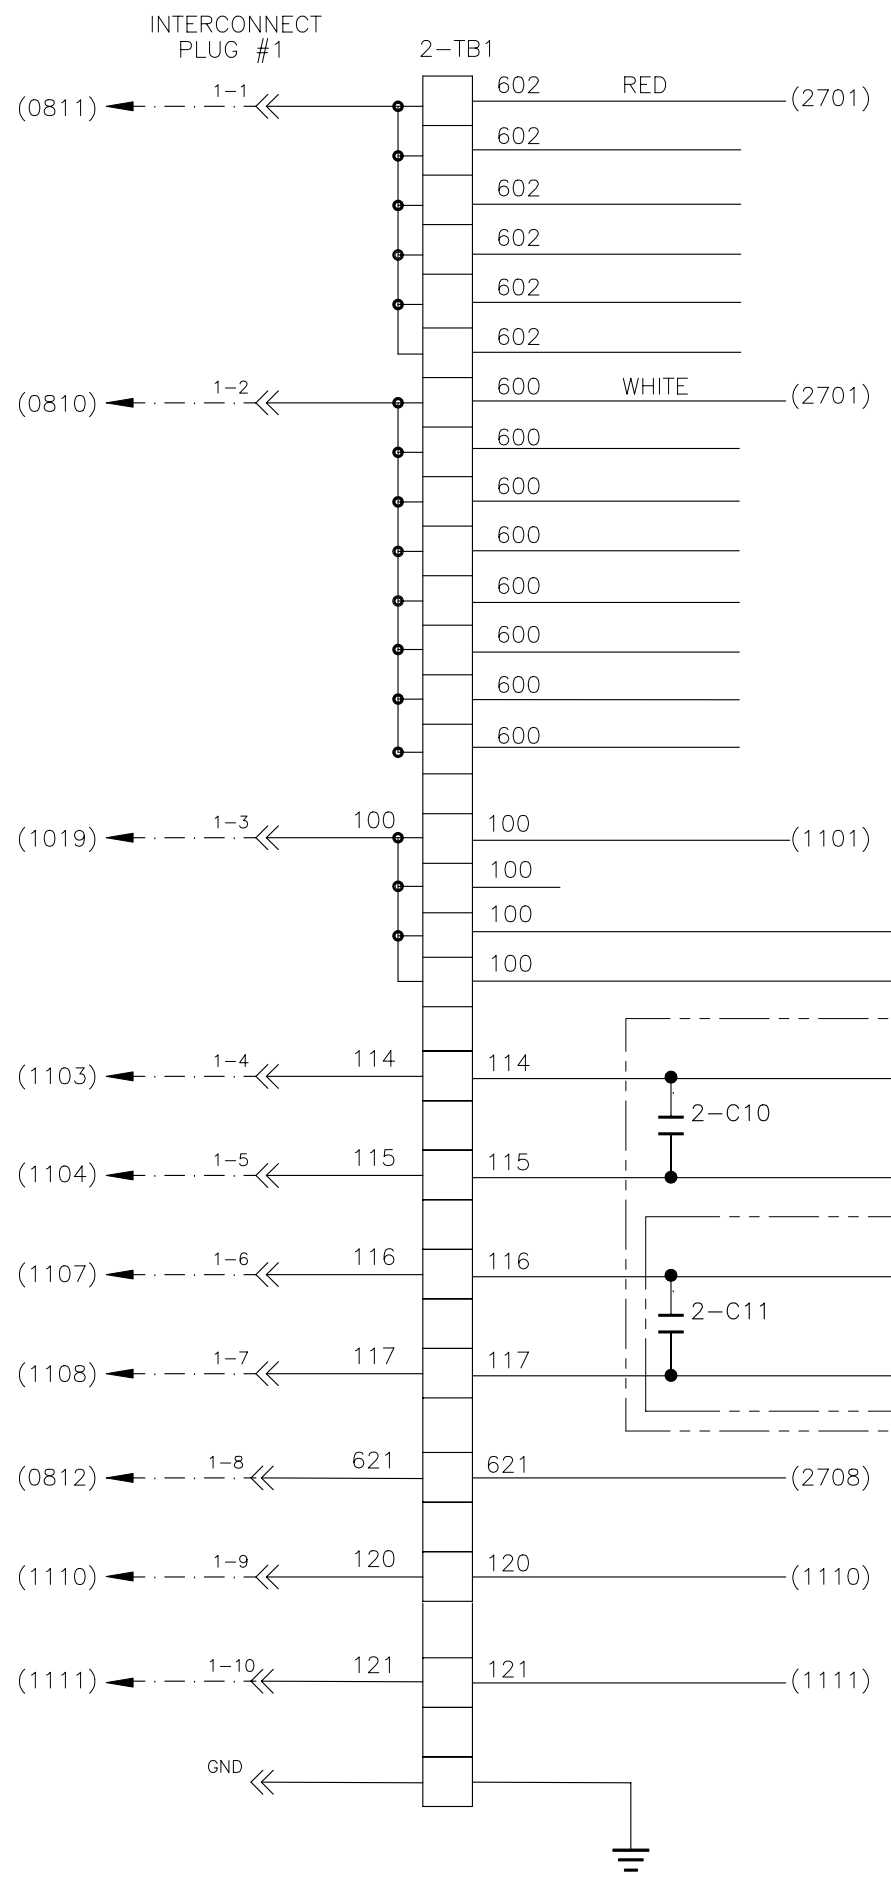

MANUFACTURER	2-C10	2-C11
PANASONIC-3 SERIES		
115V-50/60-25W	8uF	-
115V-50/60-60W	-	20uF
230V-50/60-25W	2uF	-
230V-50/60-60W	-	5uF
PANASONIC-G SERIES		
115V-50/60-20W	5.5uF	-
115V-50/60-60W	-	12uF
230V-50/60-25W	1.8uF	-
230V-50/60-60W	-	5uF

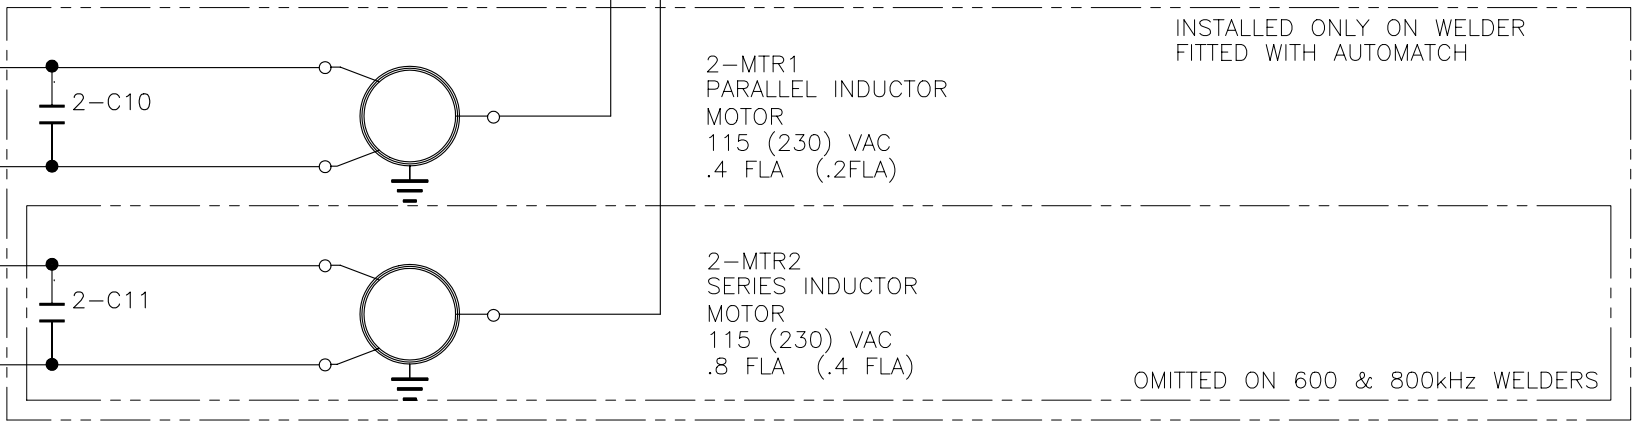

THERMATOOL
©Copyright THERMATOOL EUROPE LTD


TITLE: SCHEMATIC – ELECTRICAL CFI SOLID STATE WELDER

SIZE	DIV NO	DWG NO	REV
A1	3	WW5107	E
SCALE	N/A	DO NOT SCALE DRAWING COPY	SHEET 35

ENG-REF: 2

HF GENERATOR PLUG INTERCONNECTION DETAILS

REVISIONS												
REV	ECR	DESCRIPTION						ZONE	DWN	CHK	APPD	MM/DD/YY
0	03248	FIRST ISSUE										10/21/03
A	04102	DEL.PHYSCL PLG BLCKNG PIN DATA,ADD DS6&7 (RF36) ALTRNT 1-FLS1/1-FLS2 & 1-PS1 ARRANGEMENTS						6B 4E	TAT			07/16/04

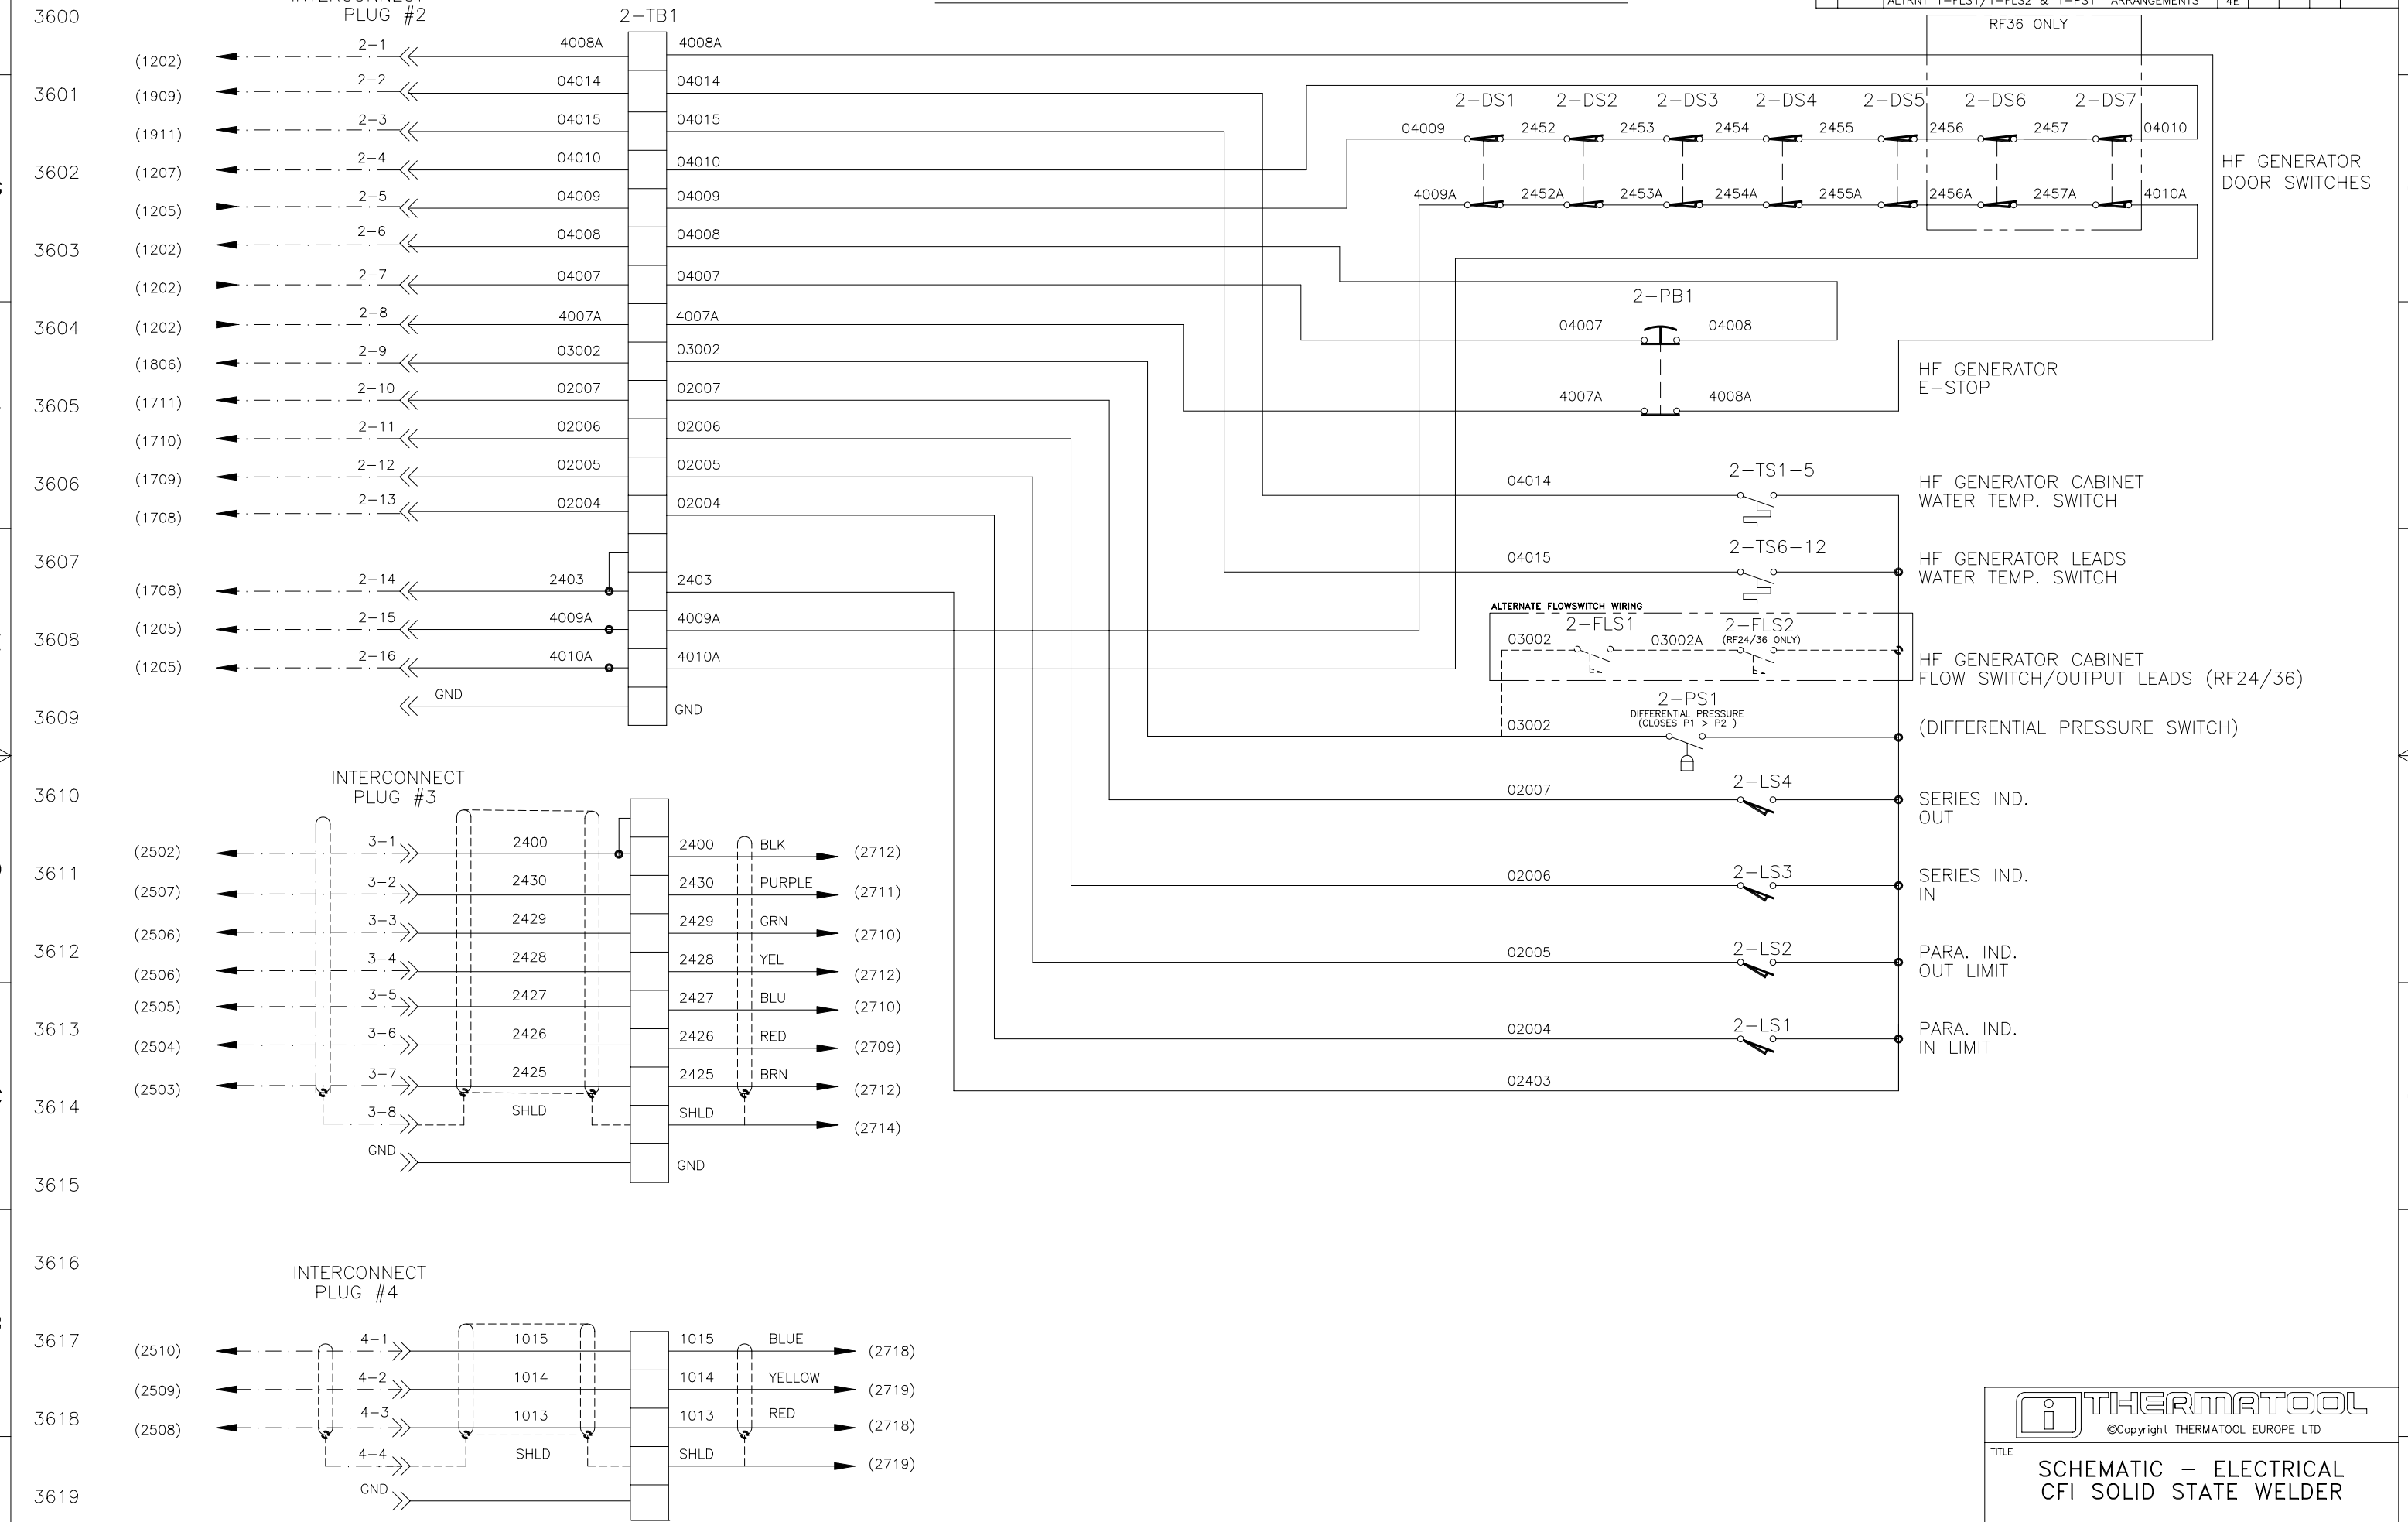






THERMATOOL
©Copyright THERMATOOL EUROPE LTD

TITLE
**SCHEMATIC – ELECTRICAL
CFI SOLID STATE WELDER**


SIZE A1	DIV NO 3	DWG NO WW5107	REV A
SCALE N/A		DO NOT SCALE DRAWING COPY SHEET 36	

TERM LAYOUT TYPICAL 400-600 KW DC PANELS

REVISIONS							
REV	ECR	DESCRIPTION	ZONE	DWN	CHK	APPD	MM/DD/YY
0	03248	FIRST ISSUE		TAT			11/06/03
A	04102	ADD TWO TERMS 2403		TAT			07/16/04

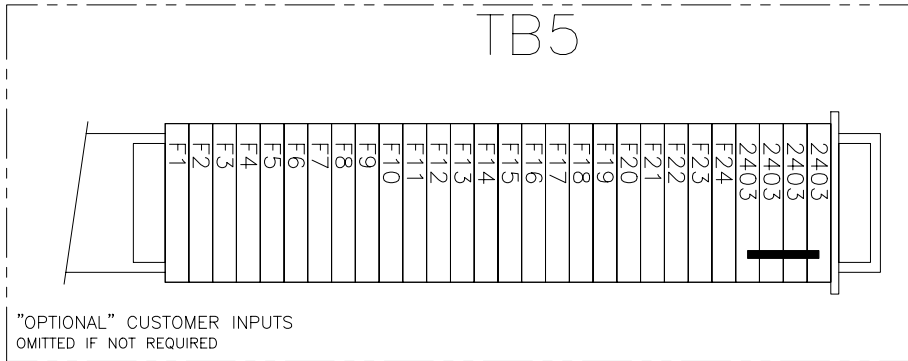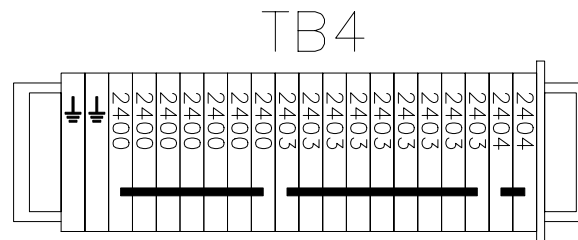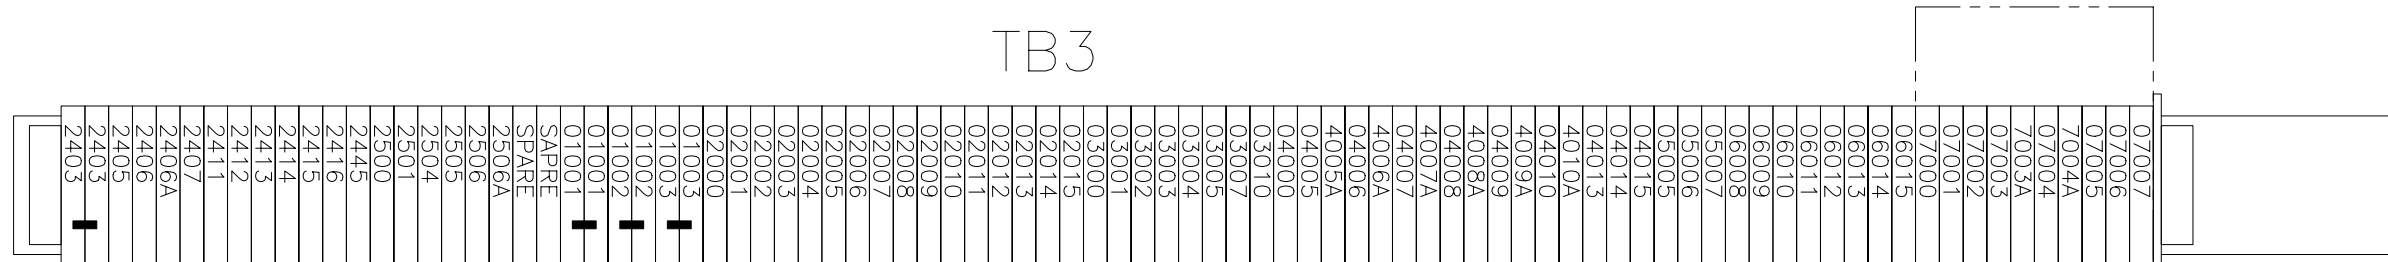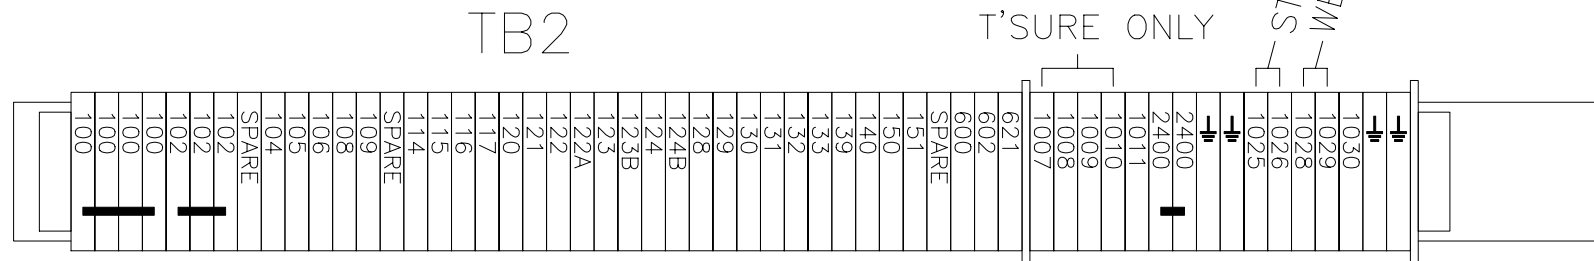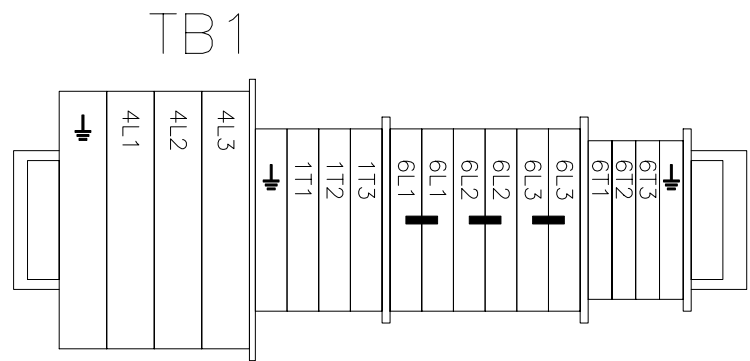

ALL TERMINALS 4MM UNLESS OTHERWISE STATED



©Copyright THERMATOOL EUROPE LTD


TITLE: SCHEMATIC – ELECTRICAL CFI SOLID STATE WELDER.

SIZE: A1	DIV NO: 3	DWG NO: WW5107	REV: A
SCALE: 1:1 ON A1 DO NOT SCALE DRAWING COPY SHEET			37A

ENG-REF: 2

TYPICAL DC PANEL LAYOUT 50-350KW

REVISIONS						
REV	ECR	DESCRIPTION	ZONE	DWN	CHK	APPD
0	03248	FIRST ISSUE		TAT		11/06/03
A	04102	VIEW ROTATED 90 DEG		TAT		07/13/04

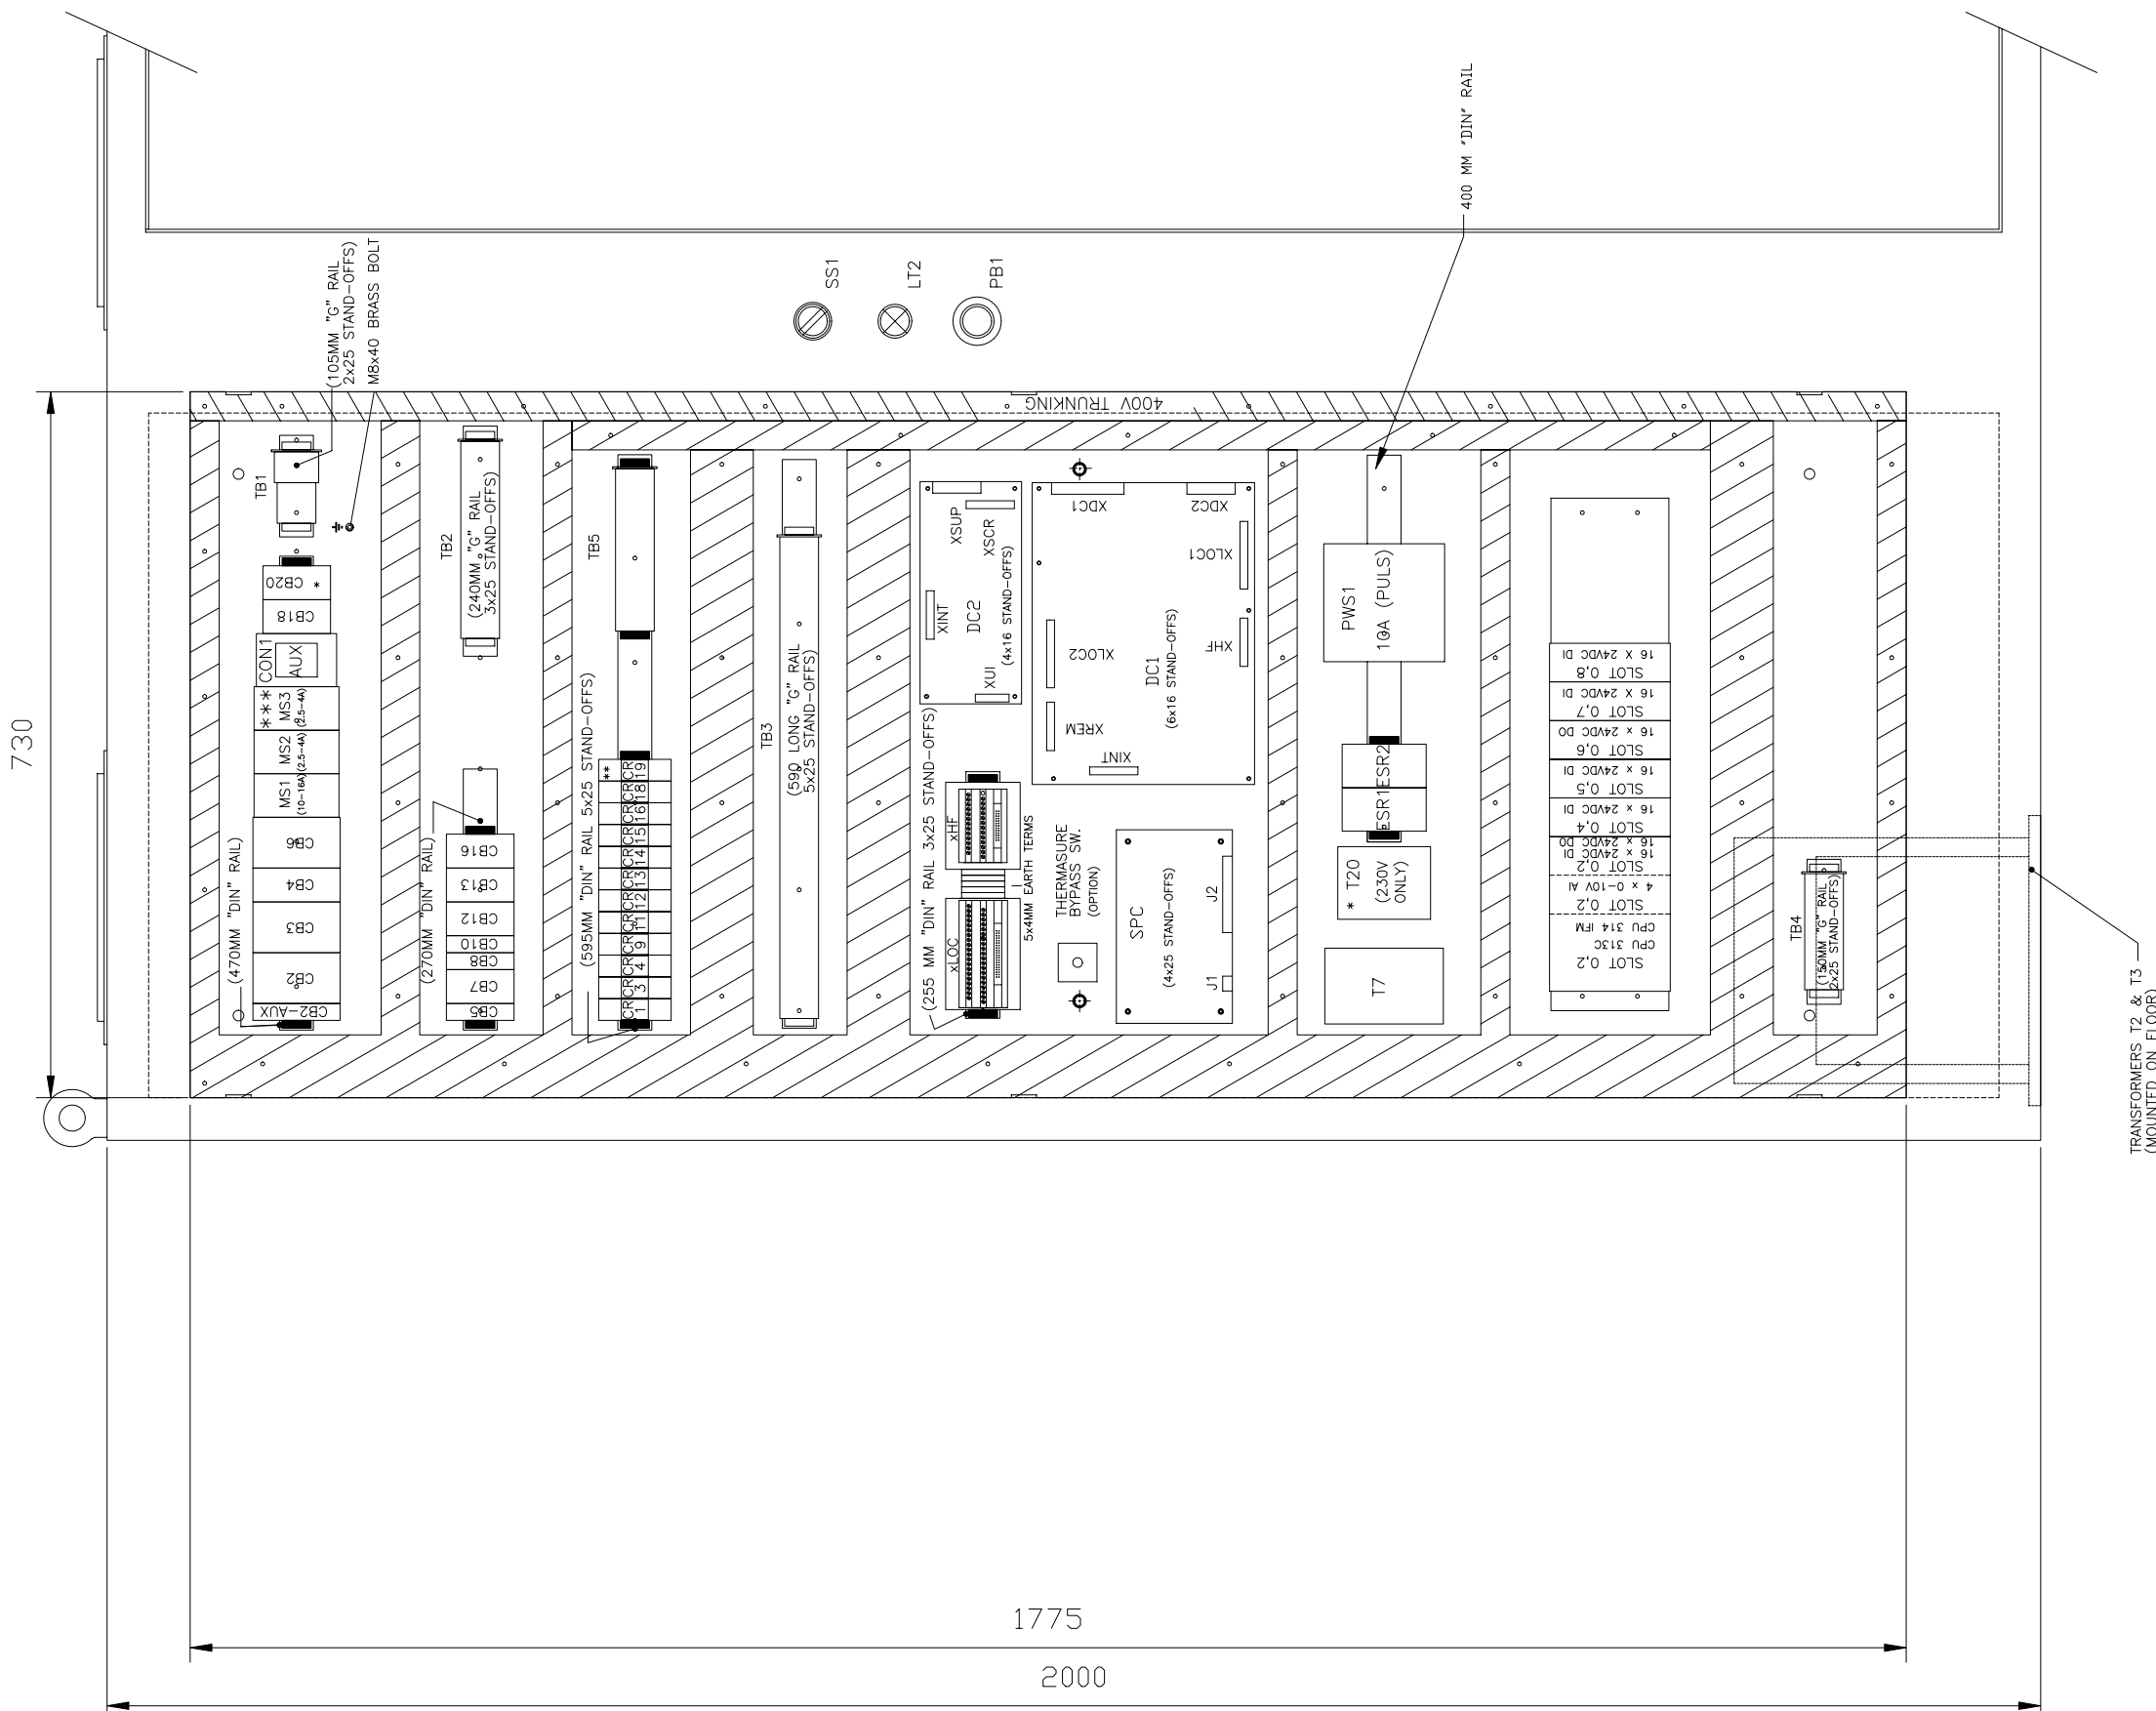

- NOTES:-**
- PANEL COMPONENT PREFIX IS "1" (IE, 1-CB1,1-CB2,1-CR1, etc)
 - TRUNKING SIZES, 30Wx80H & 45WX80H & 65Wx80H
 - * COMPONENTS ON 230V SYSTEMS ONLY
 - ** COMPONENTS ON SYSTEMS WITH THERMASURE ONLY
 - *** COMPONENTS ON 200-350KW SYSTEMS ONLY
 - IDENTIFY ALL COMPONENTS (PERMANENT ON COMPONENT OR BACKBOARD)

THERMATOOL
©Copyright THERMATOOL EUROPE LTD

TITLE: SCHEMATIC - ELECTRICAL CFI SOLID STATE WELDER.


SIZE	DIV NO	DWG NO	REV
A1	3	WW5107	A

SCALE 1:4 ON A1 DO NOT SCALE DRAWING COPY SHEET 38

Grid lines: 12, 11, 10, 9, 8, 7, 6, 5, 4, 3, 2, 1 (horizontal)
 Grid lines: H, 3800, 3801, 3802, 3803, 3804, 3805, 3806, 3807, 3808, 3809, 3810, 3811, 3812, 3813, 3814, 3815, 3816, 3817, 3818, 3819, 3820 (vertical)

TYPICAL DC PANEL LAYOUT 400-600KW

REVISIONS							
REV	ECR	DESCRIPTION	ZONE	DWN	CHK	APPD	MM/DD/YY
0	03248	FIRST ISSUE			TAT		11/06/03
A	04102	RE-DRAWN SINGLE PANEL DC			TAT		07/13/04

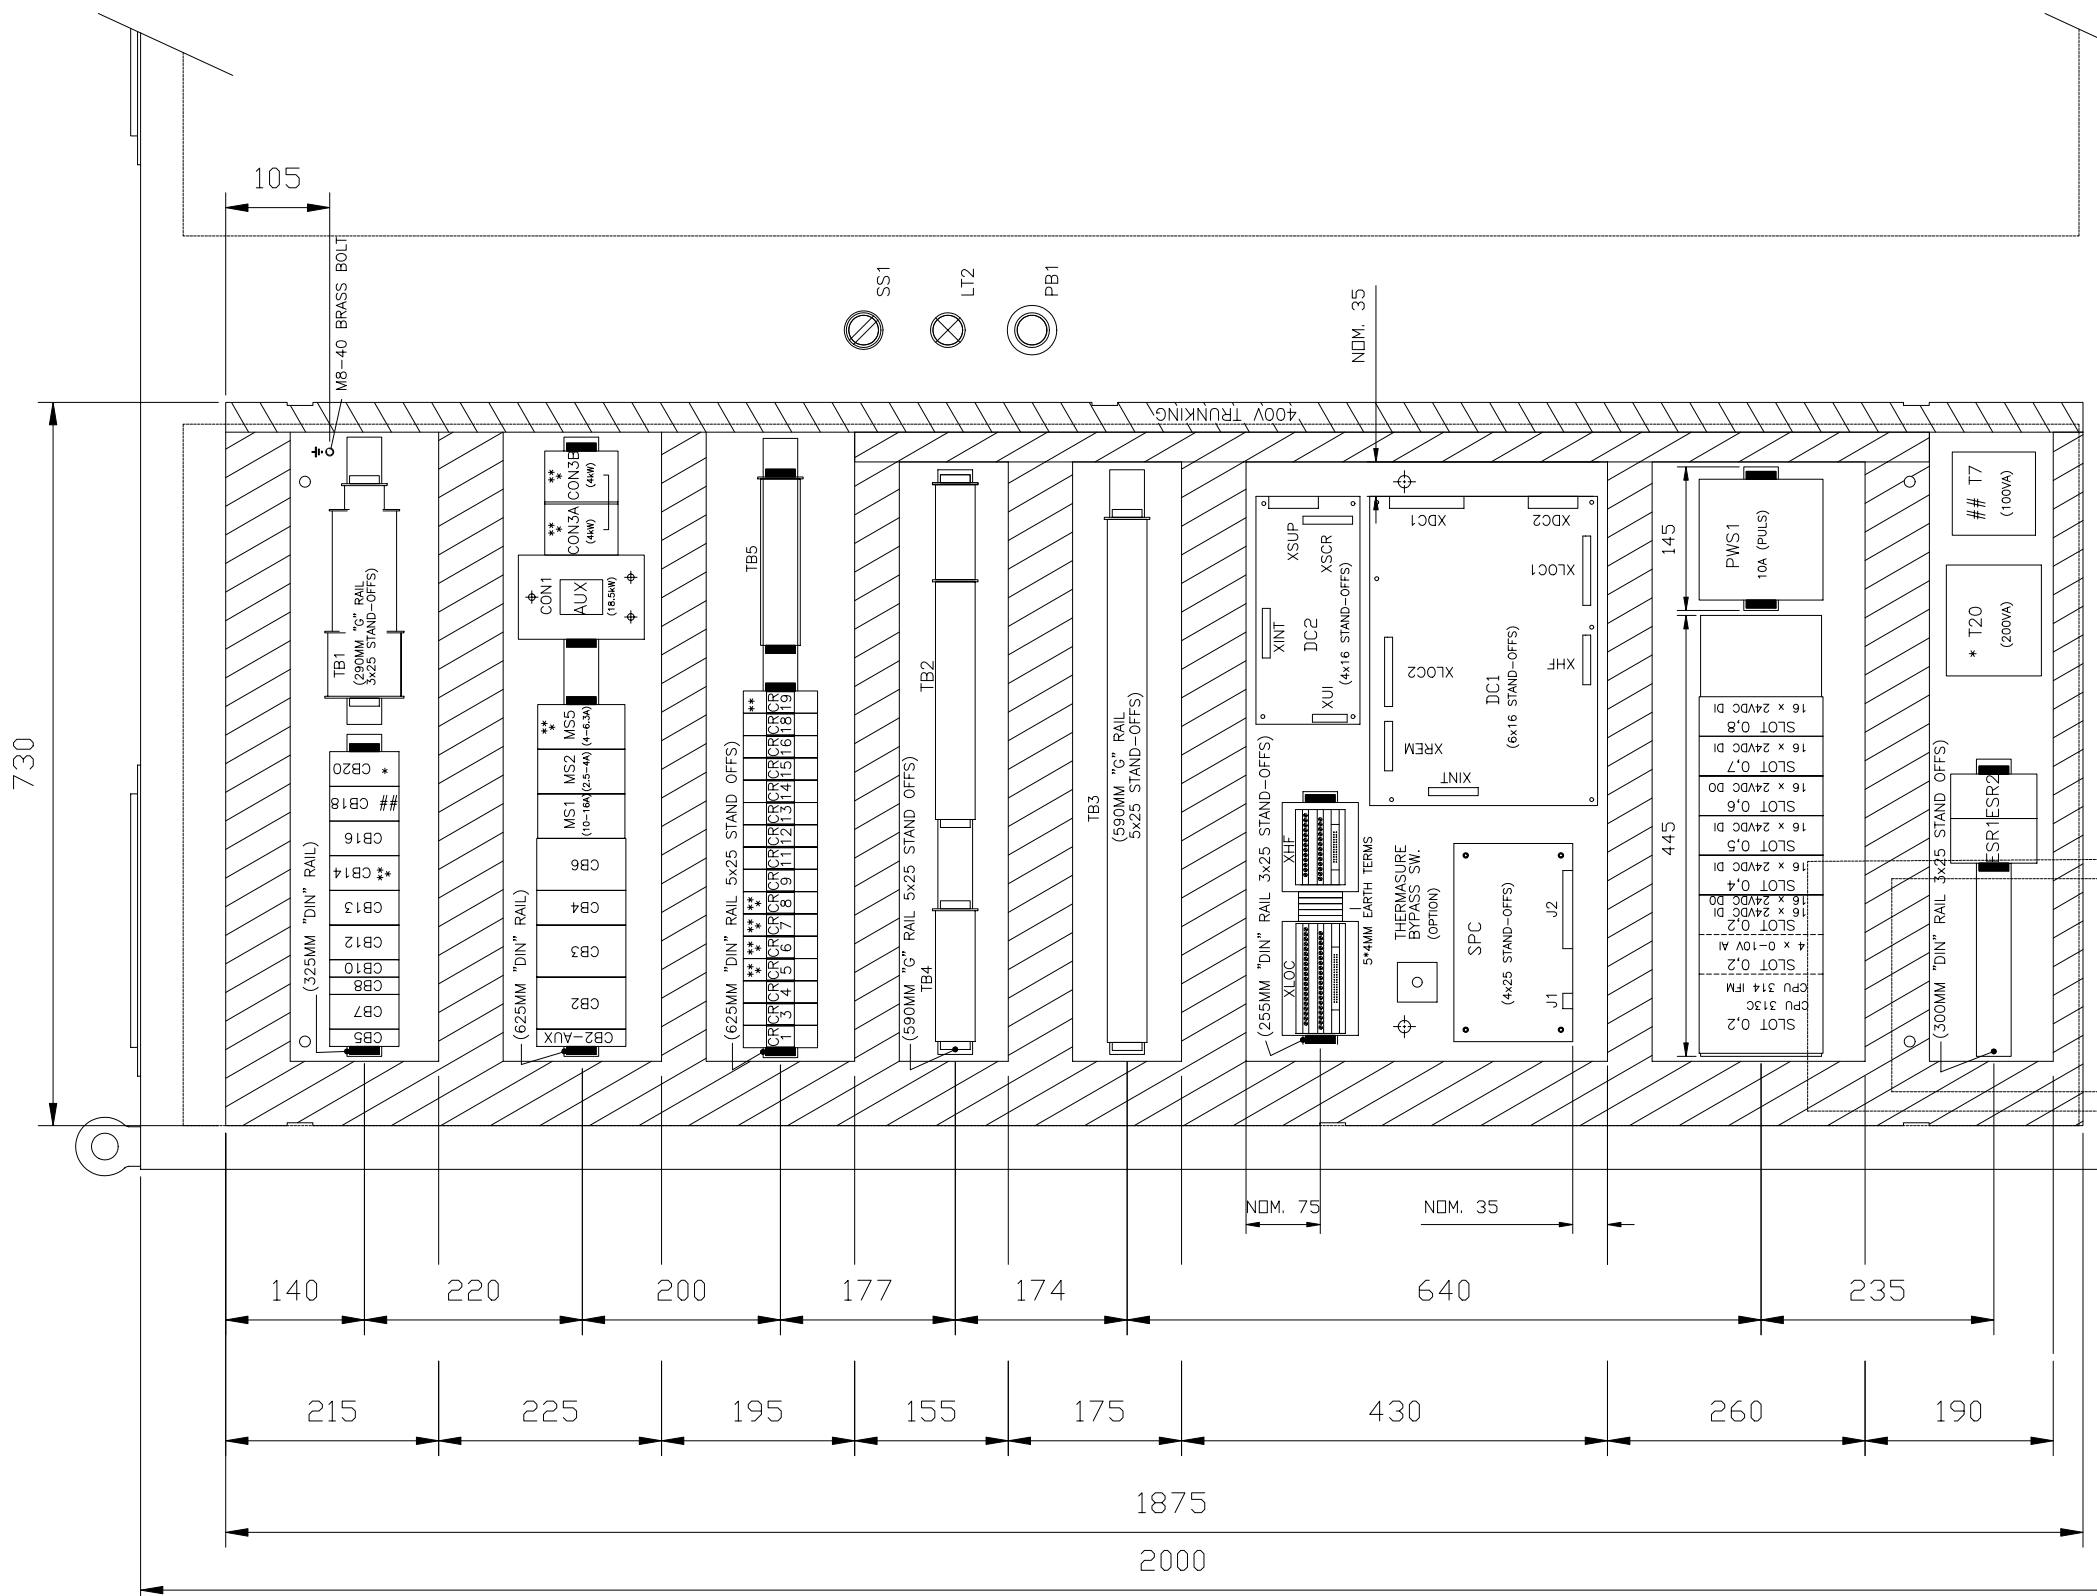

- NOTES:-**
- PANEL COMPONENT PREFIX IS "1" (IE, 1-CB1,1-CB2,1-CR1, etc)
 - TRUNKING SIZES, 30Wx80H & 45Wx80H & 65Wx80H
 - * COMPONENTS ON 230V SYSTEMS ONLY
 - ** COMPONENTS ON SYSTEMS WITH THERMASURE ONLY
 -
 - ## COMPONENTS OMITTED IF THERMATOOL SUPPLIED XFORMER CABINET
 - ** COMPONENTS OMITTED IF SINGLE AXIS TABLE
 - IDENTIFY ALL COMPONENTS (PERMANENT ON COMPONENT OR BACKBOARD)

TRANSFORMERS T2 & T3
(MOUNTED ON FLOOR)

©Copyright THERMATOOL EUROPE LTD	
TITLE SCHEMATIC – ELECTRICAL CFI SOLID STATE WELDER.	
SIZE A1	DIV NO 3
DWG NO WW5107	REV A
SCALE 1:4 ON A1	DO NOT SCALE DRAWING COPY SHEET 38A

WW0094

Interconnection Cable List

Sheet 1 – *Interconnection Cable List*

Sheet 2 – *Interconnection Cable List*

Sheet 3 – *Interconnection Cable List*

Sheet 4 – *Interconnection Cable List*

Sheet 5 – *Interconnection Cable List*

Sheet 6 – *Interconnection Cable List*

Sheet 7 – *Interconnection Cable List*

Sheet 8 – *Interconnection Cable List*

Sheet 9 – *Interconnection Cable List*

Sheet 10 – *Interconnection Cable List*

Sheet 11 – *Interconnection Cable List*

Sheet 12 – *Interconnection Cable List*

Sheet 13 – *Interconnection Cable List*

Sheet 14 – *Interconnection Cable List*

Sheet 15 – *Interconnection Cable List*

Sheet 16 – *Interconnection Cable List*

Sheet 17 – *Interconnection Cable List*

Sheet 18 – *Interconnection Cable List*

Sheet 19 – *Interconnection Cable List*


Sheet 20 – *Interconnection Cable List*

Sheet 21 – *Interconnection Cable List*

Sheet 22 – *Interconnection Cable List*

Sheet 23 – *Interconnection Cable List*

Sheet 24 – *Interconnection Cable List*

REV	ECR	DESCRIPTION	DWN	CHK	APPD	MM/DD/YY
A	282	01-06-30 CONDUIT, SINGLE AXIS MOTOR ADDED	TAT	AB	AB	9/4/98
"	"	01-02-30 CONDUIT SINGLE AXIS MTR REMOVED	"	"	"	"
B		DUAL E-STOP CIRCUIT	TAT	AB	AB	6/18/98
C		CONTACT/INDUCTION PNEU.CAB WIRING ADDED	TAT	AB	AB	8/14/98
D	N062	01-02-40 CONDUIT,(3PH SERIES MOTOR WIRING) DELETED	TAT	AB	AB	10/9/98
		01-06-30 CONDUIT, (1PH Z & X AXIS MOTORS) DELETED				
		01-20-30 CONDUIT, SINGLE AXIS (X AXIS) MOTOR ADDED				
		01-18-20 CONDUIT, MILLGUARD SW CH1&2 TERMS RE-DEFINED				
		AS 07003,7003A ON UNITS >400Kw (T*TOOL XFORMER SUPPLY)				
		AND 04010,4010A ON ALL OTHER.				
		01-06-30 CONDUIT, ADDED Y AXIS LIMIT SWITCHES				
		01-06-20 CONDUIT, ADDED PNEUMATIC CLAMP OPEN/CLOSE SW				
		01-05-40 CONDUIT, DEFINED HEAT EXCHANGER VARIANTS				
		01-04-20 CONDUIT DELETE WIRES 2407,2503				
		GENERALLY RE-ARRANGED DOCUMENT TO CLARIFY				
E	-	DEFINE POWER FACTOR CORRECTION CABLE SIZE FOR 200 & 300KW WELDERS	TAT	ABr	ABr	3/31/99
F	N258	RE-DEFINE PFC. CURRENT XFORMER CABLING DETAIL, ADD DETAIL FOR PFC DOOR SWITCHES	TAT	ABr	ABr	4/14/99
G	01065	ADD EARTHS IN PLUG CONNECTORS SH.8&9,250KW GND CABLE WAS 1X240 SH.6,DELETE CONDUIT NO 01-06-40 Z AXIS BRAKE SOLENOID, ADD 400KVAR PFC ON SH.23, CORRECT COMMENTS ON OTHER KVAR RATINGS	TAT	ABr	ABr	3/30/01
H	01091	X AXIS MOTOR WIRING ADDED TO THE MULTICORE DIRECT TO 3 AXIS TABLE (CONDUIT 01-06-30), CORRECTED MISC.COMMENT ERRORS PLUG 1 (CONDUIT 01-02-30)	TAT	Abr	ABr	4/25/00
I	01244	Sh. 8 CORRECTED CONDUIT ID FOR PLUG 2, WAS 01-02-60 NOW 01-02-20 (24V DC)	TAT	Abr	ABr	10/19/01
J	01323	CABLE/TERM 621 (Sh.8 Plug I Pin 8- Conduit 01-02-30) PREVIOUSLY IDENTIFIED AS 603	TAT	Abr	ABr	1/15/02
K	04256	SH 10, CONDUIT 01-04-20, ADD CABLE 2406A	TAT			11/16/04
L	06151	SH.13 AMENDED 50-15OKW HE PUMP WAS 2.2KW, NOW 5.5KW, CABLES WERE 1.5MM NOW 2.5MM	TAT			06/23/06
Buyer or seller hereby acknowledges that there may be errors or omissions in this document and that Thermatool Europe Ltd shall not be liable in any manner for such errors or emissions.		This document is the property of Thermatool Europe Ltd and it is submitted for use only with work proposed or authorised by this company. It should not be used or duplicated for any other purpose and is to be returned to Thermatool Europe Ltd on request when no longer required for such purposes.				
			TITLE INTERCONNECT CABLE LIST FOR CFI SOLID STATE WELDERS			
			DWG No WW0094		Rev L	

(c) Copyright Thermatool Europe Ltd

SOURCE/ DEST'N CODE		DESCRIPTION	COMMENTS
0		PLANT DISTRIBUTION PANEL	CUSTOMER SUPPLY
1		WELDER DC POWER SUPPLY	
2		RF GENERATOR/OSCILLATOR	
3		UNUSED	UNUSED
4		WELDER REMOTE CONTROLS	
5		WELDER HEAT EXCHANGER	
6		WELD TABLE	
7		WELD HEAD	
8		THERMASURE OPERATOR PANEL	OPTIONAL EQUIPMENT
9		THERMASURE CHART RECORDER	OPTIONAL EQUIPMENT
10		THERMASURE PYROMETER HEAD	OPTIONAL EQUIPMENT
11		PYROMETER AIR FILTER ASSEMBLY	OPTIONAL EQUIPMENT
12		THERMASURE TEMP. DISPLAY UNIT	OPTIONAL EQUIPMENT
13		SIL - SIGNAL ISOLATOR/CONVERTER	OPTIONAL EQUIPMENT
17		SYSTEM MILL FIXTURE	
18		SYSTEM CONTROL CABINET	
19		SYSTEM CONSOLE	
20		SYSTEM PENDANT STATION	
21		STEP DOWN TRANSFORMER CABINET	ONLY ON 400Kw AND ABOVE
31		POWER FACTOR CORRECTION CABINET	OPTIONAL EQUIPMENT

VOLTAGE LEVEL CODE		DESCRIPTION
1		SIGNAL LEVEL (ANALOGUE)
2		EXTRA LOW VOLTAGE 24VDC
3		LOW VOLTAGE 115V OR 230V 50Hz
4		LOW VOLTAGE POWER LEVEL 400V 50Hz
5		SPECIAL HIGH POWER CABLES/BUSBARS
6		LV PLANT DISTRIBUTION 400V 50Hz

CONDUIT NUMBER SYSTEM		FORMAT
		AA - BB - C D
AA		SOURCE EQUIPMENT CODE
BB		DESTINATION EQUIPMENT CODE
C		VOLTAGE LEVEL CODE
D		JUNCTION BOX No. (WHERE USED)

UNIT RATING	PHASE	CONDUCTOR NUMBER	CONDUCTOR QUANTITY	COND. SIZE	COND. COLOUR
50Kw (123A)	R	L1	1	70mm2	BLACK
	S	L2	1	70mm2	BLACK
	T	L3	1	70mm2	BLACK
	GND	GND	1	35mm2	GRN/YEL
100Kw (231A)	R	L1	1	95mm2	BLACK
	S	L2	1	95mm2	BLACK
	T	L3	1	95mm2	BLACK
	GND	GND	1	50mm2	GRN/YEL
150Kw (348A)	R	L1	2	70mm2	BLACK
	S	L2	2	70mm2	BLACK
	T	L3	2	70mm2	BLACK
	GND	GND	1	70mm2	GRN/YEL
200Kw (464A)	R	L1	2	120mm2	BLACK
	S	L2	2	120mm2	BLACK
	T	L3	2	120mm2	BLACK
	GND	GND	1	120mm2	GRN/YEL
250Kw (578A)	R	L1	2	150mm2	BLACK
	S	L2	2	150mm2	BLACK
	T	L3	2	150mm2	BLACK
	GND	GND	1	150mm2	GRN/YEL
300Kw (690A)	R	L1	2	185mm2	BLACK
	S	L2	2	185mm2	BLACK
	T	L3	2	185mm2	BLACK
	GND	GND	1	185mm2	GRN/YEL
350Kw (795A)	R	L1	3	120mm2	BLACK
	S	L2	3	120mm2	BLACK
	T	L3	3	120mm2	BLACK
	GND	GND	1	185mm2	GRN/YEL
NOTES					
CABLES ON THIS PAGE ARE BASED ON COPPER UNARMoured SINGLE CORE					
CONDUCTORS ENCLOSED IN CONDUIT TO BS 6004, BS 6231, BS 6346					
AT 30 DEG C AMBIENT AND 70 DEG C CONDUCTOR TEMPERATURE.					

UNIT RATING	PHASE	CONDUCTOR NUMBER	CONDUCTOR QUANTITY	COND. SIZE	COND. COLOUR
400Kw (911A)	R	L1	3	150mm2	BLACK
	S	L2	3	150mm2	BLACK
	T	L3	3	150mm2	BLACK
	GND	GND	1	240mm2	GRN/YEL
500Kw (1130A)	R	L1	4	150mm2	BLACK
	S	L2	4	150mm2	BLACK
	T	L3	4	150mm2	BLACK
	GND	GND	2	150mm2	GRN/YEL
600Kw (1361A)	R	L1	4	185mm2	BLACK
	S	L2	4	185mm2	BLACK
	T	L3	4	185mm2	BLACK
	GND	GND	2	185mm2	GRN/YEL
800Kw (1805A)	R	L1	5	240mm2	BLACK
	S	L2	5	240mm2	BLACK
	T	L3	5	240mm2	BLACK
	GND	GND	3	240mm2	GRN/YEL
1000Kw (2257A)	R	L1	6	240mm2	BLACK
	S	L2	6	240mm2	BLACK
	T	L3	6	240mm2	BLACK
	GND	GND	3	240mm2	GRN/YEL
1200Kw (2703A)	R	L1	7	240mm2	BLACK
	S	L2	7	240mm2	BLACK
	T	L3	7	240mm2	BLACK
	GND	GND	4	240mm2	GRN/YEL
NOTES					
CABLES ON THIS PAGE ARE BASED ON COPPER UNARMoured SINGLE CORE					
CONDUCTORS ENCLOSED IN CONDUIT TO BS 6004, BS 6231, BS 6346					
AT 30 DEG C AMBIENT AND 70 DEG C CONDUCTOR TEMPERATURE.					

CONDUIT ID - A A - B B - C D				APPLICATION	SEE UNIT RATING
CONDUIT No.- 2 1 - 0 1 - 5 0				DESCRIPTION	WELDER SUPPLY 200V 50Hz
SOURCE - CUSTOMER				FROM	WELDER TRANSFORMER CABINET
				TO	WELDER DC POWER SUPPLY

CONDUCTOR DESCRIPTION HIGH CONDUCTIVITY COPPER BUSBARS

UNIT RATING	PHASE	CONDUCTOR NUMBER	CONDUCTOR QUANTITY	COND. SIZE	COND. COLOUR
400Kw (1680A)	R	2L1	1	100X10mm	N/A
	S	2L2	1	100X10mm	N/A
	T	2L3	1	100X10mm	N/A
	GND	GND	1	100X5mm	N/A
500Kw (2097A)	R	2L1	2	60X10mm	N/A
	S	2L2	2	60X10mm	N/A
	T	2L3	2	60X10mm	N/A
	GND	GND	1	60X10mm	N/A
600Kw (2525A)	R	2L1	2	80X10mm	N/A
	S	2L2	2	80X10mm	N/A
	T	2L3	2	80X10mm	N/A
	GND	GND	1	80X10mm	N/A
800Kw (3347A)	R	2L1	2	100X10mm	N/A
	S	2L2	2	100X10mm	N/A
	T	2L3	2	100X10mm	N/A
	GND	GND	1	100X10mm	N/A
1000Kw (4183A)	R	2L1	3	100X10mm	N/A
	S	2L2	3	100X10mm	N/A
	T	2L3	3	100X10mm	N/A
	GND	GND	2	100X10mm	N/A
1200Kw (5020A)	R	2L1	3	120X10mm	N/A
	S	2L2	3	120X10mm	N/A
	T	2L3	3	120X10mm	N/A
	GND	GND	2	120X10mm	N/A

NOTES

CONDUCTORS ON THIS PAGE ARE BASED ON PURE COPPER BUSBARS OPERATING AT 80 DEG C IN AN AMBIENT OF 35 DEG C.

SUFFICIENT VENTILATION MUST BE PROVIDED.

UNIT RATING	PHASE	CONDUCTOR NUMBER	CONDUCTOR QUANTITY	COND. SIZE	COND. COLOUR
50Kw (260A DC)	+ - GND	9 0 3 9 0 4 GND	1 1 1	95mm2 95mm2 50mm2	BLACK BLACK GRN/YEL
100Kw (521A DC)	+ - GND	9 0 3 9 0 4 GND	2 2 1	95mm2 95mm2 95mm2	BLACK BLACK GRN/YEL
150Kw (781 A DC)	+ - GND	9 0 3 9 0 4 GND	3 3 1	95mm2 95mm2 150mm2	BLACK BLACK GRN/YEL
200Kw (1042A DC)	+ - GND	9 0 3 9 0 4 GND	3 3 1	120mm2 120mm2 185mm2	BLACK BLACK GRN/YEL
250Kw (1302A DC)	+ - GND	9 0 3 9 0 4 GND	4 4 2	120mm2 120mm2 120mm2	BLACK BLACK GRN/YEL
300Kw (1563A DC)	+ - GND	9 0 3 9 0 4 GND	4 4 2	150mm2 150mm2 150mm2	BLACK BLACK GRN/YEL
350Kw (1800A DC)	+ - GND	9 0 3 9 0 4 GND	4 4 2	185mm2 185mm2 185mm2	BLACK BLACK GRN/YEL

CONDUIT ID -	A A - B B - C D
CONDUIT No.-	0 1 - 0 2 - 5 0
SOURCE -	CUSTOMER

APPLICATION	SEE UNIT RATING
DESCRIPTION	SPECIAL HIGH POWER CABLES
FROM	WELDER DC POWER SUPPLY
TO	RF GENERATOR/OSCILLATOR

NOTES					
CABLES ON THIS PAGE ARE BASED ON COPPER UNARMoured SINGLE CORE					
CONDUCTORS ENCLOSED IN CONDUIT TO BS 6004, BS 6231, BS 6346					
AT 30 DEG C AMBIENT AND 70 DEG C CONDUCTOR TEMPERATURE.					

CONDUIT ID - A A - B B - C D				APPLICATION	SEE UNIT RATING
CONDUIT No.- 0 1 - 0 2 - 5 0				DESCRIPTION	SPECIAL HIGH POWER CABLES
SOURCE - CUSTOMER				FROM	WELDER DC POWER SUPPLY
				TO	RF GENERATOR/OSCILLATOR

UNIT RATING	PHASE	CONDUCTOR NUMBER	CONDUCTOR QUANTITY	COND. SIZE	COND. COLOUR
400Kw	+	9 0 3	4	240mm2	BLACK
(2057A DC)	-	9 0 4	4	240mm2	BLACK
	GND	GND	2	240mm2	GRN/YEL
500Kw	+	9 0 3	5	240mm2	BLACK
(2567A DC)	-	9 0 4	5	240mm2	BLACK
	GND	GND	3	240mm2	GRN/YEL
600Kw	+	9 0 3	6	240mm2	BLACK
(3091A DC)	-	9 0 4	6	240mm2	BLACK
	GND	GND	3	240mm2	GRN/YEL
800Kw	+	9 0 3	8	240mm2	BLACK
(4096A DC)	-	9 0 4	8	240mm2	BLACK
	GND	GND	4	240mm2	GRN/YEL
1000Kw	+	9 0 3	9	240mm2	BLACK
(5121A DC)	-	9 0 4	9	240mm2	BLACK
	GND	GND	5	240mm2	GRN/YEL
1200Kw	+	9 0 3	11	240mm2	BLACK
(6145A DC)	-	9 0 4	11	240mm2	BLACK
	GND	GND	6	240mm2	GRN/YEL

NOTES

CABLES ON THIS PAGE ARE BASED ON COPPER UNARMoured SINGLE CORE
 CONDUCTORS ENCLOSED IN CONDUIT TO BS 6004, BS 6231, BS 6346
 AT 30 DEG C AMBIENT AND 70 DEG C CONDUCTOR TEMPERATURE.

CONDUIT ID - A A - B B - C D				APPLICATION	ALL UNITS
CONDUIT No.- 0 1 - 0 2 - 3 0				DESCRIPTION	LOW VOLTAGE 115V OR 230V 50Hz
SOURCE - CUSTOMER				FROM	WELDER DC POWER SUPPLY
				TO	RF GENERATOR PLUG 1
CONDUCTOR DESCRIPTION 12 CONDUCTOR SCREENED CABLE					
PLUG PIN NUMBER	WIRE NUMBER	CONDUCTOR SIZE	CONDUCTOR COLOUR	COMMENTS	
1..2	6 0 0	2.5mm2			
1..1	6 0 2	2.5mm2			
1..8	6 2 1	2.5mm2		COOLING FAN POWER	
1..3	1 0 0	2.5mm2			
1..4	1 1 4	2.5mm2		(PARALLEL) ONLY ON AUTOMATCH	
1..5	1 1 5	2.5mm2		(PARALLEL) ONLY ON AUTOMATCH	
1..6	1 1 6	2.5mm2		(SERIES) ONLY ON AUTOMATCH	
1..7	1 1 7	2.5mm2		(SERIES) ONLY ON AUTOMATCH	
1..9	1 2 0	2.5mm2		(X AXIS) SINGLE AXIS TABLES ONLY	
1..10	1 2 1	2.5mm2		(X AXIS) SINGLE AXIS TABLES ONLY	
GND $\frac{\perp}{\perp}$	G N D $\frac{\perp}{\perp}$	2.5mm2	GRN/YELLOW	EARTH	

CONDUIT ID - A A - B B - C D				APPLICATION	ALL UNITS
CONDUIT No.- 0 1 - 0 2 - 2 0				DESCRIPTION	EXTRA LOW VOLTAGE 24VDC
SOURCE - CUSTOMER				FROM	WELDER DC POWER SUPPLY
				TO	RF GENERATOR PLUG 2
CONDUCTOR DESCRIPTION 16 CONDUCTOR SHIELDED CABLE					
PLUG PIN NUMBER	WIRE NUMBER	CONDUCTOR SIZE	CONDUCTOR COLOUR	COMMENTS	
2..7	0 4 0 0 7	0.75mm2		E STOP CH. 1	
2..8	4 0 0 7 A	0.75mm2		E STOP CH. 2	
2..6	0 4 0 0 8	0.75mm2		E STOP CH. 1	
2..1	4 0 0 8 A	0.75mm2		E STOP CH. 2	
2..5	0 4 0 0 9	0.75mm2		DOOR SWITCHES CH.1	
2..15	4 0 0 9 A	0.75mm2		DOOR SWITCHES CH.2	
2..4	0 4 0 1 0	0.75mm2		DOOR SWITCHES CH.1	
2..16	4 0 1 0 A	0.75mm2		DOOR SWITCHES CH.2	
2..2	0 4 0 1 4	0.75mm2		2-TS1-5	
2..3	0 4 0 1 5	0.75mm2		2-TS6-12	
2..9	0 3 0 0 2	0.75mm2		2-FLS1	
2..13	0 2 0 0 4	0.75mm2		AUTOMATCH ONLY (Lim.Sw Parallel In.)	
2..12	0 2 0 0 5	0.75mm2		AUTOMATCH ONLY (Lim.Sw ParallelOut)	
2..11	0 2 0 0 6	0.75mm2		AUTOMATCH ONLY (Lim.Sw Series In.)	
2..10	0 2 0 0 7	0.75mm2		AUTOMATCH ONLY (Lim.Sw Series Out)	
2..14	2 4 0 3	0.75mm2		24V DC SUPPLY	
GND $\frac{\perp}{\perp}$	G N D $\frac{\perp}{\perp}$	0.75mm2	GRN/YELLOW	EARTH	

CONDUIT ID - A A - B B - C D				APPLICATION	ALL UNITS
CONDUIT No.- 0 1 - 0 2 - 2 0				DESCRIPTION	EXTRA LOW VOLTAGE 24VDC
SOURCE - CUSTOMER				FROM	WELDER DC POWER SUPPLY
				TO	RF GENERATOR PLUG 3
CONDUCTOR DESCRIPTION 12 CONDUCTOR SHIELDED CABLE					
PLUG PIN NUMBER	WIRE NUMBER	CONDUCTOR SIZE	CONDUCTOR COLOUR	COMMENTS	
3..1	2 4 0 0	0.75mm2		TO 1-XHF TERM 1	
3..7	2 4 2 5	0.75mm2		TO 1-XHF TERM 3	
3..6	2 4 2 6	0.75mm2		TO 1-XHF TERM 5	
3..5	2 4 2 7	0.75mm2		TO 1-XHF TERM 7	
3..4	2 4 2 8	0.75mm2		TO 1-XHF TERM 20	
3..3	2 4 2 9	0.75mm2		TO 1-XHF TERM 10	
3..2	2 4 3 0	0.75mm2		TO 1-XHF TERM 11	
3..8	S C R N			SCREEN	
3..9				SPARE	
3..10				SPARE	
3..11				SPARE	
3..12				SPARE	
GND $\frac{\perp}{\perp}$	G N D $\frac{\perp}{\perp}$	2.5mm2	GRN/YELLOW	EARTH	

CONDUIT ID - A A - B B - C D				APPLICATION	ALL UNITS
CONDUIT No.- 0 1 - 0 2 - 1 0				DESCRIPTION	SIGNAL LEVEL (ANALOG)
SOURCE - CUSTOMER				FROM	WELDER DC POWER SUPPLY
				TO	RF GENERATOR PLUG 4
CONDUCTOR DESCRIPTION 4 CONDUCTOR SHIELDED CABLE					
PLUG PIN NUMBER	WIRE NUMBER	CONDUCTOR SIZE	CONDUCTOR COLOUR	COMMENTS	
4..3	1 0 1 3	0.5mm2	RED	TO 1-XHF TERM 13	
4..2	1 0 1 4	0.5mm2	BLUE	TO 1-XHF TERM 15	
4..1	1 0 1 5	0.5mm2	GREEN	TO 1-XHF TERM 17 & 19	
4..4	S C R N			SCREEN	
GND $\frac{\perp}{\perp}$	G N D $\frac{\perp}{\perp}$	0.5mm2	GRN/YELLOW	EARTH	

CONDUIT ID - A A - B B - C D				APPLICATION	ALL UNITS
CONDUIT No.- 0 1 - 1 7 - 1 0				DESCRIPTION	SIGNAL LEVEL (ANALOGUE)
SOURCE - THERMATOOL				FROM	WELDER DC POWER SUPPLY
				TO	MILL FIXTURE
CONDUCTOR DESCRIPTION 2 CONDUCTOR SHIELDED CABLE					
CONDUCTOR NUMBER	WIRE NUMBER	CONDUCTOR SIZE	CONDUCTOR COLOUR	COMMENTS	
1	2 4 0 0	1.5mm2		MILL SPEED TACHO +Ve	
2	1 0 1 1	1.5mm2		MILL SPEED TACHO -Ve	
SCRN	SCRN				

CONDUIT ID - A A - B B - C D				APPLICATION	ALL UNITS
CONDUIT No.- 0 1 - 0 4 - 2 0				DESCRIPTION	EXTRA LOW VOLTAGE 24VDC
SOURCE - CUSTOMER				FROM	WELDER DC POWER SUPPLY
				TO	WELDER REMOTE CONTROLS
CONDUCTOR DESCRIPTION				40 CONDUCTOR SHIELDED CABLE	
CONDUCTOR NUMBER	WIRE NUMBER	CONDUCTOR SIZE	CONDUCTOR COLOUR	COMMENTS	
1	0 2 0 0 0	0.75mm2			
2	0 2 0 0 1	0.75mm2			
3	0 2 0 0 2	0.75mm2			
4	0 2 0 0 3	0.75mm2			
5	0 2 0 0 8	0.75mm2		ONLY AUTOMATCH UNITS	
6	0 2 0 0 9	0.75mm2		ONLY AUTOMATCH UNITS	
7	0 2 0 1 0	0.75mm2		ONLY AUTOMATCH UNITS	
8	0 2 0 1 1	0.75mm2		ONLY AUTOMATCH UNITS	
9	0 2 0 1 2	0.75mm2		ONLY AUTOMATCH UNITS	
10	2 4 0 0	0.75mm2		24V DC COM	
11	2 4 0 3	0.75mm2			
12	2 4 0 6	0.75mm2		RESET	
13	2 4 0 6 A	0.75mm2		E-STOP CH.2	
14	2 4 1 1	0.75mm2		X AXIS	
15	2 4 1 2	0.75mm2		X AXIS	
16	2 4 1 3	0.75mm2		(Y AXIS) 3 AXIS TABLE ONLY	
17	2 4 1 4	0.75mm2		(Y AXIS) 3 AXIS TABLE ONLY	
18	2 4 1 5	0.75mm2		(Z AXIS) 3 AXIS TABLE ONLY	
19	2 4 1 6	0.75mm2		(Z AXIS) 3 AXIS TABLE ONLY	
20		0.75mm2		SPARE	
21	2 5 0 4	0.75mm2		RESET	
22	0 4 0 0 6	0.75mm2		E-STOP CH.2	
23	4 0 0 6 A	0.75mm2		E-STOP CH.1	
24	0 6 0 0 0	0.75mm2		PMD ONLY	
25	0 6 0 0 1	0.75mm2		PMD ONLY	
26	0 6 0 0 2	0.75mm2		PMD ONLY	
27	0 6 0 0 3	0.75mm2		PMD ONLY	
28	0 6 0 0 4	0.75mm2		PMD ONLY	
29	0 6 0 0 5	0.75mm2		PMD ONLY	
30	0 6 0 0 6	0.75mm2		PMD ONLY	
31	0 6 0 0 7	0.75mm2		PMD ONLY	
32	0 6 0 0 8	0.75mm2		PMD ONLY	
33	0 6 0 0 9	0.75mm2		PMD ONLY	
34	0 6 0 1 0	0.75mm2		PMD ONLY	
35	0 6 0 1 1	0.75mm2		PMD ONLY	
36	0 6 0 1 2	0.75mm2		PMD ONLY	
37	0 6 0 1 3	0.75mm2		"HEAT OFF" LAMP	
38	0 6 0 1 4	0.75mm2		"HEAT ON" LAMP	
39	0 6 0 1 5	0.75mm2		RESET PUSHBUTTON	
40		0.75mm2		SPARE	
SCRN	SCRN				

CONDUIT ID - A A - B B - C D				APPLICATION	ALL UNITS
CONDUIT No.- 0 1 - 1 8 - 2 0				DESCRIPTION	EXTRA LOW VOLTAGE 24VDC
SOURCE - CUSTOMER				FROM	WELDER DC POWER SUPPLY
				TO	SYSTEM CONTROL CABINET
CONDUCTOR DESCRIPTION 20 CONDUCTOR SCREENED CABLE					
CONDUCTOR NUMBER	WIRE NUMBER	CONDUCTOR SIZE	CONDUCTOR COLOUR	COMMENTS	
1	0 4 0 0 5	0.75mm2		MILL E-STOP CH.2	
2	4 0 0 5 A	0.75mm2		MILL E-STOP CH.1	
3	2 4 0 0	0.75mm2		24V DC COM	
4	2 4 0 3	0.75mm2		24V DC SUPPLY	
5	2 4 0 7	0.75mm2		MILL E-STOP CH 2	
6	0 2 0 1 3	0.75mm2		MILL INTERLOCK	
7	0 2 0 1 4	0.75mm2		MILL FAULT/READY	
8	0 2 0 1 5	0.75mm2		MILL OFF/RUN	
9	1 3 0	0.75mm2		WELDER FAULT/READY	
10	1 3 1	0.75mm2			
11	1 3 2	0.75mm2		WELD HEAT OFF/ON	
12	1 3 3	0.75mm2			
13	1 2 8	0.75mm2		WELDER E-STOP CH.1	
14	1 2 9	0.75mm2		WELDER E-STOP CH.1	
15	1 5 0	0.75mm2		WELDER E-STOP CH.2	
16	1 5 1	0.75mm2		WELDER E-STOP CH.2	
17	2 5 0 6	0.75mm2		MILL/PFC GUARD SWITCH CH 2	
18	0 4 0 1 0	0.75mm2		MILL/PFC GUARD SW. CH2 <350Kw UNITS ONLY	
18	0 7 0 0 3			MILL/PFC GUARD SW. CH 2 >400Kw UNITS WITH XFORMER CAB.ONLY	
19	2 5 0 6 A	0.75mm2		MILL/PFC GUARD SWITCH CH 1	
20	4 0 1 0 A	0.75mm1		MILL/PFC GUARD SW. CH1 <350Kw UNITS ONLY	
20	7 0 0 3 A			MILL/PFC GUARD SW. CH 1 >400Kw UNITS WITH XFORMER CAB.ONLY	
SCRN	SCRN				

CONDUIT ID - A A - B B - C D				APPLICATION	ALL UNITS
CONDUIT No.- 0 1 - 0 5 - 2 0				DESCRIPTION	EXTRA LOW VOLTAGE 24V DC
SOURCE - CUSTOMER				FROM	WELDER DC POWER SUPPLY
				TO	HEAT EXCHANGER
CONDUCTOR DESCRIPTION 2 CONDUCTOR SCREENED CABLE					
CONDUCTOR NUMBER	WIRE NUMBER	CONDUCTOR SIZE	CONDUCTOR COLOUR	COMMENTS	
1	2 4 0 3	0.75mm2		HEAT EXCHANGER	
2	3 0 0 4	0.75mm2		WATER LEVEL	
SCRN	SCRN				

CONDUIT ID - A A - B B - C D				APPLICATION	ALL UNITS
CONDUIT No.- 0 1 - 0 4 - 1 0				DESCRIPTION	SIGNAL LEVEL (ANALOG)
SOURCE - CUSTOMER				FROM	WELDER DC POWER SUPPLY
				TO	WELDER REMOTE CONTROLS
CONDUCTOR DESCRIPTION 4 x 4 CONDUCTOR SHIELDED CABLES OR 1 x 16 CONDUCTOR CABLE					
CONDUCTOR NUMBER	WIRE NUMBER	CONDUCTOR SIZE	CONDUCTOR COLOUR	COMMENTS	
1	2 4 0 0	0.5mm2	BLUE	ANALOGUE METERS	
2	1 0 0 1	0.5mm2	RED		
3	1 0 0 2	0.5mm2	GREEN		
4	1 0 0 3	0.5mm2	YELLOW	THERMAVIEW ONLY	
SCRN	SCRN				
5	2 4 0 0	0.5mm2	BLUE	WELD	
6	1 0 2 6	0.5mm2	RED	POWER	
7	1 0 2 5	0.5mm2	GREEN	POTENTIOMETER	
8		0.5mm2	YELLOW	UNUSED	
SCRN	SCRN				
9	2 4 0 0	0.5mm2	BLUE	START	
10	1 0 2 8	0.5mm2	RED	POWER	
11	1 0 2 9	0.5mm2	GREEN	POTENTIOMETER	
12		0.5mm2	YELLOW	UNUSED	
SCRN	SCRN				
13	1 0 6 5	0.5mm2	BLUE	SECOND GANG OF WELD	
14	1 0 6 6	0.5mm2	RED	POWER POT.	
15	1 0 6 7	0.5mm2	GREEN	THERMASURE UNITS ONLY.	
16		0.5mm2	YELLOW	UNUSED	
SCRN	SCRN				

CONDUIT ID - A A - B B - C D				APPLICATION	50Kw UPTO 350Kw UNITS ONLY
CONDUIT No.- 0 1 - 0 5 - 4 0				DESCRIPTION	LOW VOLTAGE POWER 400V 50Hz
SOURCE - CUSTOMER				FROM	WELDER DC POWER SUPPLY
				TO	HEAT EXCHANGER
CONDUCTOR DESCRIPTION 3 + EARTH CONDUCTOR SCREENED CABLE					
CONDUCTOR NUMBER	WIRE NUMBER	CONDUCTOR SIZE	CONDUCTOR COLOUR	COMMENTS	
1	1 T 1	2.5mm2		TO	
2	1 T 2	2.5mm2		HEAT EXCHANGER	
3	1 T 3	2.5mm2		MOTOR.(5.5Kw)	
4	GND	2.5mm2	GRN/YELLOW		

CONDUIT ID - A A - B B - C D				APPLICATION	400Kw UPTO 600Kw UNITS ONLY
CONDUIT No.- 0 1 - 0 5 - 4 0				DESCRIPTION	LOW VOLTAGE POWER 400V 50Hz
SOURCE - CUSTOMER				FROM	WELDER DC POWER SUPPLY
				TO	HEAT EXCHANGER
CONDUCTOR DESCRIPTION 3 + EARTH CONDUCTOR CABLE					
CONDUCTOR NUMBER	WIRE NUMBER	CONDUCTOR SIZE	CONDUCTOR COLOUR	COMMENTS	
1	1 T 1	4mm2		TO	
2	1 T 2	4mm2		HEAT EXCHANGER	
3	1 T 3	4mm2		MOTOR. (7.5Kw)	
4	GND	4mm2	GRN/YELLOW		

CONDUIT ID - A A - B B - C D				APPLICATION	800Kw AND ABOVE ONLY
CONDUIT No.- 0 1 - 0 5 - 4 0				DESCRIPTION	LOW VOLTAGE POWER 400V 50Hz
SOURCE - CUSTOMER				FROM	WELDER DC POWER SUPPLY
				TO	HEAT EXCHANGER
CONDUCTOR DESCRIPTION 3 + EARTH CONDUCTOR CABLE					
CONDUCTOR NUMBER	WIRE NUMBER	CONDUCTOR SIZE	CONDUCTOR COLOUR	COMMENTS	
1	1 T 1	16mm2		TO	
2	1 T 2	16mm2		HEAT EXCHANGER	
3	1 T 3	16mm2		MOTOR (22Kw)	
4	GND	10mm2	GRN/YELLOW		

				APPLICATION	ONLY UNITS 400Kw AND ABOVE
CONDUIT ID - A A - B B - C D				DESCRIPTION	LOW VOLTAGE 115V OR 230V 50Hz
CONDUIT No.- 2 1 - 0 1 - 4 0				FROM	TRANSFORMER CABINET
SOURCE - CUSTOMER				TO	WELDER DC POWER SUPPLY
CONDUCTOR DESCRIPTION 2 CONDUCTOR SCREENED CABLE					
CONDUCTOR NUMBER	WIRE NUMBER	CONDUCTOR SIZE	CONDUCTOR COLOUR	COMMENTS	
1	1 0 9	1.5mm2		DC & CONTROL	
2	1 4 1	1.5mm2		CABINET LIGHTING	
SCRN	SCRN				

				APPLICATION	ONLY UNITS 400kW & ABOVE
CONDUIT ID - A A - B B - C D				DESCRIPTION	LOW VOLTAGE 115V OR 230V 50Hz
CONDUIT No.- 2 1 - 0 1 - 3 0				FROM	TRANSFORMER CABINET
SOURCE - CUSTOMER				TO	WELDER DC POWER SUPPLY
CONDUCTOR DESCRIPTION 6 CONDUCTOR SCREENED CABLE					
CONDUCTOR NUMBER	WIRE NUMBER	CONDUCTOR SIZE	CONDUCTOR COLOUR	COMMENTS	
1	1 0 0	1.5mm2		AC COMMON	
2	1 0 2	1.5mm2		AC SUPPLY	
3	1 0 4	1.5mm2		CB MOTOR	
4	1 0 5	1.5mm2		CB CLOSE COIL	
5	1 0 6	1.5mm2		CB OPEN COIL	
6	1 0 8	1.5mm2		CB UV RELEASE	
SCRN	SCRN				

				APPLICATION	ONLY UNITS 400Kw AND ABOVE
CONDUIT ID - A A - B B - C D				DESCRIPTION	EXTRA LOW VOLTAGE 24VDC
CONDUIT No.- 2 1 - 0 1 - 2 0				FROM	TRANSFORMER CABINET
SOURCE - CUSTOMER				TO	WELDER DC POWER SUPPLY
CONDUCTOR DESCRIPTION 20 CONDUCTOR SCREENED CABLE					
CONDUCTOR NUMBER	WIRE NUMBER	CONDUCTOR SIZE	CONDUCTOR COLOUR	COMMENTS	
1	0 4 0 0 8	0.75mm2		E-STOP CH.1	
2	4 0 0 8 A	0.75mm2		E-STOP CH.2	
3	0 4 0 1 0	0.75mm2		DOOR SWITCH CH.1	
4	4 0 1 0 A	0.75mm2		DOOR SWITCH CH.2	
5	0 3 0 0 7	0.75mm2		MAIN CIRCUIT BREAKER CLOSED	
6	2 4 0 3	0.75mm2		+24VDC	
7	2 4 0 5	0.75mm2			
8	0 7 0 0 0	0.75mm2			
9	0 7 0 0 1	0.75mm2			
10	0 7 0 0 2	0.75mm2			
11	0 7 0 0 3	0.75mm2		DOOR SWITCH CH.1	
12	7 0 0 3 A	0.75mm2		DOOR SWITCH CH.2	
13	0 7 0 0 4	0.75mm2		E-STOP CH.1	
14	7 0 0 4 A	0.75mm2		E-STOP CH.2	
15	0 7 0 0 5	0.75mm2			
16	0 7 0 0 6	0.75mm2			
17	2 4 0 0	0.75mm2			
18		0.75mm2		UNUSED	
19		0.75mm2		UNUSED	
20		0.75mm2		UNUSED	
SCRN	SCRN				

				APPLICATION	ONLY UNITS 400 TO 600Kw
CONDUIT ID - A A - B B - C D				DESCRIPTION	LOW VOLTAGE POWER 400V 50Hz
CONDUIT No.- 2 1 - 0 1 - 4 0				FROM	TRANSFORMER CABINET
SOURCE - CUSTOMER				TO	WELDER DC POWER SUPPLY
CONDUCTOR DESCRIPTION 3 CONDUCTOR ARMoured CABLE					
CONDUCTOR NUMBER	WIRE NUMBER	CONDUCTOR SIZE	CONDUCTOR COLOUR	COMMENTS	
1	4 L 1	16mm2		400V CONTROL SUPPLY	
2	4 L 2	16mm2		400V CONTROL SUPPLY	
3	4 L 3	16mm2		400V CONTROL SUPPLY	
SCRN	SCRN				

CONDUIT ID - A A - B B - C D				APPLICATION	3 AXIS TABLE ONLY
CONDUIT No.- 0 1 - 0 6 - 4 0				DESCRIPTION	LOW VOLTAGE POWER 400V 50Hz
SOURCE - CUSTOMER				FROM	WELDER DC POWER SUPPLY
				TO	WELD TABLE
CONDUCTOR DESCRIPTION 3 + EARTH CONDUCTOR SCREENED CABLE					
CONDUCTOR NUMBER	WIRE NUMBER	CONDUCTOR SIZE	CONDUCTOR COLOUR	COMMENTS	
1	6 T 1	1.5mm2		TO	
2	6 T 2	1.5mm2		Z AXIS	
3	6 T 3	1.5mm2		MOTOR.	
4	GND	1.5mm2	GRN/YELLOW		

CONDUIT ID - A A - B B - C D				APPLICATION	3 AXIS TABLES ONLY
CONDUIT No.- 0 1 - 0 6 - 2 0				DESCRIPTION	EXTRA LOW VOLTAGE 24VDC
SOURCE - CUSTOMER				FROM	WELDER DC POWER SUPPLY
				TO	WELD TABLE
CONDUCTOR DESCRIPTION 3 CONDUCTOR SCREENED CABLE					
CONDUCTOR NUMBER	WIRE NUMBER	CONDUCTOR SIZE	CONDUCTOR COLOUR	COMMENTS	
1	2 4 4 5	1.5mm2		Z AXIS LIMIT SWITCHES	
2	2 5 0 0	1.5mm2		LIMIT UP	
3	2 5 0 1	1.5mm2		LIMIT DOWN	
SCRN	SCRN				

				APPLICATION	3 AXIS TABLE ONLY
CONDUIT ID - A A - B B - C D				DESCRIPTION	LOW VOLTAGE 115V OR 230V 50Hz
CONDUIT No.- O 1 - 0 6 - 3 0				FROM	WELDER DC POWER SUPPLY
SOURCE - CUSTOMER				TO	WELD TABLE
CONDUCTOR DESCRIPTION 10 CONDUCTOR SCREENED CABLE					
CONDUCTOR NUMBER	WIRE NUMBER	CONDUCTOR SIZE	CONDUCTOR COLOUR	COMMENTS	
1	1 0 0	1.5mm2		Y AXIS MOTOR (NEUTRAL)	
2	1 2 2 A	1.5mm2		Y AXIS MOTOR (BRAKE)	
3	1 2 3	1.5mm2		Y AXIS MOTOR (FORWARD)	
4	1 2 4	1.5mm2		Y AXIS MOTOR (REVERSE) BRAKE	
5	1 2 2	1.5mm2		Y AXIS LIMIT (COMMON SUPPLY)	
6	1 2 3 B	1.5mm2		Y AXIS LIMIT (FORWARD)	
7	1 2 4 B	1.5mm2		Y AXIS LIMIT (REVERSE)	
8	1 2 0	1.5mm2		X AXIS MOTOR	
9	1 2 1	1.5mm2		X AXIS MOTOR	
SCRN	SCRN				

				APPLICATION	ONLY WITH PNEUMATIC CLAMP
CONDUIT ID - A A - B B - C D				DESCRIPTION	EXTRA LOW VOLTAGE 24V DC
CONDUIT No.- O 1 - 1 7 - 2 0				FROM	WELDER DC POWER SUPPLY
SOURCE - CUSTOMER				TO	SYSTEM MILL FIXTURE
CONDUCTOR DESCRIPTION 2 CONDUCTOR SCREENED CABLE					
CONDUCTOR NUMBER	WIRE NUMBER	CONDUCTOR SIZE	CONDUCTOR COLOUR	COMMENTS	
1	2 4 0 3	0.5mm2		COIL CLAMP	
2	7 0 0 7	0.5mm2		AIR PRESSURE SWITCH	
SCRN	SCRN				

				APPLICATION	THERMASURE SYSTEMS ONLY
CONDUIT ID - A A - B B - C D				DESCRIPTION	LOW VOLTAGE 115V OR 230V 50Hz
CONDUIT No.- 1 - 0 8 - 3 0				FROM	WELDER DC POWER SUPPLY
SOURCE - CUSTOMER				TO	THERMASURE OPERATOR PANEL
CONDUCTOR DESCRIPTION 3 CONDUCTOR SCREENED CABLE					
CONDUCTOR NUMBER	WIRE NUMBER	CONDUCTOR SIZE	CONDUCTOR COLOUR	COMMENTS	
1	3 5 9	1mm2			
2	3 6 0	1mm2			
3	3 6 1	1mm2			
SCRN	SCRN				

				APPLICATION	THERMASURE SYSTEMS ONLY
CONDUIT ID - A A - B B - C D				DESCRIPTION	SIGNAL LEVEL (ANALOGUE)
CONDUIT No.- O 1 - 0 8 - 1 0				FROM	WELDER DC POWER SUPPLY
SOURCE - CUSTOMER				TO	THERMASURE OPERATOR PANEL
CONDUCTOR DESCRIPTION 4 CONDUCTOR SCREENED CABLE					
CONDUCTOR NUMBER	WIRE NUMBER	CONDUCTOR SIZE	CONDUCTOR COLOUR	COMMENTS	
1	3 6 3	1mm2			
2	3 6 4	1mm2			
3	3 6 5	1mm2			
4	3 6 6	1mm2			
SCRN	SCRN				

CONDUIT ID - A A - B B - C D				APPLICATION	THERMASURE SYTEMS ONLY
CONDUIT No.- O 1 - 0 9 - 1 0				DESCRIPTION	SIGNAL LEVEL (ANALOGUE)
SOURCE - CUSTOMER				FROM	WELDER DC POWER SUPPLY
				TO	THERMASURE CHART RECORDER
CONDUCTOR DESCRIPTION 4 CONDUCTOR SHIELDED CABLE					
CONDUCTOR NUMBER	WIRE NUMBER	CONDUCTOR SIZE	CONDUCTOR COLOUR	COMMENTS	
1	3 6 8	1mm2		CHART RECORDER ANALOGUE SIGNALS	
2	3 6 9	1mm2			
3	3 7 0	1mm2			
4	3 7 1	1mm2			
SCRN	SCRN				

CONDUIT ID - A A - B B - C D				APPLICATION	THERMASURE SYSTEMS ONLY
CONDUIT No.- O 1 - 0 9 - 3 0				DESCRIPTION	LOW VOLTAGE 115V OR 230V 50Hz
SOURCE - CUSTOMER				FROM	WELDER DC POWER SUPPLY
				TO	THERMASURE CHART RECORDER
CONDUCTOR DESCRIPTION 2 CONDUCTOR SCREENED CABLE					
CONDUCTOR NUMBER	WIRE NUMBER	CONDUCTOR SIZE	CONDUCTOR COLOUR	COMMENTS	
1	3 5 9	1mm2		POWER SUPPLY	
2	3 6 0	1mm2			
SCRN	SCRN				

CONDUIT ID - A A - B B - C D				APPLICATION	THERMASURE SYSTEMS ONLY
CONDUIT No.- O 1 - 0 9 - 2 0				DESCRIPTION	EXTRA LOW VOLTAGE 24VDC
SOURCE - CUSTOMER				FROM	WELDER DC POWER SUPPLY
				TO	THERMASURE CHART RECORDER
CONDUCTOR DESCRIPTION 2 CONDUCTOR SCREENED CABLE					
CONDUCTOR NUMBER	WIRE NUMBER	CONDUCTOR SIZE	CONDUCTOR COLOUR	COMMENTS	
1	3 2 0	1mm2		PAPER ADVANCE	
2	3 2 1	1mm2			
SCRN	SCRN				

CONDUIT ID - A A - B B - C D				APPLICATION	IRCON THERMASURE SYTEMS ONLY
CONDUIT No.- O 1 - 1 0 - 1 0				DESCRIPTION	SIGNAL LEVEL (ANALOGUE)
SOURCE - THERMATOOL				FROM	WELDER DC POWER SUPPLY
				TO	PYROMETER SENSING HEAD
CONDUCTOR DESCRIPTION 8 CONDUCTOR SHIELDED CABLE					
CONDUCTOR NUMBER	WIRE NUMBER	CONDUCTOR SIZE	CONDUCTOR COLOUR	COMMENTS	
1	3 7 5	SCRN	SCREEN		
2	3 7 6	1mm2	RED		
3	3 7 7	1mm2	BLACK		
4	3 7 8	1mm2	GREEN		
5	3 7 9	1mm2	ORANGE		
6	3 8 0	1mm2	VIOLET		
7	3 8 1	1mm2	BROWN		
8	3 8 2	1mm2	BLUE		

CONDUIT ID - A A - B B - C D				APPLICATION	THERMASURE SYSTEMS ONLY
CONDUIT No.- O 1 - 1 8 - 1 0				DESCRIPTION	SIGNAL LEVEL (ANALOGUE)
SOURCE - CUSTOMER				FROM	WELDER DC POWER SUPPLY
				TO	SYSTEM CONTROL CABINET
CONDUCTOR DESCRIPTION 2 CONDUCTOR SCREENED CABLE					
CONDUCTOR NUMBER	WIRE NUMBER	CONDUCTOR SIZE	CONDUCTOR COLOUR	COMMENTS	
1	3 7 2	1mm2		OPTIONAL 0 - 7V ANALOGUE SIGNAL	
2	3 7 3	1mm2			
SCRN	SCRN				

CONDUIT ID - A A - B B - C D				APPLICATION	WILLIAMSON THERMASURE SYTEMS ONLY
CONDUIT No.- 1 2 - 1 0 - 1 0				DESCRIPTION	SIGNAL LEVEL (ANALOGUE)
SOURCE - THERMATOOL				FROM	TEMPERATURE DISPLAY UNIT
				TO	PYROMETER SENSING HEAD
CONDUCTOR DESCRIPTION 6 CONDUCTOR SHIELDED CABLE					
CONDUCTOR NUMBER	WIRE NUMBER	CONDUCTOR SIZE	CONDUCTOR COLOUR	COMMENTS	
SCRN		SCRN	SCREEN	To Terminal 4 of Temp. Display Unit	
1		1mm2	RED	To Terminal 1 of Temp. Display Unit	
2		1mm2	BLACK	To Terminal 4 of Temp. Display Unit	
3		1mm2	GREEN	To Terminal 3 of Temp. Display Unit	
4		1mm2	ORANGE	To Terminal 6 of Temp. Display Unit	
5		1mm2	WHITE	To Terminal 2 of Temp. Display Unit	
6		1mm2	BLUE	To Terminal 5 of Temp. Display Unit	

				APPLICATION	WILLIAMSON THERMASURE SYTEMS ONLY
CONDUIT ID - A A - B B - C D				DESCRIPTION	SIGNAL LEVEL (ANALOGUE)
CONDUIT No.- O 1 - 1 3 - 1 0				FROM	WELDER DC POWER SUPPLY
SOURCE - THERMATOOL				TO	SIL - SIGNAL ISOLATOR/CONVERTER
CONDUCTOR DESCRIPTION 2 CONDUCTOR SHIELDED CABLE					
CONDUCTOR NUMBER	WIRE NUMBER	CONDUCTOR SIZE	CONDUCTOR COLOUR	COMMENTS	
SCRN		SCRN	SCREEN		
1	3 7 6	1mm2	RED	To Terminal 5 of SIL	
2	3 7 7	1mm2	BLACK	To Terminal 4 of SIL	

				APPLICATION	WILLIAMSON THERMASURE SYTEMS ONLY
CONDUIT ID - A A - B B - C D				DESCRIPTION	SIGNAL LEVEL (ANALOGUE)
CONDUIT No.- 1 2 - 1 3 - 1 0				FROM	TEMPERATURE DISPLAY UNIT
SOURCE - THERMATOOL				TO	SIL - SIGNAL ISOLATOR/CONVERTER
CONDUCTOR DESCRIPTION 2 CONDUCTOR SHIELDED CABLE					
CONDUCTOR NUMBER	WIRE NUMBER	CONDUCTOR SIZE	CONDUCTOR COLOUR	COMMENTS	
SCRN		SCRN	SCREEN	No Connection	
1	3 7 6 A	1mm2	RED	From Terminal 8, SIL to Terminal 24 Temp. Display Unit	
2	3 7 7 A	1mm2	BLACK	From Terminal 7, SIL to Terminal 25 Temp. Display Unit	

				APPLICATION	THERMASURE SYSTEMS ONLY
CONDUIT ID - A A - B B - C D				DESCRIPTION	LOW VOLTAGE 115V OR 230V 50Hz
CONDUIT No.- O 1 - 1 2 - 3 0				FROM	WELDER DC POWER SUPPLY
SOURCE - CUSTOMER				TO	TEMPERATURE DISPLAY UNIT
CONDUCTOR DESCRIPTION 2 CONDUCTOR SCREENED CABLE					
CONDUCTOR NUMBER	WIRE NUMBER	CONDUCTOR SIZE	CONDUCTOR COLOUR	COMMENTS	
1	3 5 9	1mm2		To Terminal 15 of Temp. Display Unit	
2	3 6 0	1mm2		To Terminal 14 of Temp. Display Unit	
3	GND	1mm2		To Terminal 13 of Temp. Display Unit	
SCRN	SCRN			No Connection	

CONDUIT ID - A A - B B - C D				APPLICATION	THERMASURE SYSTEMS ONLY
CONDUIT No. - 0 1 - 1 3 - 3 0				DESCRIPTION	LOW VOLTAGE 115V OR 230V 50Hz
SOURCE - CUSTOMER				FROM	WELDER DC POWER SUPPLY
				TO	SIL - SIGNAL ISOLATOR/CONVERTER
CONDUCTOR DESCRIPTION 2 CONDUCTOR SCREENED CABLE					
CONDUCTOR NUMBER	WIRE NUMBER	CONDUCTOR SIZE	CONDUCTOR COLOUR	COMMENTS	
1	3 5 9	1mm2		To Terminal 1 of SIL	
2	3 6 0	1mm2		To Terminal 2 of SIL	
SCRN	SCRN				

CONDUIT ID - A A - B B - C D				APPLICATION	CONTACT WELDERS ONLY
CONDUIT No. - 0 1 - 0 6 - 2 0				DESCRIPTION	24VDC PNEU.CONTROLS + H2O FLO
SOURCE - CUSTOMER				FROM	WELDER DC POWER SUPPLY
				TO	PNEUMATIC CONTROL PANEL
CONDUCTOR DESCRIPTION 20 CONDUCTOR + EARTH SHIELDED CABLE					
CONDUCTOR NUMBER	WIRE NUMBER	CONDUCTOR SIZE	CONDUCTOR COLOUR	COMMENTS	
1	2 4 0 0	0.75MM2		24VDC COMMON (2 TERMS)	
2	2 4 0 3	0.75MM2		24VDC +ve (5TERMS)	
3	2 4 5 9	0.75MM2		X / Y AXIS LOCK	
4	2 4 6 0	0.75MM2		CONTACTS FITTED LIMIT SW (2TERM)	
5	0 5 0 0 5	0.75MM2		COIL CLAMP RELEASE	
6	0 5 0 0 6	0.75MM2		CONTACTS APPLY	
7	0 5 0 0 7	0.75MM2		CONTACTS RETRACT	
8	0 5 0 0 9	0.75MM2		PNEUMATICS SOFT START	
9	0 8 0 0 0	0.75MM2		SYSTEM AIR PRESURE SWITCH	
10	0 8 0 0 1	0.75MM2		X / Y AXIS LOCK PRESSURE SWITCH	
11	0 8 0 0 2	0.75MM2		CONTACTS APPLY PRESSURE SW.	
12	0 8 0 0 3	0.75MM2		CONTACTS RETRACT PRESSURE SW	
13	0 8 0 0 4	0.75MM2		COIL CLAMP PRESSURE SWITCH	
14	0 8 0 0 5	0.75MM2		CONTACT COOLANT FLOW SWITCH	
15	0 8 0 0 8	0.75MM2		CONTACT / INDUCTION SELECT	
16	0 8 0 0 9	0.75MM2		CONTACTS APPLY	
17	0 8 0 1 0	0.75MM2		CONTACTS RETRACT	
18	0 8 0 1 1	0.75MM3		COIL CLAMP OPEN/CLOSE	
19		0.75MM2		SPARE	
20		0.75MM2		SPARE	
GND	$\frac{\perp}{\perp}$	G N D $\frac{\perp}{\perp}$	GRN/YELLOW	EARTH (5 TERMS)	
SCRN	SCRN				

UNIT RATING	PHASE	CONDUCTOR NUMBER	CONDUCTOR QUANTITY	COND. SIZE	COND. COLOUR
125KVA (195A) (150kW MCH)	R S T GND	L1 L2 L3 GND	1 1 1 1	95mm ² 95mm ² 95mm ² 50mm ²	BLACK BLACK BLACK GRN/YEL
150KVA (230A) (200kW MCH)	R S T GND	L1 L2 L3 GND	1 1 1 1	120mm ² 120mm ² 120mm ² 70mm ²	BLACK BLACK BLACK GRN/YEL
275KVA (420A) (350kW MCH)	R S T GND	L1 L2 L3 GND	2 2 2 1	95mm ² 95mm ² 95mm ² 95mm ²	BLACK BLACK BLACK GRN/YEL
400KVA (600A) (600kW MCH)	R S T GND	L1 L2 L3 GND	2 2 2 1	120mm ² 120mm ² 120mm ² 120mm ²	BLACK BLACK BLACK GRN/YEL
328KVA (500A) (800kW MCH + ALGORITHM)	R S T GND	L1 L2 L3 GND	2 2 2 1	120mm ² 120mm ² 120mm ² 120mm ²	BLACK BLACK BLACK GRN/YEL
410KVA (600A) (1MW MCH + ALGORITHM)	R S T GND	L1 L2 L3 GND	2 2 2 1	120mm ² 120mm ² 120mm ² 120mm ²	BLACK BLACK BLACK GRN/YEL

CONDUIT ID - A A - B B - C D	CONDUIT No. - 2 1 - 3 1 - 4 0	SOURCE - CUSTOMER
------------------------------	-------------------------------	-------------------

APPLICATION	SEE UNIT RATING
DESCRIPTION	LOW VOLTAGE 400V 50Hz
FROM	TRANSFORMER CABINET
TO	POWER FACTOR CORRECTION

NOTES					
CABLES ON THIS PAGE ARE BASED ON COPPER UNARMoured SINGLE CORE					
CONDUCTORS ENCLOSED IN CONDUIT TO BS 6004, BS 6231, BS 6346					
AT 30 DEG C AMBIENT AND 70 DEG C CONDUCTOR TEMPERATURE.					

CONDUCTOR NUMBER	WIRE NUMBER	CONDUCTOR SIZE	CONDUCTOR COLOUR	COMMENTS
1	L 0	2.5mm ²		CURRENT TRANSFORMER
2	K 0	2.5mm ²		CURRENT TRANSFORMER
SCRN	SCRN			

CONDUIT ID - A A - B B - C D	CONDUIT No. - 2 1 - 3 1 - 1 0	SOURCE - CUSTOMER
------------------------------	-------------------------------	-------------------

APPLICATION	ONLY WHERE PFC FITTED
DESCRIPTION	SIGNAL LEVEL (ANALOGUE)
FROM	TRANSFORMER CABINET
TO	POWER FACTOR CORRECTION

CONDUCTOR DESCRIPTION	2 CONDUCTOR SHIELDED CABLE
-----------------------	----------------------------

CONDUIT ID - A A - B B - C D		APPLICATION	ONLY WHERE PFC FITTED	
CONDUIT No.- 0 1 - 3 1 - 2 0		DESCRIPTION	EXTRA LOW VOLTAGE 24VDC	
SOURCE - CUSTOMER		FROM	WELDER DC POWER SUPPLY	
		TO	POWER FACTOR CORRECTION	
CONDUCTOR DESCRIPTION 4 CONDUCTOR SCREENED CABLE				
CONDUCTOR NUMBER	WIRE NUMBER	CONDUCTOR SIZE	CONDUCTOR COLOUR	COMMENTS
1	2 5 0 6	0.5mm2		PFC DOOR SW.SERIES WITH MILL GUARD SW
2	2 5 0 6 A	0.5mm2		PFC DOOR SW.SERIES WITH MILL GUARD SW
2	0 4 0 1 0	0.5mm2		PFC DOOR SW.SERIES WITH MILL GUARD SW
2	4 0 1 0 A	0.5mm2		PFC DOOR SW.SERIES WITH MILL GUARD SW
SCRN	SCRN			

XS0051

Thermatool Wiring Colours


Sheet 1 – *Control Sheet*

Sheet 2 – *Thermatool Wiring Colours*

Wiring Colours. (“Generally” According to EN60204)

Type of Circuit / Conductor	Colour	Description
PE Earth (Phase Earth)	Green/Yellow	Incoming Earth, Connection point should be denoted as PE by suitable marking (See also EN60204 for “minimum” conductor size)
Power Circuits AC & DC	Black	Incoming 3 Phase/ Wiring to Motors/ 2 Phases to Transformers)
AC Control Circuits Line	Red	Live of a Live and Neutral Supply/ Control Circuits/ Single phase Motors/ All wiring on Secondary side of Isolating Transformers
AC Control Circuits Neutral	White	Secondary side of Isolating Transformers (After being taken to ground)
Neutral Conductor	Light Blue	Incoming Neutral Conductor Only (Supply to a panel), Not generally required, Should never be grounded within a panel!
Earth	Green/Yellow	General earth cables through out panel
DC Control Circuits	Dark Blue	General Control Circuits
DC Control Circuits Neutral	White	Secondary side of Isolating Transformers/Power Supply’s (After being taken to ground)
Interlock Control Circuits (Foreign Voltages from External Power sources)	Orange	Any wiring to Volt free contacts, Or where an external source will be used to provide switching voltages.
Analogue Signals +ve Screened Grey Outer	Red	Positive
Analogue Signals -ve Screened Grey Outer	Blue	Negative
Screen	Green/Yellow Sleeve	Screen wires

Title	WIRING COLOURS	Dwg No.	XS0051	Rev.	A
-------	----------------	---------	--------	------	---

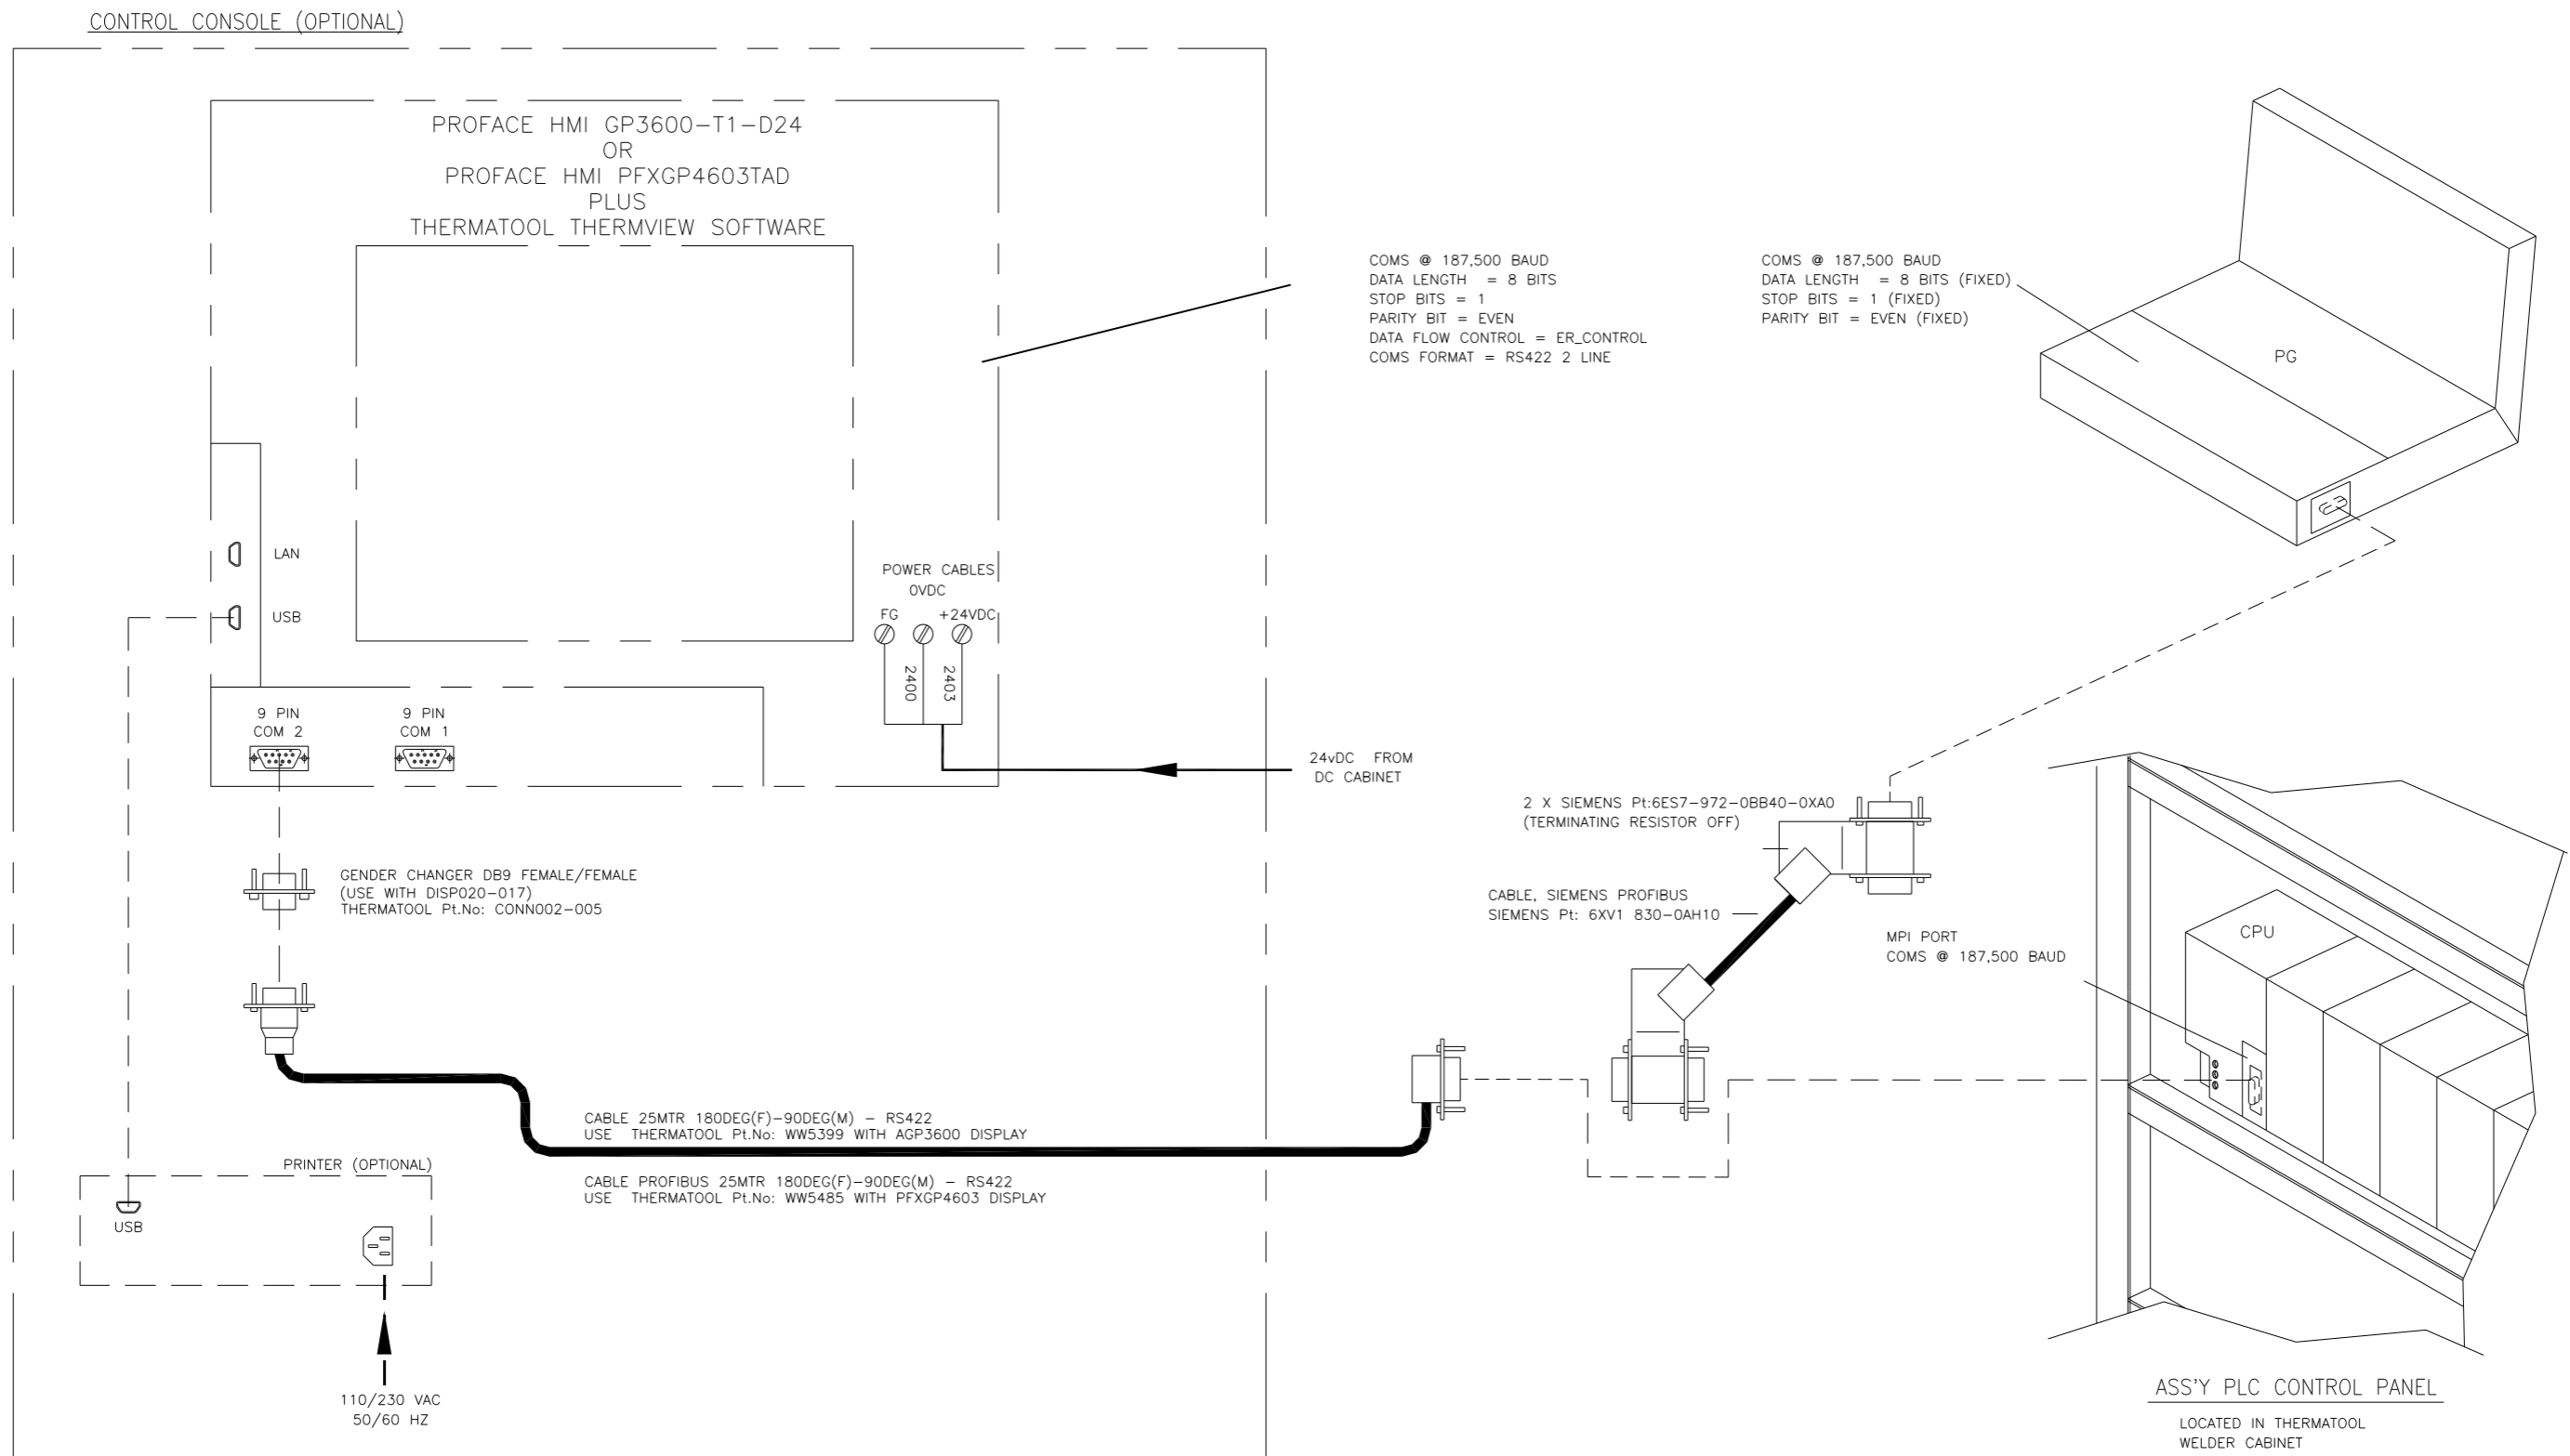

COMS @ 187,500 BAUD
 DATA LENGTH = 8 BITS
 STOP BITS = 1
 PARITY BIT = EVEN
 DATA FLOW CONTROL = ER_CONTROL
 COMS FORMAT = RS422 2 LINE

COMS @ 187,500 BAUD
 DATA LENGTH = 8 BITS (FIXED)
 STOP BITS = 1 (FIXED)
 PARITY BIT = EVEN (FIXED)

24vDC FROM DC CABINET

2 X SIEMENS Pt:6ES7-972-0BB40-0XA0 (TERMINATING RESISTOR OFF)

CABLE, SIEMENS PROFIBUS SIEMENS Pt: 6XV1 830-0AH10

MPI PORT COMS @ 187,500 BAUD

CABLE 25MTR 180DEG(F)-90DEG(M) - RS422 USE THERMATOOL Pt.No: WW5399 WITH AGP3600 DISPLAY

CABLE PROFIBUS 25MTR 180DEG(F)-90DEG(M) - RS422 USE THERMATOOL Pt.No: WW5485 WITH PFXGP4603 DISPLAY

110/230 VAC 50/60 HZ

ASS'Y PLC CONTROL PANEL
 LOCATED IN THERMATOOL WELDER CABINET

- NOTE:
1. ALL WIRING PROVIDED BY THERMATOOL/ INSTALLED BY CUSTOMER EXCEPT AS NOTED.
 2. ALL WIRING TO BE INSTALLED IN ACCORDANCE WITH NAT. ELEC. CODE EN 60204 AND / OR ALL APPLICABLE CODES.
 3. ALL CONDUITS AND WIRES SHOULD BE KEPT SEPARATE FROM AC POWER SOURCES AND WIRES.
 4. MAXIMUM CABLE LENGTH IS 50M WITHOUT REPEATER

REV	ECN	DESCRIPTION	ZONE	DWN	CHK	APPD	DATE
0	-	FIRST ISSUE (CC: WW0326)	-	TAT	-	-	13/10/10
1	13008	ADD VARIANTS HMI GP4600 / COMS CABLE WW5485	-	TAT	-	-	13/10/10

NEWELCO BANYARD THERMATOOL RADYNE

WARNING
 FAILURE TO USE INDUCTOTHERM HEATING & WELDING LTD APPROVED COMPONENTS MAY PRESENT A SAFETY HAZARD TO PERSONNEL MAY CAUSE SERIOUS DAMAGE TO THE EQUIPMENT AND WILL INVALIDATE ALL WARRANTIES.
 THIS DRAWING WAS SUPPLIED AS PART OF THE ORIGINAL EQUIPMENT OR INSTALLATION. IF IT IS BEING USED OR SUPPLIED AFTER THIS DATE, THEN IT SHOULD ONLY BE USED FOR INFORMATION PURPOSES AND SHOULD NOT BE RELIED UPON AS ALTERATIONS AND MODIFICATIONS IN THE EQUIPMENT DESIGN OR INSTALLATION MAY HAVE BEEN MADE AND AS A CONSEQUENCE MAY NOT BE DEPICTED ON THIS DRAWING.

THIS DOCUMENT IS THE PROPERTY OF INDUCTOTHERM HEATING & WELDING LTD AND IS SUBMITTED FOR USE ONLY WITH WORK PROPOSED OR AUTHORISED BY THIS COMPANY.
 IT SHOULD NOT BE USED OR DUPLICATED FOR ANY OTHER PURPOSE AND IS TO BE RETURNED TO INDUCTOTHERM HEATING & WELDING LTD WHEN NO LONGER REQUIRED FOR SUCH PURPOSES.
 BUYER OR SELLER HEREBY ACKNOWLEDGES THAT THERE MAY BE ERRORS OR OMISSIONS IN THIS DOCUMENT AND THAT INDUCTOTHERM HEATING & WELDING LTD SHALL NOT BE LIABLE IN ANY MANNER FOR SUCH ERRORS OR OMISSIONS.

PROJECT TITLE
 INTRCNCT HMI - PLC TV2
 PROFACE AGP3600/GP4603
 SIEMENS S7-300 PLC (MPI)


CIRCUIT STANDARDS ETC.

INDUCTOTHERM HEATING & WELDING An Inductotherm Group Company

SIZE A2
 DRAWN BY TT
 DATE 13/10/2010
 DWG.No. WW5400

W/O No. -
 SHEET No. 1 OF 1
 REV 1

REVISIONS									
REV	ECR	DESCRIPTION	ZONE	DWN	CHK	APPD	MM/DD/YY		
A		INFO ADDED		MWT					
B		STRAINER ADDED		MWT			5/98		
C	00149	CUSTOMER OPTION DELETED		SAF			12/00		
D	01257	'28°C MAX.' NOTE ADDED	D9	AJH			6/11/01		
E	01302	NEW HEAT EXCHANGER ASSY - VIEW CHANGE	D10	AJH			10/12/01		
F	02049	Y STRAINER ABS WAS BRONZE - VIEW CHANGE	D7	BWH			25FEB02		
G	02029	PLINTH VIEW & FLANGE NOTE CHANGED		BWH			11SEP02		
H	08083	REFERENCE TO WDO170 DELETED	A9	BWH			22MAY08		

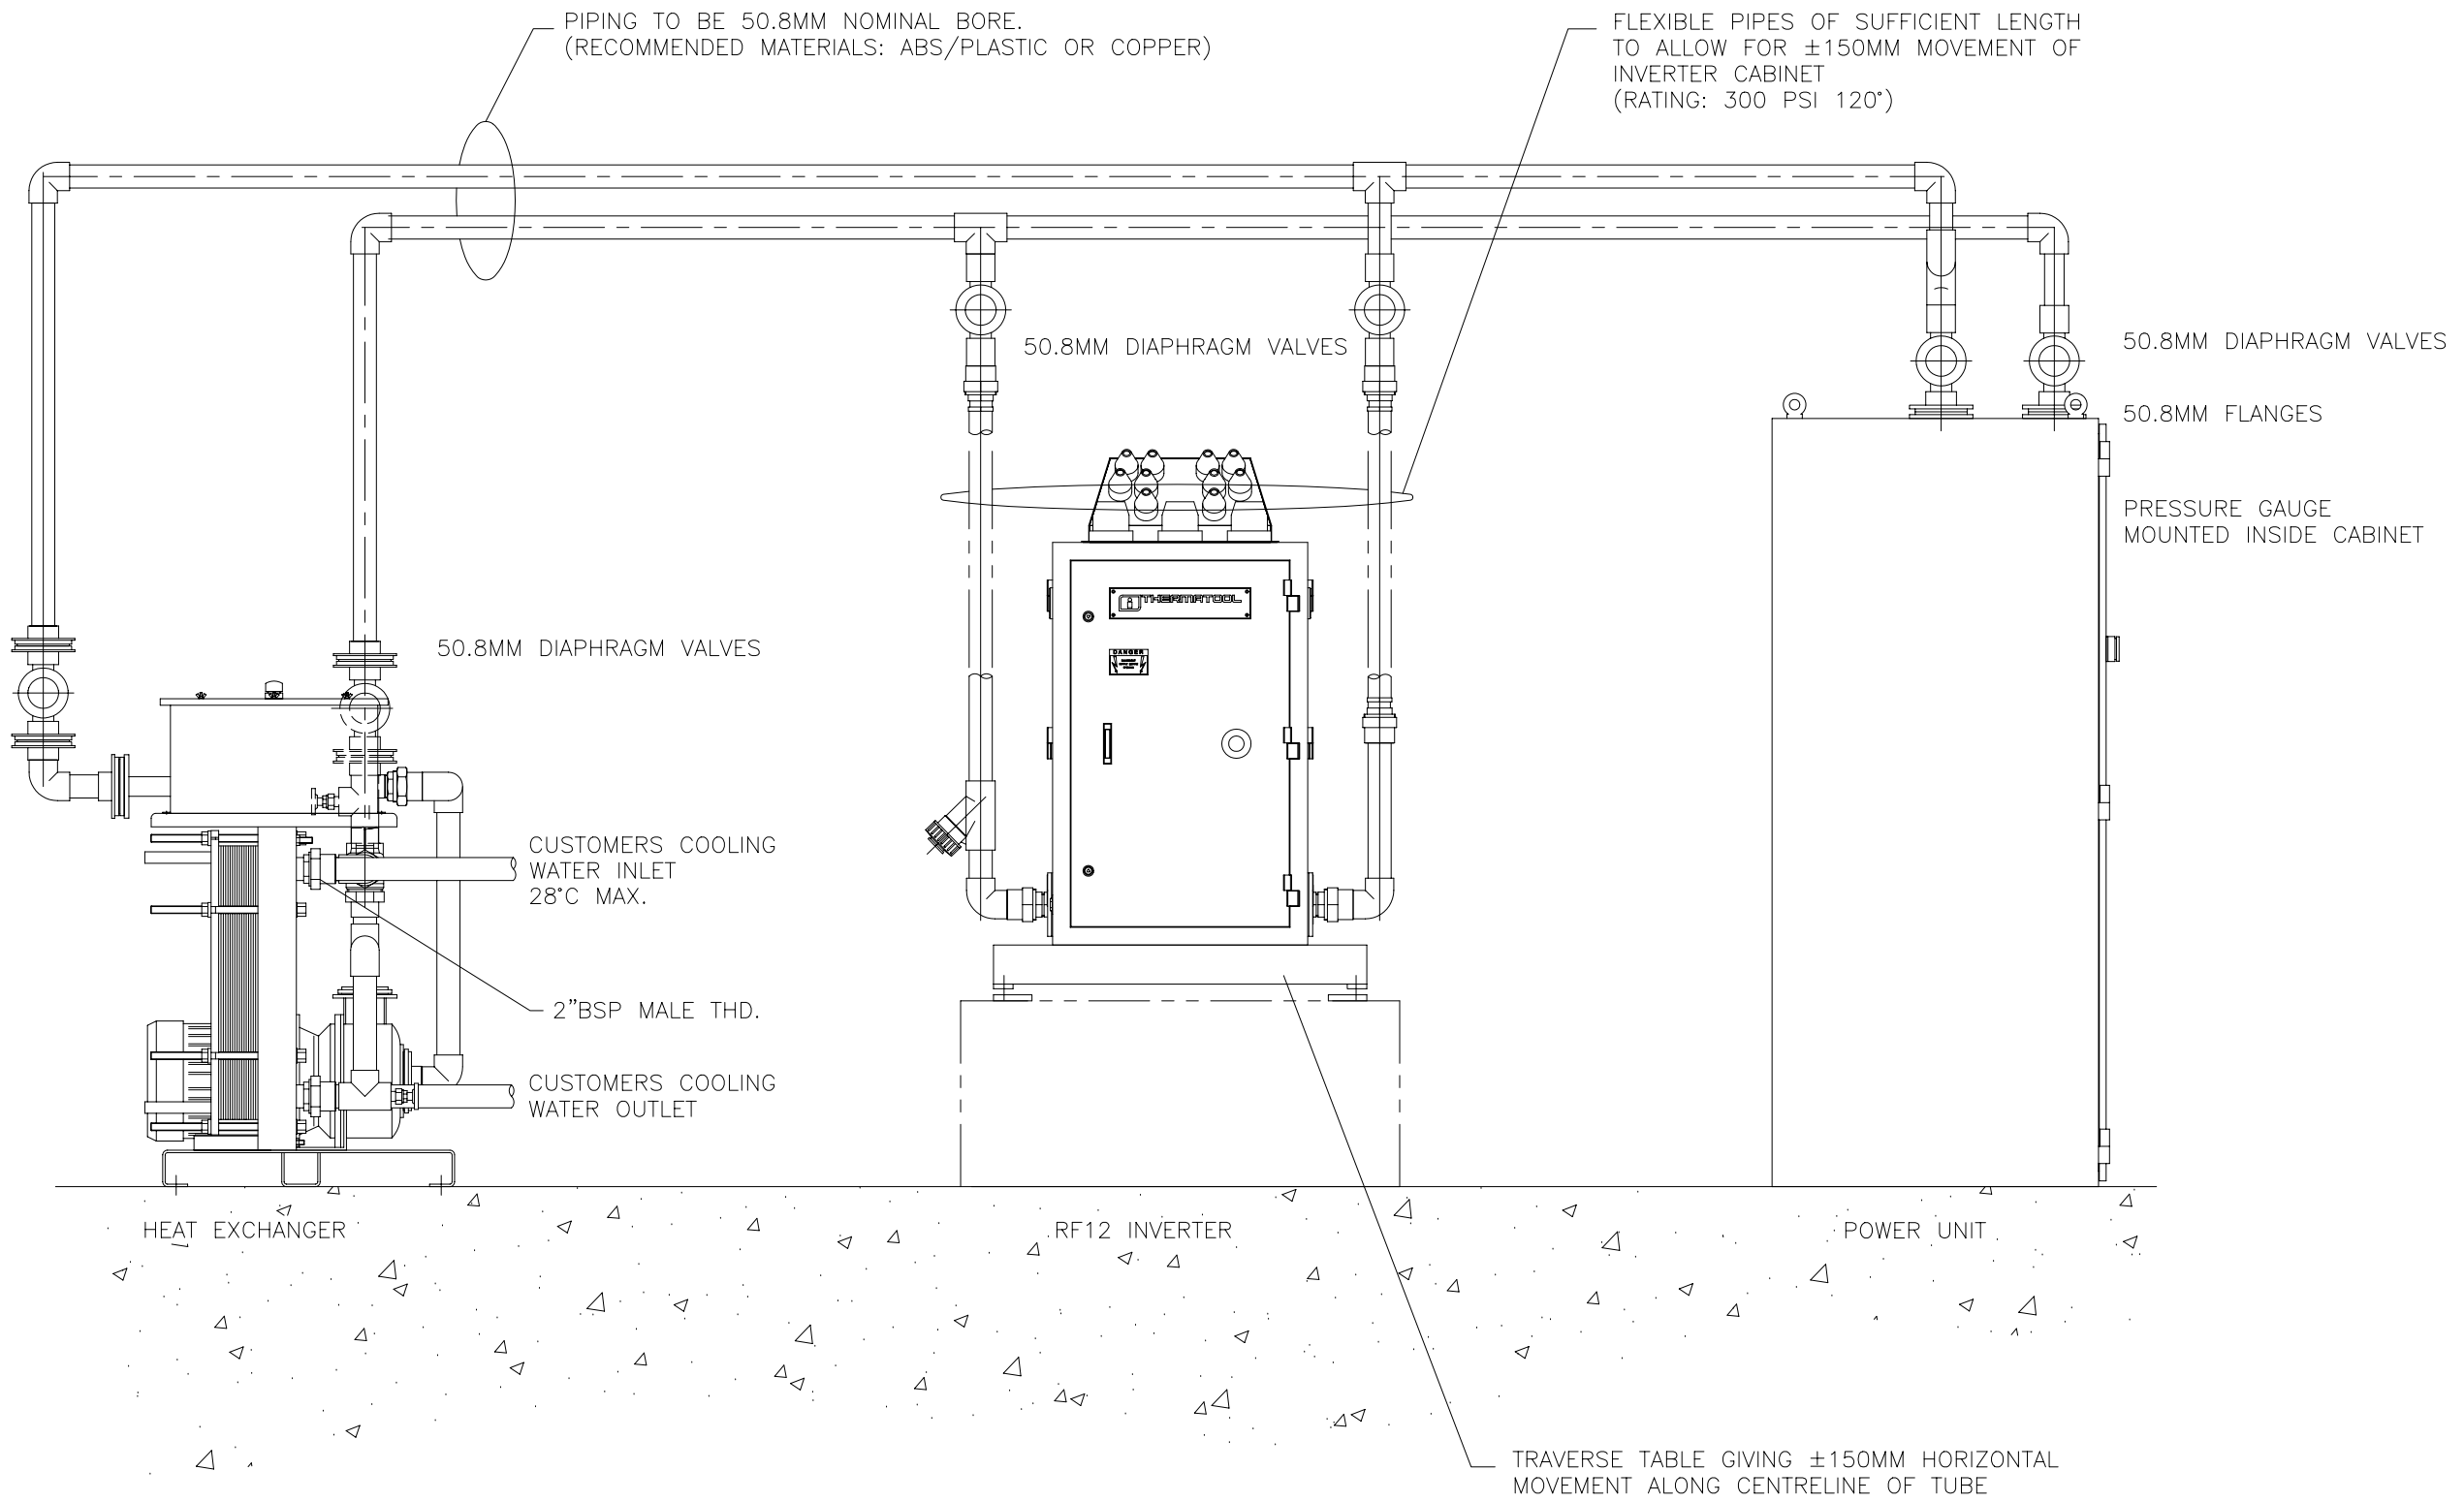

NOTE:
 FLANGES USED ARE METRIC
 DRILLED TO BS4504 TABLE 16/3 - 10/3
 REFER TO WDO171

UNLESS OTHERWISE SPECIFIED DIMENSIONS ARE IN MILLIMETERS		APPROVALS		DD/MM/YY
TOLERANCES ON		JAF		2/2/98
0 PLACE (X)	± 0.5	ANGLE	± 0°30'	
1 PLACE (X.X)	± 0.3	SURFACE FINISH	N8	
2 PLACE (X.XX)	± 0.15	BREAK AND DEBURR ALL SHARP EDGES		
NEXT ASSY	JOB NO	UNIT		
FIRST APPLICATION		50/300KW CFI		
BUYER OR SELLER HEREBY ACKNOWLEDGES THAT THERE MAY BE ERRORS OR OMISSIONS IN THIS DOCUMENT AND THAT THERMATOOL EUROPE LTD SHALL NOT BE LIABLE IN ANY MANNER FOR SUCH ERRORS OR OMISSIONS.				
©Copyright THERMATOOL EUROPE LTD		THIRD ANGLE PROJECTION		
THIS DOCUMENT IS THE PROPERTY OF THERMATOOL EUROPE LTD AND IT IS SUBMITTED FOR USE ONLY WITH WORK PROPOSED OR AUTHORIZED BY THIS COMPANY. IT SHOULD NOT BE USED OR DUPLICATED FOR ANY OTHER PURPOSE AND IS TO BE RETURNED TO THERMATOOL EUROPE LTD ON REQUEST WHEN NO LONGER REQUIRED FOR SUCH PURPOSES.		FINISH/HEAT TREAT		
		N.A.		

THERMATOOL®

TITLE
**EXTERNAL WATER CIRCUIT
 50 TO 350kW**

SIZE DIV NO DWG NO REV
A1 3 WW0090 H

SCALE 1:10 DO NOT SCALE DRAWING COPY SHEET 1 OF 1

REVISIONS							
REV	ECR	DESCRIPTION	ZONE	DWN	CHK	APPD	MM/DD/YY
A	N464	F/S CONFIGURATION TABLE ADDED		MWT			11/99
B	N537	F/S CONFIGURATION TABLE CORRECTED		MWT			02/00
C	N570	MANIFOLD FOR DC CHOKE ADDED		MWT			03/00
D	03038	AMENDED TO SUIT BUILD, NOTES ADDED		BWH			29JAN03
E	04226	1-FLS3 ADDED, PIPING REROUTED		BWH			07OCT04
F	04254	WATER MANIFOLD DELETED, FLOW SW'S REIDENTIFIED		BWH			15NOV04
G	05039	CHOKE VALUES IN TABLE MODIFIED		BWH			22FEB05
H	06010	SEE SHT 1 OF 2		MWT			12JAN06
J	09083	PLUMB DC CHOKE IN PARALLEL		TAT			14JUL09

NOTES:

- PIPES TO BE 1800mm LONG
- PIPE TO BE 2500mm LONG

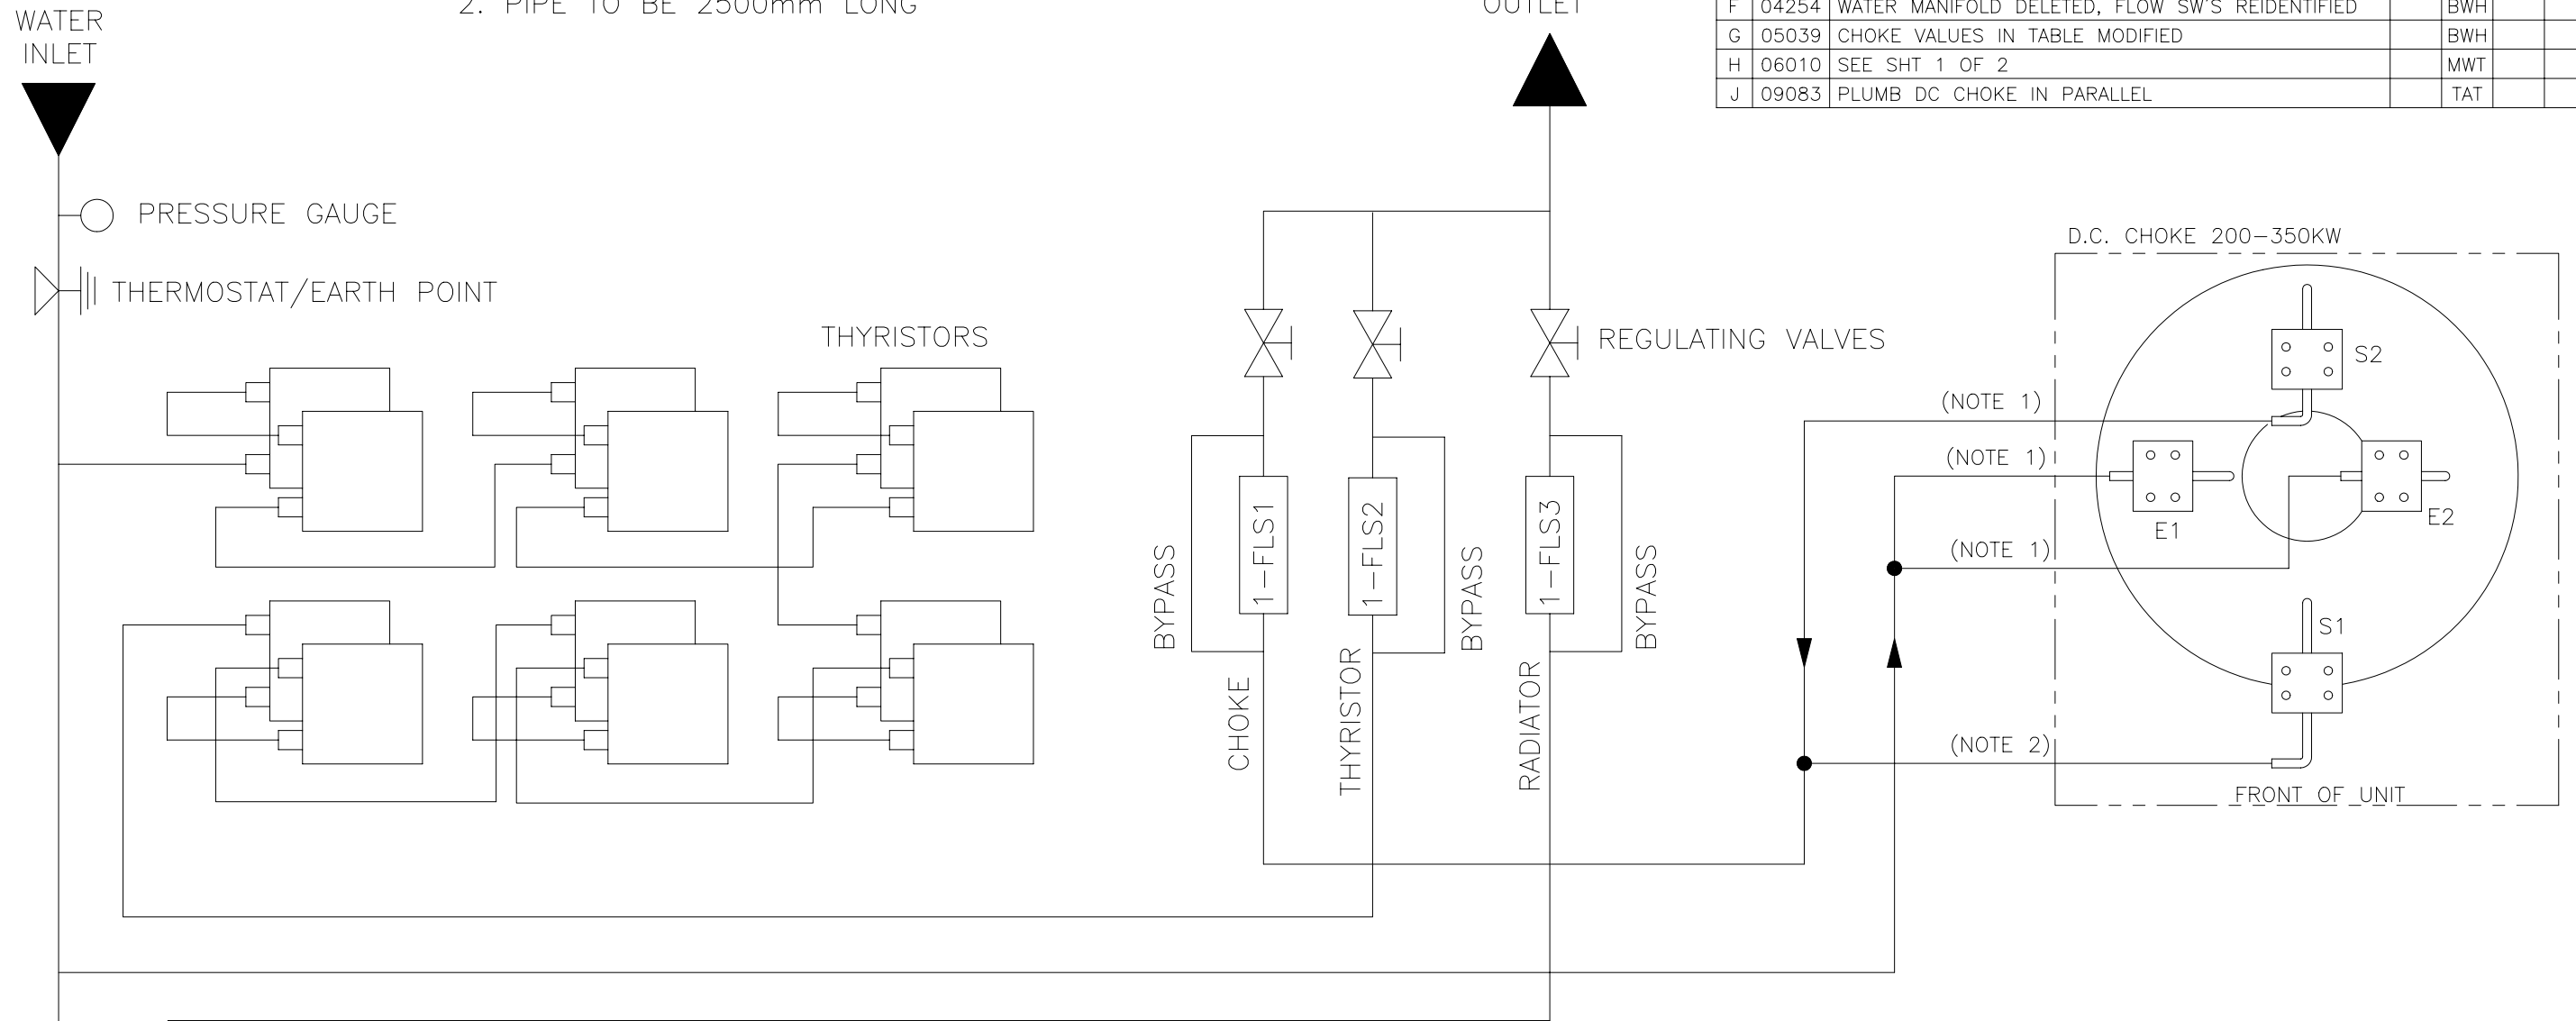



TABLE FOR FLOWSWITCH CONFIGURATION

	CHOKE			THYRISTOR			RADIATOR		
	TRIP L/min	'FLS1' L/min	BYPASS	TRIP L/min	'FLS2' L/min	BYPASS	TRIP L/min	'FLS3' L/min	BYPASS
200kW	9.5	8	Ø1.5	9.5	8	Ø1.5	15	12	Ø5
250kW	9.5	8	Ø1.5	9.5	8	Ø1.5	15	12	Ø5
300kW	9.5	8	Ø1.5	9.5	8	Ø1.5	30	12	Ø10
350kW	9.5	8	Ø1.5	9.5	8	Ø1.5	30	12	Ø10

FLOWSWITCH IDENTIFICATION

8L/min	No. 8	STAMPED ON BRASS FLOAT OR BODY
12L/min	No. 12	STAMPED ON BRASS FLOAT OR BODY



© Copyright THERMATOOL EUROPE LTD

TITLE
DC POWER UNIT
WATER SCHEMATIC

SIZE A2	DIV NO 3	DWG NO WW0091	REV J
SCALE 1:1	DO NOT SCALE DRAWING COPY		SHEET 2

WW5069

HF12 Inverter Water Schematic


Bus 5 Configuration

Sheet 1 – *HF12 Inverter Water Schematic*

Sheet 2 – *HF12 Inverter Water Schematic*

Sheet 3 – *HF12 Inverter Water Schematic*

REVISIONS									
REV	ECR	DESCRIPTION	ZONE	DWN	CHK	APPD	MM/DD/YY		
0	03028	FIRST ISSUE		MWT			01/03		
A	05058	CORRECTED LAYOUT		MWT			05/05		

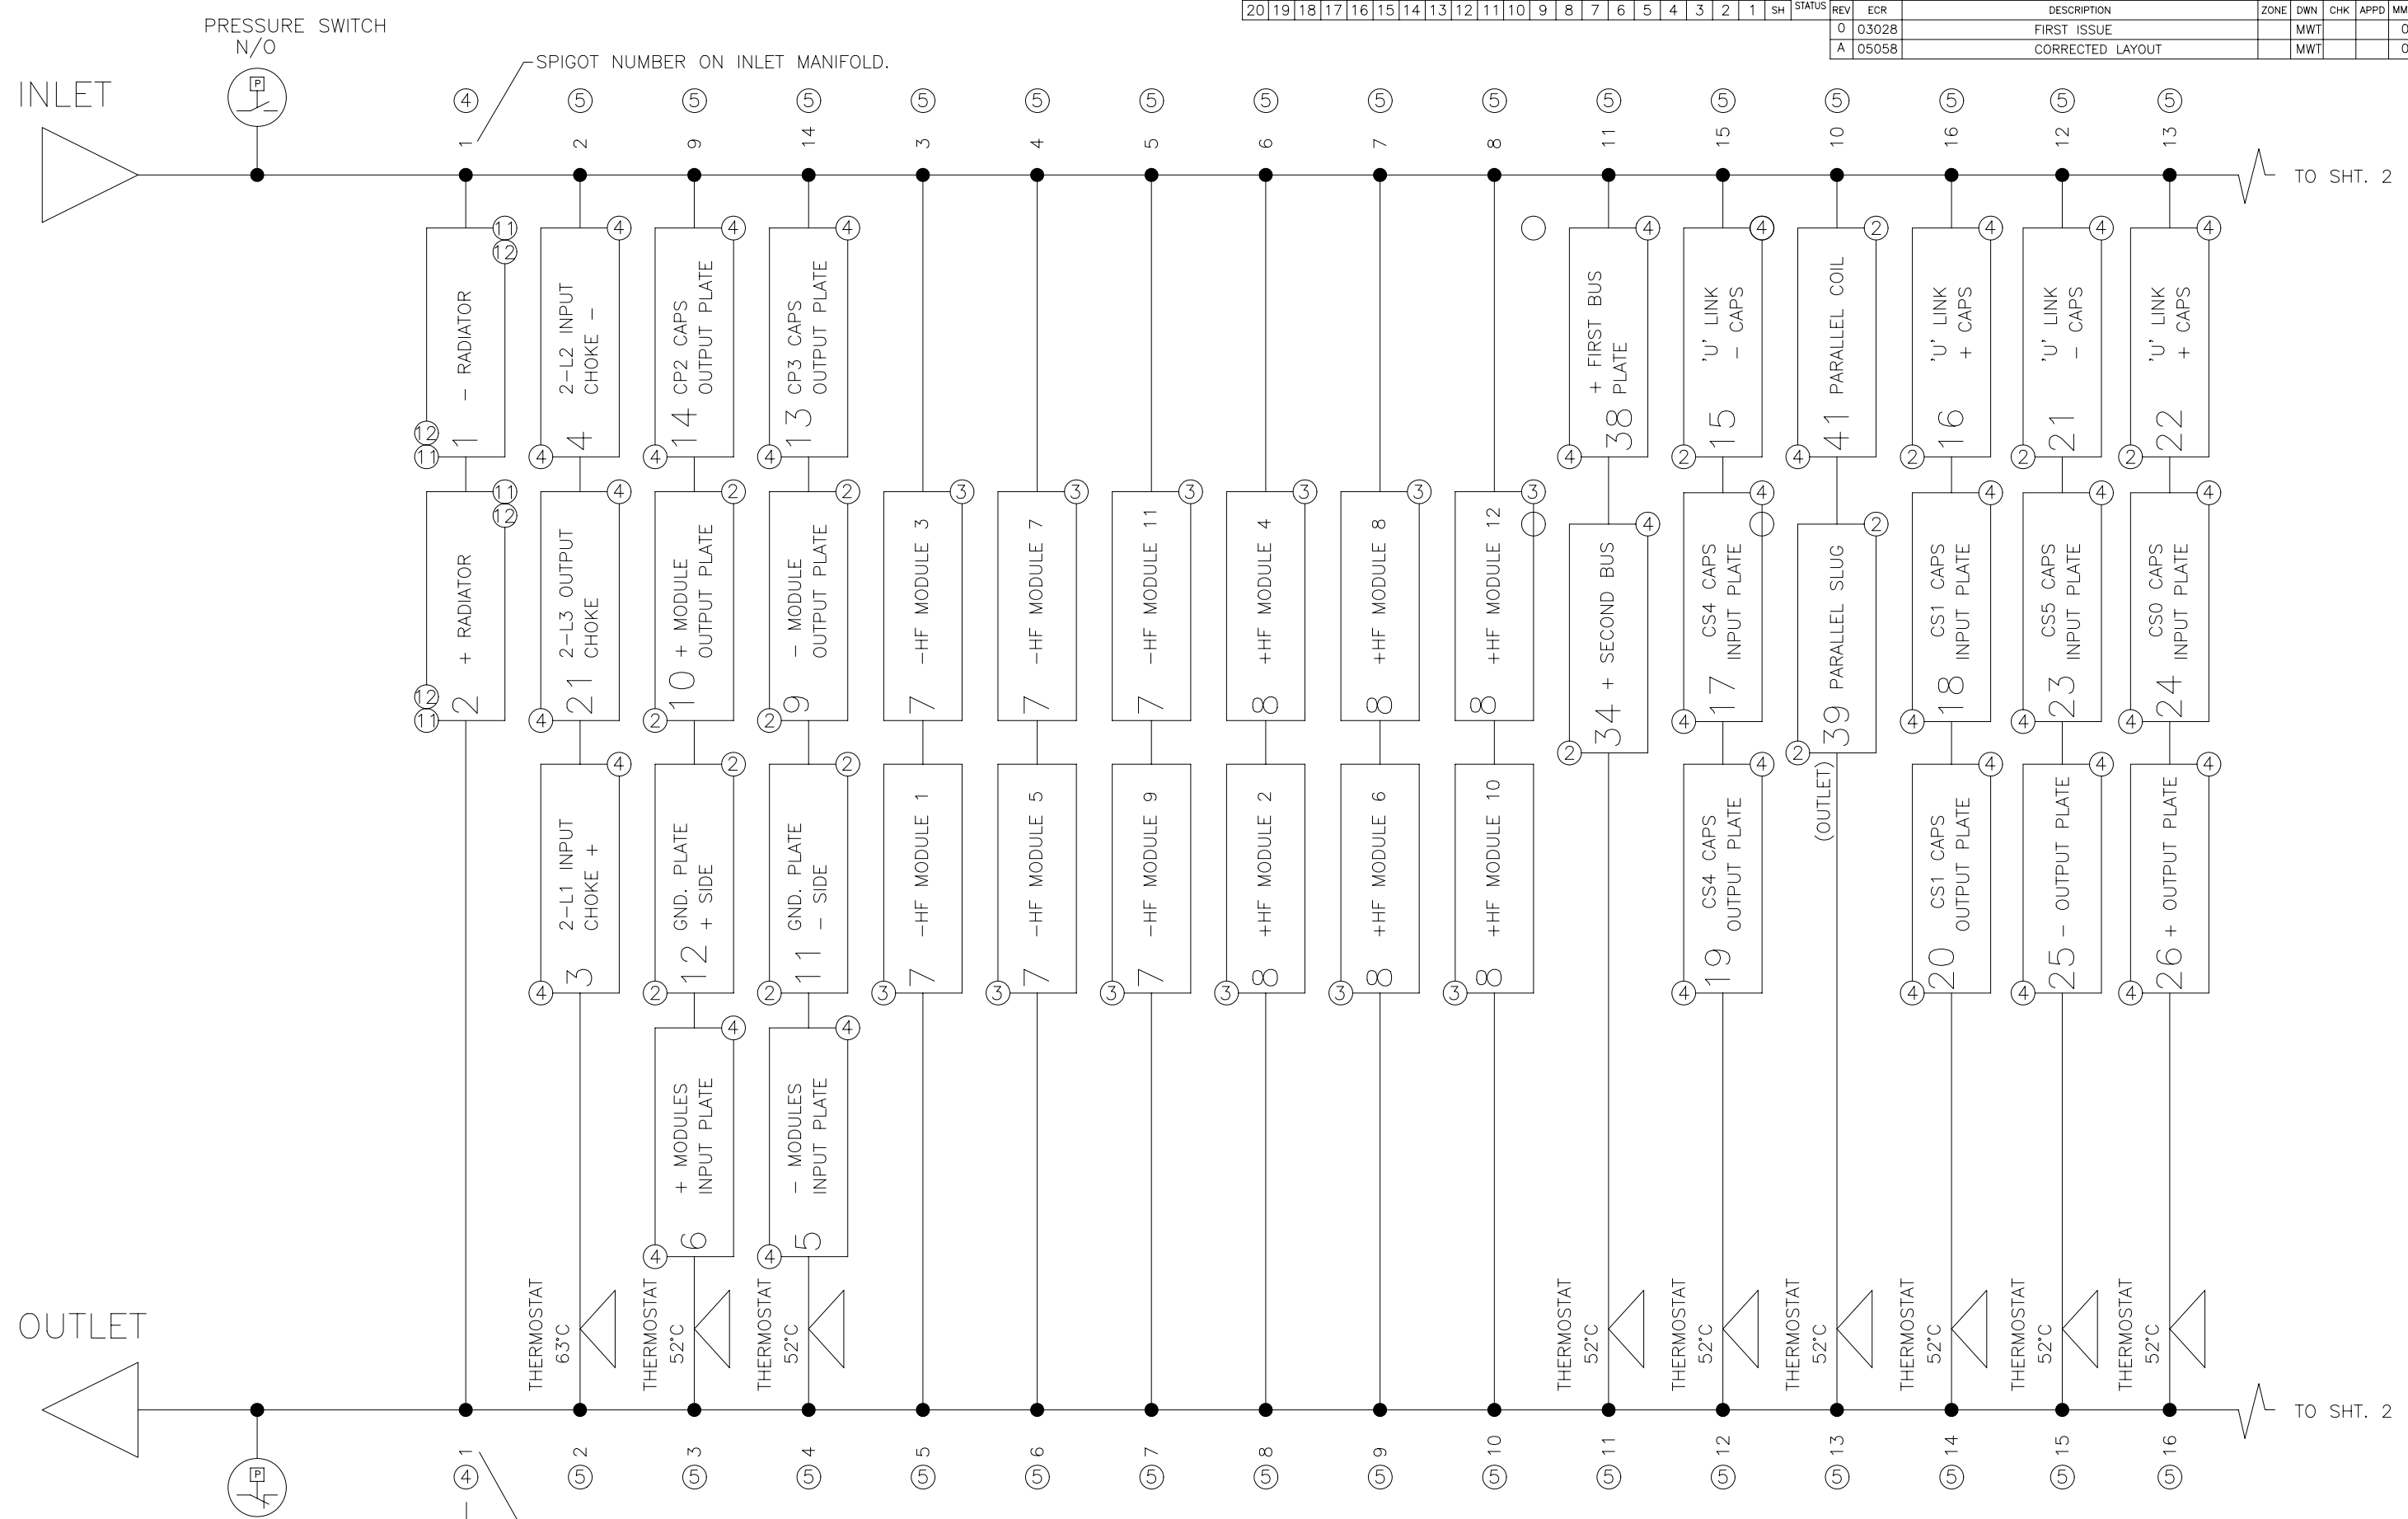

THIS RUN 10MM BLUE PIPE. ⑧



SPIGOT NUMBER ON INLET MANIFOLD.

SPIGOT NUMBER ON OUTLET MANIFOLD.

- NOTES: -
1. NUMBERS INSIDE CIRCLES ⑤ REFER TO ITEM NO. ON BOM.
 2. QUANTITY OF + & - HF MODULES DEPENDANT UPON CONFIGURATION.
 3. UNLESS STATED ALL PLUMBING RUNS 12MM BLUE PIPE. ⑨

APPROVALS		DD/MM/YY	
DWN	MWT	29/01/03	
TOLERANCES ON		TITLE	
0 PLACE (X) ± 0.5	ANGLE ± 0°30'	HF12 INVERTER WATER SCHEMATIC BUS 5 CONFIGURATION	
1 PLACE (X.X) ± 0.3	SURFACE FINISH N8		
2 PLACE (X.XX) ± 0.15	BREAK AND DEBURR ALL SHARP EDGES	SIZE DIV NO DWG NO	
		A1 3 WW5069	
THIRD ANGLE PROJECTION		REV	
		A	
FINISH/HEAT TREAT		SCALE	
N.A.		1:1	
<small>THIS DOCUMENT IS THE PROPERTY OF THERMATOOL EUROPE LTD AND IT IS SUBMITTED FOR USE ONLY WITH WORK PROPOSED OR AUTHORIZED BY THIS COMPANY. IT SHOULD NOT BE USED OR DUPLICATED FOR ANY OTHER PURPOSE AND IS TO BE RETURNED TO THERMATOOL EUROPE LTD ON REQUEST WHEN NO LONGER REQUIRED FOR SUCH PURPOSES.</small>		DO NOT SCALE DRAWING COPY SHEET 1 OF 3	

REVISIONS							
REV	ECR	DESCRIPTION	ZONE	DWN	CHK	APPD	MM/DD/YY
0	03028	FIRST ISSUE		MWT			01/03
A	05058	CORRECTED LAYOUT		MWT			05/05

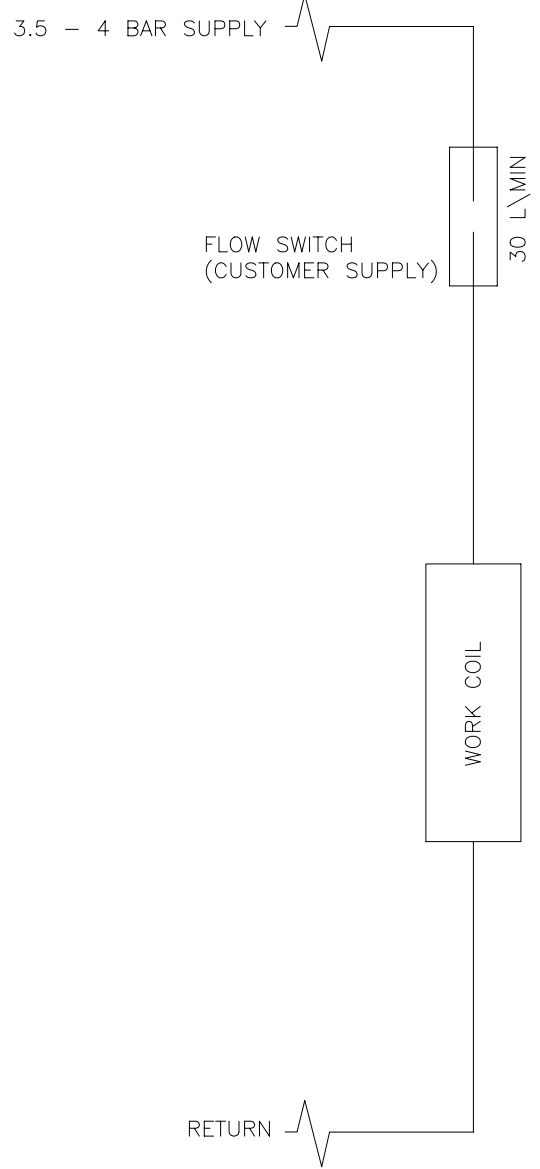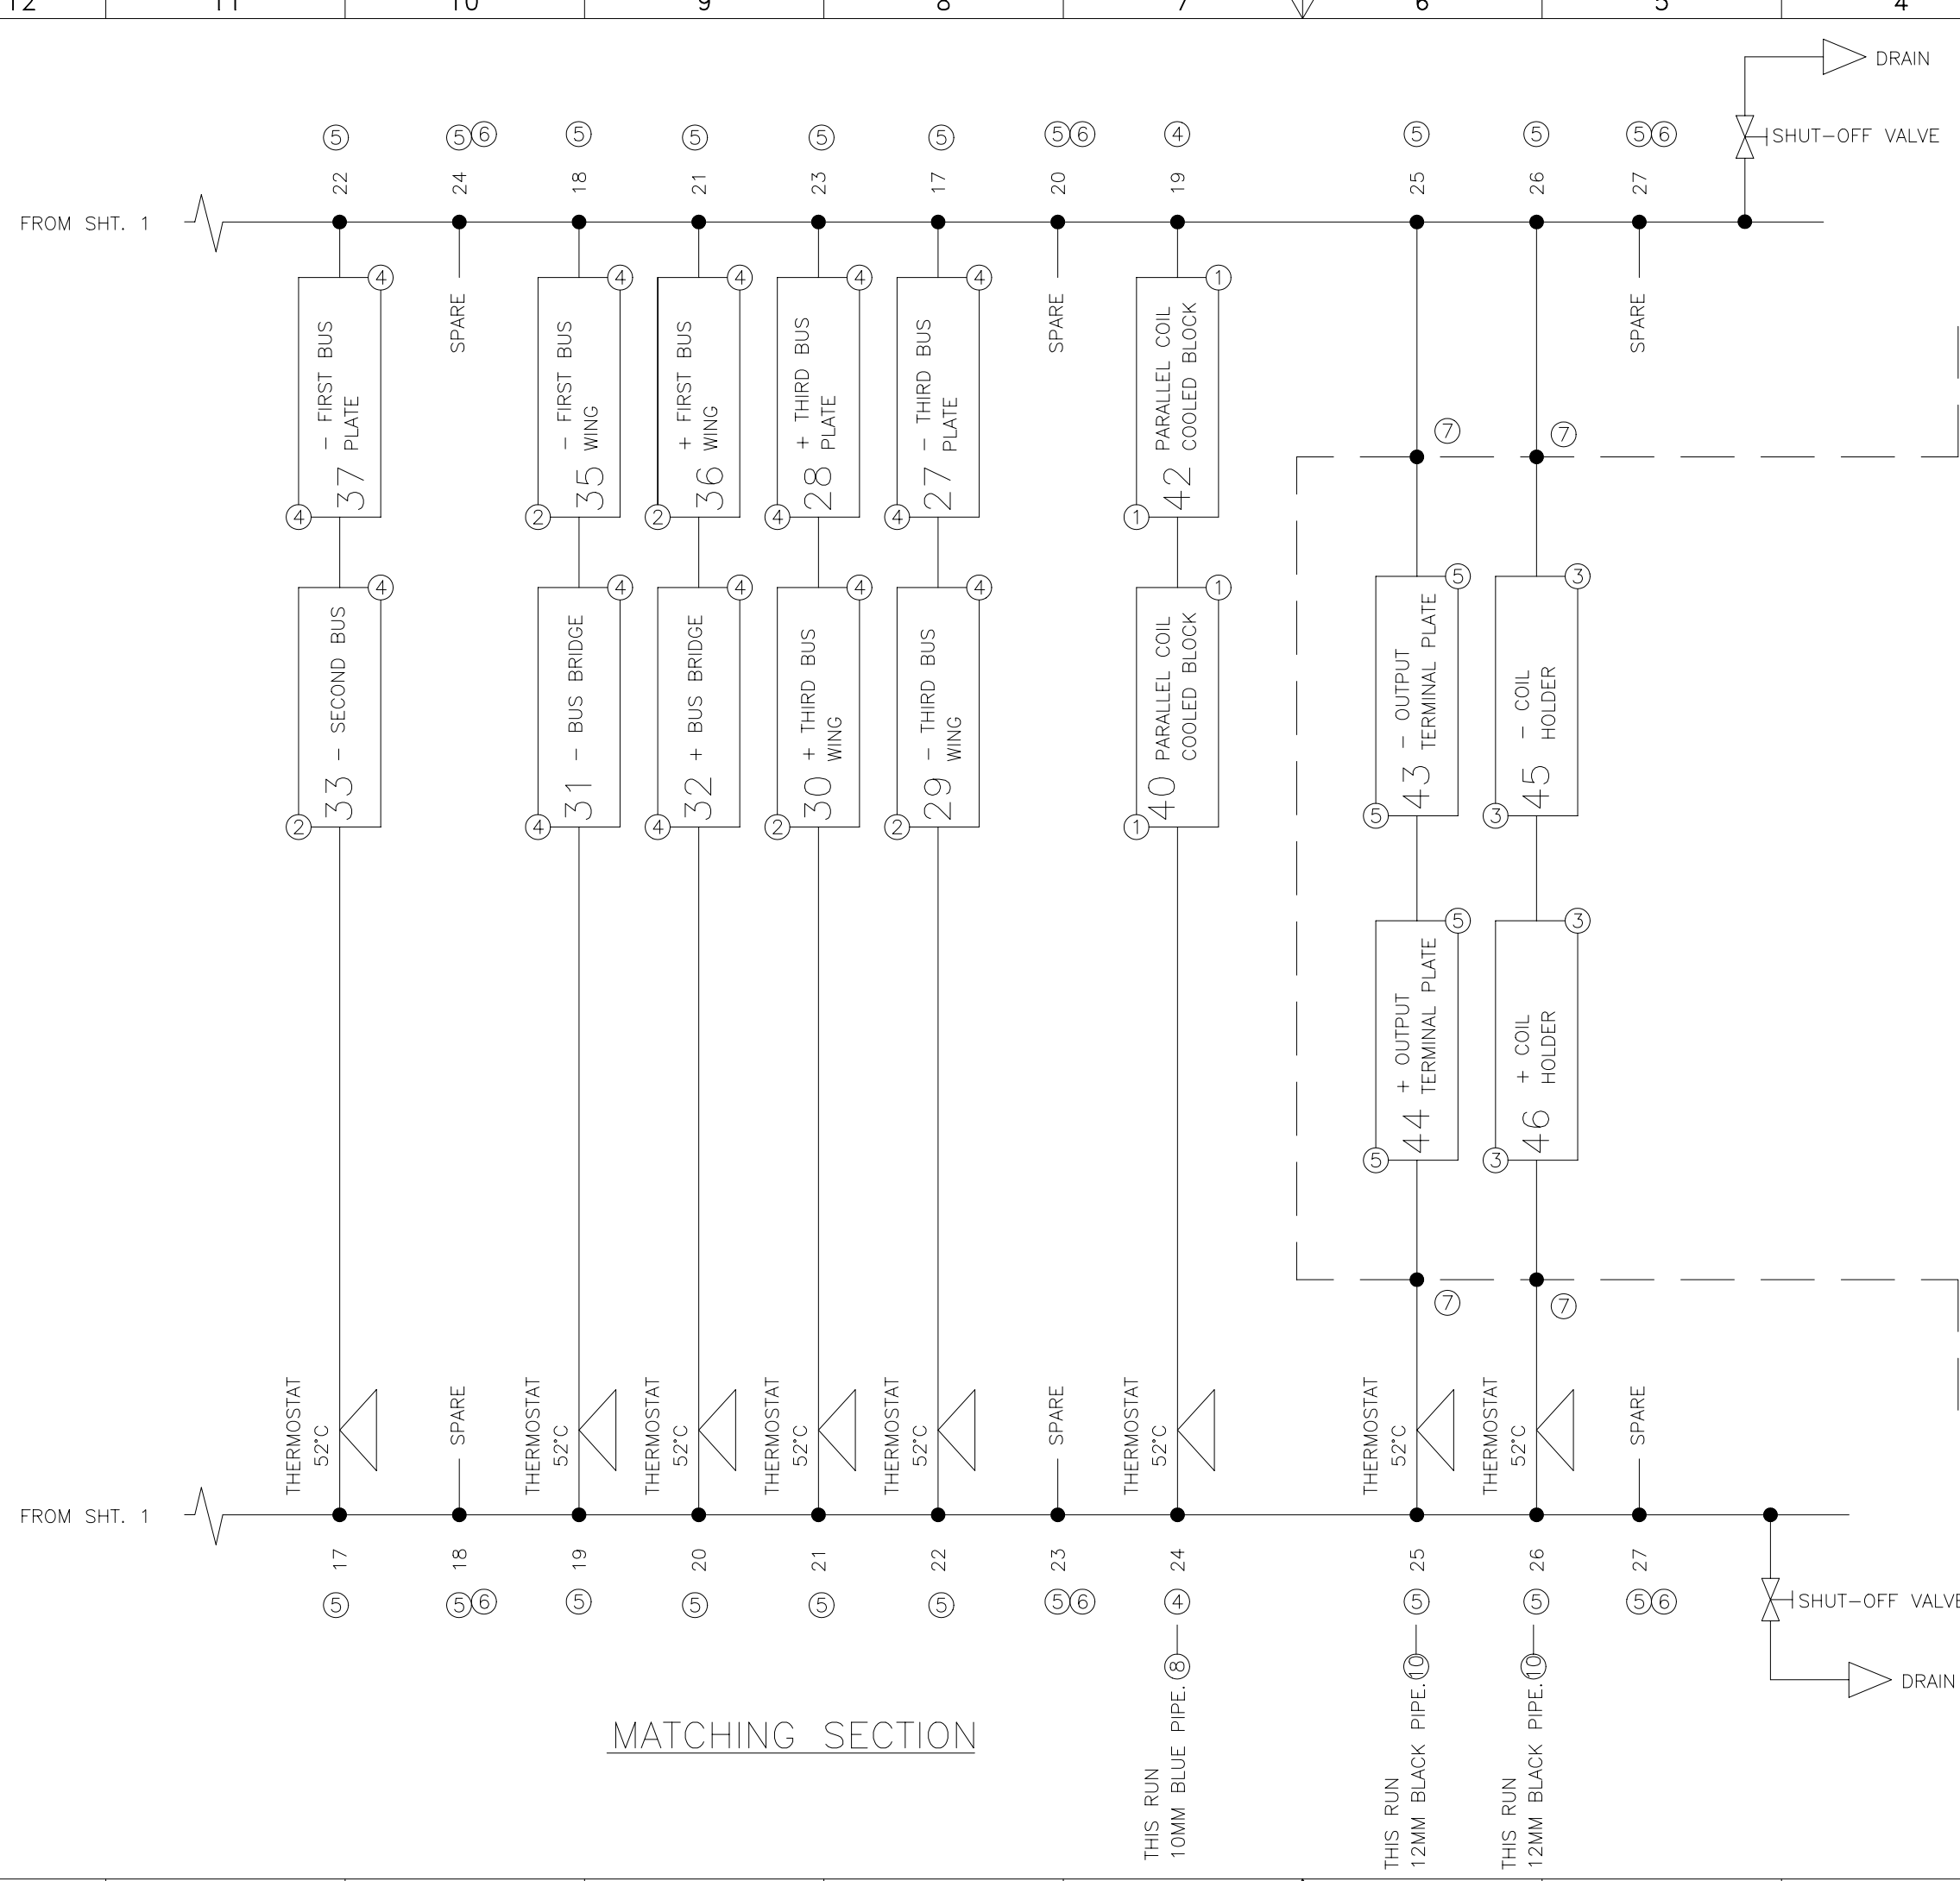

EXTERNAL CONNECTIONS
COOLED FROM CUSTOMERS MILL SUPPLY

THERMATOOL
© Copyright THERMATOOL EUROPE LTD

TITLE: **HF12 INVERTER WATER SCHEMATIC BUS 5 CONFIGURATION**

SIZE	DIV NO	DWG NO	REV
A1	3	WW5069	A

SCALE: 1:1 DO NOT SCALE DRAWING COPY SHEET 2 OF 3


MATCHING SECTION

THIS RUN 10MM BLUE PIPE. ⑧

THIS RUN 12MM BLACK PIPE. ⑩

THIS RUN 12MM BLACK PIPE. ⑩

REV		DESCRIPTION		ZONE		DWN		CHK		APPD		MM/DD/YY	
0	03028	FIRST ISSUE											01/03
A	05058	SEE SHTS 1 & 2											05/05

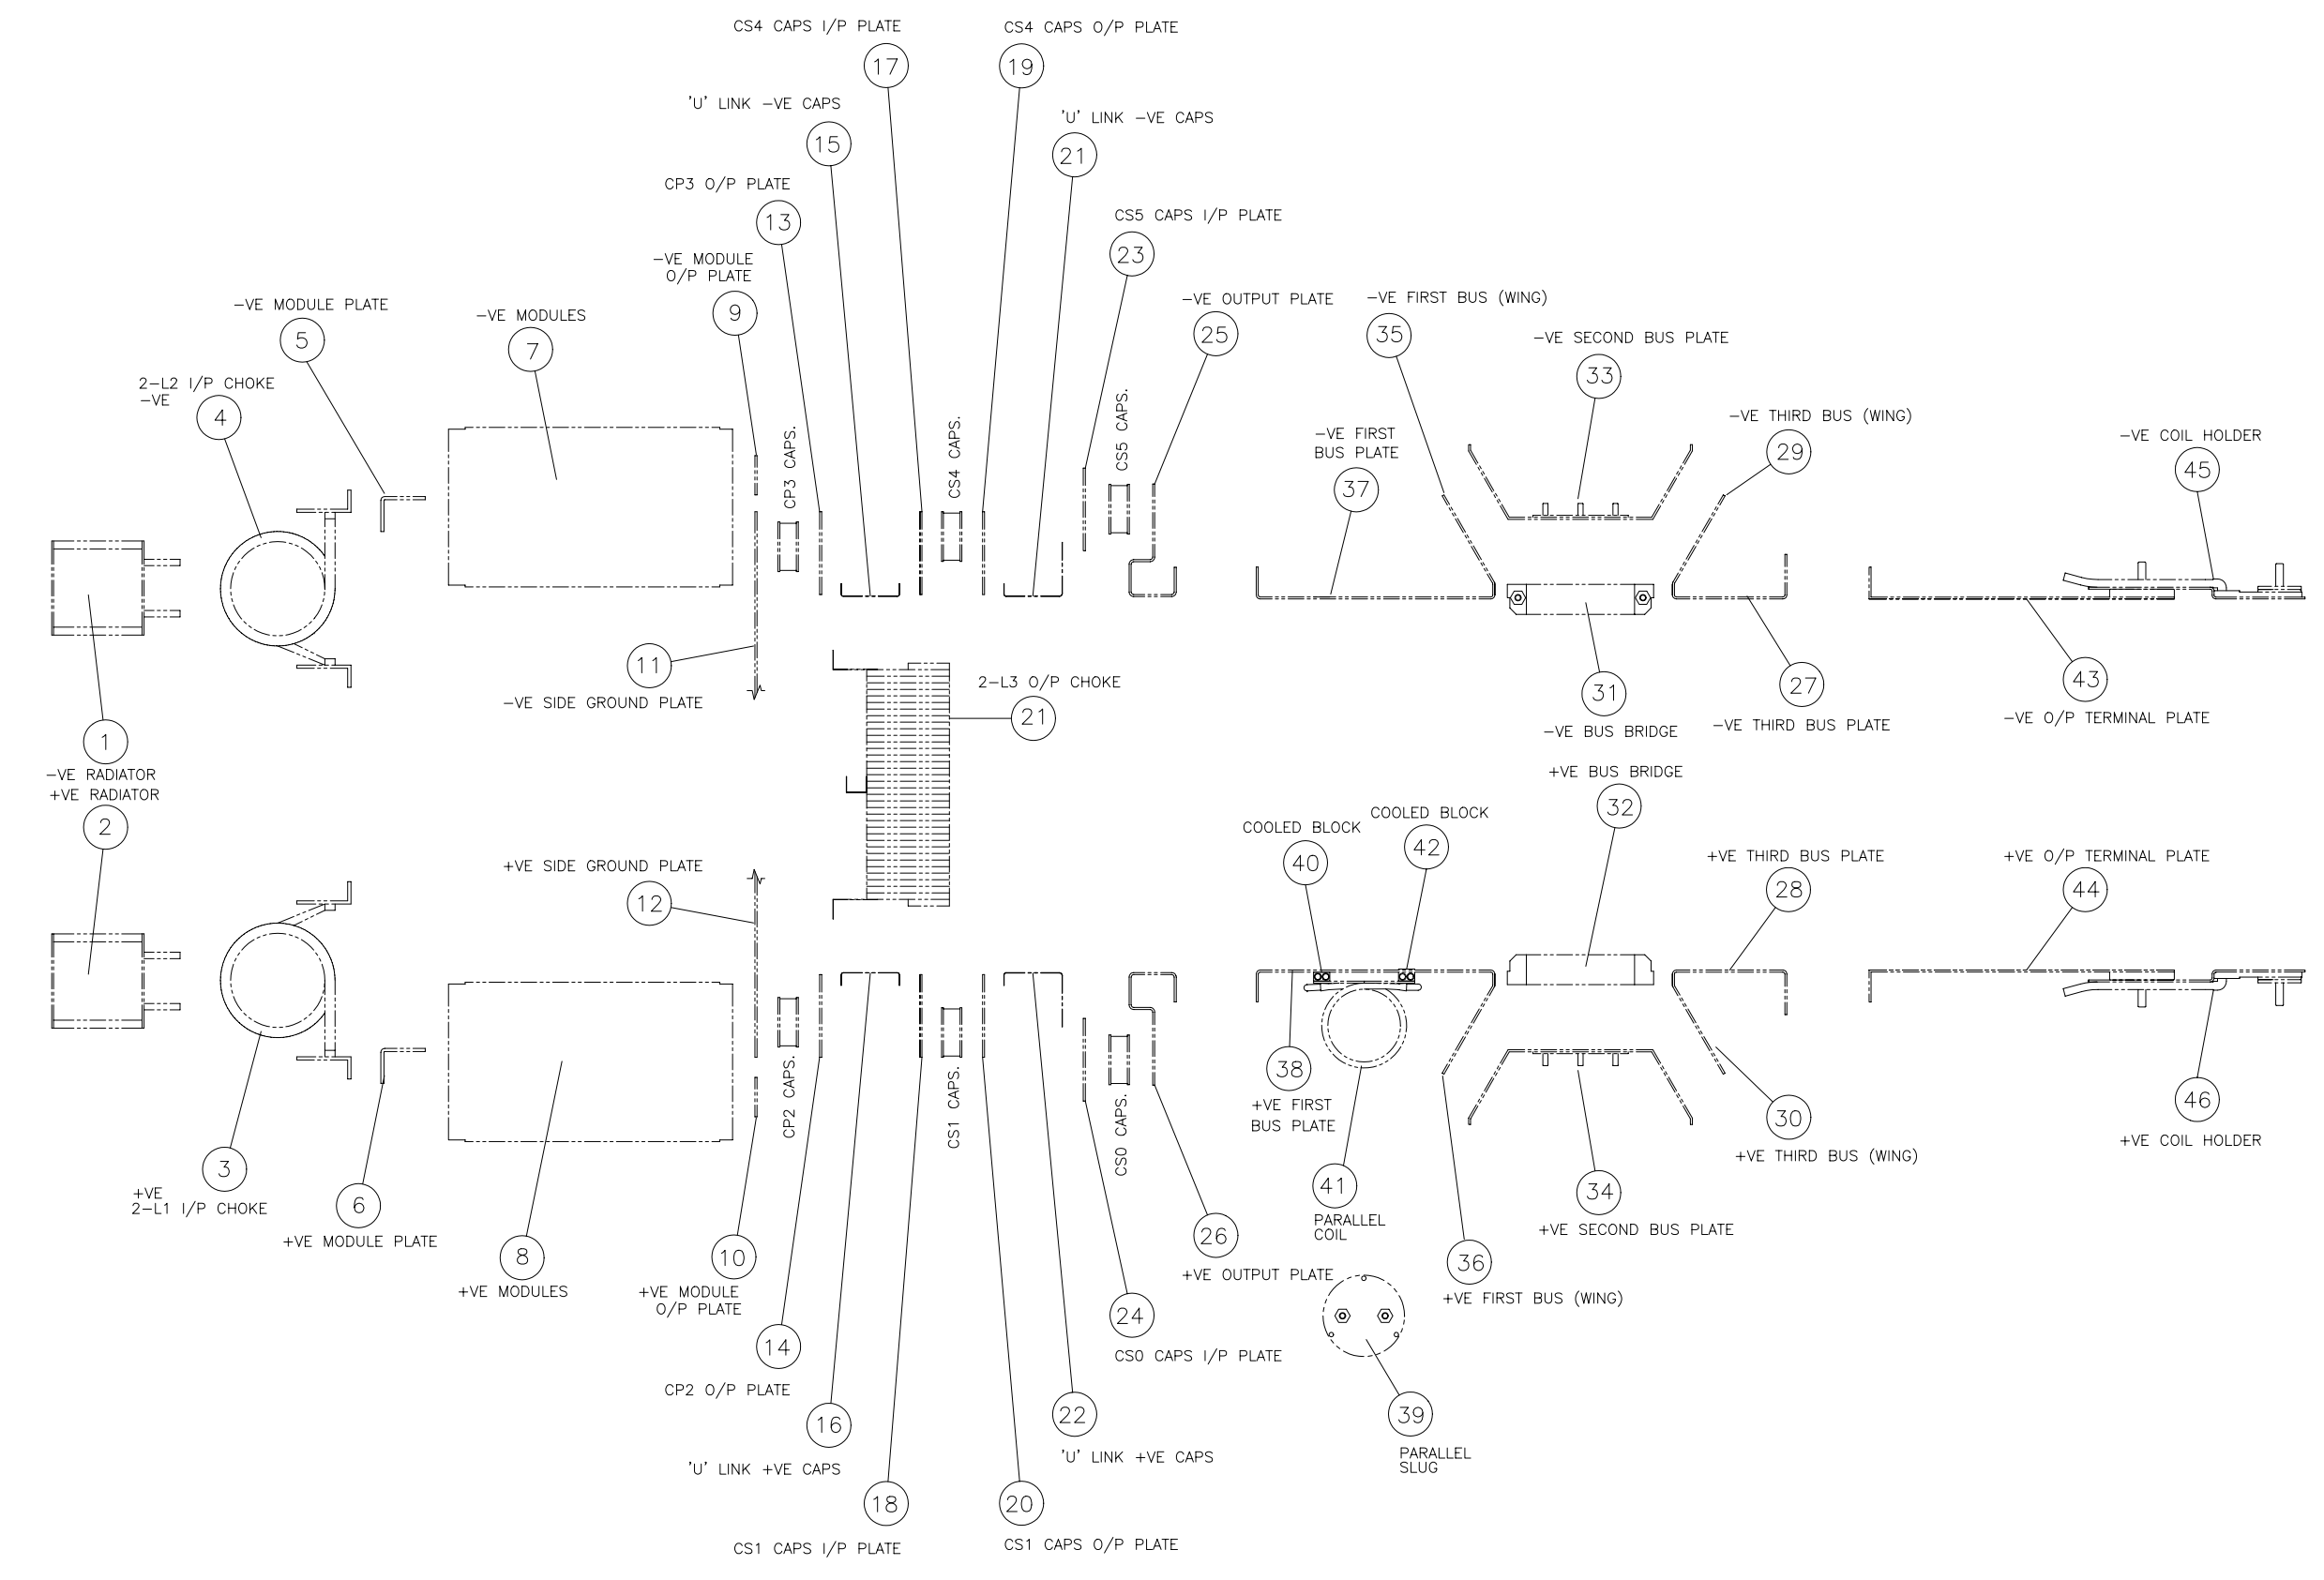

COMPONENT IDENTIFICATION LAYOUT

THERMATOOL
© Copyright THERMATOOL EUROPE LTD

TITLE
HF12 INVERTER
WATER SCHEMATIC
BUS 5 CONFIGURATION

SIZE	DIV NO	DWG NO	REV
A0	3	WW5069	A

SCALE 1:1 DO NOT SCALE DRAWING COPY SHEET 3 OF 3
ENG-REF: 2 1

WL0904

Work Coils

Sheet 1 – Work Coil, *Multi-Turn, Tubular*

Sheet 2 – Work Coil, *Multi-Turn, Tubular*

Sheet 3 – Work Coil, *Multi-Turn, Banded*

Sheet 4 – Work Coil, *Single-Turn, Banded*

REFER TO SALES ENGINEER
FOR QUOTATION FOR WORK COILS




WL5458
Work Coils

Sheet 1 – Work Coil, *Multi-Turn, Banded Bi Directional*

Sheet 2 – Work Coil, *Multi-Turn, Banded Bi Directional*

**REFER TO SALES ENGINEER
FOR COIL QUOTATION**


20	19	18	17	16	15	14	13	12	11	10	9	8	7	6	5	4	3	2	1	0	REV	REV	REVISIONS							
																					SH	STATUS	REV	ECR	DESCRIPTION	ZONE	DWN	CHK	APPD	MM/DD/YY

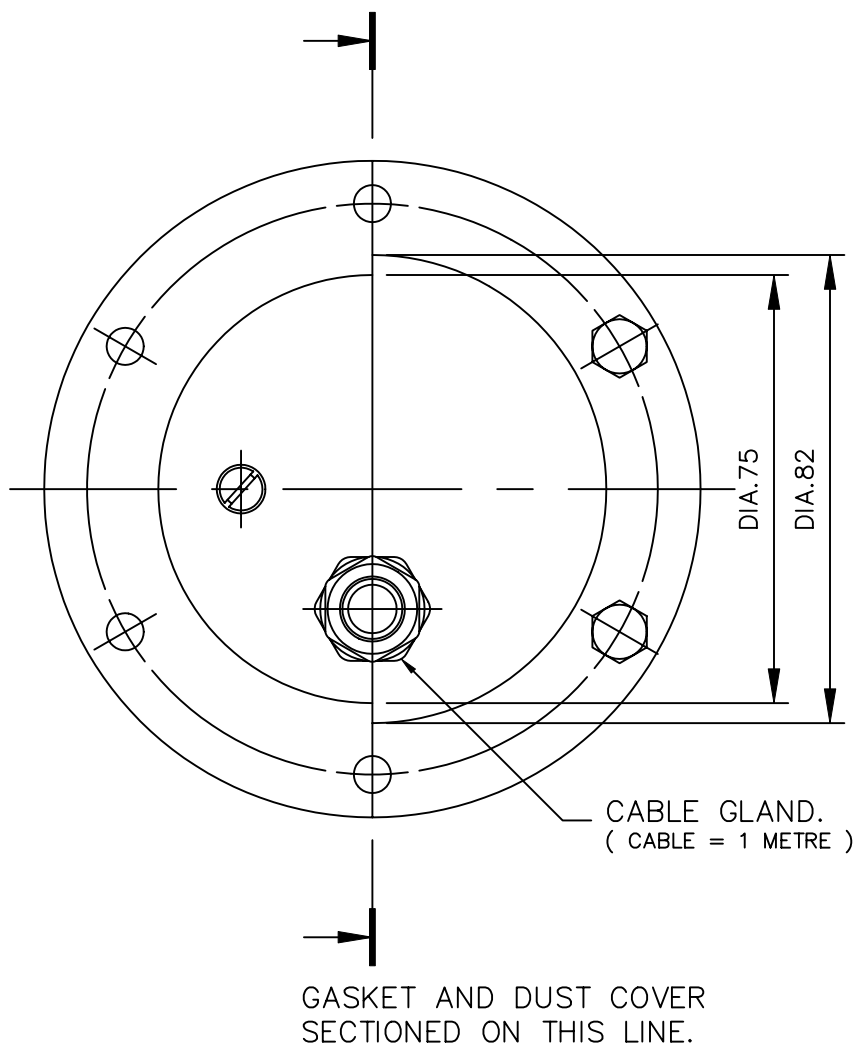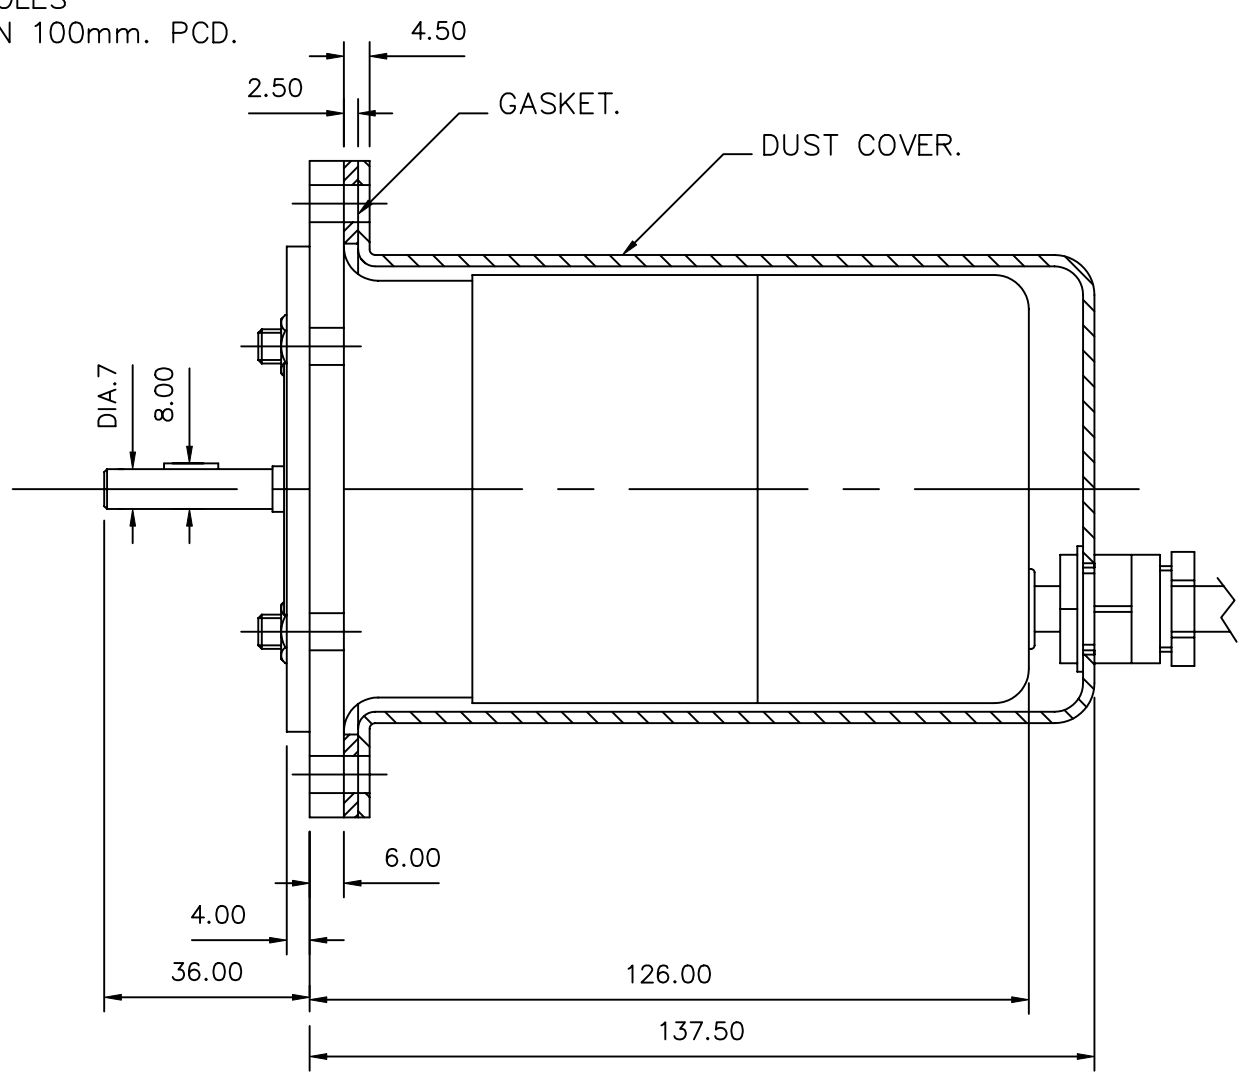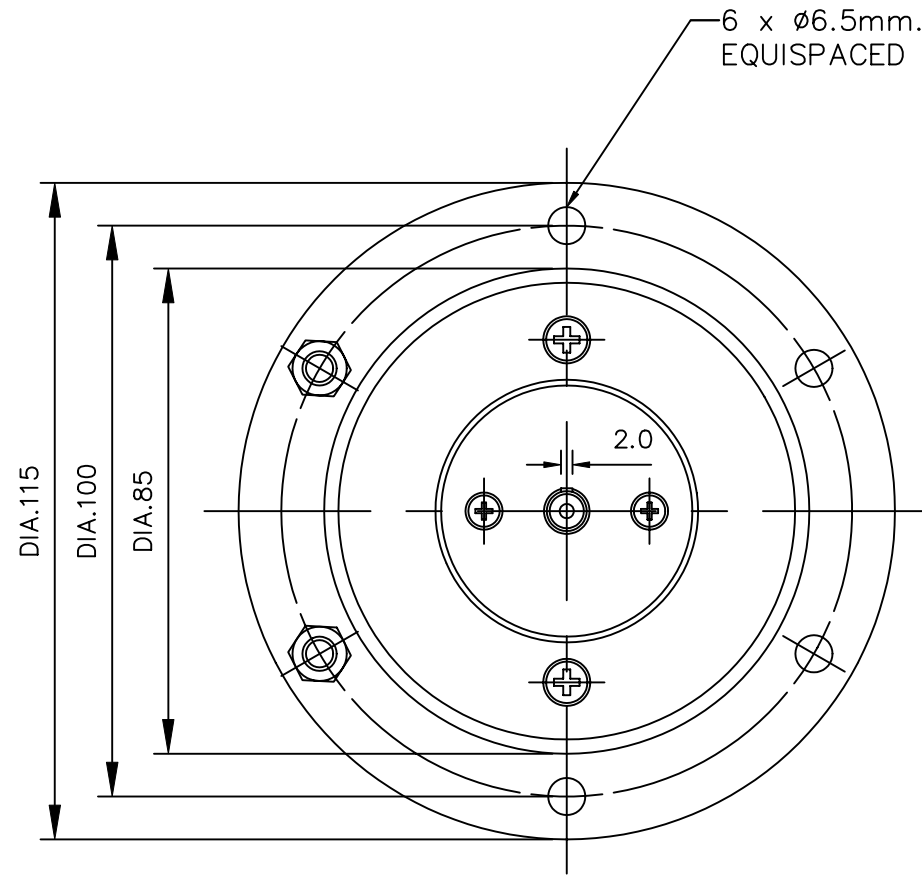

NOTE:
TACHO-GENERATOR SHOULD BE GEARED
TO GIVE 1000 to 1500 RPM. AT MAXIMUM
LINE SPEED.




UNLESS OTHERWISE SPECIFIED DIMENSIONS ARE IN MILLIMETERS TOLERANCES ON		APPROVALS	MM/DD/YY	THERMATOOL®													
NEXT ASSY	JOB NO	DWN	JAF	2/2/98	TITLE TACHO-GENERATOR TYPE: REo N												
FIRST APPLICATION		CHK															
UNIT	CFI	ENG/APPD															
BUYER OR SELLER HEREBY ACKNOWLEDGES THAT THERE MAY BE ERRORS OR OMISSIONS IN THIS DOCUMENT AND THAT THERMATOOL EUROPE LTD SHALL NOT BE LIABLE IN ANY MANNER FOR SUCH ERRORS OR OMISSIONS.		SI-METRIC		MATERIAL													
© Copyright THERMATOOL EUROPE LTD		THIRD ANGLE PROJECTION		FINISH/HEAT TREAT													
THIS DOCUMENT IS THE PROPERTY OF THERMATOOL EUROPE LTD AND IT IS SUBMITTED FOR USE ONLY WITH WORK PROPOSED OR AUTHORIZED BY THIS COMPANY. IT SHOULD NOT BE USED OR DUPLICATED FOR ANY OTHER PURPOSE AND IS TO BE RETURNED TO THERMATOOL EUROPE LTD ON REQUEST WHEN NO LONGER REQUIRED FOR SUCH PURPOSES.				<table border="1"> <tr> <td>SIZE</td> <td>DIV NO</td> <td>DWG NO</td> <td>REV</td> </tr> <tr> <td>A2</td> <td>3</td> <td>WD0083</td> <td>0</td> </tr> <tr> <td>SCALE</td> <td>1:1</td> <td>DO NOT SCALE DRAWING COPY</td> <td>SHEET 1 OF 1</td> </tr> </table>		SIZE	DIV NO	DWG NO	REV	A2	3	WD0083	0	SCALE	1:1	DO NOT SCALE DRAWING COPY	SHEET 1 OF 1
SIZE	DIV NO	DWG NO	REV														
A2	3	WD0083	0														
SCALE	1:1	DO NOT SCALE DRAWING COPY	SHEET 1 OF 1														

REV		ECR	DESCRIPTION	ZONE	DWN BY	MM/DD/YY
0	02308		FIRST ISSUE		MWT	13/12/02

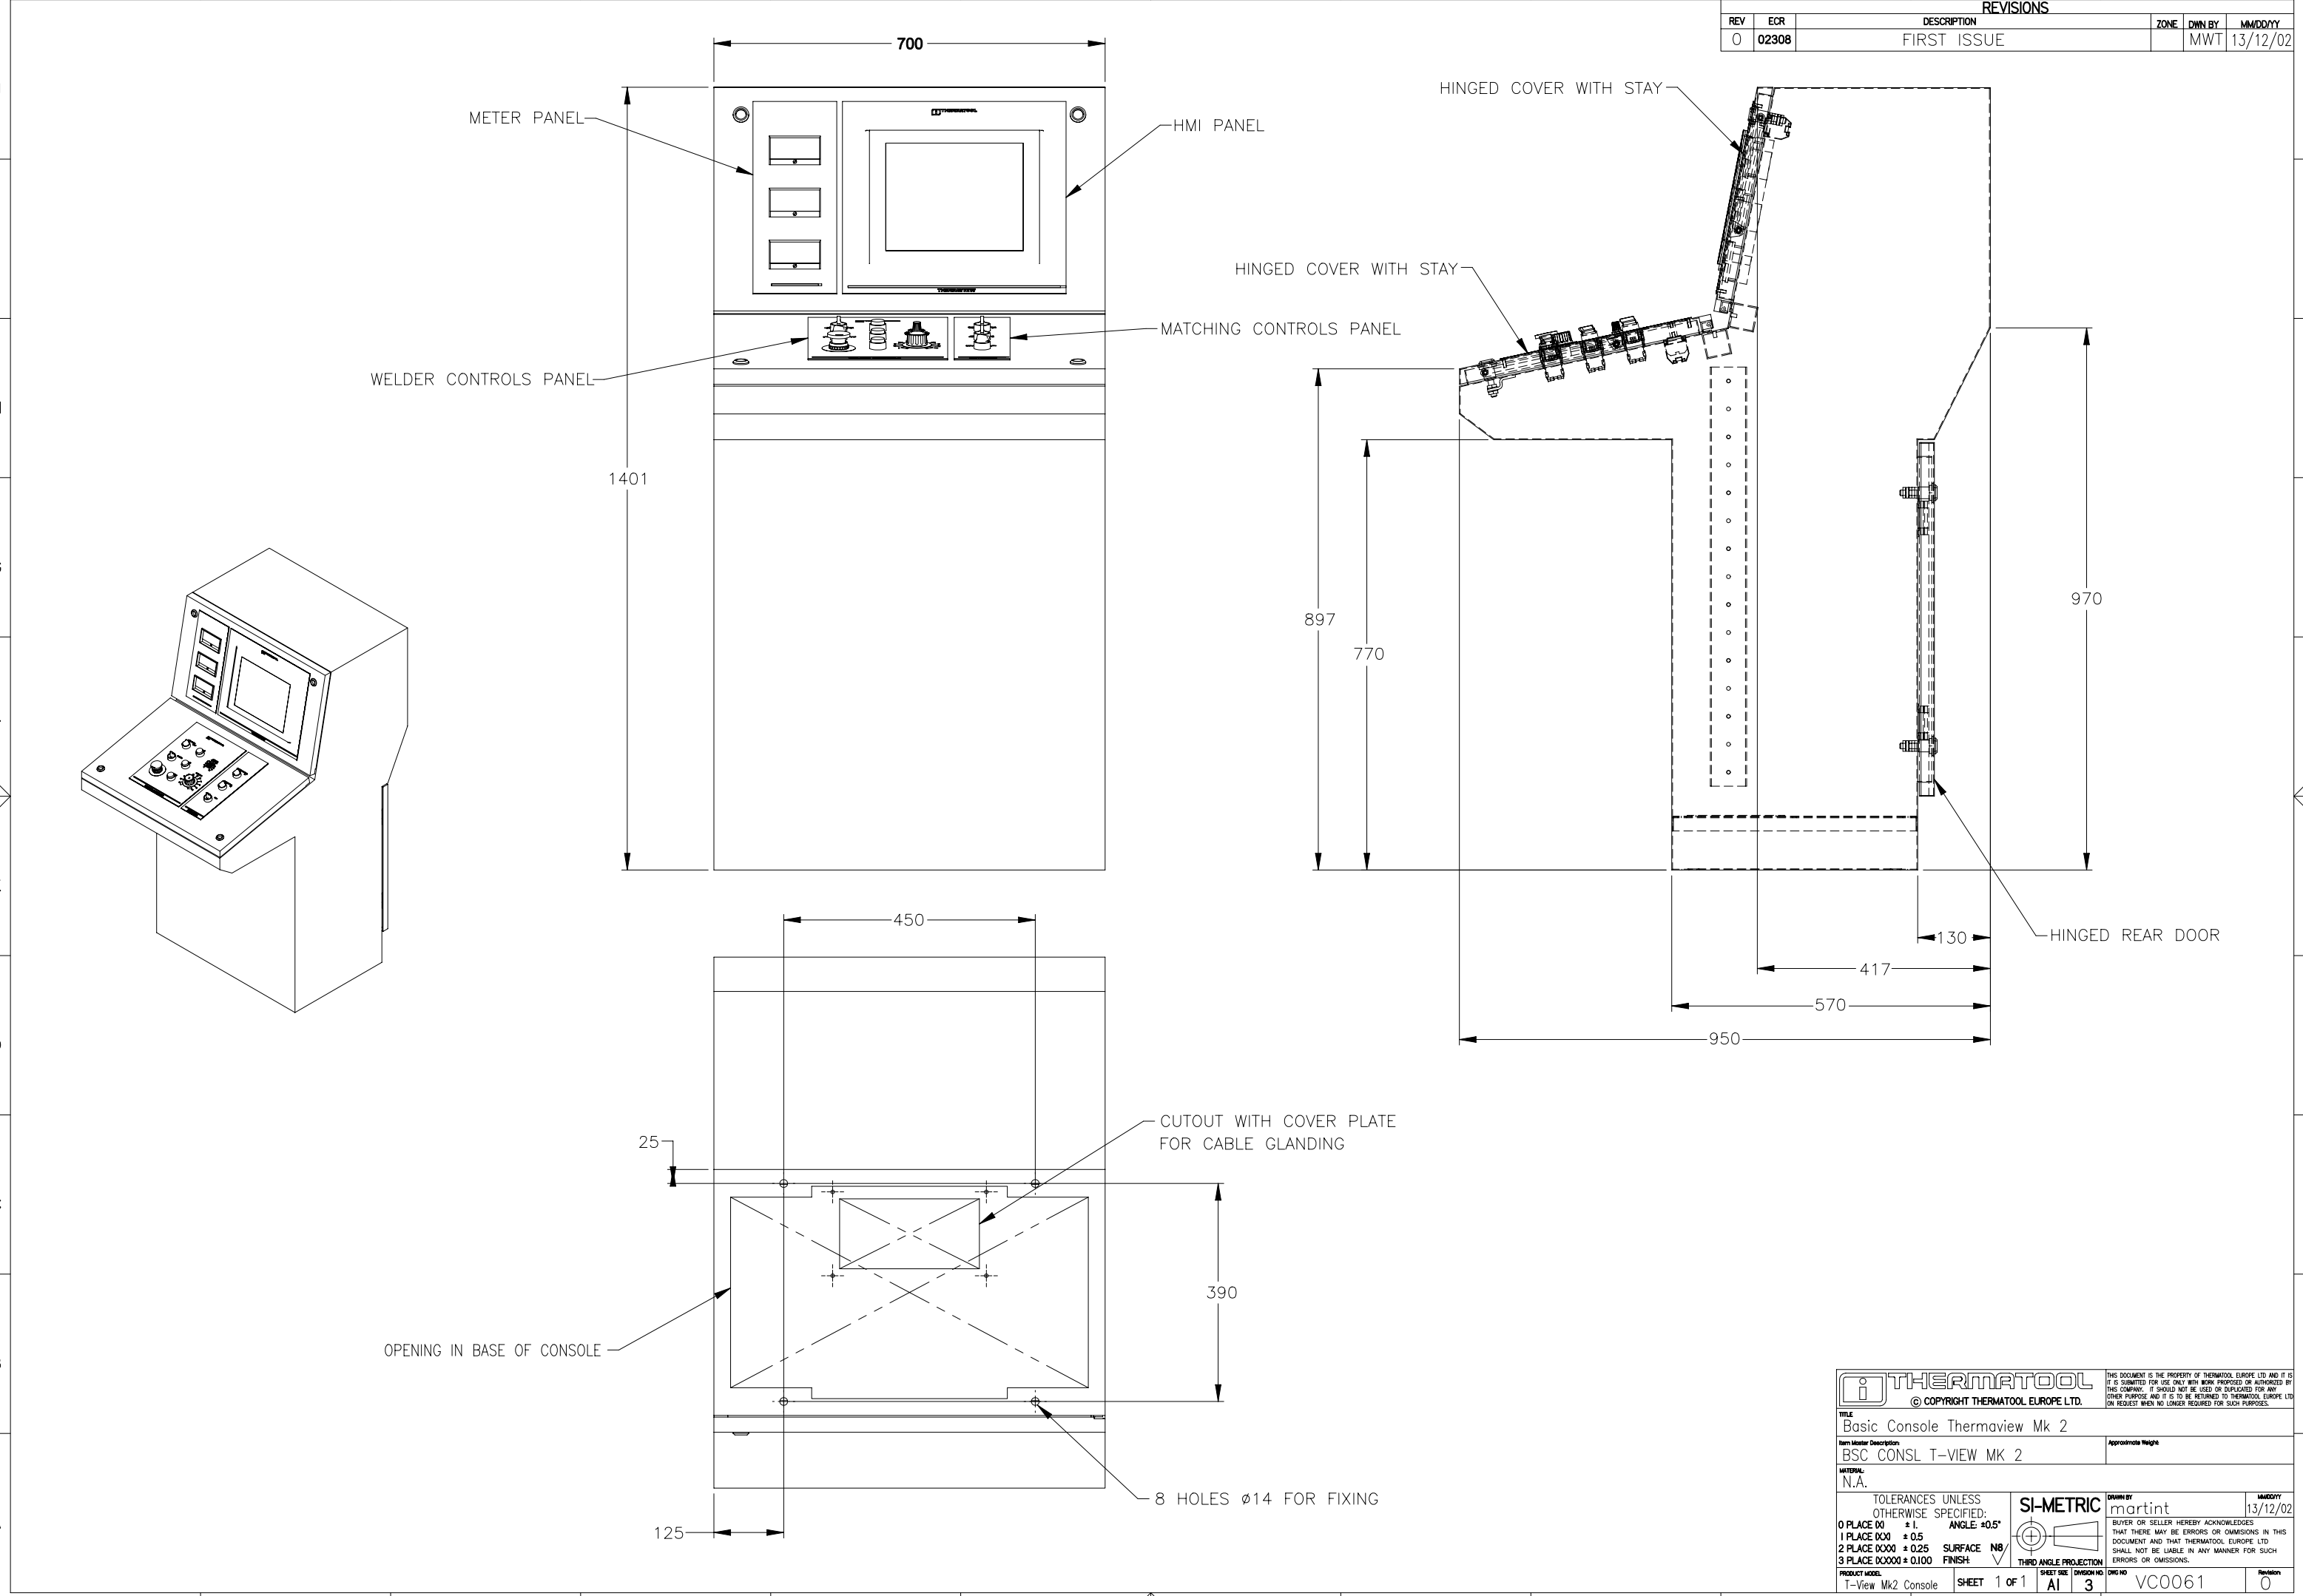

		<small>THIS DOCUMENT IS THE PROPERTY OF THERMATOOL EUROPE LTD AND IT IS NOT TO BE REPRODUCED OR TRANSMITTED IN ANY FORM OR BY ANY MEANS, ELECTRONIC OR MECHANICAL, INCLUDING PHOTOCOPYING, RECORDING, OR BY ANY INFORMATION STORAGE AND RETRIEVAL SYSTEM, WITHOUT THE WRITTEN PERMISSION OF THERMATOOL EUROPE LTD.</small>	
TITLE Basic Console Thermaview Mk 2			
Item Master Description BSC CONSL T-VIEW MK 2		Approximate Weight N.A.	
MATERIAL N.A.		TOLERANCES UNLESS OTHERWISE SPECIFIED: 0 PLACE 00 ± 1.0 1 PLACE 000 ± 0.5 2 PLACE 0000 ± 0.25 3 PLACE 00000 ± 0.100	
SI-METRIC		THIRD ANGLE PROJECTION	
PRODUCT MODEL T-View Mk2 Console		REVISION 0	
SHEET 1 OF 1		DWG NO VC0061	

REVISIONS									
REV	ECR	DESCRIPTION	ZONE	DWN	CHK	APPD	MM/DD/YY		
A	05212	REVISED PICTORIALY		BWH			31OCT05		

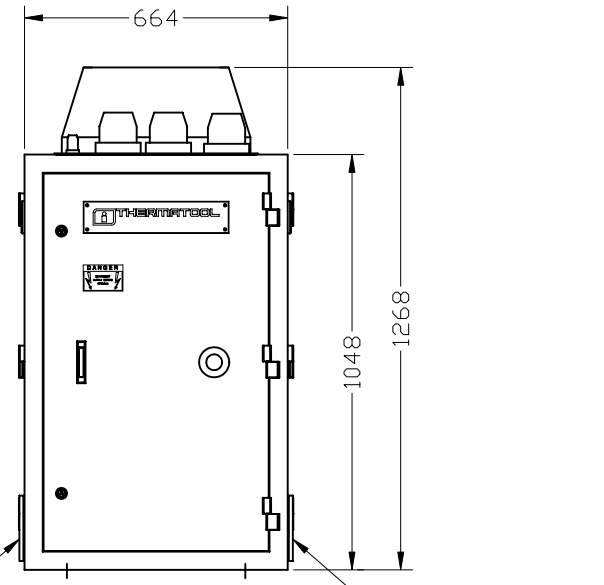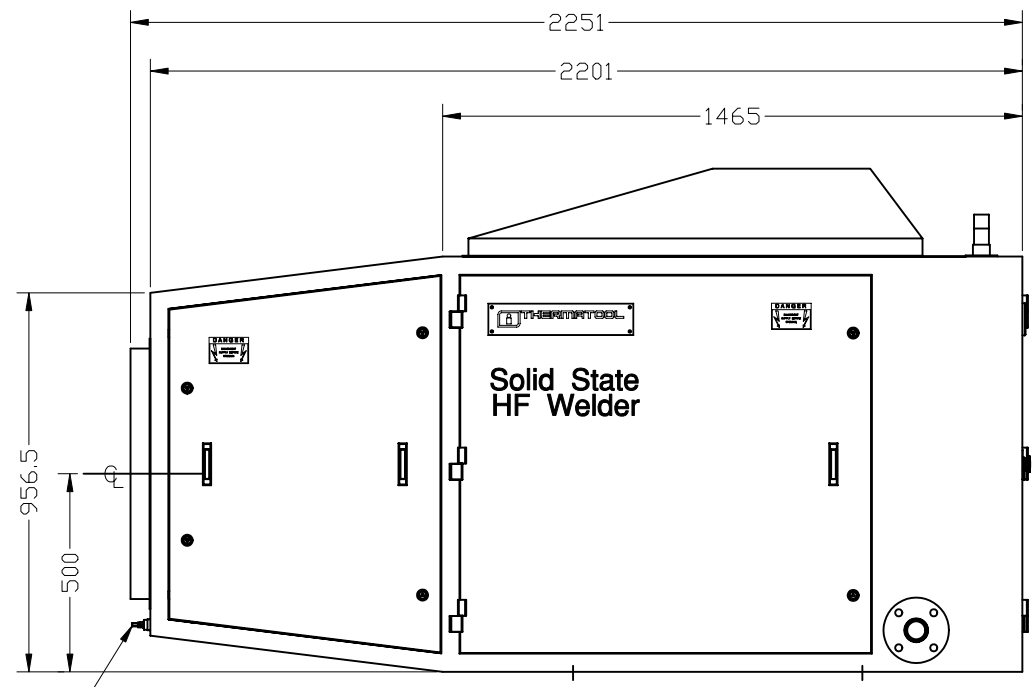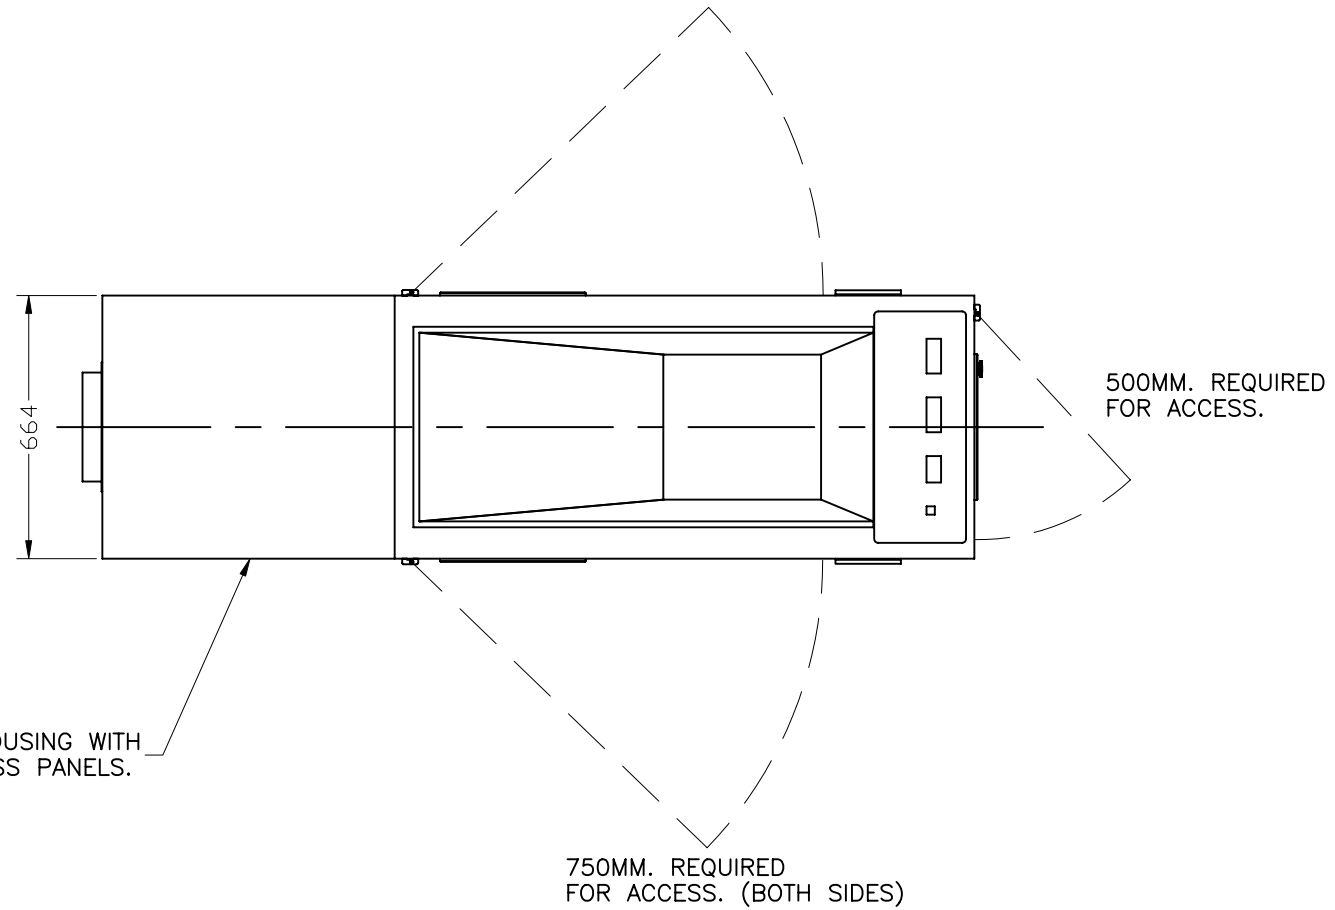

ALL 3 CABINET DOORS MAY BE LIFTED OFF THEIR HINGES IF REQUIRED.

UNLESS OTHERWISE SPECIFIED DIMENSIONS ARE IN MILLIMETERS		APPROVALS		DD/MM/YY
TOLERANCES ON		DWN	JAF	23/1/98
0 PLACE (X)	± 0.5	CHK		
1 PLACE (X.X)	± 0.3	ENG/APPD		
2 PLACE (X.XX)	± 0.15	MATL		
ANGLE ± 0°30'		FINISH/HEAT TREAT		
SURFACE FINISH N8				
BREAK AND DEBURR ALL SHARP EDGES				
UNIT		THIRD ANGLE PROJECTION		
BUYER OR SELLER HEREBY ACKNOWLEDGES THAT THERE MAY BE ERRORS OR OMISSIONS IN THIS DOCUMENT AND THAT THERMATOOL EUROPE LTD SHALL NOT BE LIABLE IN ANY MANNER FOR SUCH ERRORS OR OMISSIONS.				
©Copyright THERMATOOL EUROPE LTD				


THERMATOOL®

TITLE: **BASIC DIMENSIONS RF12 CABINET**


SIZE: A1 | DIV NO: 3 | DWG NO: **WD0076** | REV: A

SCALE: 1:10 | DO NOT SCALE DRAWING COPY | SHEET 1 OF 1

REVISIONS												
REV	ECR	DESCRIPTION	ZONE	DWN	CHK	APPD	MM/DD/YY					
A	261	OPTIONAL PFC GLAND PLATE ADDED	9C	TAT	AB	AB	04/20/99					
B	05212	CUTOUT DIMS REVISED		BWH			270CT05					

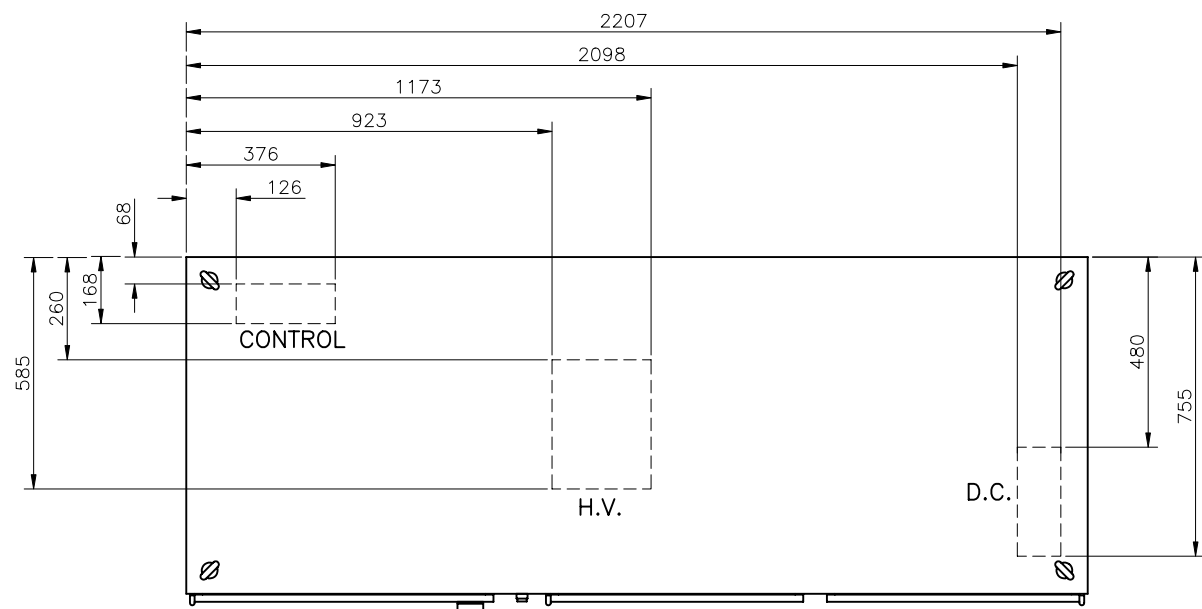


DETAIL OF BASE CUTOUTS.

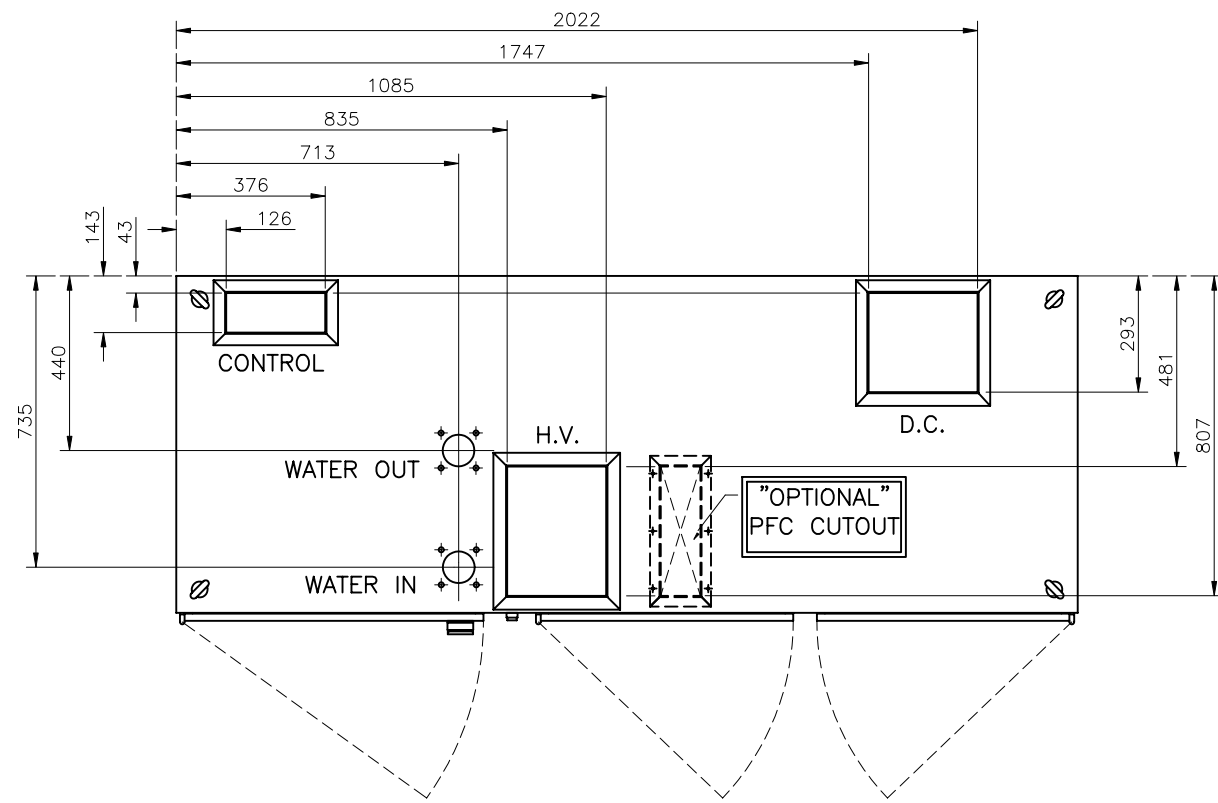


750MM. REQUIRED FOR ACCESS.

NOTE:
DOORS MAY BE LIFTED OFF HINGES IF REQUIRED.

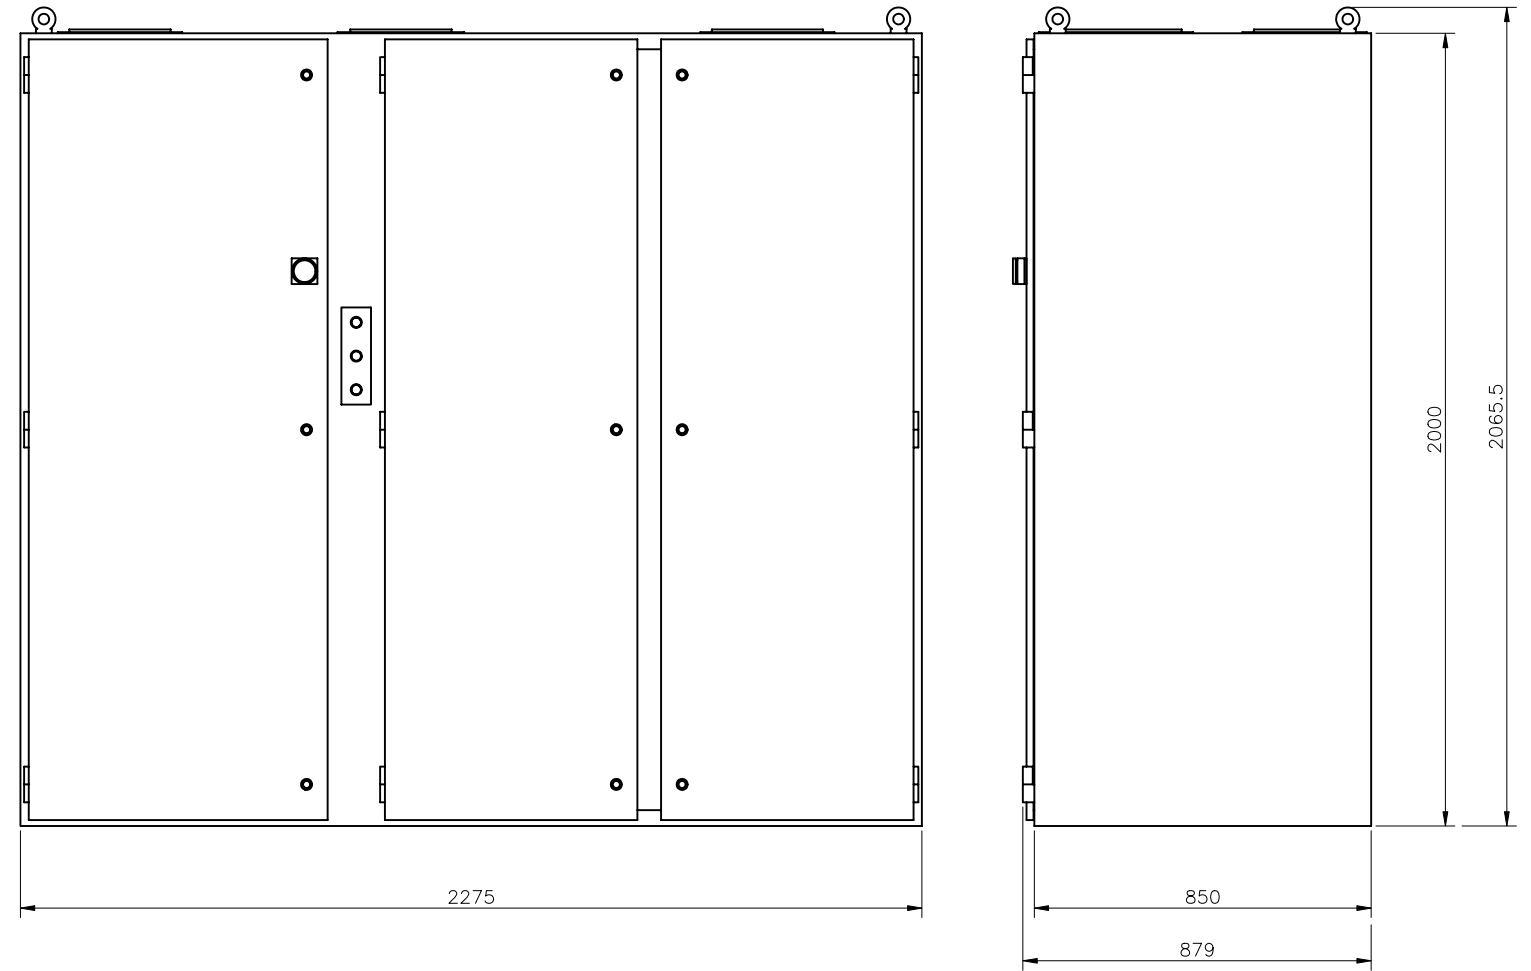


UNLESS OTHERWISE SPECIFIED DIMENSIONS ARE IN MILLIMETERS		APPROVALS		DD/MM/YY			
TOLERANCES ON		MWT		01/26/95			
0 PLACE (X) ± 0.5 ANGLE ± 0°30'		CHK				TITLE BASIC DIMENSIONS CFI POWER SUPPLY 200 TO 350 KW	
1 PLACE (X.X) ± 0.3 SURFACE FINISH N8		ENG/APPD					
2 PLACE (X.XX) ± 0.15 FINISH		MATL		N.A.		SIZE DIV NO DWG NO REV A1 3 WD0077 B	
BREAK AND DEBURR ALL SHARP EDGES		FINISH/HEAT TREAT		N.A.			
NEXT ASSY JOB NO FIRST APPLICATION UNIT 200/350KW.		THIRD ANGLE PROJECTION 		SCALE 1:10 DO NOT SCALE DRAWING COPY SHEET 2 OF 2		ENG-REF:	
BUYER OR SELLER HEREBY ACKNOWLEDGES THAT THERE MAY BE ERRORS OR OMISSIONS IN THIS DOCUMENT AND THAT THERMATOOL EUROPE LTD SHALL NOT BE LIABLE IN ANY MANNER FOR SUCH ERRORS OR OMISSIONS. ©Copyright THERMATOOL EUROPE LTD							

REVISIONS									
REV	ECR	DESCRIPTION	ZONE	DWN	CHK	APPD	MM/DD/YY		
0	01302	FIRST ISSUE		AJH			12/01		
A	06115	NOW COVERS 50 > 350KW		MWT			15/05		
B	R023	REMOVE PLMA-E90-2 FROM THE PUMP INLET LINE		SB	DRH		26/06/12		

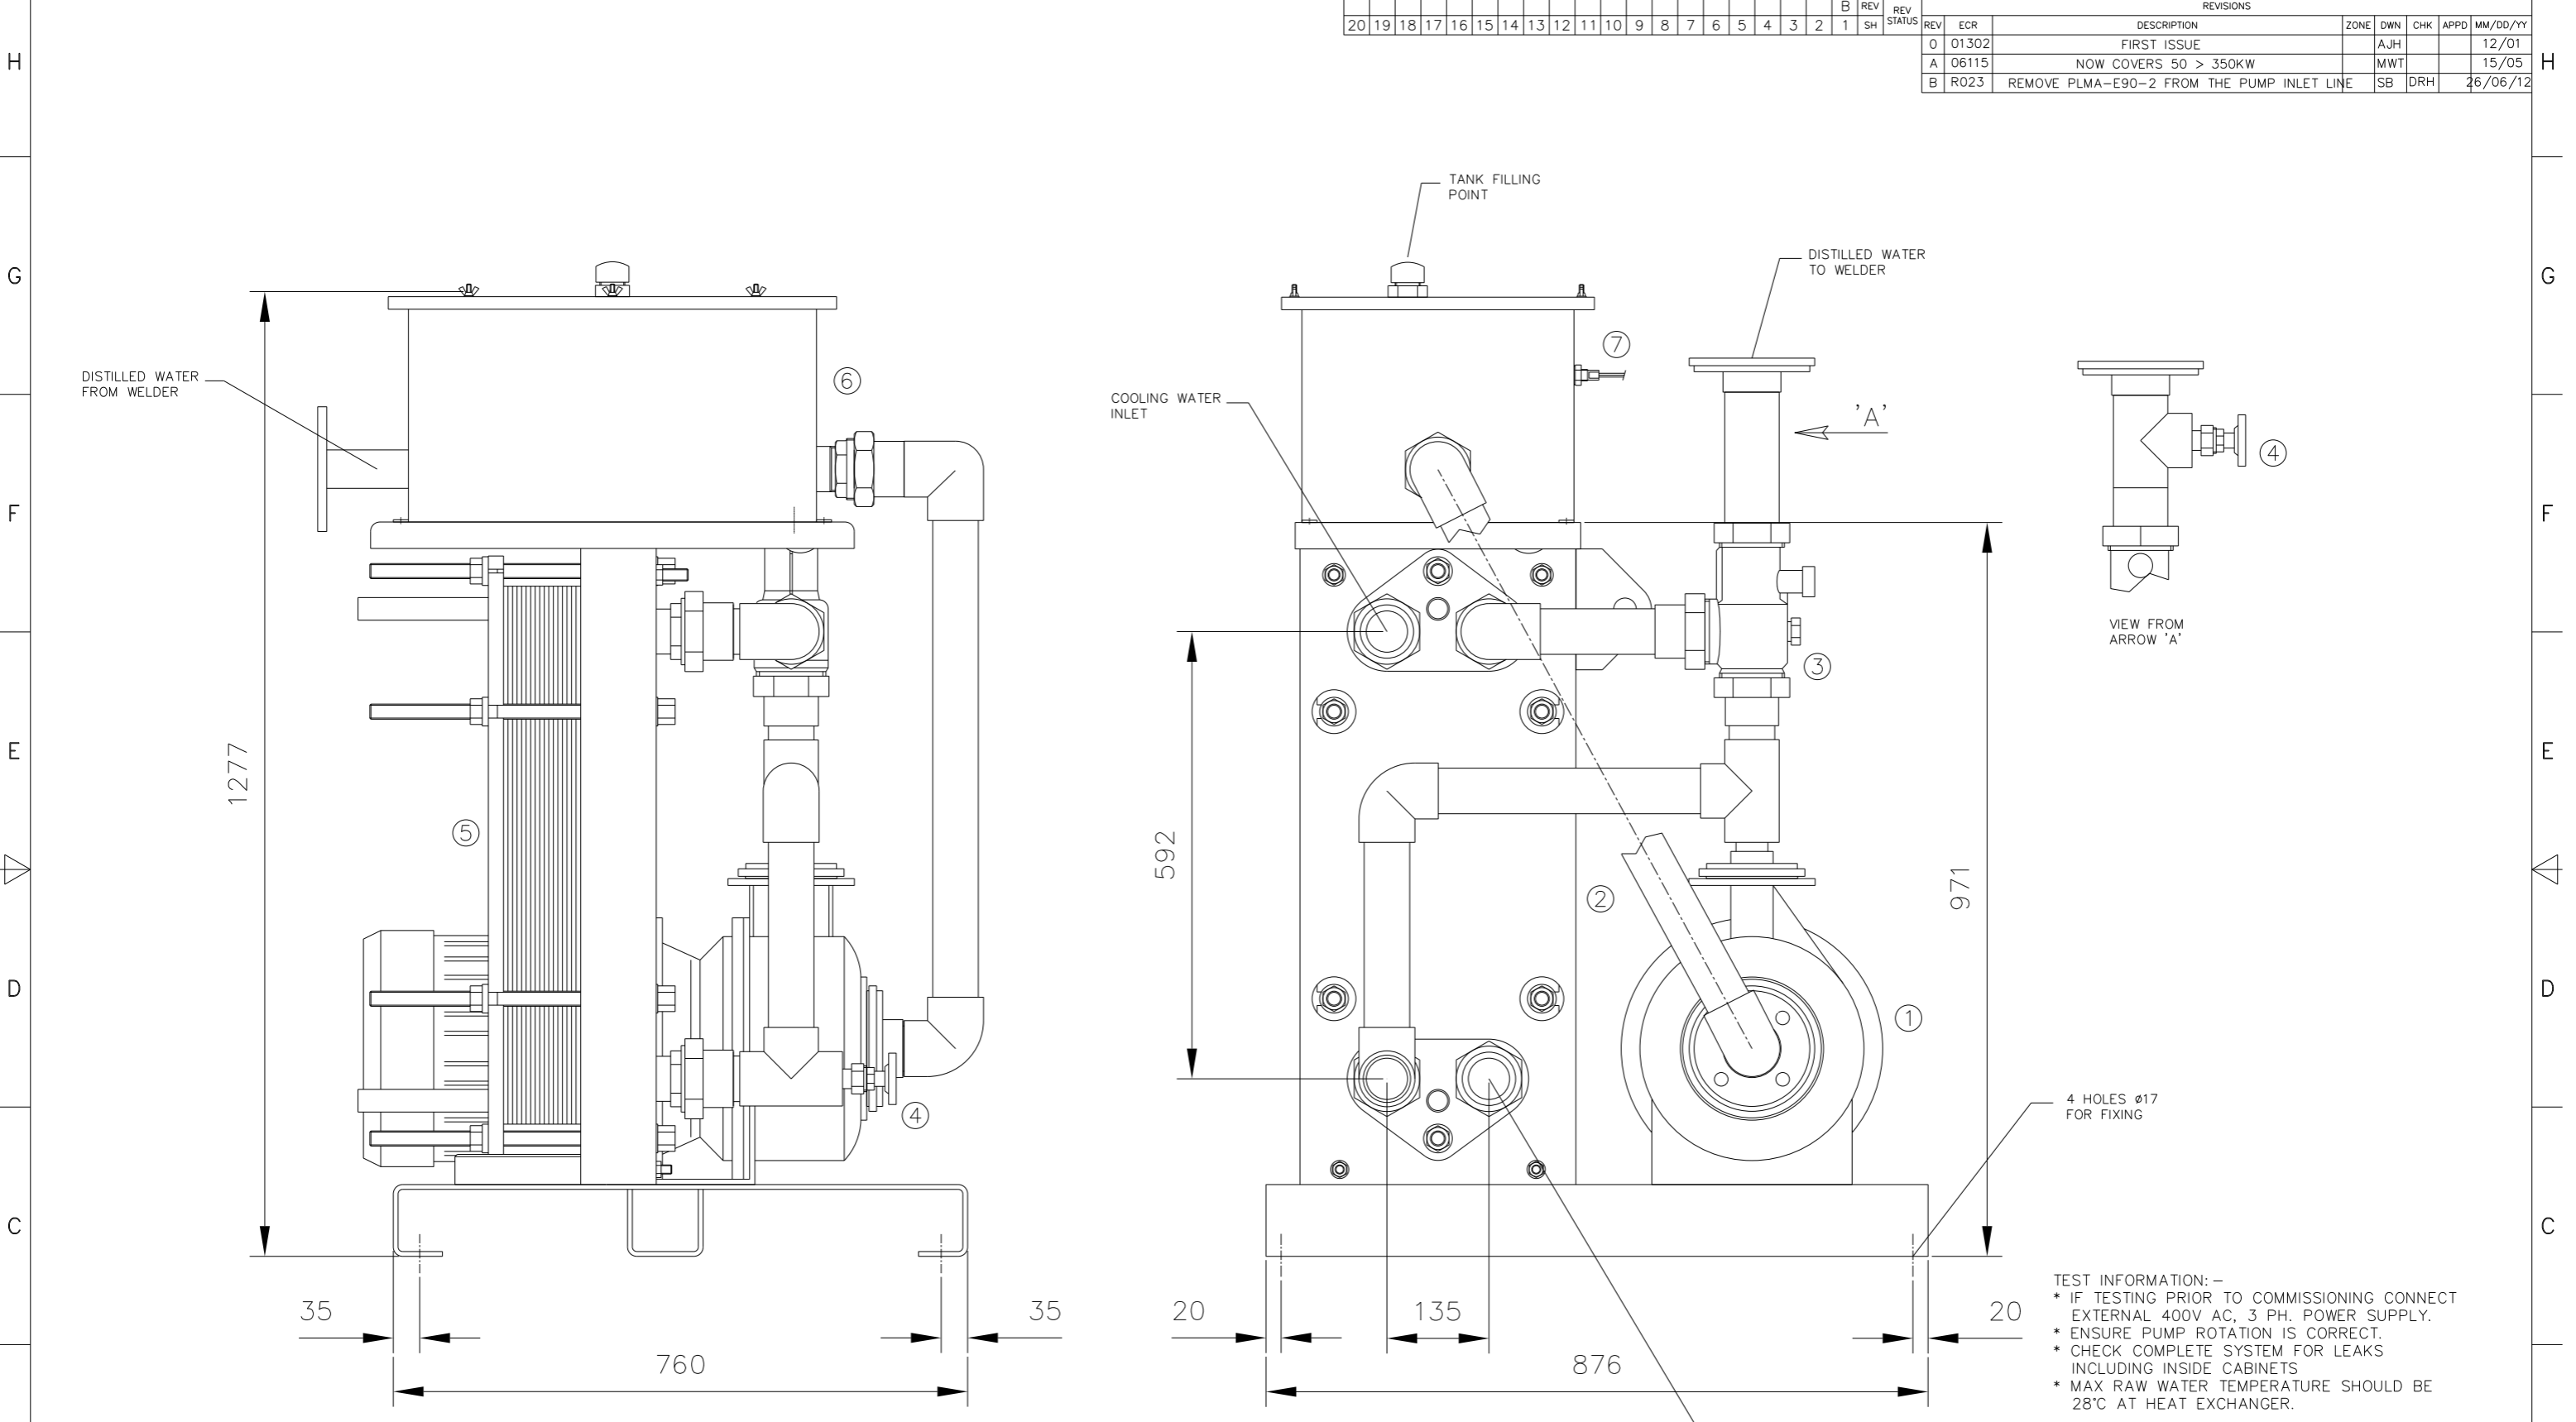

- COMPONENT LIST :-
- ① PUMP.
 - ② HEAT EXCHANGER FRAME.
 - ③ TEMPERATURE CONTROL VALVE.
 - ④ TEMPERATURE GAUGE.
 - ⑤ HEAT EXCHANGER.
 - ⑥ HEADER TANK WITH LID.
 - ⑦ HEADER TANK LEVEL SWITCH.

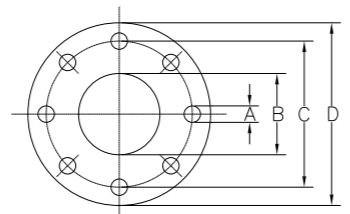

DIMENSIONS FOR METRIC FLANGES :-
 DRILLED TO BS4504 TABLE 16/3 - 10/3.
 OR BS10 TABLE D/E.


DIM.	1.25" FLANGE BS 4504	1.5" FLANGE BS 4504
A	14mm.	14mm.
B	42.2mm.	48.3mm.
C	100mm.	110mm.
D	140mm.	150mm.

DIM.	2" FLANGE BS 4504	3" FLANGE BS 10
A	18mm.	18mm.
B	60.3mm.	88.9mm.
C	125mm.	145mm.
D	166mm.	199mm.


TEST INFORMATION: -
 * IF TESTING PRIOR TO COMMISSIONING CONNECT
 EXTERNAL 400V AC, 3 PH. POWER SUPPLY.
 * ENSURE PUMP ROTATION IS CORRECT.
 * CHECK COMPLETE SYSTEM FOR LEAKS
 INCLUDING INSIDE CABINETS
 * MAX RAW WATER TEMPERATURE SHOULD BE
 28°C AT HEAT EXCHANGER.

UNLESS OTHERWISE SPECIFIED DIMENSIONS ARE IN MILLIMETERS TOLERANCES ON		APPROVALS		DD/MM/YY	
0 PLACE (X) ± 0.5 ANGLE ± 0°30'		DWN	AJH	07/06/01	
1 PLACE (X.X) ± 0.3 SURFACE N8/		CHK			
2 PLACE (X.XX) ± 0.15 FINISH		ENG/APPD			
BREAK AND DEBURR ALL SHARP EDGES		MATL	N.A.		
THIS DOCUMENT IS THE PROPERTY OF THERMATOOL EUROPE LTD AND IT IS SUBMITTED FOR USE ONLY WITH WORK PROPOSED OR AUTHORIZED BY THIS COMPANY. IT SHOULD NOT BE USED OR DUPLICATED FOR ANY OTHER PURPOSE AND IS TO BE RETURNED TO THERMATOOL EUROPE LTD ON REQUEST WHEN NO LONGER REQUIRED FOR SUCH PURPOSES.		FINISH/HEAT TREAT N.A.		TITLE BASIC DIMENSIONS HEAT EXCHANGER ASSEMBLY	
SI-METRIC THIRD ANGLE PROJECTION		SIZE	A1	DWG NO	WD0171
		DIV NO	3	REV	B
		SCALE	1:4	SHEET 1 OF 1	

THROUGH FLOW IMPEDORS.
(ENCLOSED FERRITE)
SEE TABLE FOR AVAILABLE SIZES

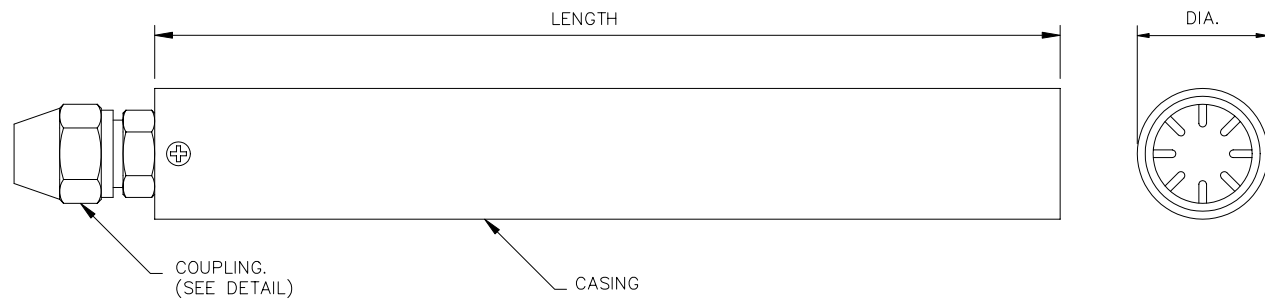


TYPE "C" IMPEDORS.
(EXPOSED FERRITE)
SEE TABLE FOR AVAILABLE SIZES

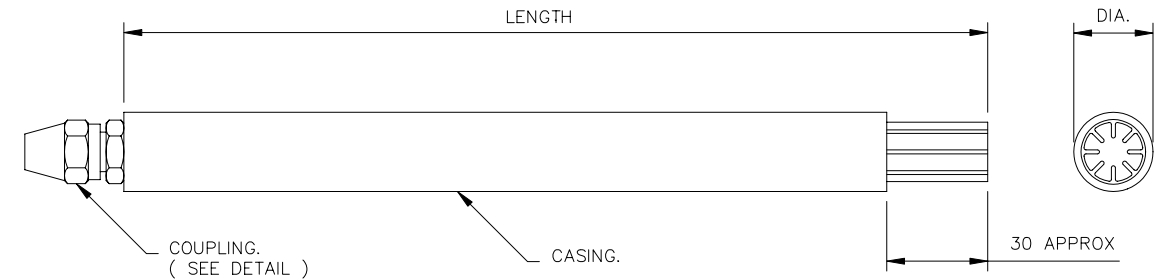


THROUGH FLOW IMPEDOR PART No.	EXPOSED "TYPE C" IMPEDOR PART No.	TUBE ID. (APPROX)	DIA. (mm)	LENGTH (mm)	COUPLING.	ADAPTOR No.
IM-44-1006		8	6.5	230	1/4-28 TPI	
IM-44-1008	IM-44-0008	9.5	8	230	1/4-28 TPI	
IM-44-1009	IM-44-0009	11	9	230	1/4-28 TPI	
IM-44-1010	IM-44-0010	12	10	230	1/4-28 TPI	
IM-44-1011	IM-44-0011	13	11	230	1/4-28 TPI	
IM-44-1012	IM-44-0012	14.5	12	230	1/4 FLARE	4
IM-44-1013		15.5	13	230	1/4 FLARE	4
IM-44-1014	IM-44-0014	17	14	230	1/4 FLARE	4
IM-44-1015		18	15	230	1/4 FLARE	4
IM-44-1016	IM-44-0016	19	16	230	1/4 FLARE	4
IM-44-1017		20.5	17	230	1/4 FLARE	4
IM-44-1018		21.5	18	230	1/4 FLARE	4
IM-44-1019	IM-44-0019	23	19	230	1/4 FLARE	4
IM-44-1020		24	20	230	1/4 FLARE	4
IM-44-1021		25	21	230	1/4 FLARE	4
IM-44-1022	IM-44-0022	26.5	22	230	1/4 FLARE	4
IM-44-1023		27.5	23	230	1/4 FLARE	4
IM-44-1024		29	24	230	1/4 FLARE	4
IM-44-1025	IM-44-0025	30	25	230	1/4 FLARE	4
IM-44-1028		33.5	28	230	3/8 FLARE	5
IM-44-1031		37	31	230	3/8 FLARE	5
IM-44-1034		41	34	230	1/2 FLARE	6
IM-44-1037		44.5	37	230	1/2 FLARE	6
IM-44-1040		48	40	230	1/2 FLARE	6
IM-44-1343		51.5	43	330	1/2 FLARE	6
IM-44-1350		60	50	330	5/8 FLARE	7
IM-44-1357		68.5	57	330	5/8 FLARE	7
IM-44-1364		77	64	330	5/8 FLARE	7
IM-44-1370		84	70	330	5/8 FLARE	7
IM-44-1376		91	76	330	5/8 FLARE	7
IM-44-1489		107	89	432	1 NPT	
IM-44-1410		122.5	102	432	1 NPT	

REV	ECR	DESCRIPTION	ZONE	DWN	CHK	APPD	MM/DD/YY
0	03203	FIRST ISSUE		BWH			05FEB03
A	07068	PARTS UPDATED AND ADDED AS PER SPARES LISTING		BWH			26MAR07
B	09090	ADAPTOR DIMENSIONS ADDED		TB			18AUG09
C	-	AMEND / CLARIFY ADAPTOR DIMS		TAT			10AUG10

COUPLING	THREAD SIZE. UNF.	TUBE OD.
1/4 FLARE	7/16in.	1/4in. 6.3mm.
3/8 FLARE	5/8in.	3/8in. 9.5mm.
1/2 FLARE	3/4in.	1/2in. 12.7mm.
5/8 FLARE	7/8in.	5/8in. 15.8mm.

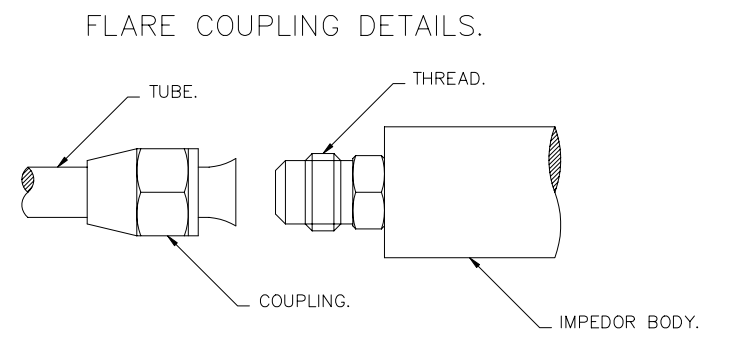

ADAPTOR No.	UNF. THREAD.	METRIC THREAD	"A" mm	"B" mm
1	1/4-28	M6.		
2	5/16-24	M6.		
3	3/8-24	M8.		
4	7/16-20	M10.	12.7	14
5	5/8-18	M16.	27	30
6	3/4-16	M20.	27	30
7	7/8-14	M20.	27	30

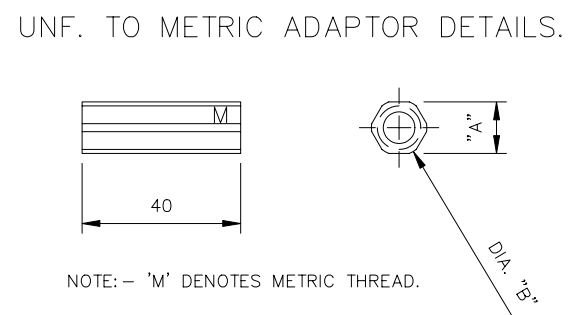


NOTE: -
FOR OPTIMUM WORKING CONDITIONS
IMPEDOR OD. + 20% = TUBE ID.

UNLESS OTHERWISE SPECIFIED DIMENSIONS ARE IN MILLIMETERS TOLERANCES ON		APPROVALS		DD/MM/YY	
0 PLACE (X) ± 0.5 ANGLE ± 0°30'		DWN BWH		05FEB04	
1 PLACE (X.X) ± 0.3 SURFACE FINISH N8		CHK			
2 PLACE (X.XX) ± 0.15 BREAK AND DEBURR ALL SHARP EDGES		ENG/APPD			
©Copyright THERMATOOL EUROPE LTD		MATL			
THIRD ANGLE PROJECTION		FINISH/HEAT TREAT			
THERMATOOL®		TITLE			
SI-METRIC		THROUGH FLOW IMPEDORS (BASIC DIMENSIONS)			
SCALE 1:1		SIZE A1		DIV NO 3	
DO NOT SCALE DRAWING COPY		DWG NO WD5066		REV C	
SHEET 1 OF 2		SCALE 1:1		DO NOT SCALE DRAWING COPY	

RETURN FLOW IMPEDOR.


COOLANT FLOW DETAILS.
COOLANT ENTERS ALONG CENTRAL BORE OF FERRITE ROD
AND RETURNS VIA SPACE BETWEEN FERRITE ROD AND
IMPEDOR CASING ID.

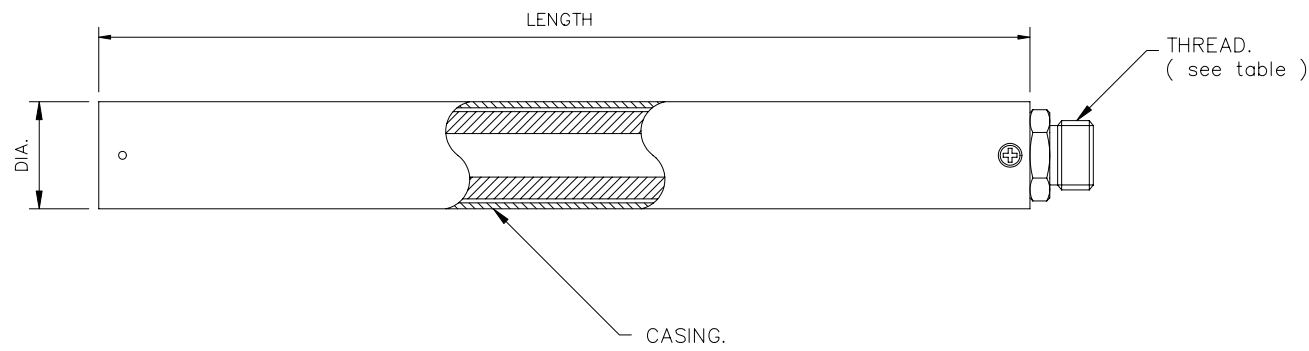


PART No.	TUBE ID. (APPROX) (mm)	DIA. (mm)	LENGTH (mm)	COUPLING No.	THREAD (in)
IM-44-3009	11	9	230	2	3/8-24
IM-44-3010	12	10	230	2	3/8-24
IM-44-3011	13	11	230	2	3/8-24
IM-44-3012	14.5	12	230	2	3/8-24
IM-44-3013	15.5	13	230	3	7/16-24
IM-44-3014	17	14	230	3	7/16-24
IM-44-3015	18	15	230	3	7/16-24
IM-44-3016	19	16	230	3	7/16-24
IM-44-3017	20.5	17	230	3	7/16-24
IM-44-3018	21.5	18	230	3	7/16-24
IM-44-3019	23	19	230	3	7/16-24
IM-44-3020	24	20	230	3	7/16-24
IM-44-3021	25	21	230	3	7/16-24
IM-44-3022	26.5	22	230	3	7/16-24
IM-44-3023	27.5	23	230	3	7/16-24
IM-44-3024	29	24	230	3	7/16-24
IM-44-3025	30	25	230	3	7/16-24
IM-44-3028	33.5	28	230	3	7/16-24
IM-44-3031	37	31	230	3	7/16-24
IM-44-3034	41	34	230	4	13/16-18
IM-44-3037	44.5	37	230	4	13/16-18
IM-44-3040	48	40	230	4	13/16-18
IM-44-3143	51.5	43	330	4	13/16-18
IM-44-3250	60	50	330	5	15/16-18
IM-44-3157	68.5	57	330	5	15/16-18
IM-44-3163	76	63.5	330	5	15/16-18
IM-44-3169	84	69.85	330	5	15/16-18
IM-44-3176	91.5	76.20	330	5	15/16-18

NOTE:-
FOR COUPLING DETAILS SEE VIEWS OPPOSITE.
FOR OPTIMUM WORKING CONDITIONS
IMPEDOR OD. + 20% = TUBE ID.


REVISIONS									
REV	ECR	DESCRIPTION	ZONE	DWN	CHK	APPD	MM/DD/YY		
0	03203	FIRST ISSUE		BWH			05FEB03		
A	07068	PARTS UPDATED AND ADDED AS PER SPARES LISTING		BWH			26MAR07		

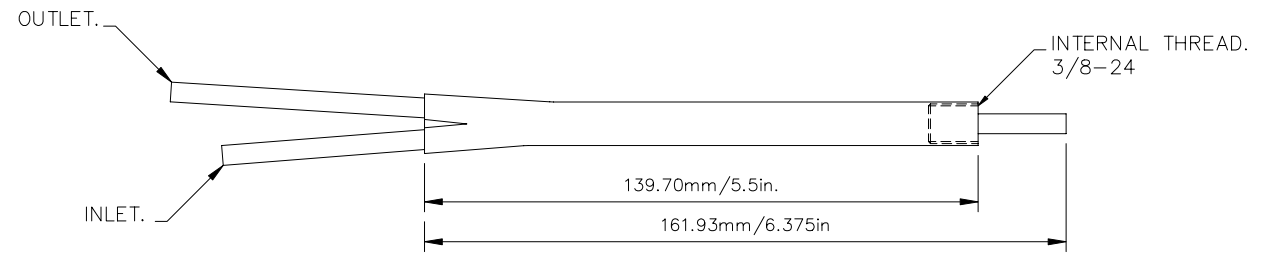


COUPLING No. 2 (IM-44-4002)

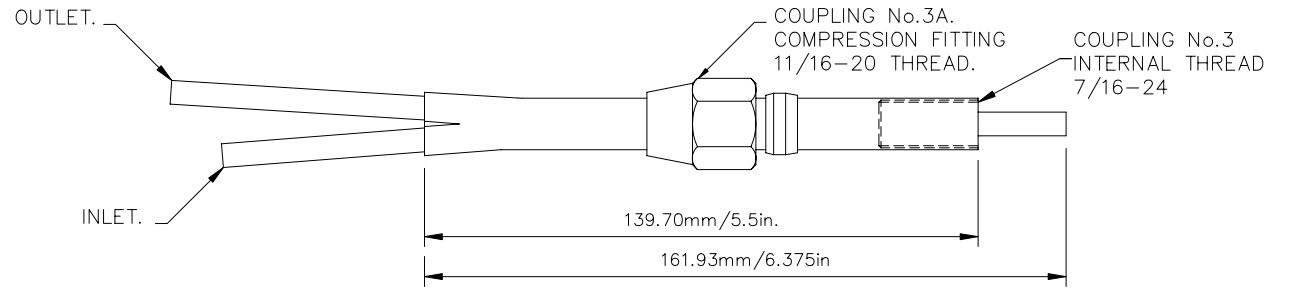

COUPLING No. 3,3A (IM-44-4003)

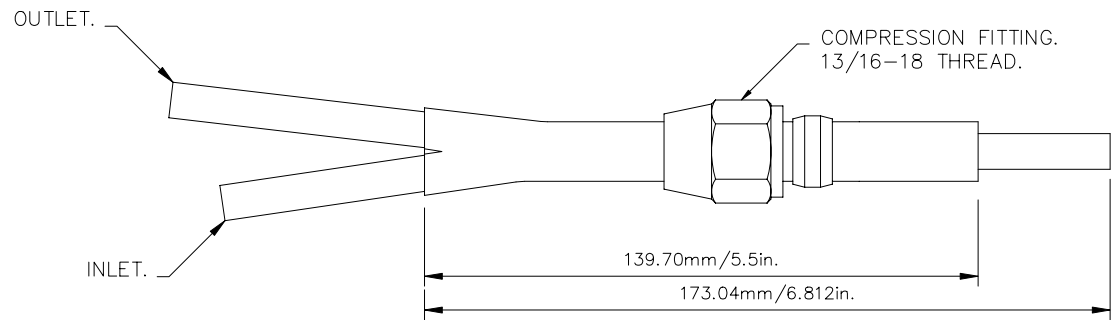

COUPLING No. 4 (IM-44-4004)


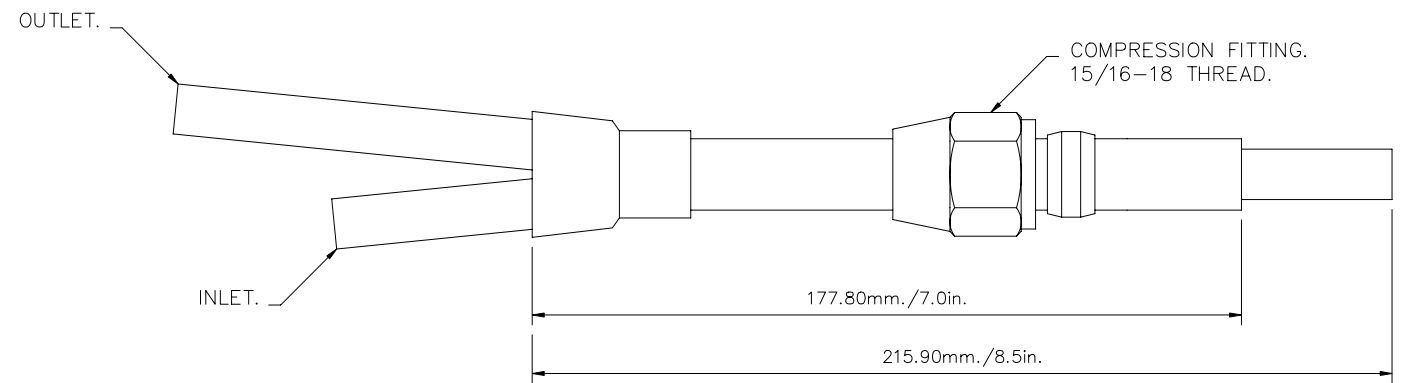


COUPLING No. 5 (IM-44-4005)

UNLESS OTHERWISE SPECIFIED DIMENSIONS ARE IN MILLIMETERS		APPROVALS		DD/MM/YY	
TOLERANCES ON		DWN		05FEB04	
0 PLACE (X) ± 0.5 ANGLE ± 0°30'		CHK		BWH	
1 PLACE (X.X) ± 0.3 SURFACE FINISH N8		ENG/APPD			
2 PLACE (X.XX) ± 0.15 BREAK AND DEBURR ALL SHARP EDGES		MATL			
©Copyright THERMATOOL EUROPE LTD		FINISH/HEAT TREAT			
THIS DOCUMENT IS THE PROPERTY OF THERMATOOL EUROPE LTD AND IT IS SUBMITTED FOR USE ONLY WITH WORK PROPOSED OR AUTHORIZED BY THIS COMPANY. IT SHOULD NOT BE USED OR DUPLICATED FOR ANY OTHER PURPOSE AND IS TO BE RETURNED TO THERMATOOL EUROPE LTD ON REQUEST WHEN NO LONGER REQUIRED FOR SUCH PURPOSES.		THIRD ANGLE PROJECTION		THERMATOOL®	
SI-METRIC		TITLE		RETURN FLOW IMPEDORS (BASIC DIMENSIONS)	
SCALE 1:1		SIZE DIV NO DWG NO		A1 3 WD5067	
DO NOT SCALE DRAWING COPY		SHEET		1 OF 2	
ENG-REF: Supersedes WD0081 Rev A		REV		A	

REVISIONS					
REV	ECR	DESCRIPTION	ZONE	DWN BY	MM/DD/YY
0	06155	FIRST ISSUE		MWT	06/29/06
A		CONFIGURATION RELEASE		XXX	MM/DD/YY
B	11440	ON WU5262-002 DELETED ITEM 10 WL5161 QTY.-2 AND ADDED ITEM 29 WL5161 QTY.-2.	A6	RRR	05/01/08
		ON WU5262-004 DELETED ITEM 10 WL5161 QTY.-2.	D6		

SD

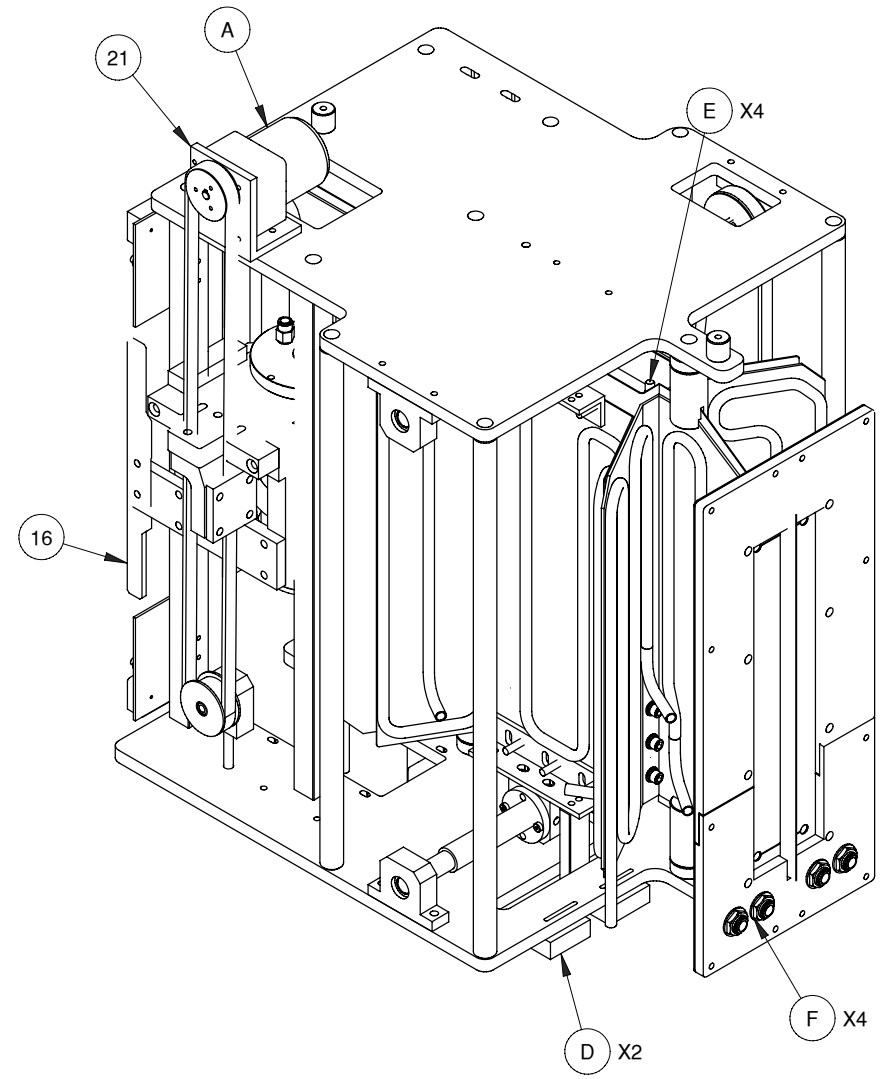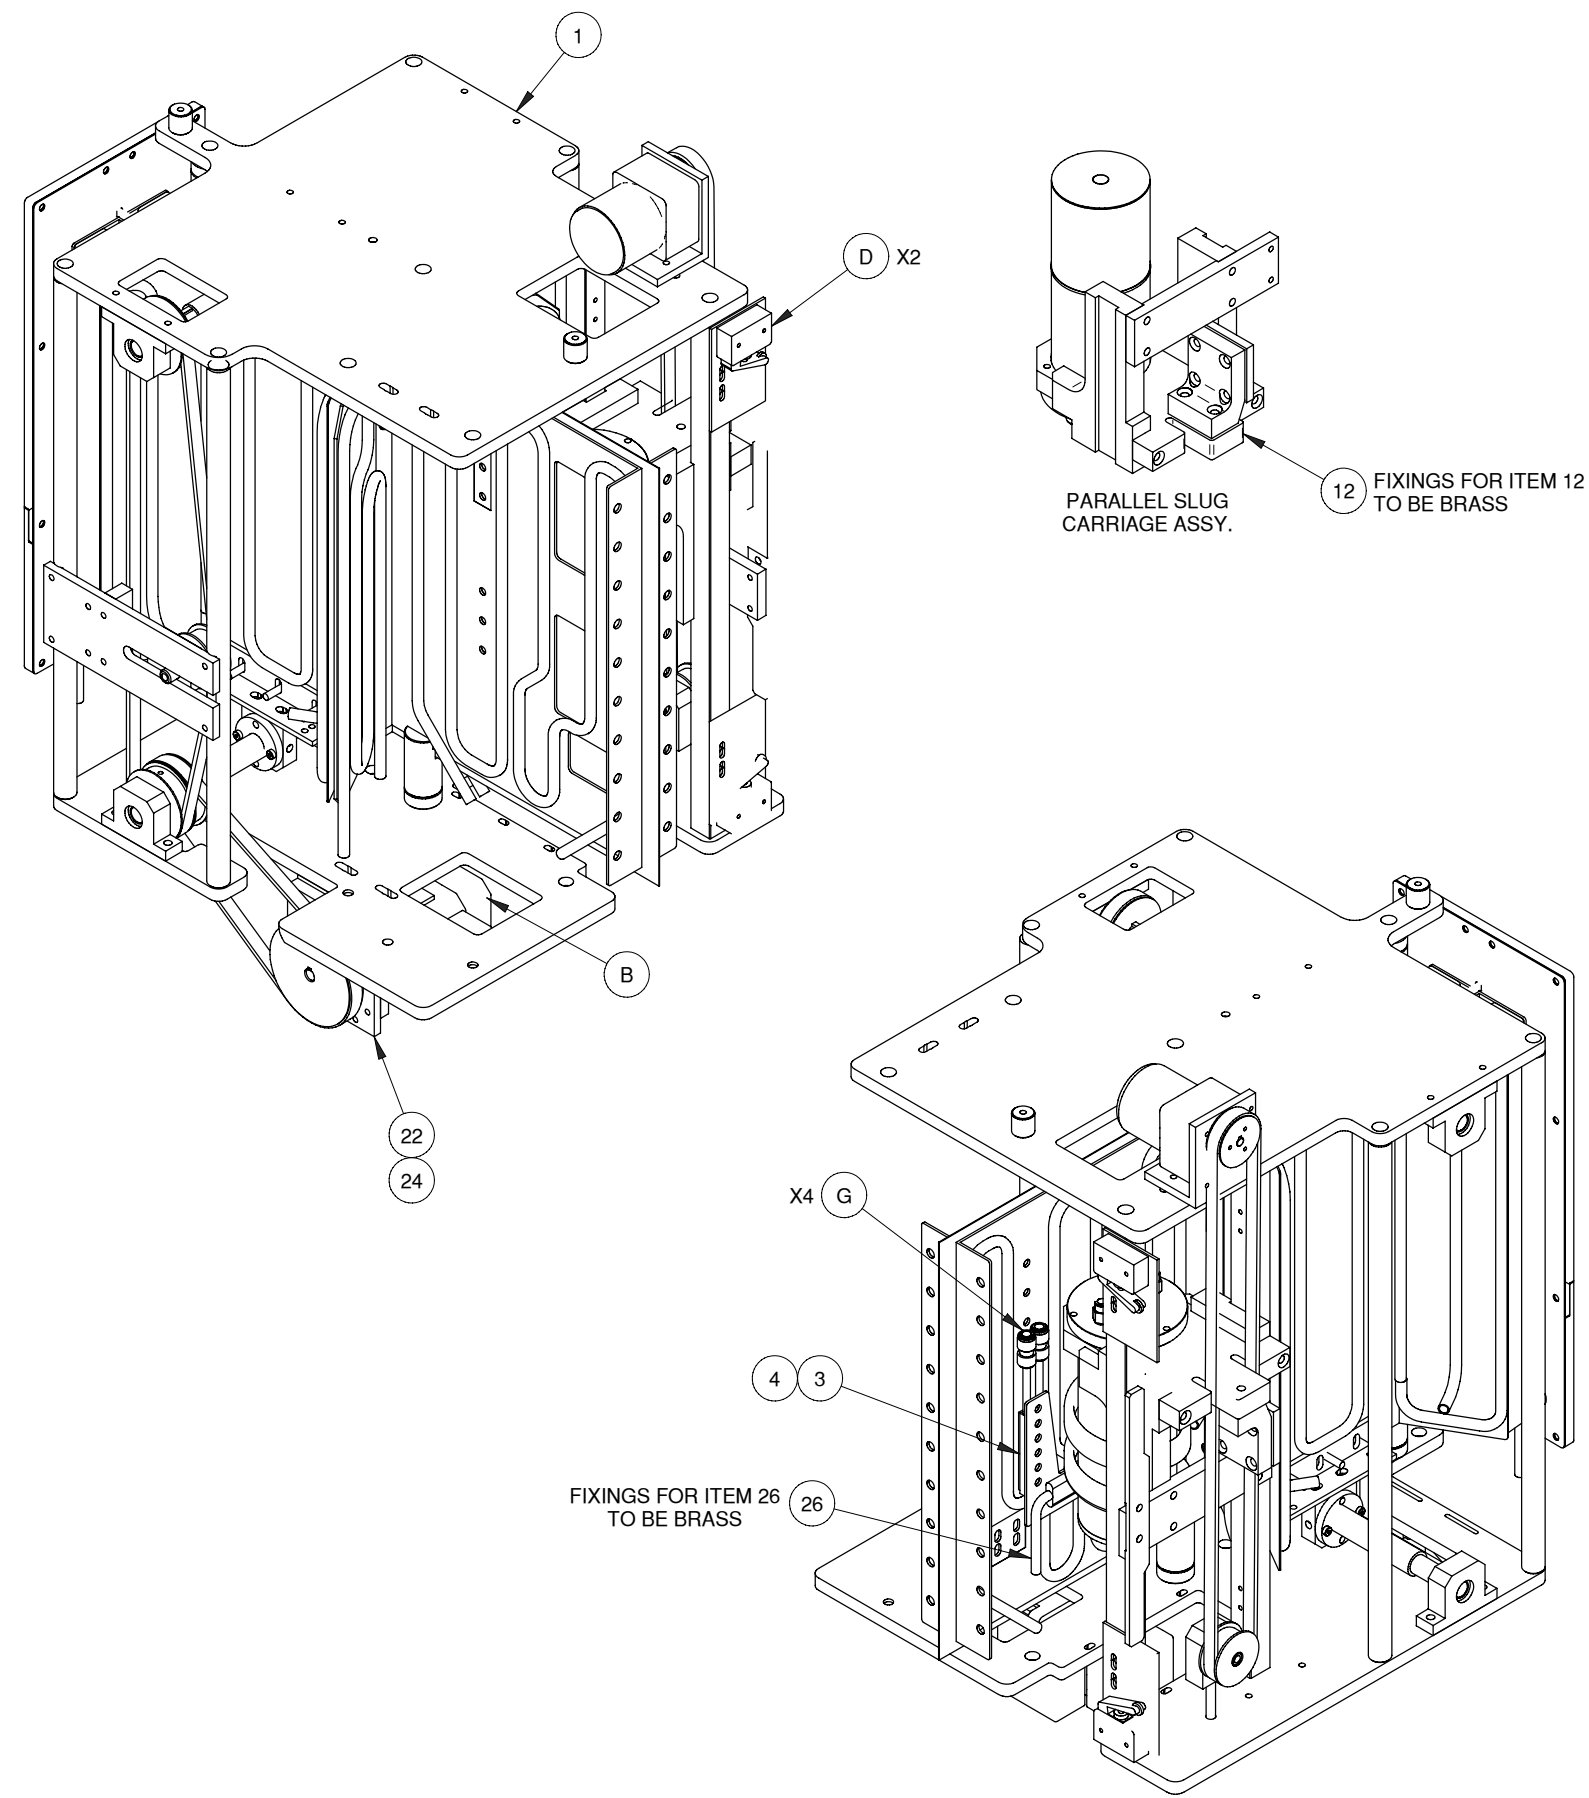

HF12 AUTOMATCH ASSY.
WU5262-001
UK STD. BUILD

NOTE:-
ALL FIXINGS UNLESS OTHERWISE STATED
TO BE NON-MAGNETIC (304) STAINLESS STEEL.

		<small>THIS DOCUMENT IS THE PROPERTY OF THERMATOOL EUROPE LTD AND IT IS SUBMITTED FOR USE ONLY WITH WORK PROPOSED OR AUTHORIZED BY THIS COMPANY. IT SHOULD NOT BE USED OR DUPLICATED FOR ANY OTHER PURPOSE AND IT IS TO BE RETURNED TO THERMATOOL EUROPE LTD ON REQUEST WHEN NO LONGER REQUIRED FOR SUCH PURPOSES.</small>	
HF12 Automatch Assy		<small>Approximate Weight</small> 41.4 kg	
<small>Item Master Description</small> HF12 AMATCH ASSY		<small>Thermatool Material Code</small> See BOM	
<small>TOLERANCES UNLESS OTHERWISE SPECIFIED.</small> 0 PLACE 00 ± 1. ANGLE: ±0.5° 1 PLACE 0X0 ± 0.5 2 PLACE 0X00 ± 0.25 SURFACE NB/ 3 PLACE 0X000 ± 0.125 FINISH		<small>SI-METRIC</small> 	<small>Drawn By</small> martint
<small>BUYER OR SELLER HEREBY ACKNOWLEDGES THAT THERE MAY BE ERRORS OR OMISSIONS IN THIS DOCUMENT AND THAT THERMATOOL EUROPE LTD SHALL NOT BE LIABLE IN ANY MANNER FOR SUCH ERRORS OR OMISSIONS.</small>		<small>THIRD ANGLE PROJECTION</small> 	<small>MM/DD/YY</small> 05/01/08
<small>PRODUCT MODEL</small> CFI	<small>SHEET NO. OF TOTAL SHEETS</small> 1 OF 4	<small>DWG NO.</small> WU5262	<small>Revision</small> B

Title		HF12 AUTOMATCH ASSEMBLY					B.O.M. No. WU5262								
Machine Type		CFI HF12					Revision E								
For Assy. Drg. See		WU5262					Date 11/10/13								
							QUANTITY								
Item No.	Drawing No.	Warehouse No.	TT Part No.	DESCRIPTION	Supplier Part No.	Circuit Reference	Comm	UK STD		UK V/F		USA STD		USA V/F	
								-001		-002		-003		-004	
1	WU5261	-		HF12 BASIC AUTOMATCH ASSY. (CHINA)	-	-	1	-		-		-		-	
2	WL0833	-		PARALLEL COIL ASSY.	-	-	-	-		1		-		1	
3	WL1994	-	WL1994-001	PARALLEL COIL MTG. BLOCK	-	-	1	-		-		-		-	
4	WL1994	-	WL1994-002	PARALLEL COIL MTG. BLOCK	-	-	-	1		2		1		2	
5	WL0734	-		BELT TENSIONER ASSY.	-	-	-	-		1		-		1	
6	WL5162	-		TENSIONER WHEEL	-	-	-	-		1		-		1	
7	WL2184	-	WL2184-002	PARALLEL TENSIONER PIN	-	-	-	-		1		-		1	
8	WL5138	-		VERTICAL GUIDES	-	-	-	-		2		-		2	
9	WL2221	-		PULLEY, 18T, 10 PITCH, 10 BORE	-	-	-	-		1		-		1	
10					-	-									
11	WL2183	-		TOP PLATE PARALLEL SLUG ASSY	-	-	-	-		1		-		1	
12	WU5120	-		PARALLEL SLUG ASSY.	-	-	-	1		2		-		-	
13	WL0730	-		PARALLEL SLUG ASSY.	-	-	-	-		-		1		2	
14	WM5094	-		PARALLEL LIMIT SWITCH ACTUATOR	-	-	-	-		1		-		1	
15	WL5139	-		SLIDE PLATES BRACE	-	-	-	-		1		-		1	
16	WM5095	-		PARALLEL LIMIT SWITCH ACTUATOR	-	-	1	-		-		-		-	
17	WL0752	-	WL0752-004	PARALLEL SLUG SLIDE PLATE, R/H	-	-	-	-		1		-		1	
18	WL0752	-	WL0752-003	PARALLEL SLUG SLIDE PLATE, L/H	-	-	-	-		1		-		1	
19	WL5165	-	WL5165-001	CLAMP BRACKET	-	-	-	-		1		-		1	
20	WL5165	-	WL5165-002	CLAMP PLATE	-	-	-	-		1		-		1	
21	WL0760	-		PARALLEL MOTOR MTG. BRACKET	-	-	-	1		2		-		-	
22	WM5168	-		SERIES MOTOR MTG BRACKET	-	-	-	1		1		-		-	
23	WL1870	-		PARALLEL COIL ASSY. (SWITCHED)	-	-	-	-		1		-		1	
24	WL1868	-		MOTOR SPACER	-	-	-	1		1		-		-	
25	WU5091	-		FREQUENCY SWITCH ASSY.	-	-	-	-		1		-		1	
26	WL1998	-		PARALLEL COIL ASSY.	-	-	-	1		-		1		-	
27	WU5010	-	WU5010-001	SERIES MOTOR ASSY.	-	-	-	-		-		1		1	
28	WU5010	-	WU5010-002	PARALLEL MOTOR ASSY.	-	-	-	-		-		1		2	
29	WG5007			TRIP SWITCH MTG BRACKET			-	-		2		-		2	
30	WG5231			INSUL PIECE PARALLEL COIL AMATCH	-	-	-	1		2					
31															
32															
33															
34															
35	WG5090	-	WG5090	PCB MOUNTING	-	-	-	-		1		-		-	
36															
37															
38															
39															
40															

Title		HF12 AUTOMATCH ASSEMBLY					B.O.M. No. WU5262								
Machine Type		CFI HF12					Revision E								
For Assy. Drg. See		WU5262					Date 11/10/13								
							QUANTITY								
Item No.	Drawing No.	Warehouse No.	TT Part No.	DESCRIPTION	Supplier Part No.	Circuit Reference	Comm	UK STD		UK V/F		USA STD		USA V/F	
								-001		-002		-003		-004	
A	-	-	MOTO-GM-800698 OR MOTR008-004 OR MOTR008-015	GEARED MOTOR 20W/25W	-	-	-	1		2		-		-	
B	-	-	MOTO-GM-803578 OR MOTR008-006 OR MOTR008-016	GEARED MOTOR 60W	-	-	-	1		1		-		-	
C	-	-	BELT001-002	TIMING BELT 16-T10/1520-KEVLAR	-	-	-	-		1		-		1	
D	-	-	03CP103	LIMIT SWITCH	-	-	-	4		6		4		6	
E	-	-	13CP302-370	STEM ADAPTOR 1/4" BSP X 10MM PIPE	RM051012N	-	4	-		-		-		-	
F	-	-	13CP302-041	BULKHEAD CONNECTOR 12MM PIPE	RPM1212E	-	4	-		-		-		-	
G	-	-	13CP302-402	REDUCING CONNECTOR 10MM X 8MM PIPE	RPM201008E	-	-	4		6		4		6	
H															
J															

WU5261


**Basic Auto-Match Assembly HF12
(Common Build)**

Sheet 1 – *Basic Auto-Match Assembly*

Sheet 2 – *Basic Auto-Match Assembly*


REVISIONS					
REV	ECR	DESCRIPTION	ZONE	DWN BY	MMDDYY
0	06155	FIRST ISSUE		MWT	06/27/06
A	11207	REVISED QTY. OF ITEM 9 (WL0704) FROM 1 TO 2	C10	RRR	10/17/07
B	11281	DELETED ITEM 34 WL5161 QTY. 2 ADDED ITEM 42 WM5465 QTY. 4 SHEET 2 ADDED ITEM 43 WG5007 QTY. 2		J7 H9	01/08/08

SD

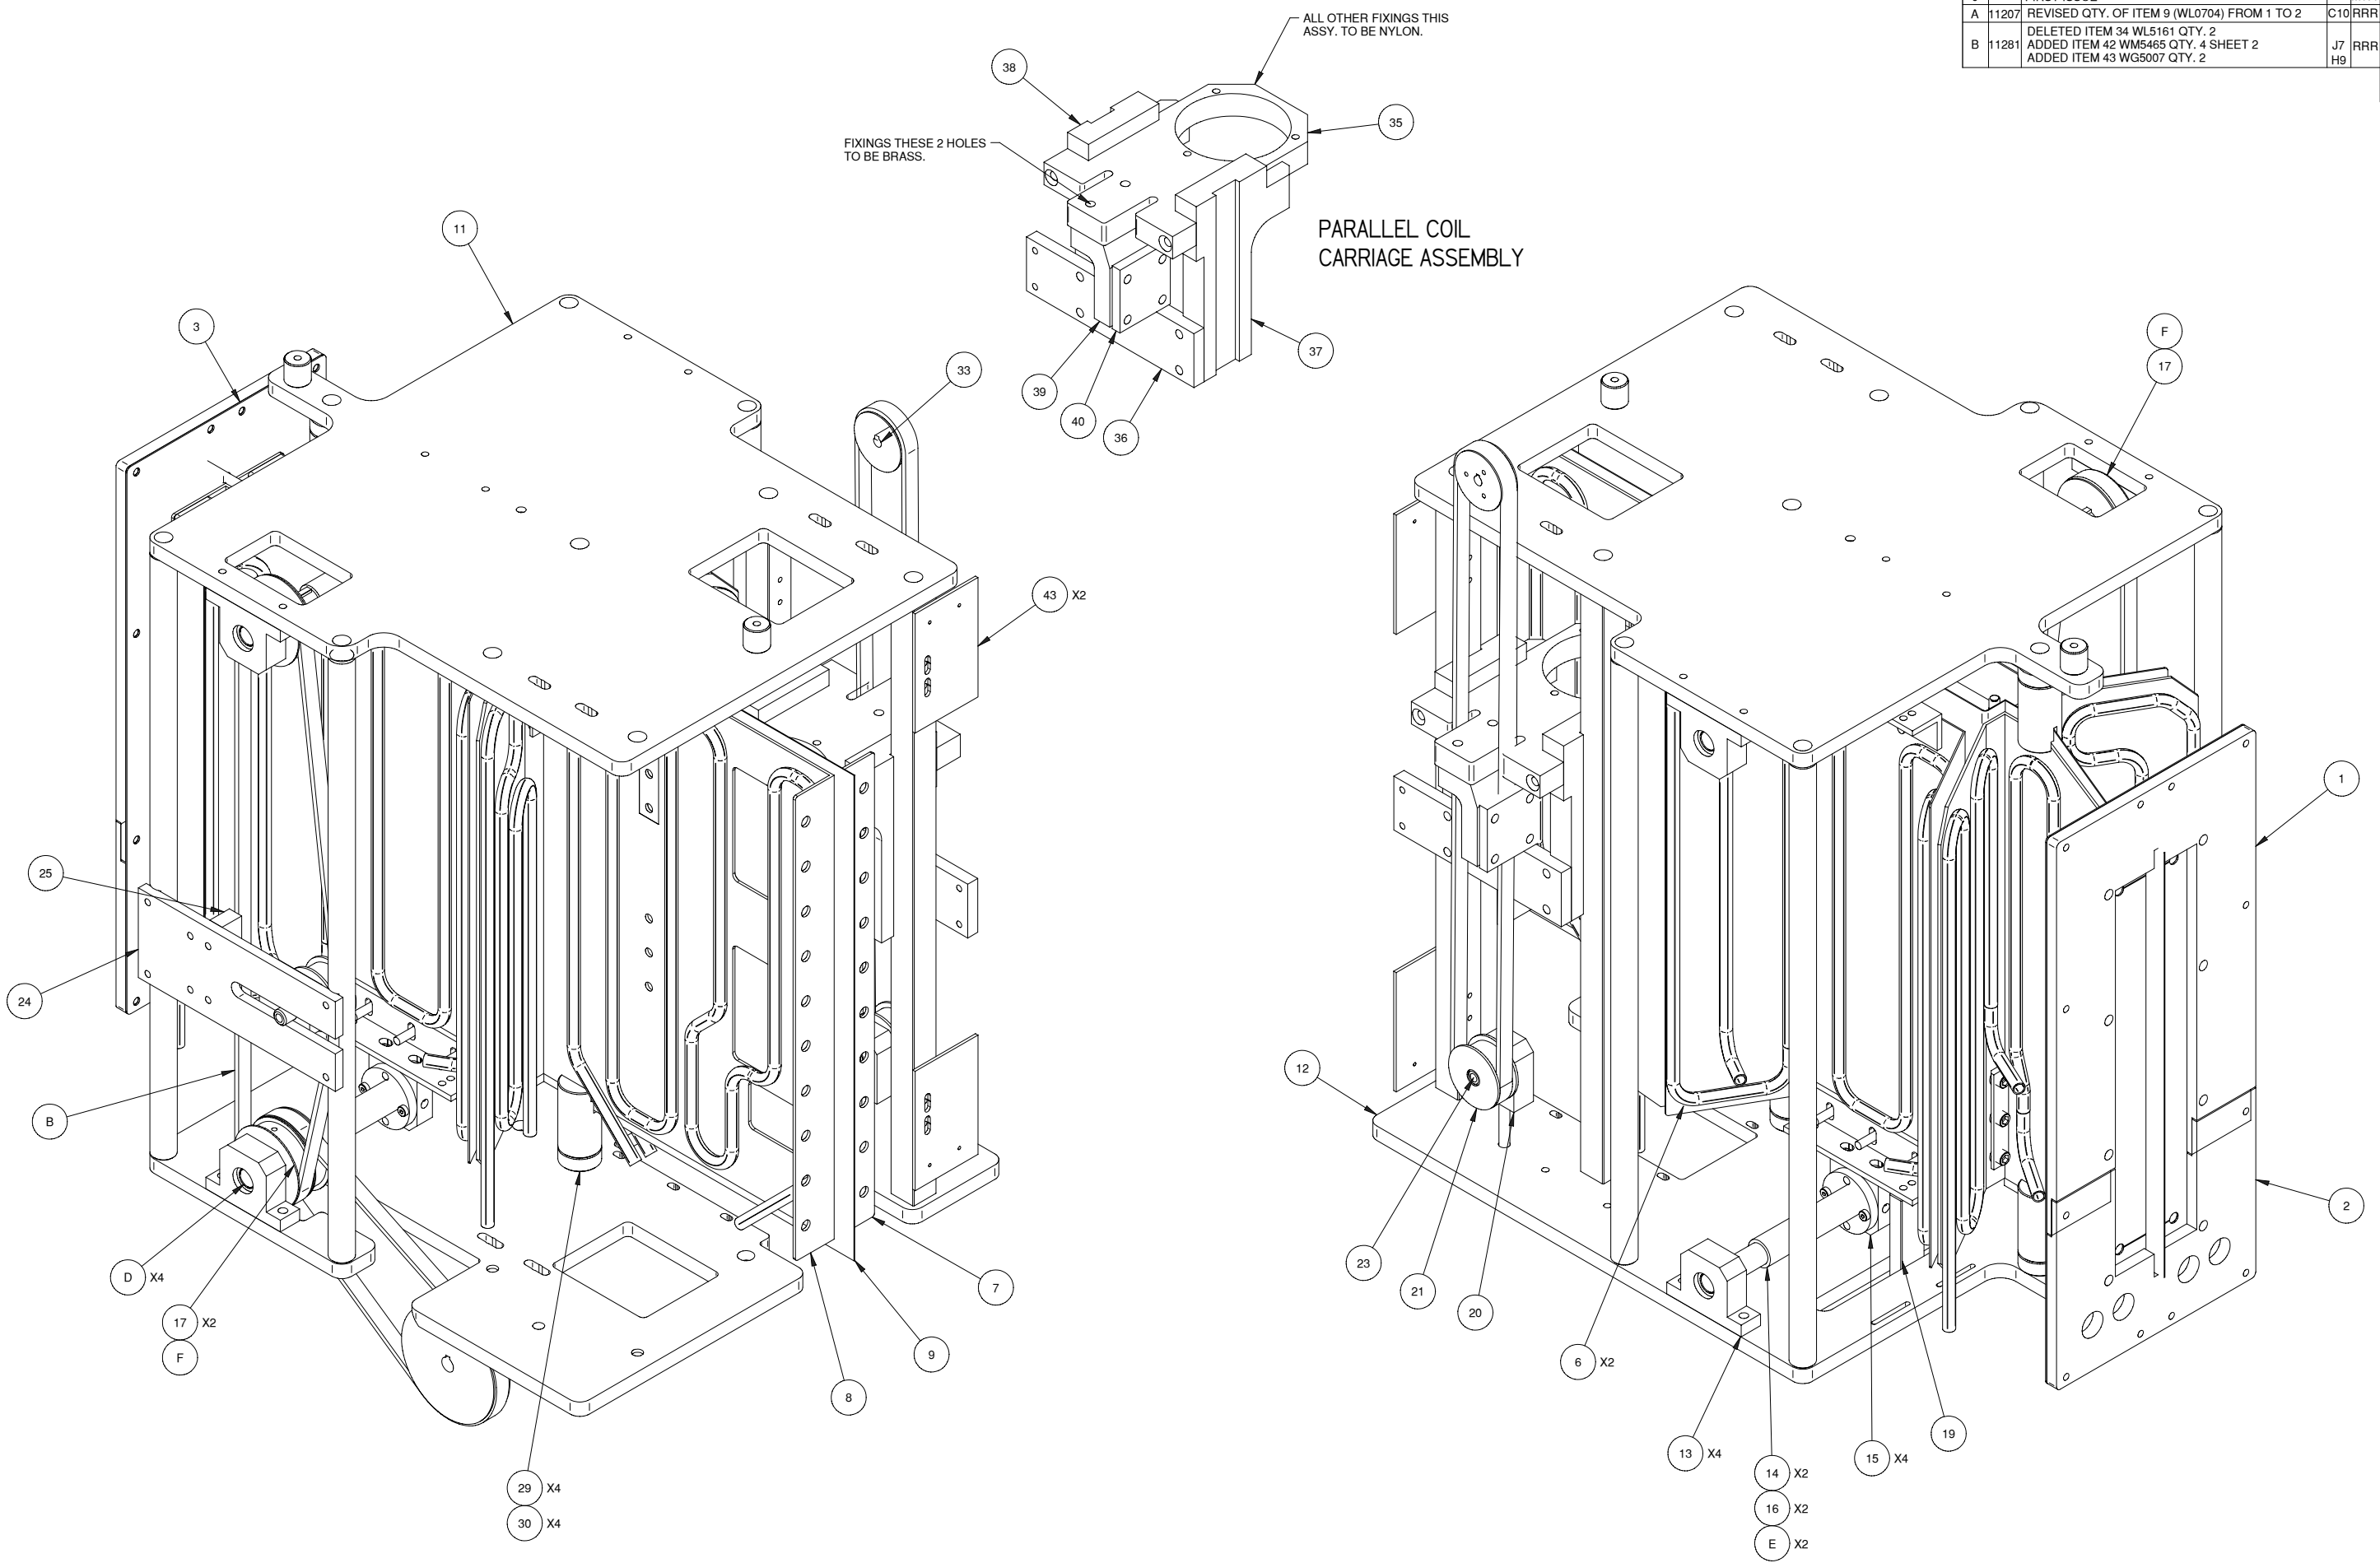

NOTE:-
ALL FIXINGS UNLESS OTHERWISE STATED
TO BE NON-MAGNETIC (304) STAINLESS STEEL.

		<small>THIS DOCUMENT IS THE PROPERTY OF THERMATOOL EUROPE LTD. AND IS A CONFIDENTIAL DOCUMENT. IT IS TO BE KEPT IN STRICT CONFIDENCE AND NOT TO BE REPRODUCED OR DISCLOSED TO ANY OTHER PARTY WITHOUT THE WRITTEN PERMISSION OF THERMATOOL EUROPE LTD.</small>	
HF12 Basic Automatch Assy		<small>Manufacture Weight</small> 41.4 kg	
<small>Part Name Description</small> HF12 BSC AMATCH ASSY		<small>Thermatool Material Code</small> 	
<small>SEE PART DETAIL</small>			
<small>TOLERANCES UNLESS OTHERWISE SPECIFIED</small> 0 PLACE 00 ± 1 ANGLE ± 0.5° 1 PLACE XXX ± 0.05 SURFACE N8/ 2 PLACE XXXX ± 0.025 SURFACE N8/ 3 PLACE XXXXX ± 0.125 FINISH		<small>SI-METRIC</small> 	
<small>DATE</small> 06/27/06		<small>BY</small> martint	
<small>BUYER OR SELLER HEREBY ACKNOWLEDGES THAT THERE MAY BE ERRORS OR OMISSIONS IN THIS DOCUMENT AND THAT THERMATOOL EUROPE LTD. SHALL NOT BE LIABLE IN ANY MANNER FOR SUCH ERRORS OR OMISSIONS.</small>			
<small>PRODUCTION CODE</small> CFI		<small>THIRD ANGLE PROJECTION</small> 	
<small>SHEET 1 OF 2</small> AO 3		<small>Part No</small> WU5261	

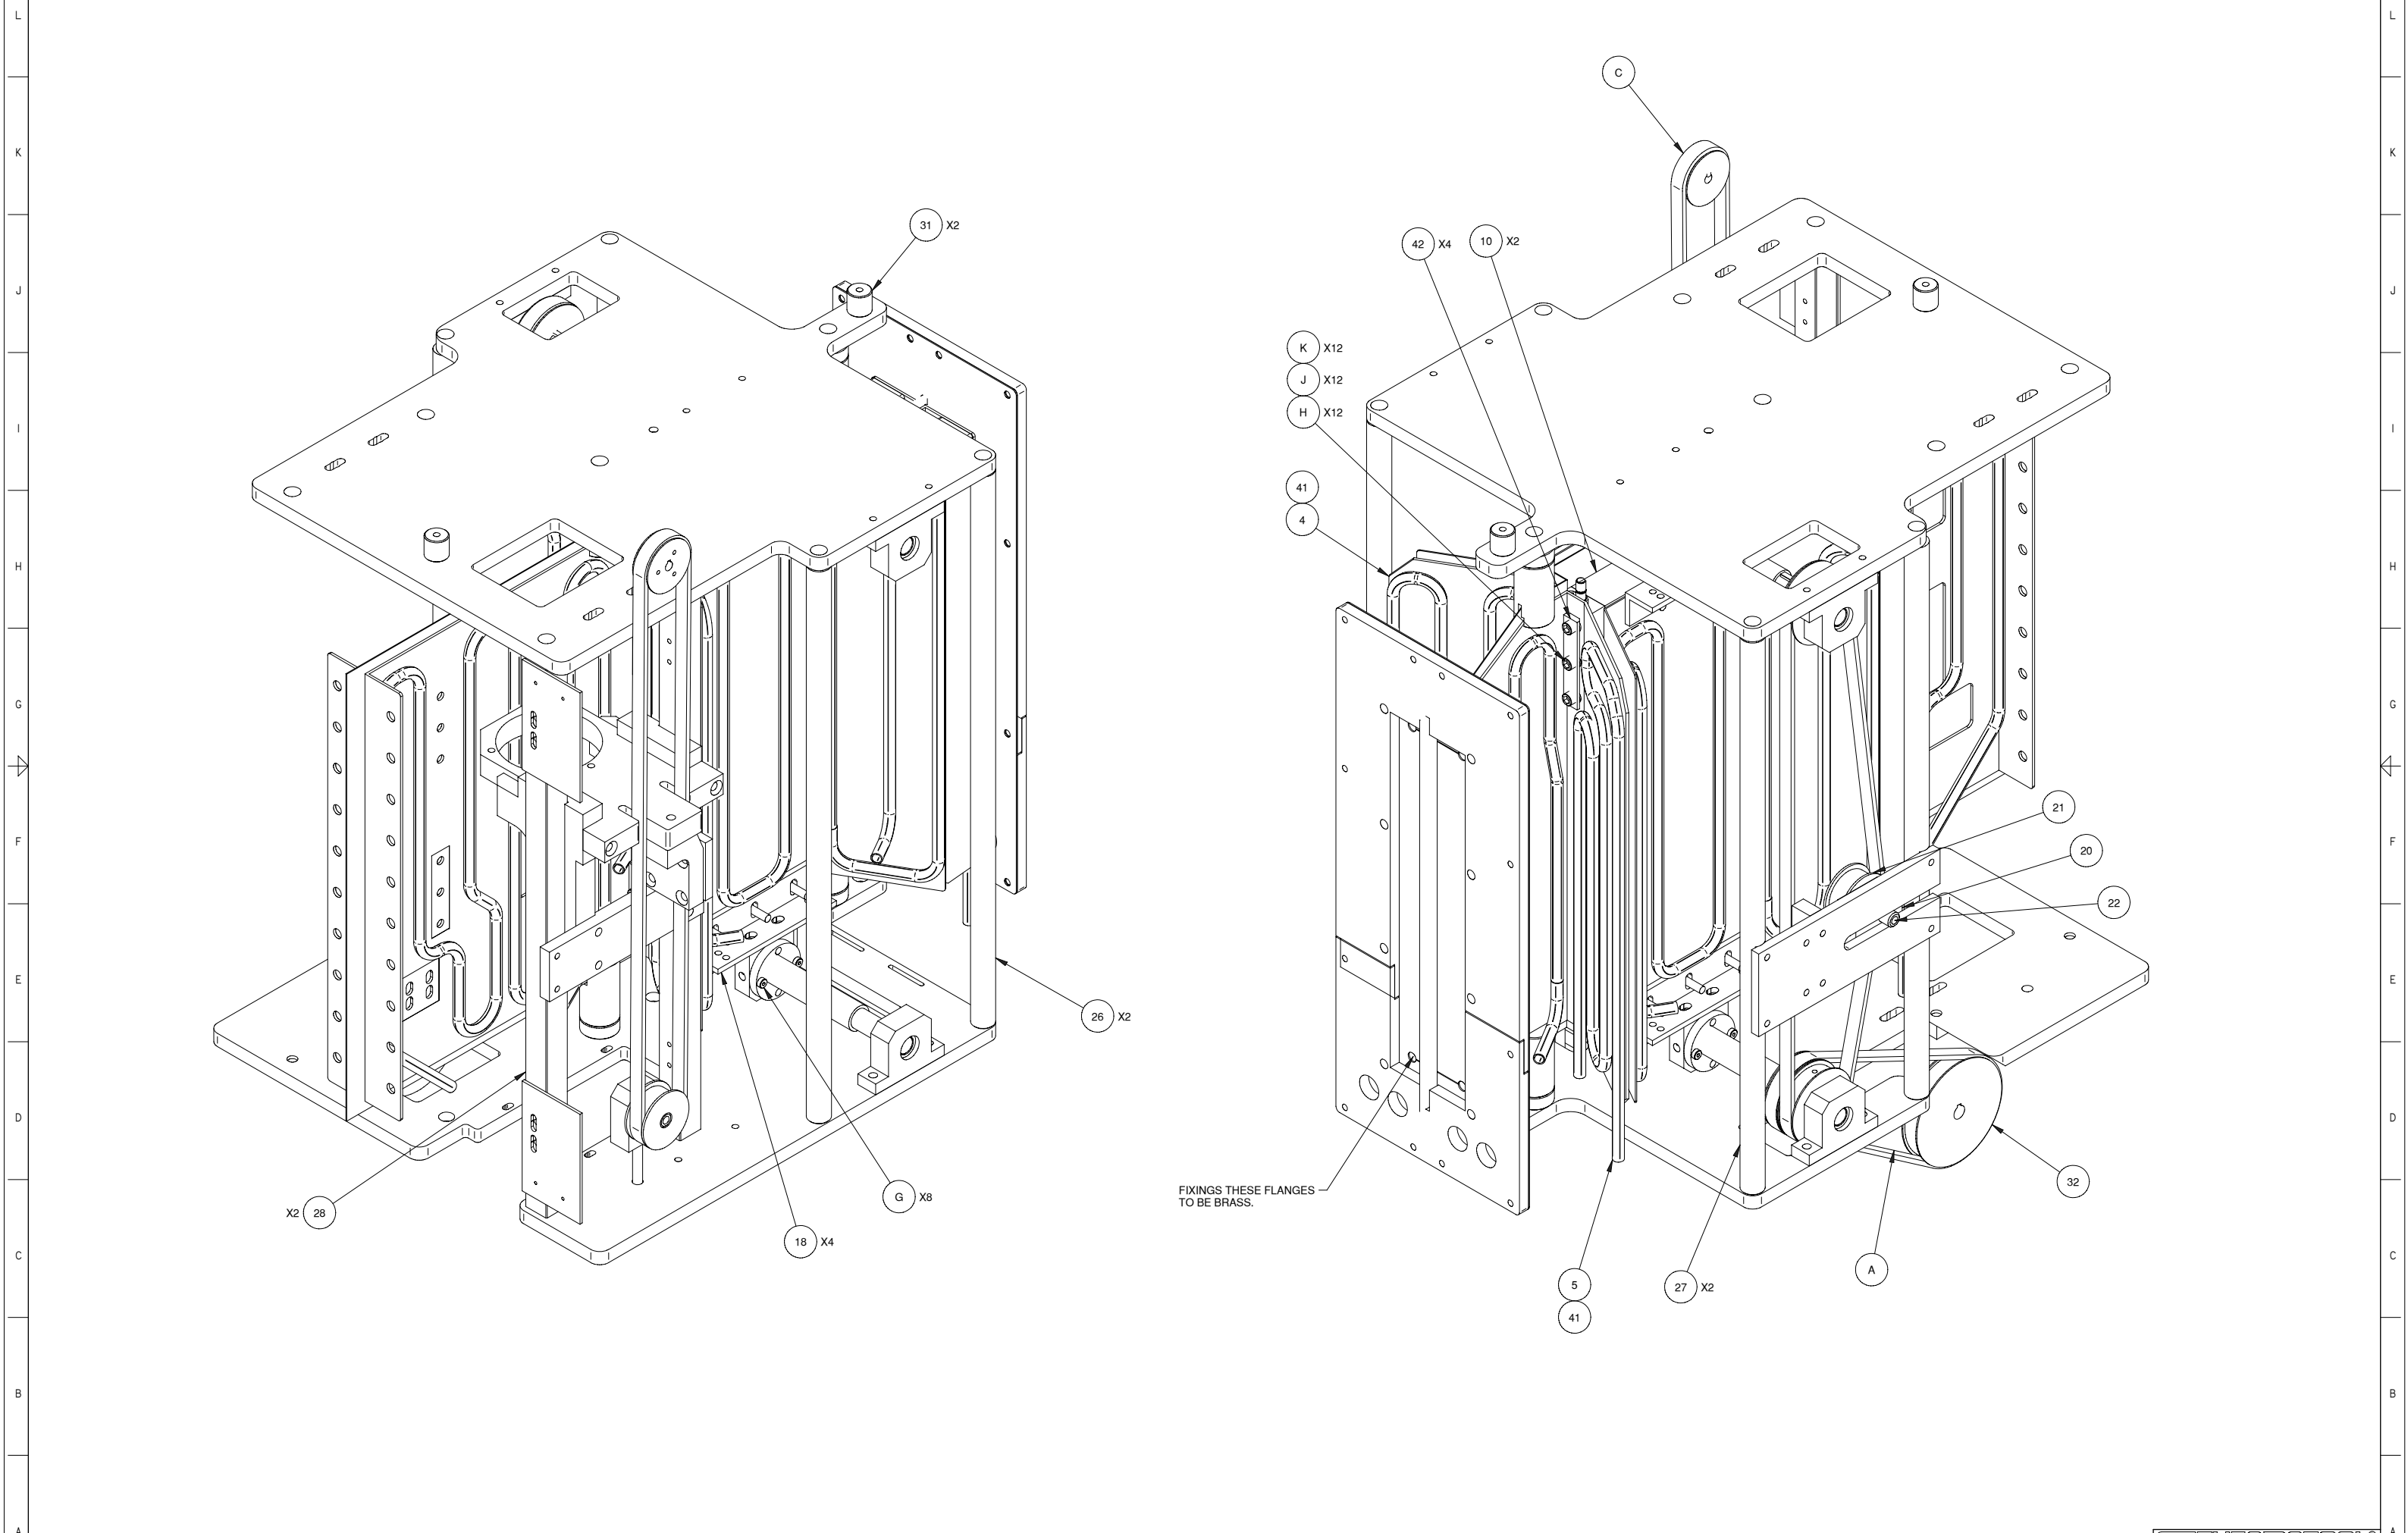

WU5261

Basic Auto-Match Assembly HF12

(Common Build)

BOM (Bill Of Material)

Sheet 1 – *Auto-Match - BOM*


Sheet 2 – *Auto-Match – BOM*

Title		HF12 BASIC AUTOMATCH ASSEMBLY (COMMON BUILD)						B.O.M. No. WU5261							
Machine Type		CFI HF12						Revision B							
For Assy. Drg. See		WU5261						Date 21SEPT10							
								QUANTITY							
Item No.	Drawing No.	Warehouse No.	TT Part No.	DESCRIPTION	Supplier Part No.	Circuit Reference	Comm								
1	WL5170	-	WL5170-001	ENVIRONMENTAL SHIELD, TOP	-	-	1								
2	WL5170	-	WL5170-002	ENVIRONMENTAL SHIELD, BOTTOM	-	-	1								
3	WL5169	-	WL5169	GASKET	-	-	1								
4	WL5530	-	WL5530	THIRD BUS. NEGATIVE	-	-	1								
5	WL5531	-	WL5531	THIRD BUS. POSITIVE	-	-	1								
6	WL5140	-	WL5140	SECOND BUS.	-	-	2								
7	WL5526	-	WL5526	FIRST BUS. NEGATIVE	-	-	1								
8	WL5527	-	WL5527	FIRST BUS. POSITIVE	-	-	1								
9	WL0704	-	WL0704	BUS INSULATION	-	-	1								
10	WL0742	-	WL0742	BUS BRIDGE ASSEMBLY	-	-	2								
11	WL1864	-	WL1864	UPPER PLATE	-	-	1								
12	WG5075	-	WG5075	LOWER PLATE	-	-	1								
13	WL5168	-	WL5168	LEAD SCREW OUTER BUSHING MTG	-	-	4								
14	WL5167	-	WL5167-001	LEAD SCREW - NUT ASSY	-	-	2								
15	WL0938	-	WL0938	ACME NUT MTG PLATE	-	-	4								
16	WL5164	-	WL5164	LEAD SCREW INNER BUSHING MTG	-	-	2								
17	WL2219	-	WL2219	PULLEY, 24T, 10 PITCH, 22 BORE	-	-	3								
18	WL2182	-	WL2182-002	BEARING SUPPORT MOUNT, LOWER	-	-	4								
19	WL2186	-		SERIES LIMIT SWITCH ACTUATOR	-	-	1								
20	WL0734	-		BELT TENSIONER ASSY	-	-	2								
21	WL5162	-		TENSIONER WHEEL	-	-	2								
22	WL2184	-	WL2184-001	SERIES TENSIONER PIN	-	-	1								
23	WL2184	-	WL2184-002	PARALLEL TENSIONER PIN	-	-	1								
24	WL5133	-	WL5133-001	SERIES TENSIONER MTG PLATE	-	-	1								
25	WL5133	-	WL5133-002	SERIES TENSIONER TAKE-UP PLATE	-	-	1								
26	WL5136	-	WL5136-001	VERTICAL SUPPORT ROD, NEG	-	-	2								
27	WL5136	-	WL5136-002	VERTICAL SUPPORT ROD, POS	-	-	2								
28	WL5138	-		VERTICAL GUIDES	-	-	2								
29	WL0709	-	WL0709-003	BUS-BAR SUPPORT	-	-	4								
30	WL0901	-		BUS-BAR SUPPORT SPACER	-	-	4								
31	WL5163	-		TOP PLATE GUIDE	-	-	2								
32	WM5047	-		PULLEY, 36T, 10 PITCH	-	-	1								
33	WL2221	-		PULLEY, 18T, 10 PITCH, 10 BORE	-	-	1								
34															
35	WL2183	-		TOP PLATE PARALLEL SLUG ASSY	-	-	1								
36	WL5139	-		SLIDE PLATES BRACE	-	-	1								
37	WL0752	-	WL0752-004	PARALLEL SLUG SLIDE PLATE, R/H	-	-	1								

Title		HF12 BASIC AUTOMATCH ASSEMBLY (COMMON BUILD)					B.O.M. No. WU5261											
Machine Type		CFI HF12					Revision B											
For Assy. Drg. See		WU5261					Date 21SEPT10											
							QUANTITY											
Item No.	Drawing No.	Warehouse No.	TT Part No.	DESCRIPTION	Supplier Part No.	Circuit Reference	Comm											
38	WL0752	-	WL0752-003	PARALLEL SLUG SLIDE PLATE, L/H	-	-	1											
39	WL5165	-	WL5165-001	CLAMP BRACKET	-	-	1											
40	WL5165	-	WL5165-002	CLAMP PLATE	-	-	1											
41	WL5160	-		TAPPED BACK-UP BAR	-	-	2											
42	WM5465	-		CLAMP BAR, 3rd BUS TO BRIDGE	-	-	2											
43	WL5161	-		TRIP SWITCH MTG BRACKET	-	-	2											
A	-	-	BELT001-010	TIMING BELT 16-T10/810-KEVLAR	-	-	1											
B	-	-	BELT001-001	TIMING BELT 16-T10/1460-KEVLAR	-	-	1											
C	-	-	BELT001-002	TIMING BELT 16-T10/1520-KEVLAR	-	-	1											
D	-	-	42CP132-051	IGLIDE BUSH M250	-	-	4											
E	-	-	42CP131-093	IGLIDE BUSH MSM-3240-20	-	-	2											
F	-	-	HARD-KEY-6X6X50	KEY STAINLESS STEEL	-	-	2											
G	-	-	M5XM6X10MMSKTSHLDR S/STL	SHSS DIA 6 X M5-0.8 X 10MM LG. 304 S/STL	-	-	8											
H	-	-	-	SHCS M8-1.25 X 20MM LG. 304 S/STL	-	-	12											
J	-	-	-	M8 SPRING WASHER. 304 S/STL	-	-	12											
K	-	-	-	M8 PLAIN WASHER. 304 S/STL	-	-	12											



REVISION		ZONE	DWN BY	DD/MM/YY
REV	ECR	DESCRIPTION		
0	02299	FIRST ISSUE	MWT	23/08/04

SD

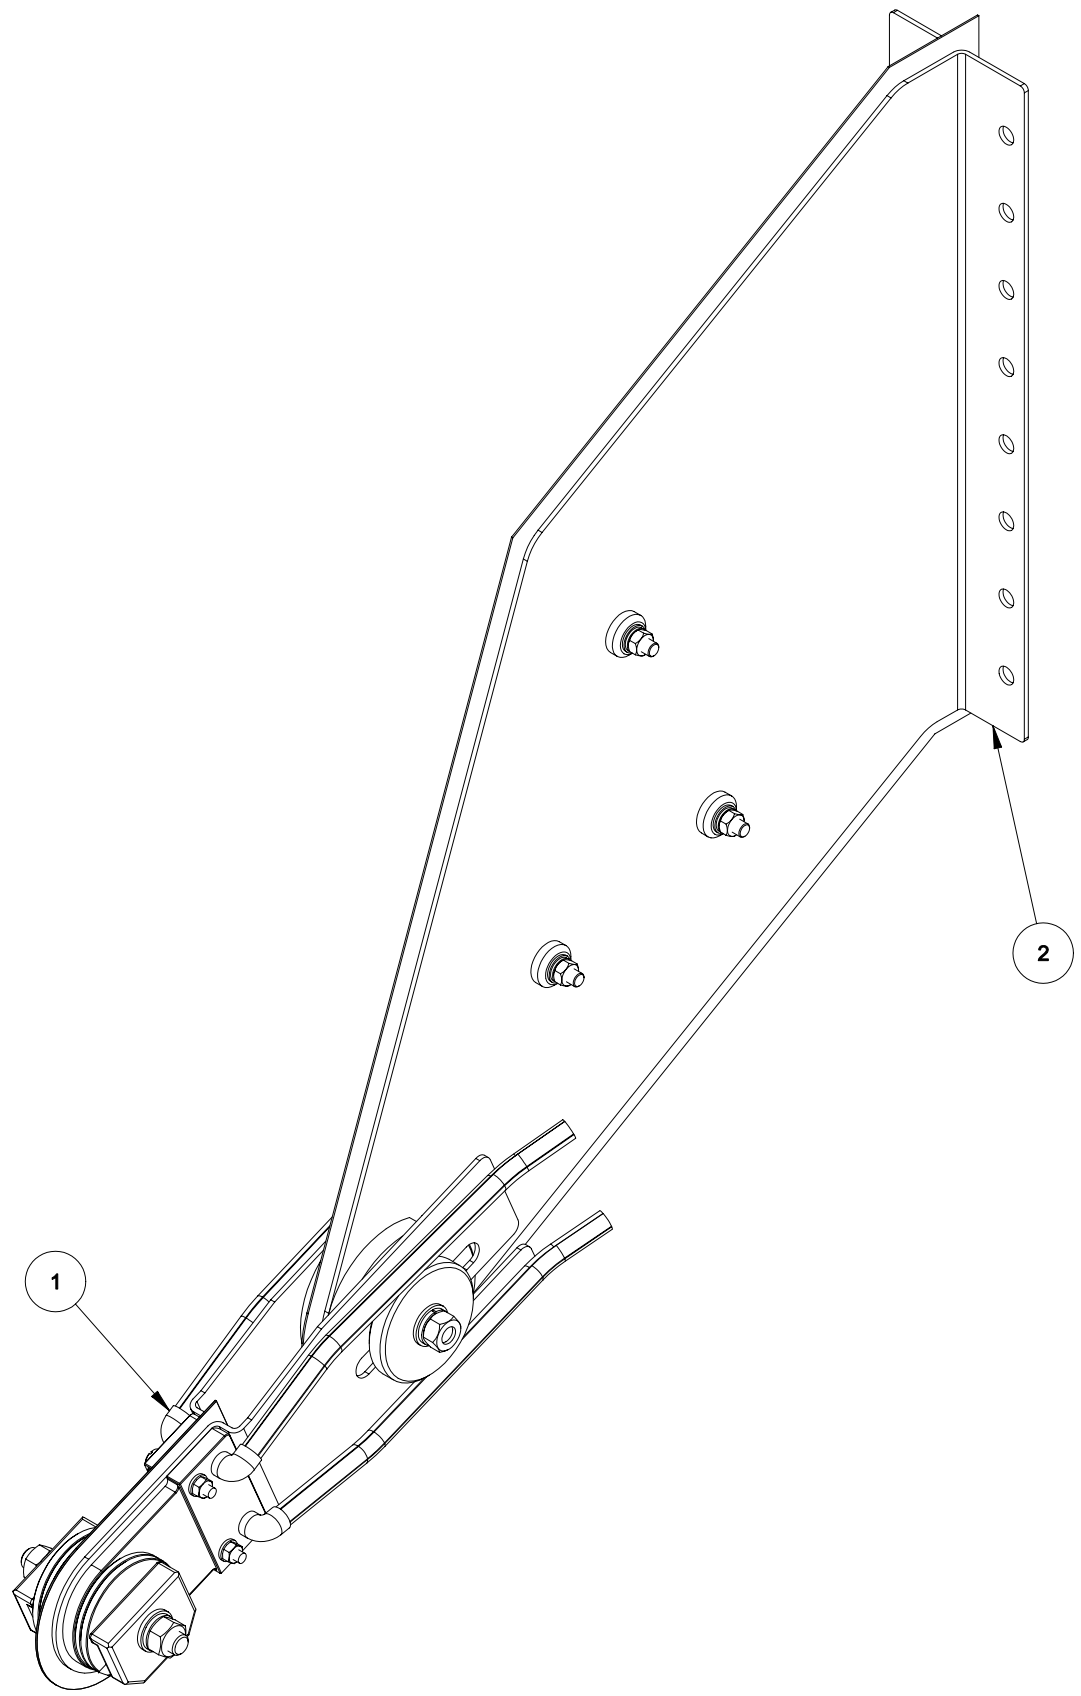

		<small>THIS DOCUMENT IS THE PROPERTY OF THERMATOOL EUROPE LTD. AND IT IS SUBMITTED FOR USE ONLY WITH WORK PROPOSED OR AUTHORIZED BY THIS COMPANY. IT SHOULD NOT BE USED OR REPLICATED FOR ANY OTHER PURPOSE AND IT IS TO BE RETURNED TO THERMATOOL EUROPE LTD. ON REQUEST WHEN NO LONGER REQUIRED FOR SUCH PURPOSES.</small>	
TITLE HF12 Output Assembly			
Item Master Description: HF12 OUPPT ASSY		Approximate Weight: 17.4kg	
MATERIAL: SEE PART DETAIL			
TOLERANCES UNLESS OTHERWISE SPECIFIED: 0 PLACE (X) ±1. ANGLE: ±0.5° 1 PLACE (X.X) ±0.5 2 PLACE (X.XX) ±0.25 SURFACE NB 3 PLACE (X.XXX) ±0.100 FINISH:		SI-METRIC 	DRAWN BY martint DD/MM/YY 23/08/06
PRODUCT MODEL CFT HF12		SHEET SIZE DIVISION NO 1 OF 1 A1 3	Revision WU5032 0

REVISIONS			ZONE	DWN BY	MM/DD/YY
REV	ECR	DESCRIPTION			
0	06260	FIRST ISSUE		MWT	11/03/06

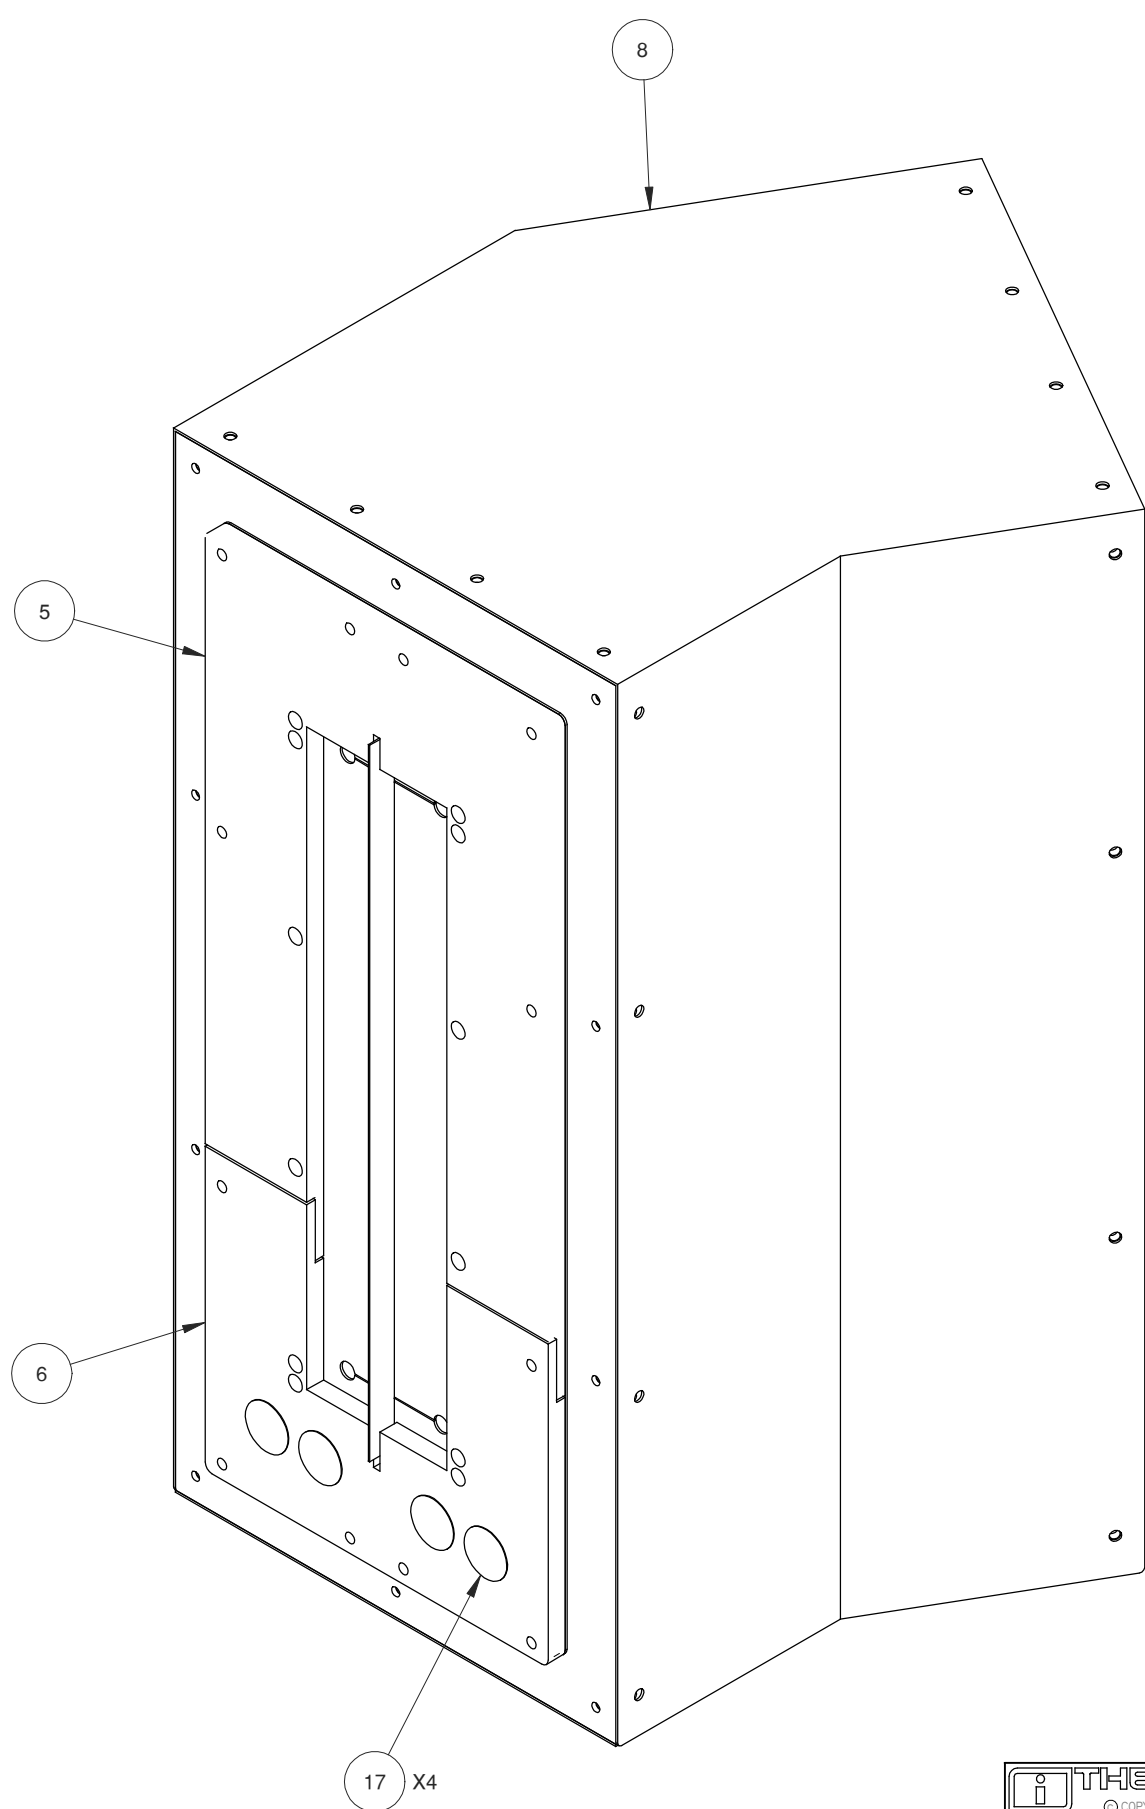
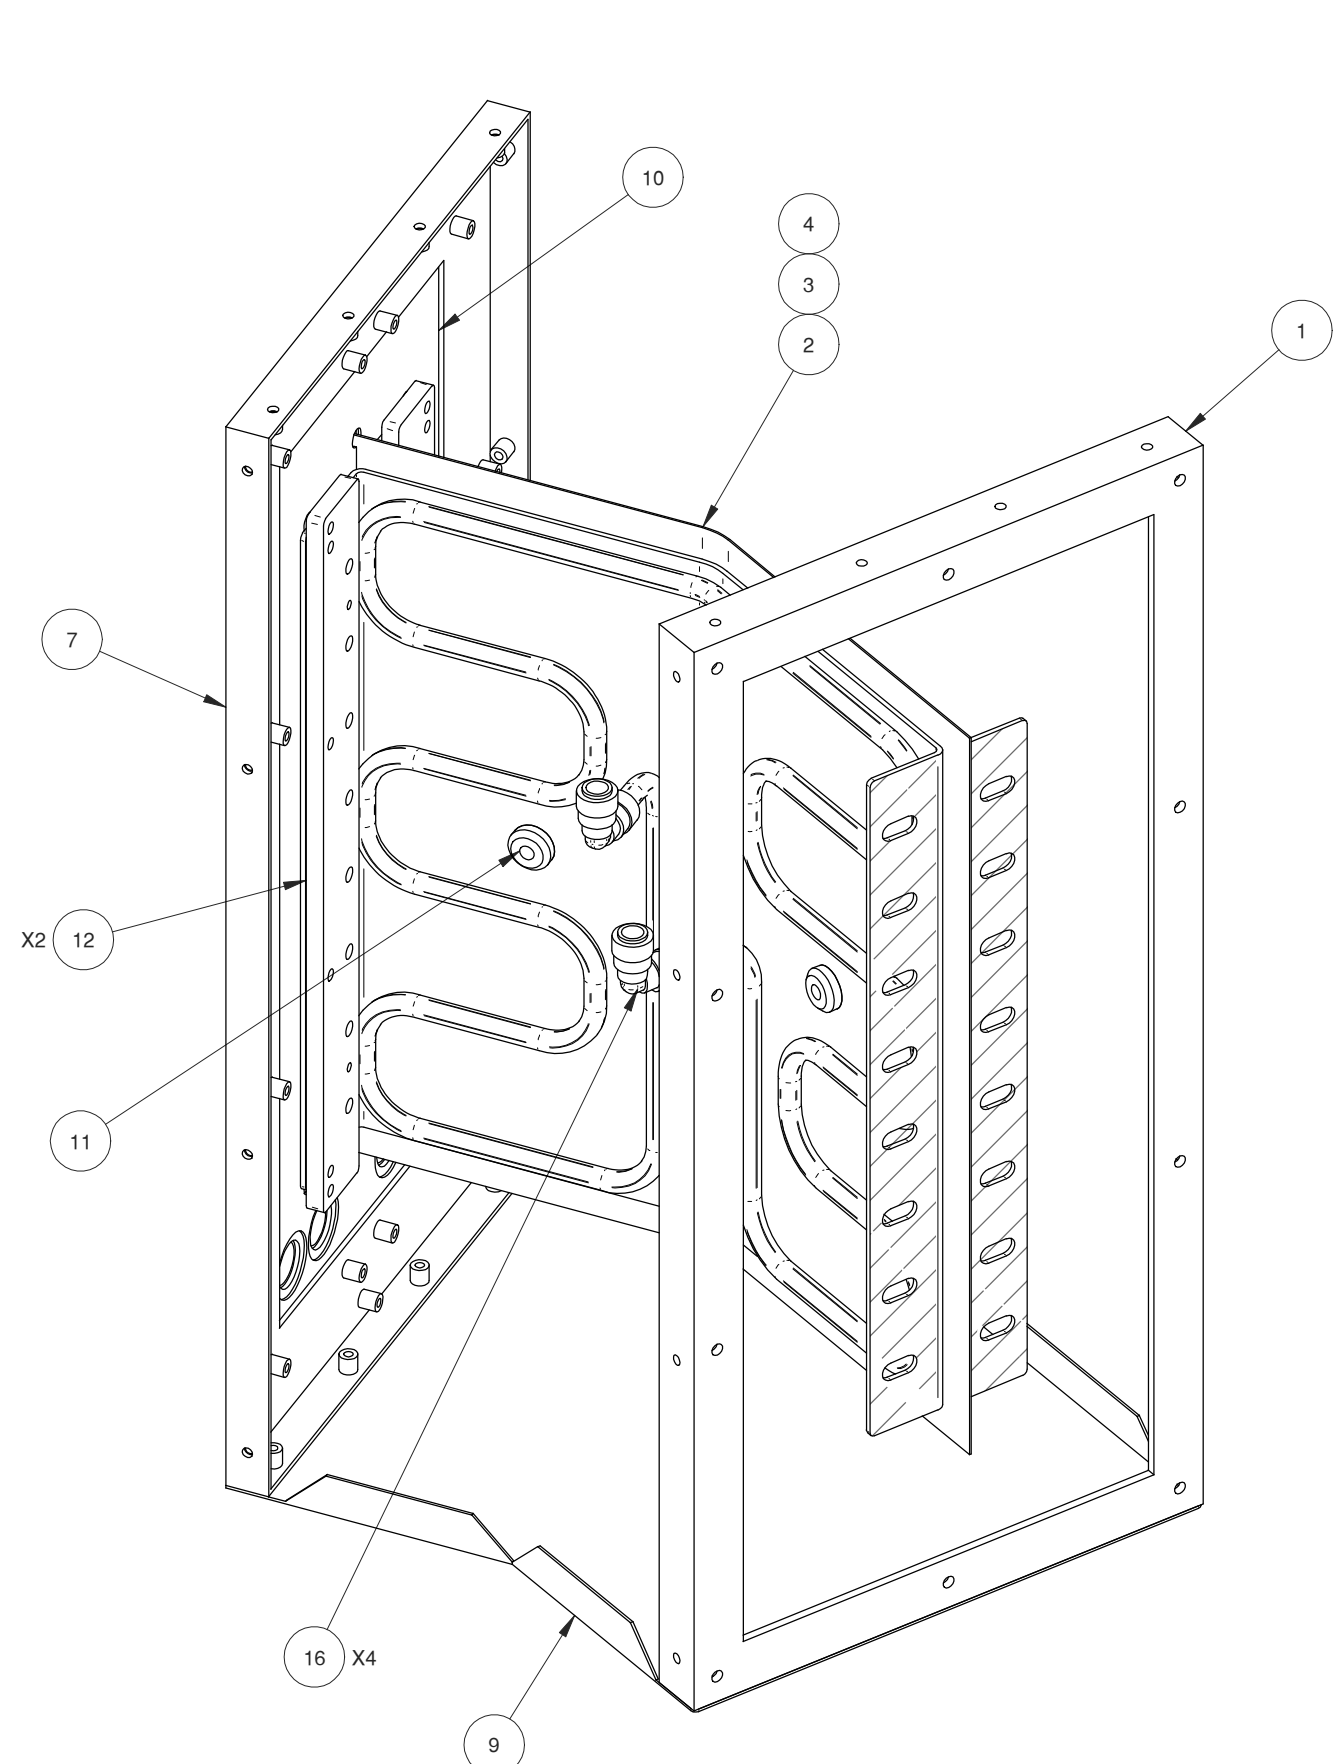


NOTE--
SECURED TO ITEM 8 TOP COVER USING
SELF TAPPING SCREWS. MARK AND DRILL
AT ASSEMBLY.


THERMATOOL © COPYRIGHT THERMATOOL EUROPE LTD		THIS DOCUMENT IS THE PROPERTY OF THERMATOOL EUROPE LTD AND IS SUBMITTED FOR USE ONLY WITH WORK PROPOSED OR AUTHORIZED BY THE COMPANY. IT SHOULD NOT BE USED OR REPLICATED FOR ANY OTHER PURPOSE AND IT IS TO BE RETURNED TO THERMATOOL EUROPE LTD ON REQUEST WHEN NO LONGER REQUIRED FOR SUCH PURPOSES.	
30 Deg Output Housing Assembly		Approximate Weight 27.6 kg	
Item Master Description 30 DEG OP HSNG ASSY		Thermatool Material Code	
MATERIAL: SEE PART DETAIL		Thermatool Material Code	
TOLERANCES UNLESS OTHERWISE SPECIFIED: 0 PLACE D0 ± 1 ANGLE: ±0.5° 1 PLACE DXX ± 0.5 2 PLACE DXXX ± 0.25 SURFACE N8/ 3 PLACE DXXXX ± 0.125 FINISH		SI-METRIC BUYER OR SELLER HEREBY ACKNOWLEDGES THAT THERE MAY BE ERRORS OR OMISSIONS IN THIS DOCUMENT AND THAT THERMATOOL EUROPE LTD SHALL NOT BE LIABLE IN ANY MANNER FOR SUCH ERRORS OR OMISSIONS.	
PRODUCT MODEL CFI	SHEET 1 OF 1	DWG NO. WU5311	Revision 0

Title		30 DEG OUTPUT HOUSING ASSEMBLY					B.O.M. No. WU5311													
Machine Type		HF12 CFI					Revision 0													
For Assy. Drg. See		WU5311					Date 03/1/06													
							QUANTITY													
Item No.	Drawing No.	Warehouse No.	TT Part No.	DESCRIPTION	Supplier Part No.	Circuit Reference	Comm													
1	WF5291	-	WF5291	HOUSING MOUNTING FRAME	-	-	1													
2	WL5597	-	WL5597-001	30 DEG ADAPTOR BUS, R/H SECTION	-	-	1													
3	WL5597	-	WL5597-002	30 DEG ADAPTOR BUS, L/H SECTION	-	-	1													
4	WL5598	-	WL5598	ADAPTOR BUS INSULATION	-	-	1													
5	WK5400	-	WK5400-001	ENVIRONMENTAL SHIELD, TOP	-	-	1													
6	WK5400	-	WK5400-002	ENVIRONMENTAL SHIELD, BOTTOM	-	-	1													
7	WF5352	-	WF5352	HOUSING BULKHEAD	-	-	1													
8	WF5471	-	WF5471	TOP COVER	-	-	1													
9	WF5472	-	WF5472	BOTTOM COVER	-	-	1													
10	WL5169	-	WL5169	GASKET	-	-	1													
11	WL1039	-	WL1039	INSULATION CLAMP	-	-	4													
12	WK5461	-	WK5461	TAPPED BACK-UP BAR	-	-	2													
13																				
14																				
15	-	-	PLM-BULK-RPM1212E	BULKHEAD CONNECTOR	RPM1212E	REF.	4													
16	-	-	PLM-ADT-RM0312E	12MM ELBOW	RM0312E	-	4													
17	-	-	-	27MM BLANKING PLUG	-	-	4													
18																				
19																				
20																				


REV	REV STATUS	DESCRIPTION	ZONE	DWN	CHK	APPD	DD/MM/YY
0	SH	08203 FIRST ISSUE					

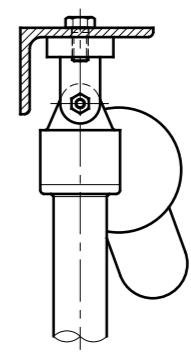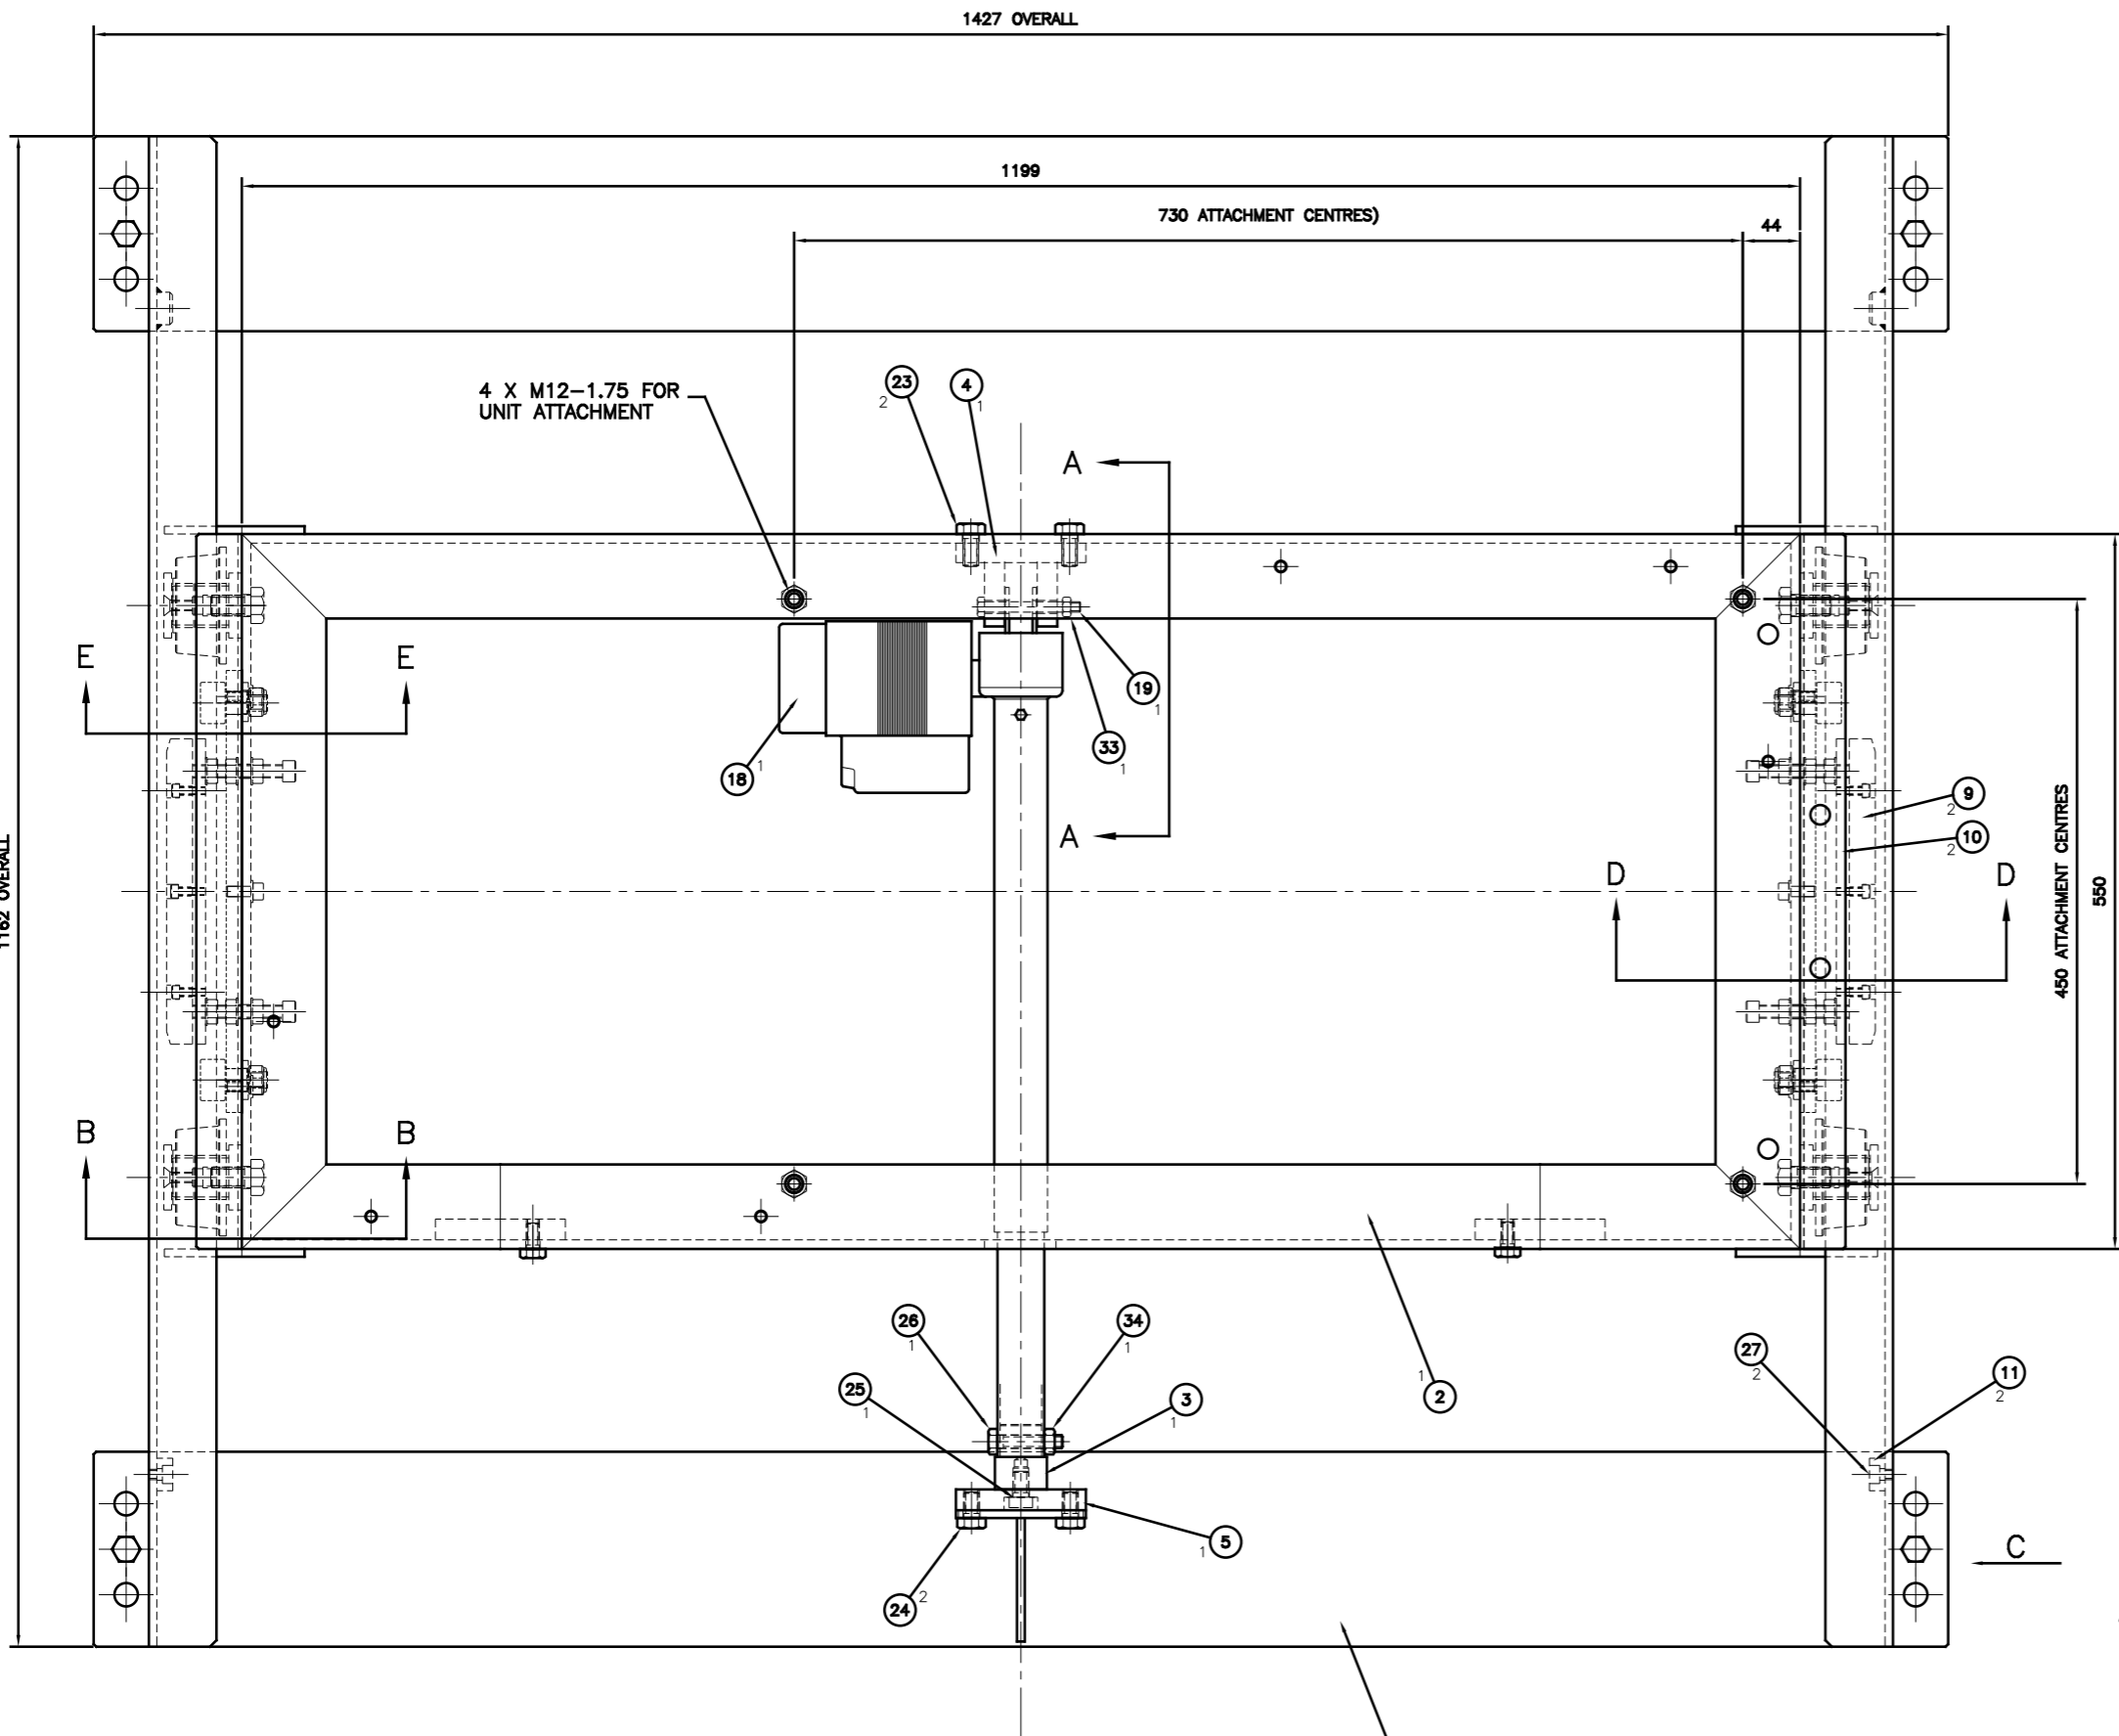


SECTION ON 'A-A'

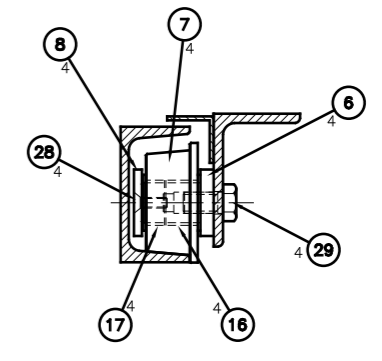


SECTION ON 'B-B'

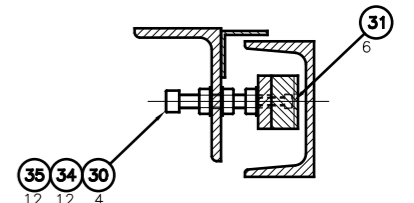

SECTION ON 'D-D'

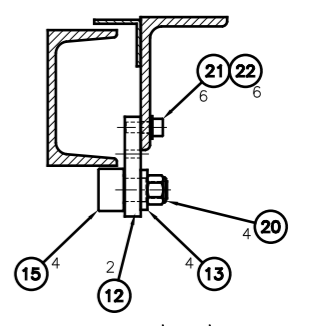

SECTION ON 'E-E'

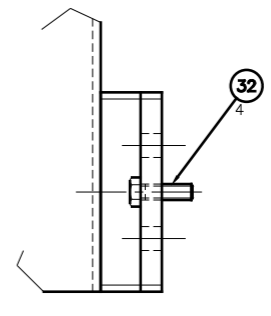


VIEW FROM 'C'

NOTE:-
SINGLE AXIS TABLE TO GIVE ±150MM MOVEMENT.

WEIGHT 128Kgs



BASED ON WG0529

UNLESS OTHERWISE SPECIFIED DIMENSIONS ARE IN MILLIMETERS TOLERANCES ON:		APPROVALS		THERMATOOL®	
0 PLACE (X) ± 0.5	ANGLE ± 0°30'	DWN	DWH	28/08/08	TITLE
1 PLACE (X.X) ± 0.3	SURFACE FINISH	CHK			FINAL ASSEMBLY CF1 SINGLE AXIS TRAVERSE TABLE
2 PLACE (X.XX) ± 0.15	BREAK AND DEBURR ALL SHARP EDGES	ENG/APPD			SIZE DWG NO. REV
SI-METRIC		MATL.	N.A.		A0 3
THIRD ANGLE PROJECTION		FINISH/HEAT TREAT	N.A.		WU5436 0
©Copyright THERMATOOL EUROPE LTD		SCALE		DO NOT SCALE DRAWING COPY SHEET 1 OF 1	


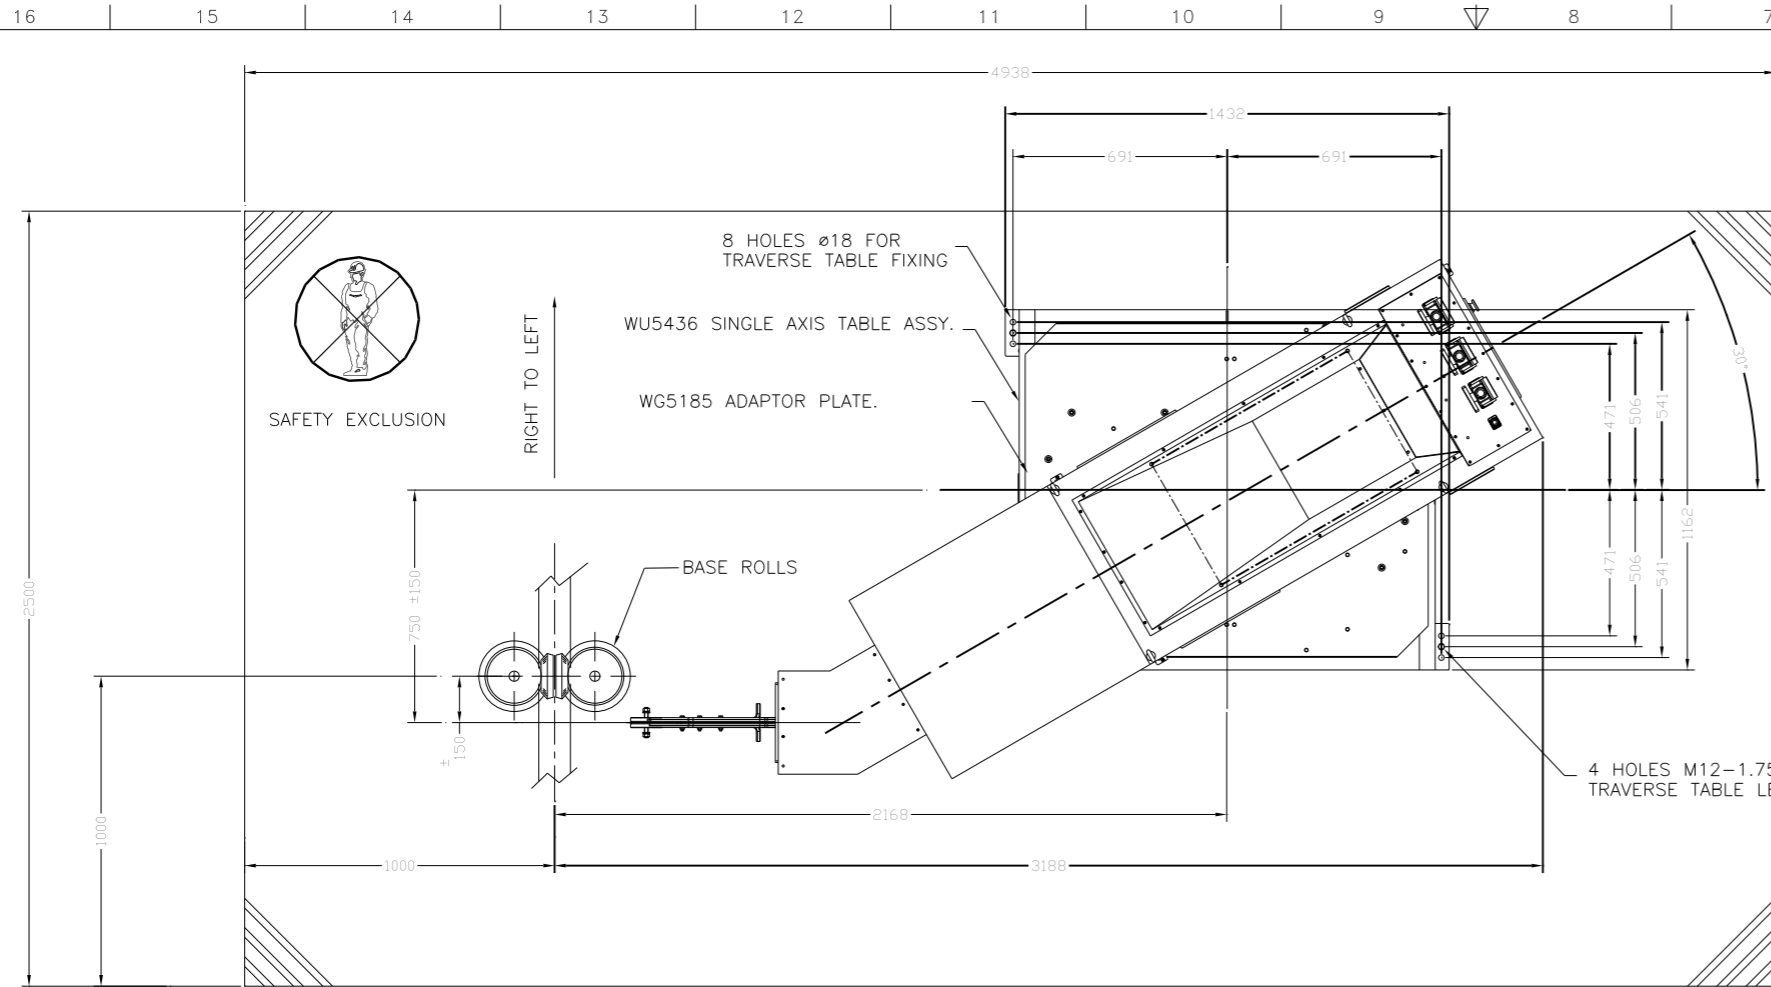


REVISIONS									
NO	REV	STATUS	DESCRIPTION	ZONE	DWN	CHK	APPD	DATE	BY
0	REV	SH	0						
0	REV	SH	0						

DO NOT SCALE, IF IN DOUBT ASK!

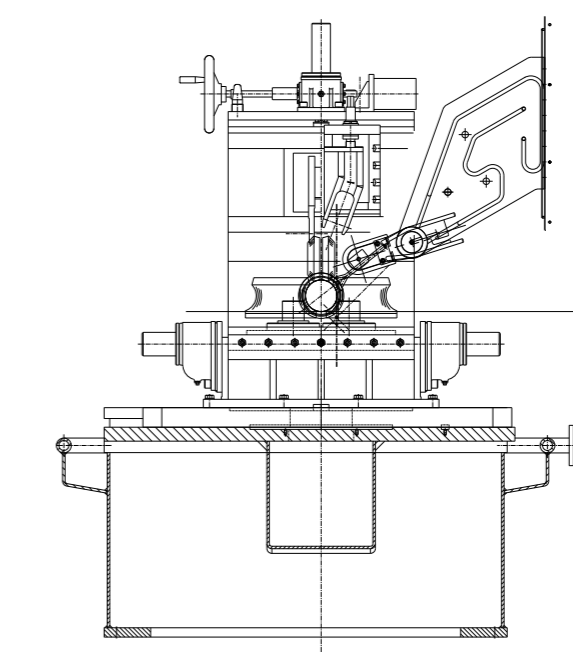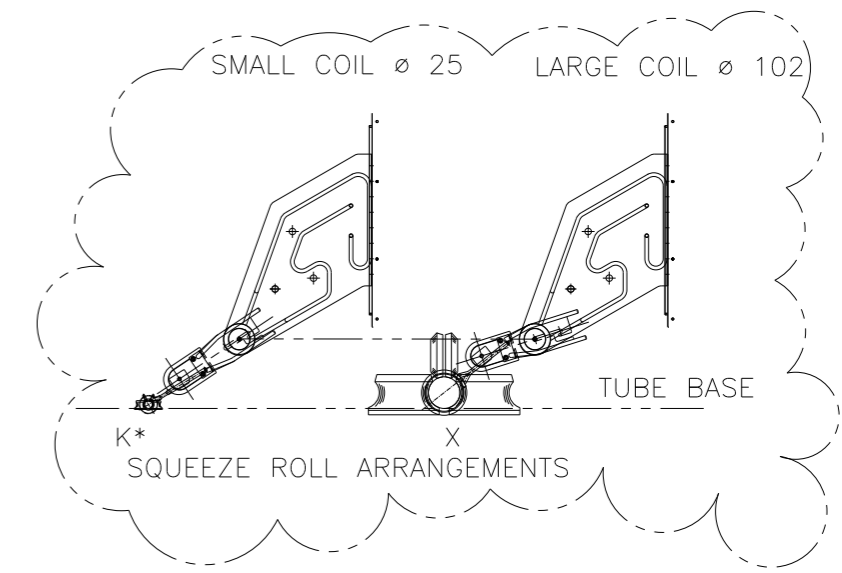

VIEW SHOWING LARGE COIL IN POSITION

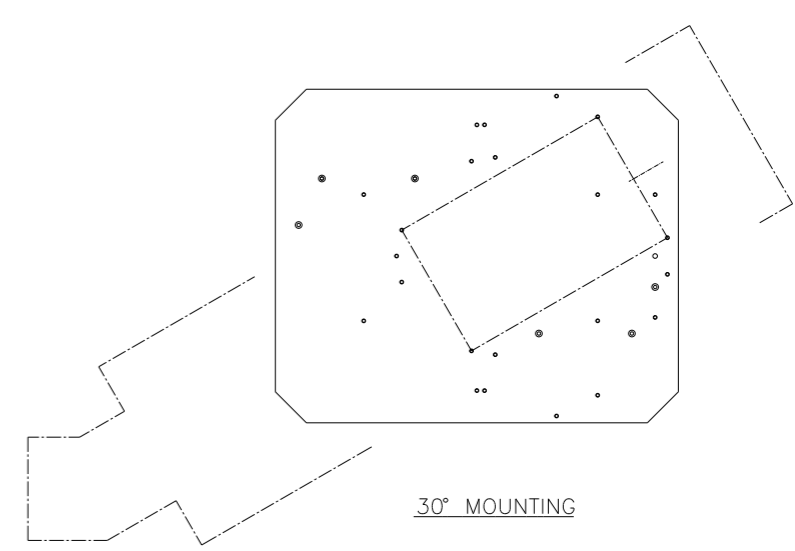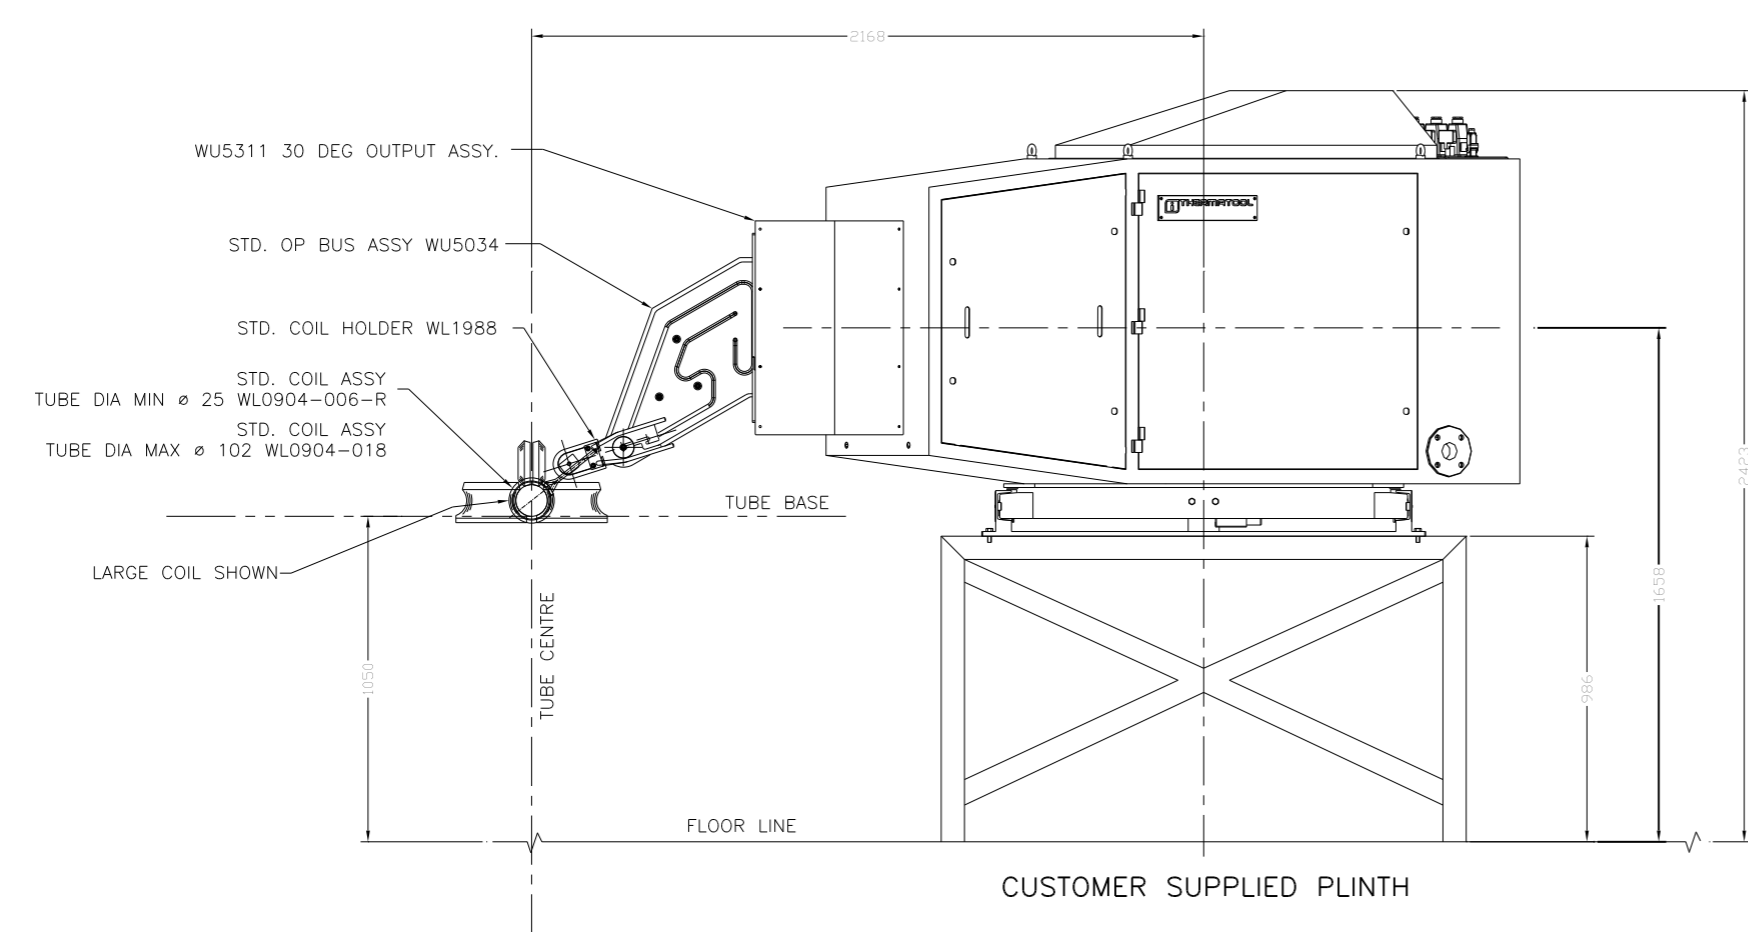

WARNING
 PLEASE TO THE MANUFACTURER'S & WELDING TECHNOLOGIES LIMITED INSTRUCTIONS AND SAFETY INFORMATION. ALWAYS WEAR APPROPRIATE PPE. ALWAYS USE THE CORRECT WELDING TECHNIQUE AND WELDING PARAMETERS. ALWAYS USE THE CORRECT WELDING EQUIPMENT AND WELDING MATERIALS. ALWAYS USE THE CORRECT WELDING PROCEDURE. ALWAYS USE THE CORRECT WELDING POSITION. ALWAYS USE THE CORRECT WELDING SPEED. ALWAYS USE THE CORRECT WELDING CURRENT. ALWAYS USE THE CORRECT WELDING VOLTAGE. ALWAYS USE THE CORRECT WELDING WIRE. ALWAYS USE THE CORRECT WELDING GAS. ALWAYS USE THE CORRECT WELDING TORQUE. ALWAYS USE THE CORRECT WELDING TEMPERATURE. ALWAYS USE THE CORRECT WELDING TIME. ALWAYS USE THE CORRECT WELDING DISTANCE. ALWAYS USE THE CORRECT WELDING ANGLE. ALWAYS USE THE CORRECT WELDING BEVEL. ALWAYS USE THE CORRECT WELDING ROOT FACE. ALWAYS USE THE CORRECT WELDING ROOT GAP. ALWAYS USE THE CORRECT WELDING ROOT RADIUS. ALWAYS USE THE CORRECT WELDING ROOT CHAMFER. ALWAYS USE THE CORRECT WELDING ROOT SURFACE. ALWAYS USE THE CORRECT WELDING ROOT CONDITION. ALWAYS USE THE CORRECT WELDING ROOT QUALITY. ALWAYS USE THE CORRECT WELDING ROOT DEFECTS. ALWAYS USE THE CORRECT WELDING ROOT REPAIRS. ALWAYS USE THE CORRECT WELDING ROOT INSPECTION. ALWAYS USE THE CORRECT WELDING ROOT RECORDS. ALWAYS USE THE CORRECT WELDING ROOT DOCUMENTATION. ALWAYS USE THE CORRECT WELDING ROOT ARCHIVE. ALWAYS USE THE CORRECT WELDING ROOT BACKUP. ALWAYS USE THE CORRECT WELDING ROOT RESTORE. ALWAYS USE THE CORRECT WELDING ROOT RECOVERY. ALWAYS USE THE CORRECT WELDING ROOT PROTECTION. ALWAYS USE THE CORRECT WELDING ROOT SECURITY. ALWAYS USE THE WELDING ROOT PROTECTION. ALWAYS USE THE CORRECT WELDING ROOT SECURITY. ALWAYS USE THE CORRECT WELDING ROOT ACCESS. ALWAYS USE THE CORRECT WELDING ROOT PERMISSIONS. ALWAYS USE THE CORRECT WELDING ROOT AUDIT. ALWAYS USE THE CORRECT WELDING ROOT LOGGING. ALWAYS USE THE CORRECT WELDING ROOT MONITORING. ALWAYS USE THE CORRECT WELDING ROOT ALERTS. ALWAYS USE THE CORRECT WELDING ROOT REPORTS. ALWAYS USE THE CORRECT WELDING ROOT ANALYSIS. ALWAYS USE THE CORRECT WELDING ROOT TRENDS. ALWAYS USE THE CORRECT WELDING ROOT VISUALIZATION. ALWAYS USE THE CORRECT WELDING ROOT INTERACTION. ALWAYS USE THE CORRECT WELDING ROOT COLLABORATION. ALWAYS USE THE CORRECT WELDING ROOT COMMUNICATION.

INDUSTRIAL HEATING & WELDING TECHNOLOGIES LTD
 157
 1 OF 1
 A0
 WG2210-T2400

CUSTOMER PLINTH REQUIREMENTS	
HF12 INVERTER R-L BASELINE	
SI - MM	
1 OF 1	
A0	
WG2210-T2400	